

2



US Army Corps
of Engineers
Fort Worth District

**FOUNDATION
REPORT**

AD-A229 436

DTIC
ELECTE
NOV 27 1990
S D CG D

**COMPLETION OF
EMBANKMENT, SPILLWAY
AND OUTLET WORKS
RAY ROBERTS LAKE
ELM FORK, TRINITY RIVER, TEXAS**

DISTRIBUTION STATEMENT A
Approved for public release
Distribution Unlimited

August 1990

90 11 19264

CORPS OF ENGINEERS
FORT WORTH DISTRICT, TEXAS



FOUNDATION REPORT
COMPLETION OF EMBANKMENT AND SPILLWAY

RAY ROBERTS LAKE

Accession	
NTIS <input type="checkbox"/> <input checked="" type="checkbox"/>	
DTIC <input type="checkbox"/> <input checked="" type="checkbox"/>	
U. S. Army J. S. [unclear]	
By <i>per call</i>	
Distribution <i>1</i>	
Availability	
Dist	Avail. & 1/0 Special
<i>A-1</i>	

Statement "A" per telecon Caroline Solomon. U.S. Army Engineering District, Fort Worth/CESWF-IM-C. P. O. Box 17300. Fort Worth, TX 76102-0300.

VHG

11/26/90

AUGUST 1990

TABLE OF CONTENTS

<u>Para No.</u>	<u>TITLE</u>	<u>Page No.</u>
1	INTRODUCTION	
	a. Project Location and Description	1
	b. Construction Authority	1
	c. Purpose of the Report	1
	d. Project History	2
	e. Contractors, Supervision and Quality Control Organization	4
	(1) Quality Control	4
	(2) Contract Supervision	4
2	FOUNDATIONS	
	a. Investigations Prior to Construction	5
	b. Investigations During Construction	6
3	GEOLOGY	
	a. Physiography	6
	b. Site Geology	7
	(1) Overburden	7
	(2) Structure	8
	(3) Stratigraphy	8
	(a) Pawpaw Shale	8
	(b) Main Street Limestone	9
	(c) Grayson Marl	9
	(d) Woodbine Formation	9
	(4) Weathering	10
	(5) Ground Water	11
	c. Engineering Characteristics of Over- burden Materials	11
	(1) Outlet Works	11
	(2) Embankment	11
	(3) Weak Stratum	12
	(4) Spillway	13
	d. Engineering Characteristics of Bedrock Materials	13
	(1) Outlet Works	13
	(2) Embankment	14
	(3) Spillway	14

TABLE OF CONTENTS
(cont'd)

<u>Para No.</u>	<u>TITLE</u>	<u>Page No.</u>
	e. Unusual or Unanticipated Geologic Conditions Encountered During Construction	14
4	EXCAVATION PROCEDURES	
	a. Excavation Grades	14
	b. Dewatering Provisions	15
	c. Overburden Excavation	15
	d. Rock Excavation	15
	e. Line Drilling, Presplitting and Contour Blasting	26
	f. Foundation Preparation	26
	g. Gunite in Conduit Excavation Walls	26
	h. Safety Protection Against Slides and Rockfalls	42
5	PILE DRIVING AND SPECIAL FOUNDATIONS	42
6	TUNNELS, SHAFTS, AND UNDERGROUND STRUCTURES	42
7	FOUNDATION ANCHOR TEST	42
8	CHARACTER OF FOUNDATION	
	a. Character of Overburden Materials	47
	b. Character of Primary Materials	47
9	FOUNDATION TREATMENT	48
10	FOUNDATION INSTRUMENTATION	
	a. General	48
	(1) Initial Embankment and Closure Section	48
	(2) Left Abutment	56
	(3) Embankment Underseepage	56
	(4) Outlet Works	56
	(5) Embankment Crest	56

TABLE OF CONTENTS
(cont'd)

<u>Para No.</u>	<u>TITLE</u>	<u>Page No.</u>
	b. Schedule of Instrumentation Reading	56
	c. Settlement Plates and Deep Settlement Plates	57
	d. Inclinometers	57
	e. Piezometers	57
	f. Surface Reference Marks	58
	g. Reference Pins	58
	h. Seepage Interceptor System	58
11	POSSIBLE FUTURE PROBLEMS	59
12	RECORD OF FOUNDATION APPROVAL	59

PLATES

<u>Plate No.</u>	<u>TITLE</u>
1	Lake Map and Vicinity Map
2	General Plan
3	Dam Site Geology
4 - 7	Plan of Explorations
8 - 39	Logs of Borings
40 - 41	Outlet Works
42 - 43	Outlet Works, Plan and Profile
44 - 46	Geologic Profile, Embankment Centerline
47	Geologic Profile, Outlet Works
48	Spillway, Approach Channel, and Discharge Channel
49 - 60	Inspection Trench, Plan and Profile
61	Left Abutment, Deep Inspection Trench
62	Plan of Instrumentation
63	Record of Foundation Approval

RAY ROBERTS LAKE FOUNDATION REPORT

1. INTRODUCTION.

a. **Project Location and Description.** Ray Roberts Dam and Lake project is situated in northern Denton, south-central Cooke and western Grayson Counties. The Dam is at river mile 60.0 on Elm Fork of the Trinity River, approximately 30 river miles north of Lewisville Dam. The location of the project is shown on Plate 1. The principal features of the project include (1) a rolled earthfill embankment approximately 14,980 feet long; (2) a limited service spillway consisting of an uncontrolled trapezoidal broad-crested weir; the spillway crest length is 100 feet; and (3) the outlet works, consisting of an excavated approach channel, intake structure and service bridge, a 708-foot long by 13-foot diameter cut and cover conduit, stilling basin and excavated discharge channel (see Plate 2). For the future addition of hydropower, a separate steel-lined concrete 5-foot diameter low flow conduit was constructed beneath the main flood control conduit. (SDN)

b. **Construction Authority.** Congressional authority for construction of Aubrey Lake (now Ray Roberts Lake) is contained in the Public Works - Rivers and Harbor Act approved 27 October 1965 (Public Law 89-298) in accordance with the plan of improvement as outlined in House Document No. 276 (89th Congress, 1st Session).

c. **Purpose of the Report.** This report was prepared in accordance with requirements as set forth by the Office, Chief of Engineers in ER 1110-1-1801.

The purpose of this report is to provide a complete record of foundation conditions encountered during construction. Information contained in this report will be valuable when evaluating (1) necessary remedial action required to prevent or repair any problems resulting from foundation deficiencies; (2) contractor claims related to foundation conditions or alleged change of condition; and (3) planning and design of future comparable construction projects.

A copy of this report should be included in the permanent records maintained at the project office.

d. **Project History.** Four dam site locations were studied prior to final site selection. Site No. 1, the project document site, is at river mile 60.0. Sites 2, 3, and 4 are at river miles 55.9, 51.2, and 64.0, respectively. Three holes were drilled at Site 2 in 1970. No subsurface explorations were done at Sites 3 and 4.

Site No. 4, located upstream of the confluence of the Elm Fork and Isle du Bois Creek would require two embankments and in effect form two lakes. Site No. 4 would also require two outlet facilities or an equalizer channel. This was the uppermost site considered. Sites downstream from Site 3 would be in the flood pool of Lewisville Lake and would require a major railroad relocation.

Based on studies that included an appraisal of the physical, historic, economic, and social impacts at each site, and the results from a public meeting held in April 1971, Site No. 1 was selected as the recommended site. By Public Law 96-384, dated 6 October 1980, the

project name was officially changed from Aubrey Lake to Ray Roberts Lake.

Seven locations, designated A through G, for the spillway were investigated. Cost estimates were made for gated, broadcrested, and uncontrolled ogee spillways. Consideration was also given to a perched spillway with the crest elevation at 5 feet, and at 10 feet above the top of the flood control pool.

Site A was used for the gated spillway estimate for site selection. It was in the steep slope of the east abutment and proved to be undesirable from the standpoint of stability and excessive excavation. Site B, the recommended site, was used for the uncontrolled spillway estimate for site selection, and for various other plans. Site B proved to be the most economical spillway location regardless of type of spillway. Site E at Culp Branch on the west abutment was investigated, but spillways here were too costly because of excessive channel excavation and downstream land requirements. Sites C, D, F, and G were eliminated by inspection because of excessive excavation and additional land requirements.

Studies showed that a gated spillway had a higher first cost than the uncontrolled spillways. Annual operating and maintenance costs for a gated spillway would also be appreciably greater. Several studies were made of various plans with both broadcrested and ogee uncontrolled spillways, in order to optimize size and type of structure.

Studies were made for uncontrolled spillways with widths varying

from 100 feet to 1,000 feet. These studies indicated that the most economical project would be one with the narrowest spillway and highest embankment. A width of 100 feet was judged to be the practical minimum and was, therefore, selected for the recommended plan.

e. **Contractors Supervision and Quality Control Organization.** The embankment, spillway, and outlet works for Ray Roberts Lake were constructed under one contract. Pertinent data related to the contract are listed below:

Contractor: Phillips and Jordan, Inc., Knoxville, TN

Contract No.: DACW63-82-C-0083

Contractor's Bid: \$48,657,799

Notice to Proceed: 31 May 1982

Completion Date: 9 October 1986

Total Payment Including Modifications: \$51,491,731.27

(1) **Quality Control.** The quality control organization was furnished and compensated by the contractor.

(2) **Contract Supervision.** Construction was under the immediate supervision of the District Engineer, U.S. Army Engineer District, Fort Worth, Texas. The contracting officer's representative for administration of the contract was Mr. Webb Boland. The following personnel participated in administering the contract: Mr. Mark Gibson, outlet works construction, and Mr. David Bowie, embankment and spillway construction.

2. FOUNDATION EXPLORATIONS.

a. Investigations Prior to Construction. Dam Site No. 1 was first explored in 1939. Eight combination auger and core borings numbered C-1 through C-8 were drilled near the present alignment. The borings ranged from 67 to 217 feet in depth. In December 1960, three additional combination auger and core holes, numbered 9 through 11, were drilled on the right abutment slope, ranging in total depth from 30.6 to 106 feet. There are no testing records on either the overburden materials or the rock cores and the borings were not pressure tested. Boring locations are shown on Plates 4 through 7. Logs of boring are shown on Plates 8 through 39.

Twenty-two additional holes were drilled in 1971 and 1972 during the General Design Memo Study Phase. These holes were numbered 12 through 27, and B, C, D, E, F, J, and K. The following table shows the location, total footage, and purpose for these holes.

Location	: Number : Drilled	: Total : Footage	: : Purpose
Right (West) Abutment	6	292.0	Embankment Foundation
Left (East) Abutment	1	51.0	" "
Valley Section	4	296.4	" "
Spillway	7	476.3	Spillway Location & Foundation
Right Abutment Outlet Works	2	95.2	Intake & Stilling Basin Foundation
*Left Abutment Outlet Works	2	105.8	Intake & Stilling Basin Foundation

*Alternate location considered for outlet works.

In late 1972 and 1973, 37 additional holes were drilled. These holes were numbered 28 through 77. Holes 41 through 49 were 3-inch

Shelby tube holes, drilled along the axis of the uncontrolled spillway. Holes 3S-52 through 3S-57 were 3-inch shelby tube holes drilled along the centerline of the outlet works discharge channel. The other 22 holes were drilled in the embankment foundation.

In 1975 and 1976, holes 83 through 99 were drilled in the outlet works area, with the exception of hole 3F-86, which was drilled on the left abutment.

In late 1975, nine 8A6C holes, designated 301 through 309, were drilled at Site E for spillway site selection. This site was was not selected.

In October 1980, holes 310 through 316 were drilled, and in April 1981, holes 358 through 366 were drilled, all in the outlet works area.

One calyx hole (42-inch auger) was drilled in March 1975, to a depth of 46.5 feet to investigate soft clay seams in the embankment foundation. The hole was located at Station 120+70, 130 feet upstream.

A total of 113 foundation borings were drilled at the project.

b. **Investigations During Construction.** No problems requiring additional subsurface explorations were encountered during construction.

3. GEOLOGY.

a. **Physiography.** Ray Roberts Dam and Reservoir lie within the Gulf Coastal Plain physiographic province. The coastal plain of Texas is characterized by a broad rolling landform extending from the outcrop of the basal Cretaceous sands to the northwest to the Gulf of Mexico on

the southeast. It has developed upon a sequence of sedimentary rock units which dip gently southeastward, resulting in successively younger formations cropping out Gulfward. The outcrop of each formation or group in the coastal plain of Texas has distinctive soil, vegetation, and erosion characteristics which are the basis for further physiographic subdivision. Ray Roberts Dam and Reservoir lie within two such subdivisions; the Grand Prairie and the Eastern Cross Timbers. Damsite Geology is shown on Plate 3. The Grand Prairie, a subdivision which has developed on the outcrop of the Washita Group of Lower Cretaceous age, occurs generally west of the Elm Fork of the Trinity River. It is characterized by a rolling to hilly topography supported by limestone, marl, clay shale, and sandy shale. Typically, it is a grassy country, the uplands being given largely to grazing, the valleys being important agriculturally. Situated east of the Elm Fork, the Eastern Cross Timbers has developed on the outcrop of the Woodbine Formation of Upper Cretaceous geologic age. The Eastern Cross Timbers is characterized by a rolling to moderately rugged topography which supports a prolific growth of post oak trees.

b. Site Geology.

(1) **Overburden.** Overburden on the abutments consisted of predominantly residual clay and clayey materials generally ranging from 25 to 35 feet in thickness. The embankment is founded on these materials. In the spillway area, 2 to 11 feet of clay and silty clay with scattered gravel were removed and this structure is founded on

weathered clay shale. Overburden materials in the floodplain consist of 35 to 45 feet of alluvial clays, silts, sands, and gravels, comprising the floodplain embankment foundation. In the outlet works area about 20 to 30 feet of alluvial clays, silts, sands, and gravels were removed and the outlet works is founded in unweathered clay shale of the Pawpaw Formation.

(2) **Structure.** Subsurface investigations and subsequent foundation mapping during construction of the dam, outlet works and spillway have not revealed faulting or any other structural anomalies that would adversely affect the foundation of these structures. Correlation of marker beds encountered in the foundation borings show that the strata strike northeast and dip about 60 feet per mile to the southeast. Locally, minor undulations occur within the strata.

(3) **Stratigraphy.** Primary materials at the site from oldest to youngest are Pawpaw shale, Main Street limestone and Grayson marl of Lower Cretaceous age, and the Woodbine Formation of Upper Cretaceous age. The broad Elm Fork River valley is partially filled with Recent floodplain alluvium, while the uplands bordering the valley are often covered with Quaternary age terrace deposits.

a. **Pawpaw Shale.** Except for some isolated remnants of Main Street limestone, the Pawpaw shale comprises the primary strata beneath the embankment between station 0+00 to the base of the left abutment, the outlet works, and spillway (see Plates 44 through 48). The formation is composed of a soft to moderately hard, gray to black,

medium bedded clay shale, often sandy with sand laminations and lenses up to several inches thick. Thin, limy, fossiliferous zones occur throughout the formation.

b. **Main Street Limestone.** The Main Street limestone conformably overlies the Pawpaw shale. A full section is present in the left abutment. Erosional remnants occur in the central part of the embankment foundation and on the right abutment slope above elevation 640. The limestone is about 12 feet thick, moderately hard to hard, gray, fossiliferous, massive at its base, and becomes shaly as it grades into the overlying Grayson marl.

c. **Grayson Marl.** The Grayson marl occurs only in the left abutment at the dam site. It is represented by a soft to moderately hard, gray, highly calcareous, thick bedded, fossiliferous shale, that becomes increasingly marly at its base. Often a thin shaly limestone bed caps the formation separating it from the unconformably overlying Woodbine Formation. The Grayson and Main Street Formations are usually mapped as one geologic unit. At the dam site, their combined thickness is about 30 feet.

d. **Woodbine Formation.** The left abutment, above approximate elevation 565, is comprised of sediments belonging to the Woodbine Formation. Core borings made for the embankment reveal a fine-to-coarse-grained sand with scattered ironstone concretions and thin, poorly cemented sandstone seams to approximate elevation 600. In the basal portion of the Woodbine, a soft to moderately hard, gray to

brown, sandy clay shale predominates, although sand and sandstone can occur. Carbonaceous fragments are often noted. These inclusions, along with the generally noncalcareous nature of the shale, distinguish the material from the underlying Grayson Formation. The Woodbine exhibits gradational changes, both laterally and vertically, in its lithologic composition that make correlation between even closely spaced borings very difficult. The most detailed description of the Woodbine was developed after excavation of the inspection trench of the left abutment. Plate 58 is a geologic section of the plan of the inspection trench along the left abutment prior to placement of the fill.

(4) Weathering. Chemical weathering (oxidation and hydration) has affected the primary strata at the dam site to varying degrees. The shale and sandy shale of the Pawpaw Formation that comprise the primary strata for most of the embankment section have been only slightly altered. Staining (oxidation) is present to a maximum depth of about 14 feet below the top of primary strata that underlie the upland soils of the right abutment, while the Pawpaw shale beneath the alluvium in the valley section is fresh. In contrast, the sand, soft sandstone and shale of the Woodbine Formation that comprise the left abutment are deeply weathered. The relatively permeable sands and sandstones receptive to percolating waters are generally weathered throughout to the top of the first significant shale beds. Weathering in the shale occurs primarily as oxidation along joints and bedding

planes.

(5) **Ground Water.** Water levels are shown on Plates 44 through 48. Significant quantities of ground water are found in the floodplain alluvium and in the basal sands and gravels of the low level terrace deposits. Lesser quantities occur in joints and fractures in the weathered section of the Pawpaw shale and in the basal portion of the Woodbine Formation near its contact with the underlying Grayson in the left abutment. Prior to impoundment, ground water in the floodplain alluvium occurred at depths of 20-25 feet. During excavation of the inspection trench in the left abutment, water seeps were encountered at the contacts of the more pervious sands and sandstones with the underlying clays (see Plate 58).

c. Engineering Characteristics of the Overburden Materials.

(1) **Outlet Works.** Overburden in the outlet works area was investigated using auger, Denison and Shelby tube samplers. The materials consist of sandy clays (CL and CH) with zones of clayey sands (SC) and gravels (GC-GP). The gravelly zones generally overlay the primary materials. Overburden thickness varies from about 5 to 25 feet along the approach channel, from 8 to 20 feet along the conduit, and from 12 to 45 feet along the discharge channel. Classification and index testing were performed on jar samples taken from various depths in the overburden.

(2) **Embankment.** The overburden materials in the embankment foundation consist of alluvial clays, sands, and gravel strata.

Classification tests, Q, R, and S strength tests, and consolidation tests were performed on Denison barrel samples taken at varying depths in the clay. Classification and index tests were performed on jar samples taken from auger borings and Denison barrel samples obtained from the overburden in the floodplain. The following properties were used for overburden materials in the floodplain:

Moisture content 20%

Dry density 107.5 pcf

<u>Type Test</u>	<u>c</u> <u>tsf</u>	<u>0</u> <u>Degrees</u>
Q	0.8	3
R	0.1	14
S	0	26

(3) Weak Stratum. The following soil parameters were used for the weak, sandy clay stratum which is located in the foundation near the base of the overburden beneath the floodplain embankment.

Moisture content 23%

Dry density 102.0 pcf

<u>Type Test</u>	<u>c</u> <u>tsf</u>	<u>0</u> <u>Degrees</u>
Q	0.35 and 0.40	2.5
R	0.1	14
S	0	26

The low, undrained shear strength of this weak stratum is the controlling factor in the stability of the floodplain embankment.

(4) Spillway. The broadcrested weir is founded in weathered shale. Overburden along the centerline of the spillway increases from 2 feet in the area of the weir to 7 feet in the approach channel and 4 to 6 feet in the discharge channel. The overburden consists of principally silty clay with some fine sand and locally scattered fine gravels.

d. Engineering Characteristics of the Bedrock Materials.

(1) Outlet Works. The primary materials in the outlet works area were investigated using Denison, Shelby tube and core barrel samplers. Boring locations are shown on Plate . Primary foundation materials consist of unweathered clay shales of the Pawpaw Formation. The shales contain interbedded sandstone seams and beds that vary from a few inches to approximately 4 feet in thickness. From station 27+00 to 34+00, a near surface limestone layer was encountered which varied from about 2 to 7 feet in thickness. Laboratory testing was performed on selected samples of primary materials taken from borings along the centerline of the outlet works. Tests performed were classification, index grain size, unconfined compression and Q-triaxial compression tests. The approach channel structure, intake tower, and stilling basin was founded in unweathered shale for which the following parameters were used:

Allowable bearing pressure	8.0 ksf
Shear Strength, ϕ	20°
Cohesion	0

(2) **Embankment.** Laboratory strength tests conducted on samples of primary materials indicate that the shale stratum underlying the overburden through the floodplain has a low to moderately low strength, but its strength increases with depth. Although the strength of the shale is relatively low in the upper portion of the stratum, its strength is greater than that of the overburden; therefore, it is not the governing factor in the stability of the embankment.

(3) **Spillway.** The spillway is founded on interbedded silty shale and soft sandstone of the Pawpaw Formation. The materials are adequate to support the light loads to be imposed.

e. **Unusual or Unanticipated Geologic Conditions Encountered During Construction.** No unusual or unanticipated geologic conditions were encountered during construction.

4. EXCAVATION PROCEDURES

a. **Excavation Grades.** Foundation conditions encountered during excavation of the outlet works, inspection trench, cutoff trench, and emergency spillway were about the same as described in the subsurface data in the plans and specifications. The design slopes were achieved without any problems. The only deviation from designed grade lines was overexcavation in the primary materials. In February 1984, overexcavation occurred in the area adjacent to the outlet works conduit, between stations 28+90 and 29+80. The maximum depth of overexcavation was 2 feet. Contractor backfilled the overexcavation with concrete.

b. **Dewatering Provisions.** No ground-water problems of a serious nature were experienced in the outlet works, inspection trench, cutoff trench, or spillway excavations. On occasion, heavy rains partially filled the excavations. Small seeps were present in all the excavations except the spillway and are noted on the drawings. Surface water and the small amount of ground-water seepage experienced were handled by pump and sump operations. See Figures 1 through 6. All concrete and impervious backfill placements were on foundations free of water.

c. **Overburden Excavation.** Overburden materials excavated consisted of residual clay and other clayey materials on the abutments; alluvial clays, silts, sands, and gravels in the floodplain inspection trench and outlet works; and clay and sandy clay with scattered gravel in the spillway area. See Figures 7 through 12. Bulk excavation was done by Caterpillar scrapers. Finished grades were achieved with motor graders. Overburden materials considered suitable were used as random and semicompacted fill.

d. **Rock Excavation.** All rock excavation was accomplished using rippers and scrapers. Much of the weathered shale was used in a manner similar to the overburden; as random or semicompacted fill. Excavation methods were also similar. After bulk excavations of weathered shale by caterpillar scrapers, final grade was accomplished using motor graders. Exposure of weathered or unweathered shale of the Pawpaw Formation was limited to 3 days. See Figures 13 through 20. When this limit was exceeded, the contractor was required to clean the exposed



Figure 1. Outlet Works excavation, showing peripheral ditches controlling ground water.



Figure 2. Same as above

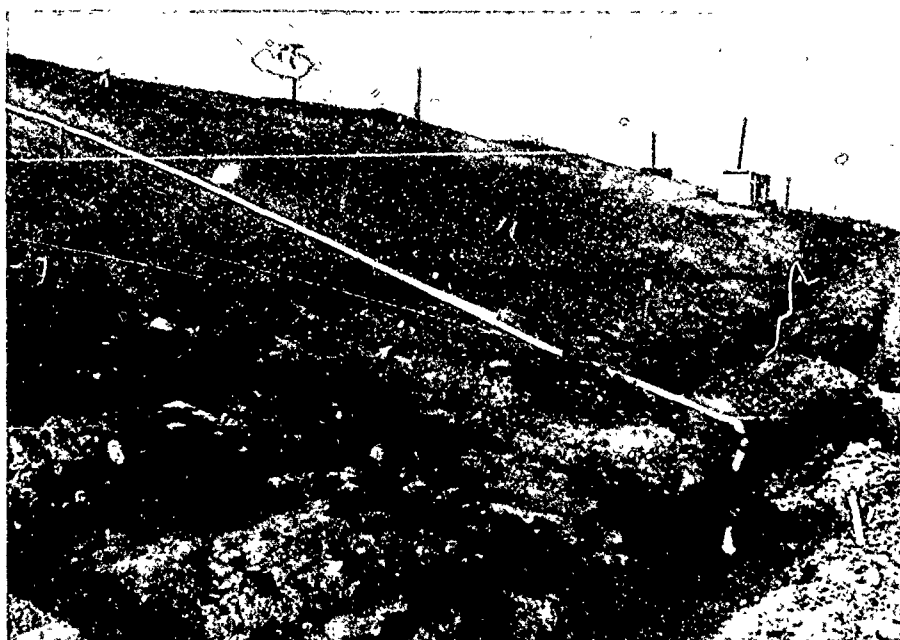


Figure 3. Outlet Works excavation showing peripheral ditches controlling ground water.



Figure 4. Same as above.



Figure 5. Outlet Works excavation showing peripheral ditches controlling ground water.



Figure 6. Same as above.

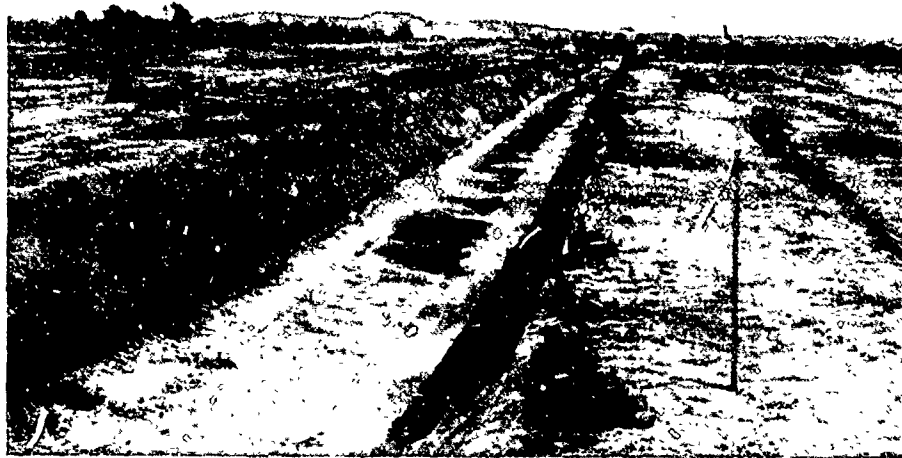


Figure 7. Right Abutment inspection trench looking east (Upstation)

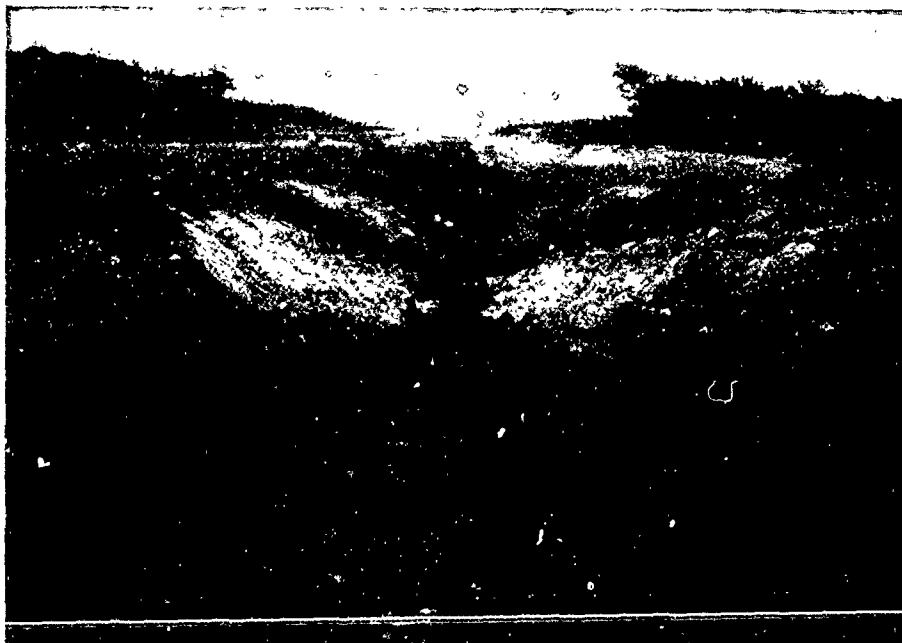


Figure 8. Left Abutment looking east.



Figure 9. Downstream face of right abutment inspection trench approx. sta. 66+50 to 69+00, looking east (Upstation).



Figure 10. Upstream face of right abutment inspection trench Approx. sta. 66+50 to 69+00, looking east.

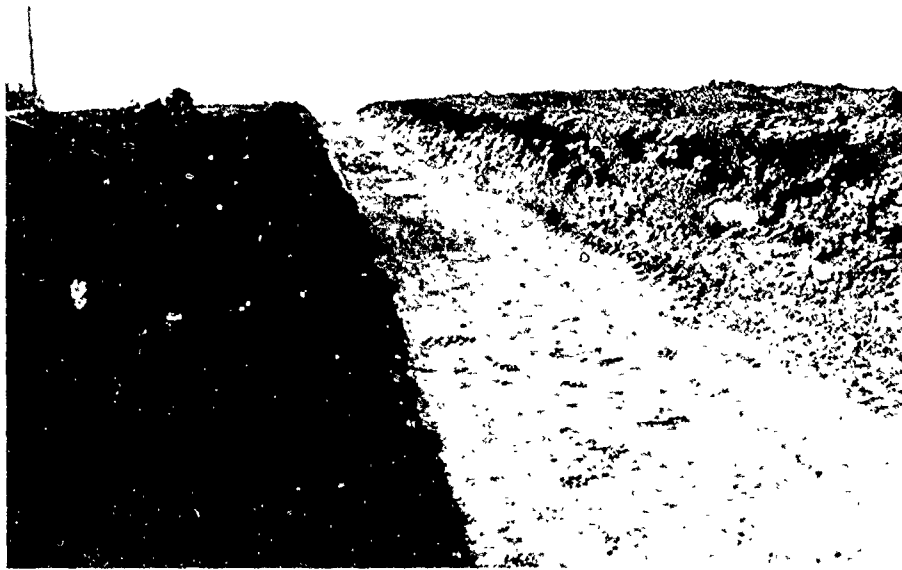


Figure 11. Right abutment inspection trench, looking west (downstream).



Figure 12. Same as above.

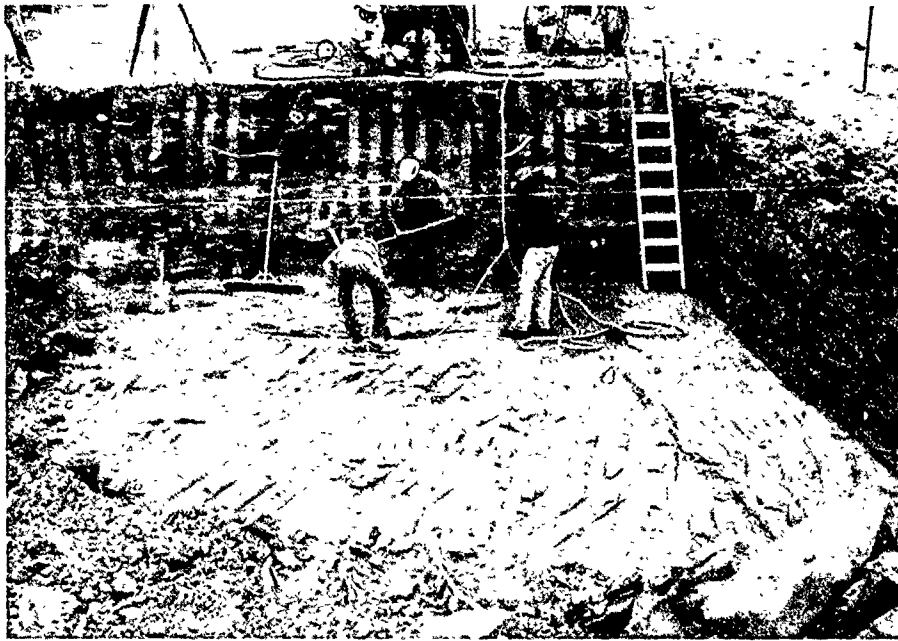


Figure 13. Intake Structure, hand cleaning shale foundation.



Figure 14. Intake Structure, placing re-bar for slab.



Figure 15. Looking Upstream from valve vault, showing fresh shale surface prior to placement of impervious material.

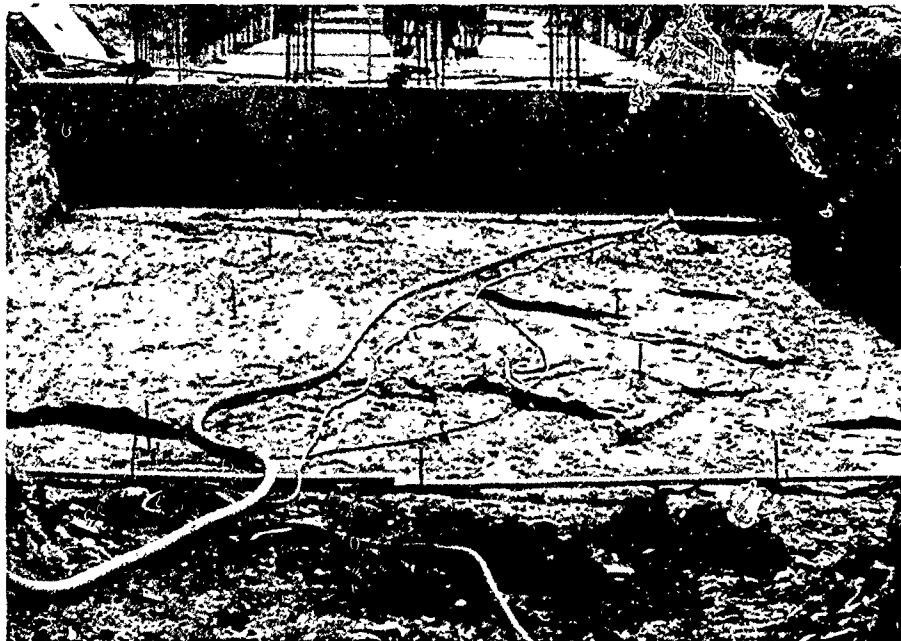


Figure 16. Foundation for approach slab.

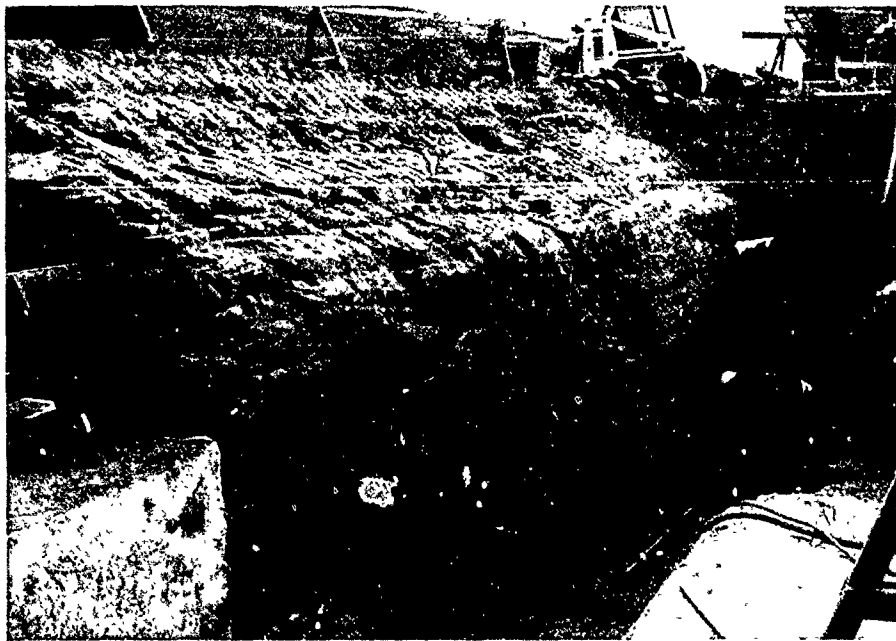


Figure 17. Excavation for intake for hydropower conduit at intake structure slab - looking downstream.

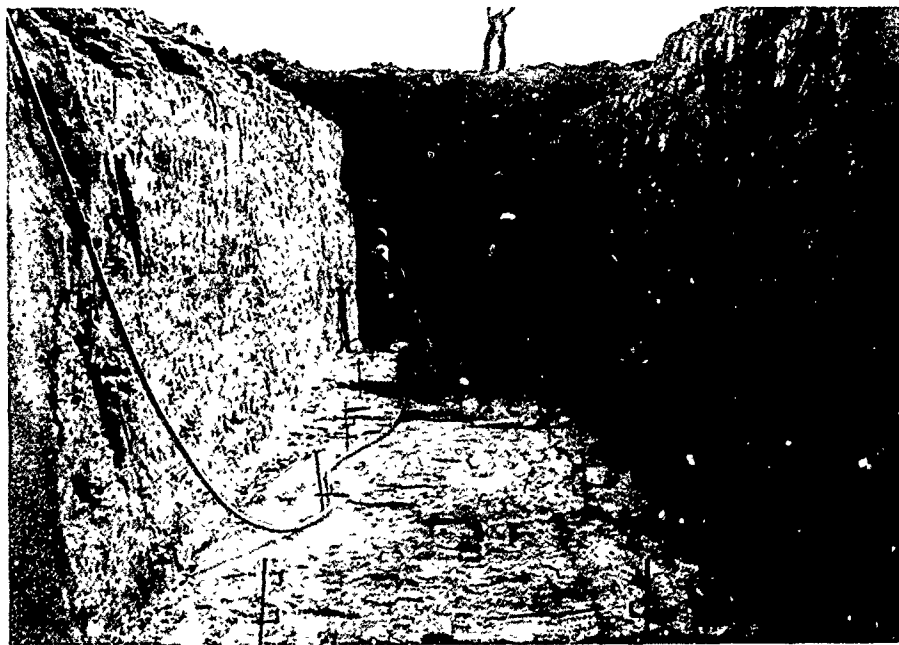


Figure 18. Hydropower conduit - placing gunite, Sta. 29+50-30+00.

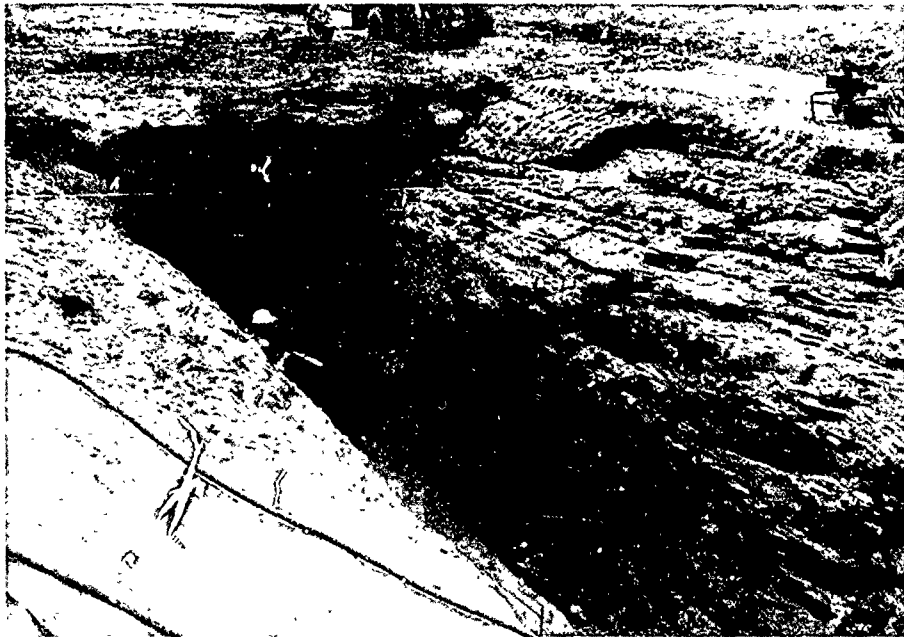


Figure 19. Hydropower conduit, looking downstream,
Sta. 29+20.

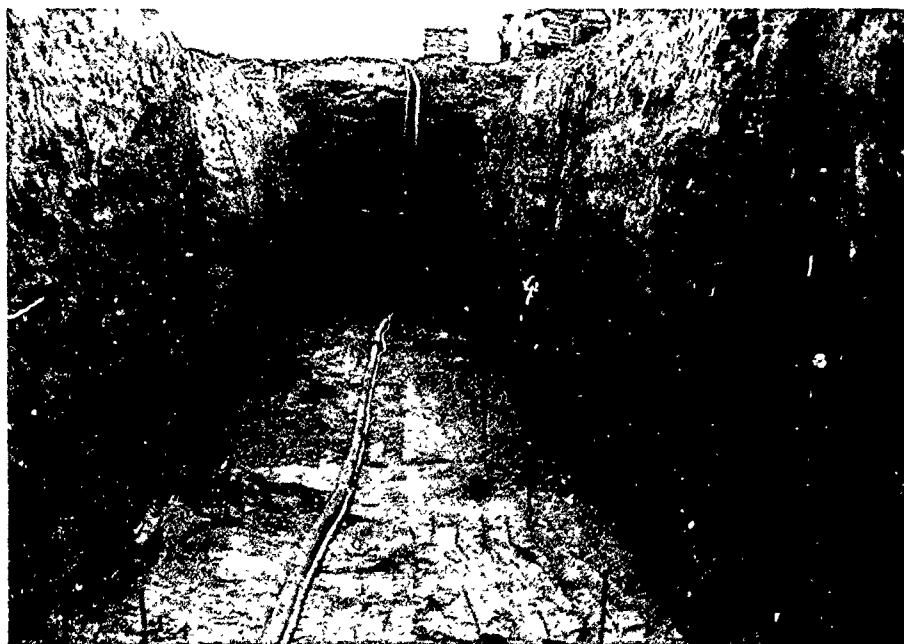


Figure 20. Hydropower conduit, looking downstream,
Sta. 30+10.

face by jackhammer and/or air jetting before protective concrete was placed.

e. **Line Drilling, Presplitting, and Contour Blasting.** No line drilling, presplitting, or contour blasting were performed during the course of construction.

f. **Foundation Preparation.** Clay shale of the Pawpaw Formation forms the majority of the foundation in the outlet works excavation and in the excavation for the sill of the limited-use spillway. See Figures 21 through 29. Primary materials in general were not exposed in cutoff or inspection trench excavations. See Figures 30 and 31. The most predominant material exposed was clay, especially CH clays. Since the clay shale deteriorates upon exposure to air, usually very noticeable within about 3 days, protective sealant or lean concrete (Gunitite) were specified for exposed shale surfaces. See Figures 34, 35, 36, 41, and 42.

g. **Gunitite in Conduit Excavation Walls.** Problems with Gunitite (protective concrete) developed in November 1982 in the hydropower conduit section between Stations 26+63 and 30+85. Excavation of the trench was done between 10 November 1982 and 23 November 1982. Gunitite was applied, as excavation progressed, on the floor and nearly vertical walls of the trench. Inspection on 24 November 1982 revealed numerous horizontal cracks, circular areas where Gunitite has fallen off the wall, and evidence that voids existed behind the Gunitite face. Inspection on 30 November 1982 revealed that deterioration of the Gunitite had greatly

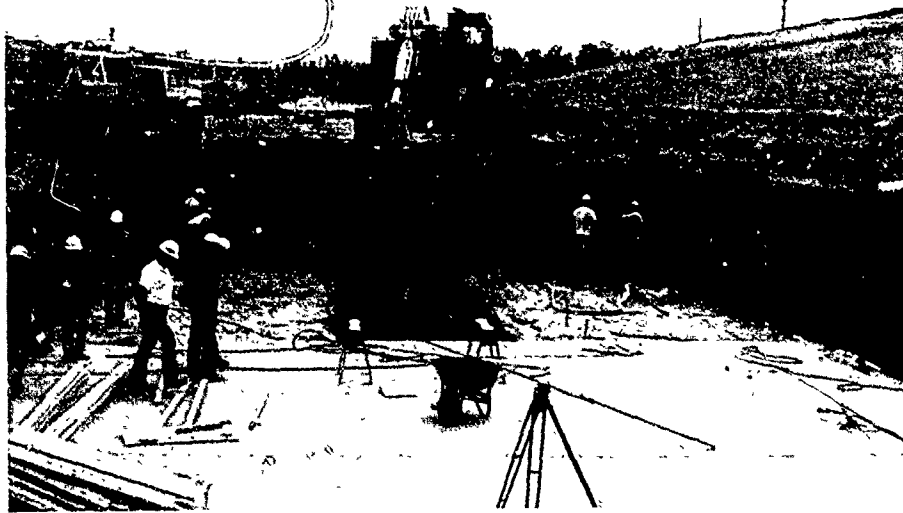


Figure 21. Excavation for hydropower conduit at intake structure slab.



Figure 22. Same as above.

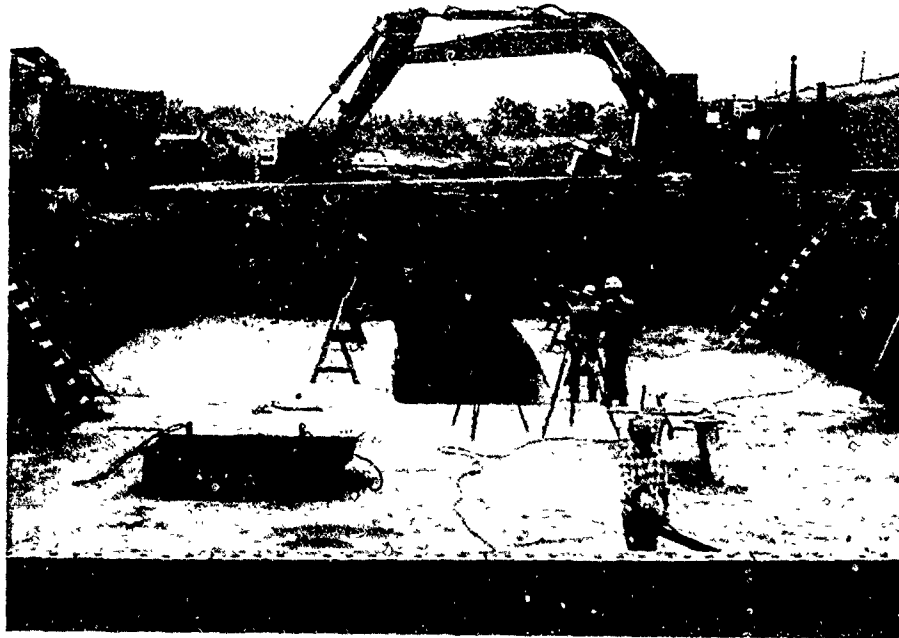


Figure 23. Excavation for hydropower conduit at intake structure slab.

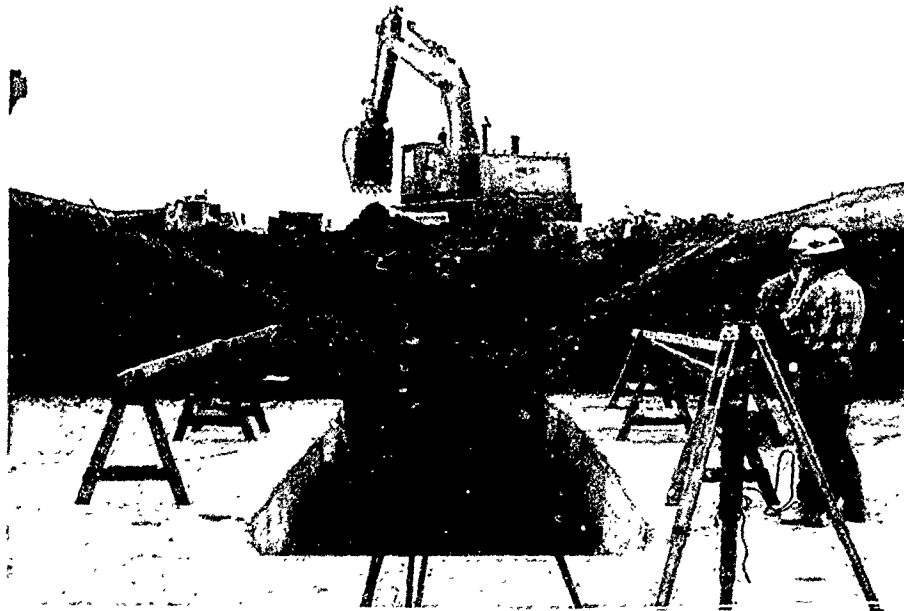


Figure 24. Same as above.

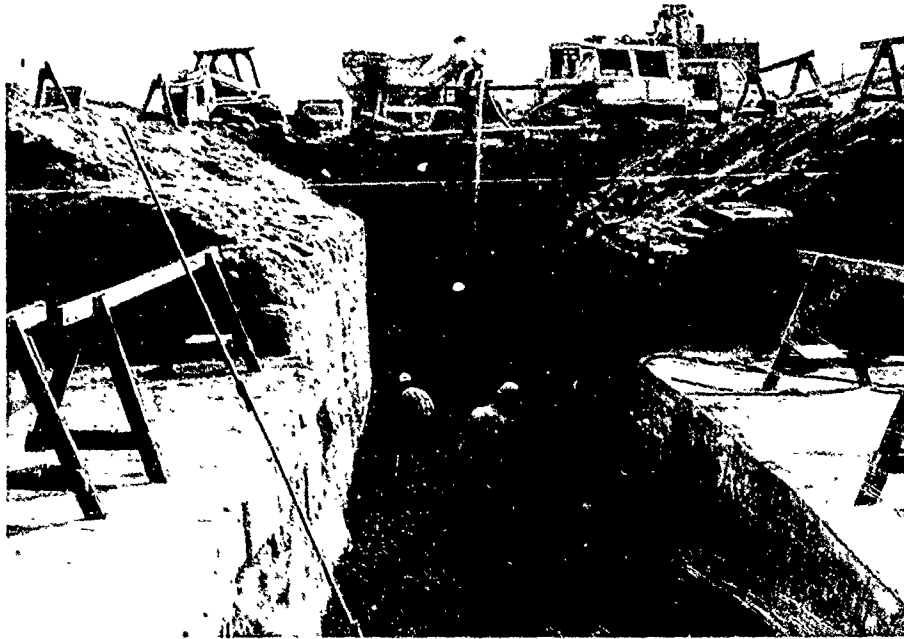


Figure 25. Excavation for hydropower conduit at intake structure slab.



Figure 26. Same as above.

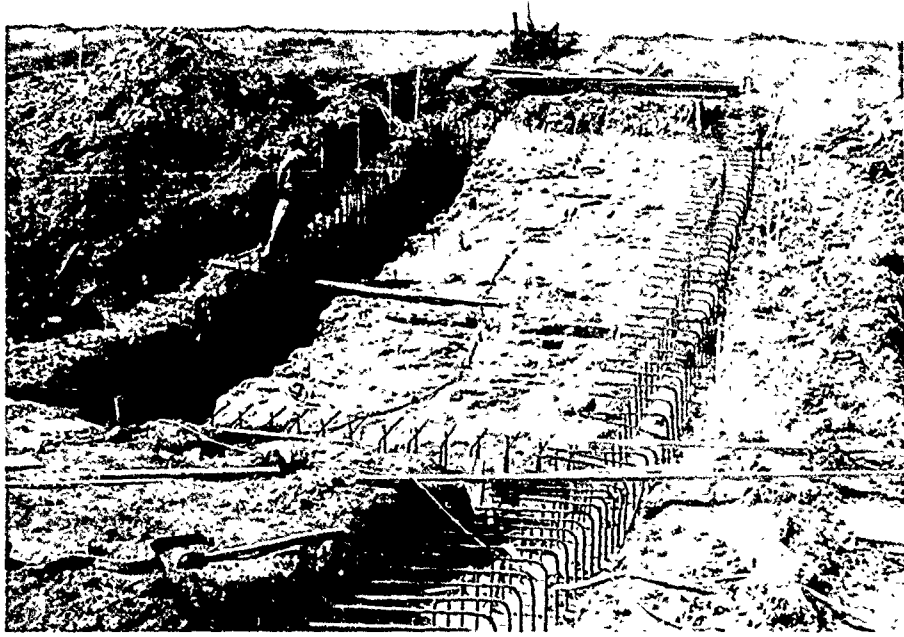


Figure 27. Construction of spillway sill.

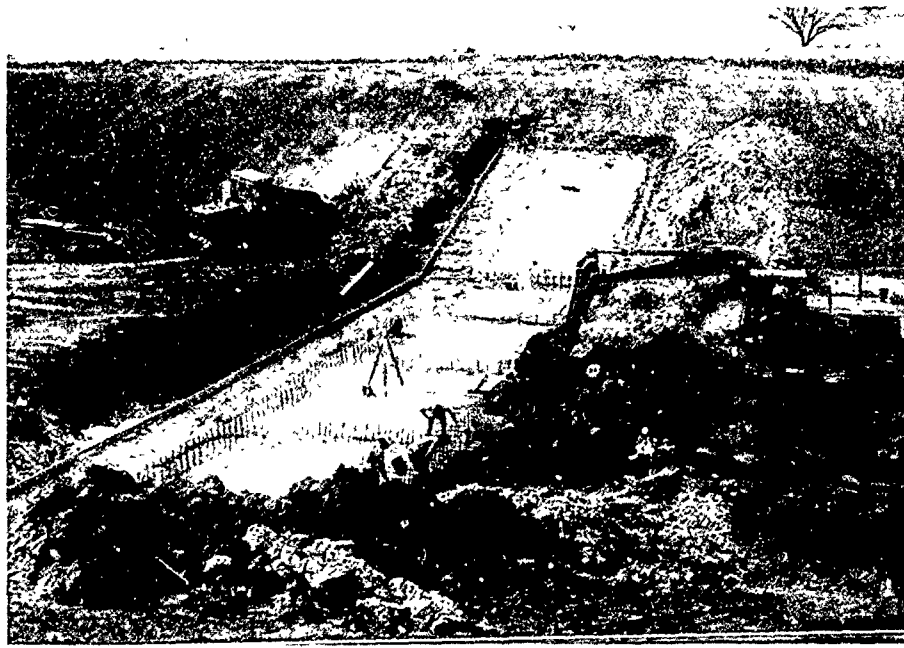


Figure 28. Same as above.

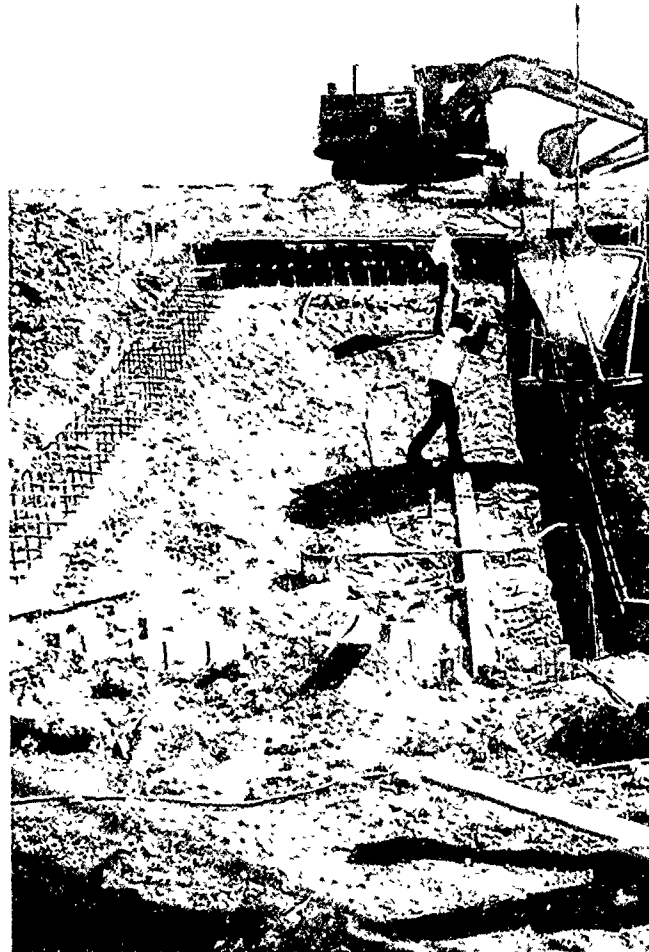


Figure. 29. Spillway - placing concrete footings.

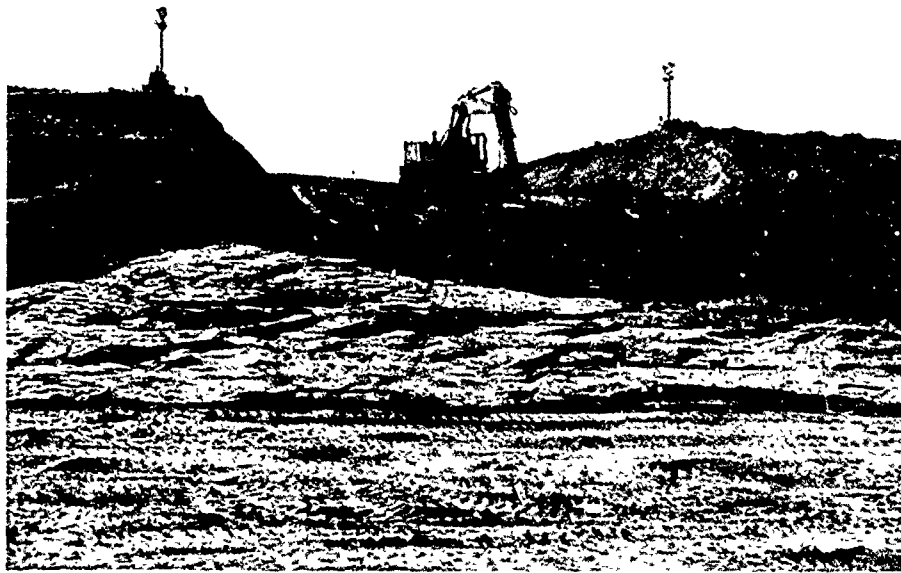


Figure 30. Looking downstation along dam centerline at intersection of embankment centerline and outlet works centerline.

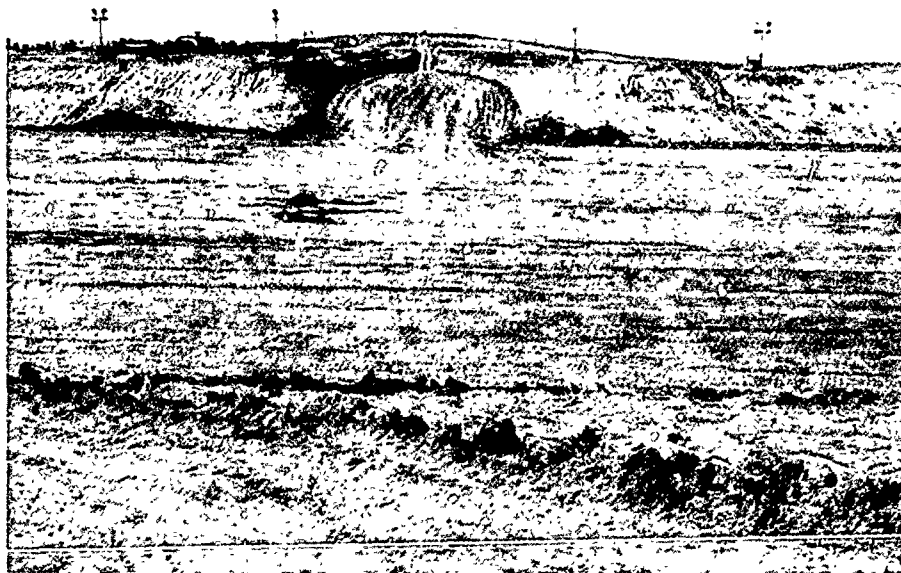


Figure 31. Later view of same area.

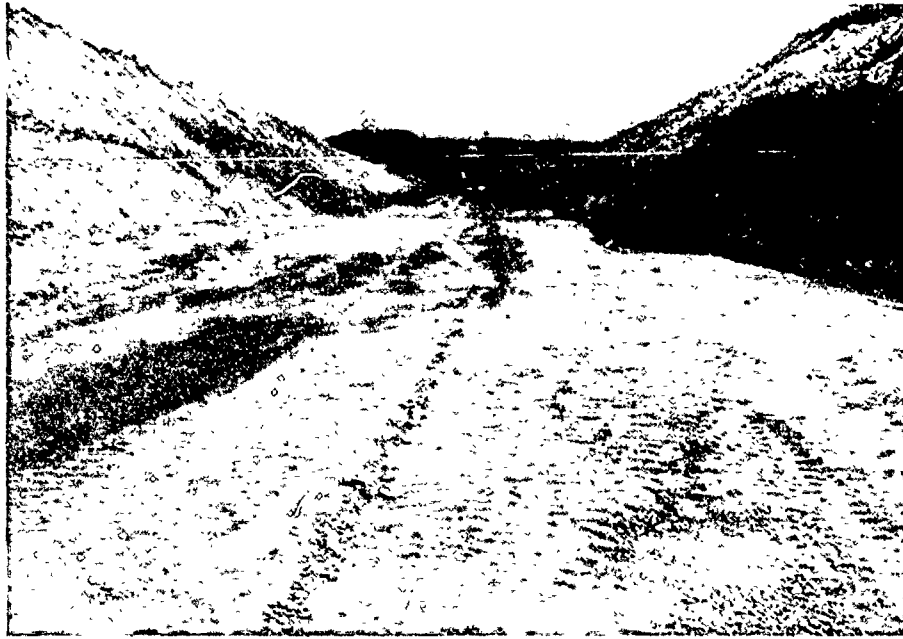


Figure 32. Inspection trench looking upstation (east).

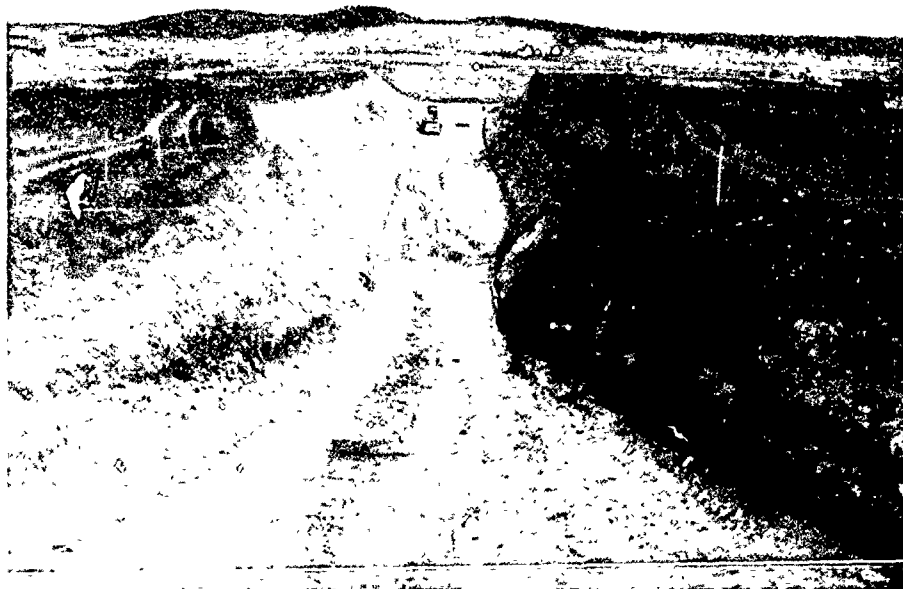


Figure 33. Inspection trench looking upstation.
Sta. 83+00 - 91+00.



Figure 34. Intake structure foundation - spraying aerospray.

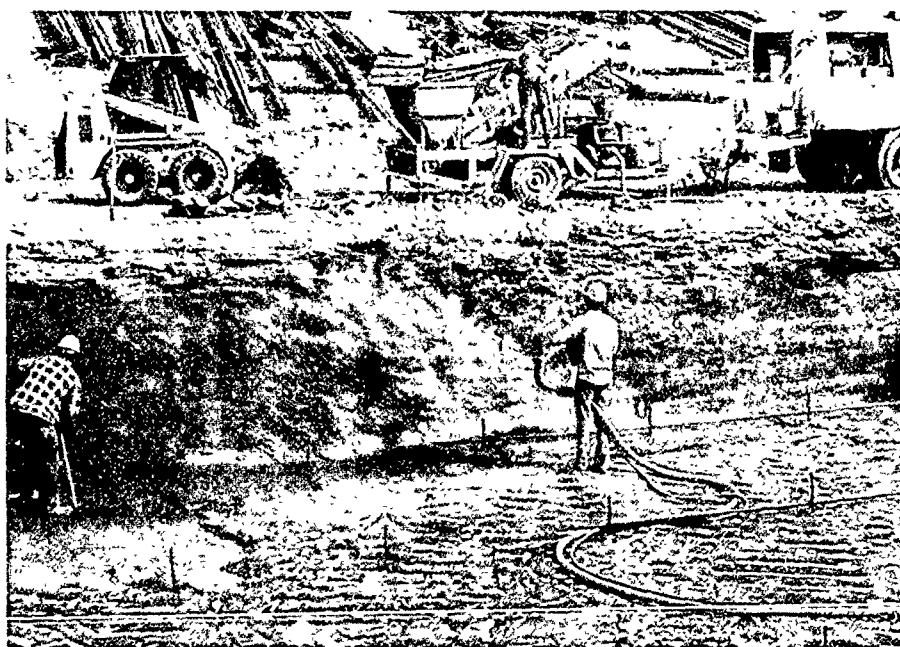


Figure 35. Intake structure foundation - applying gunite.



Figure 36. Intake structure foundation - placing protective concrete.



Figure 37. Forms for intake structure.



Figure 38. Outlet works, left side looking downstream at intake structure wing walls showing fresh shale surface.

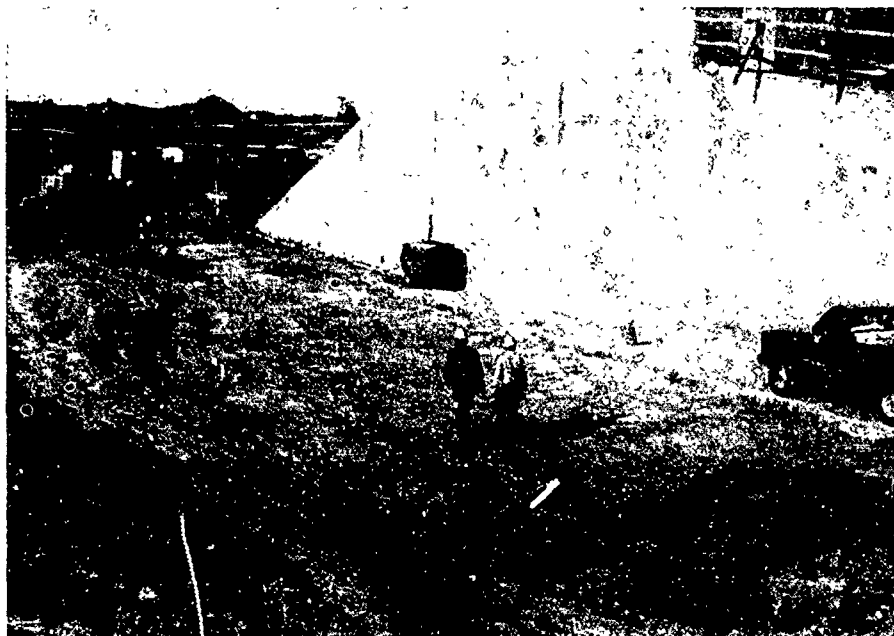


Figure 39. Intake structure, left side looking upstream. Fresh shale surface prior to placement of impervious.

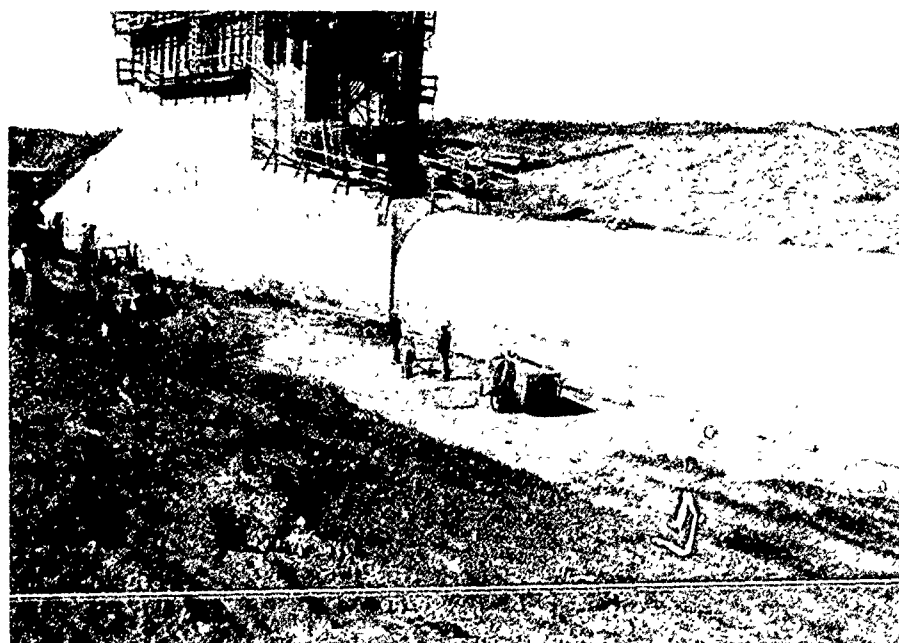


Figure 40. Same as above.

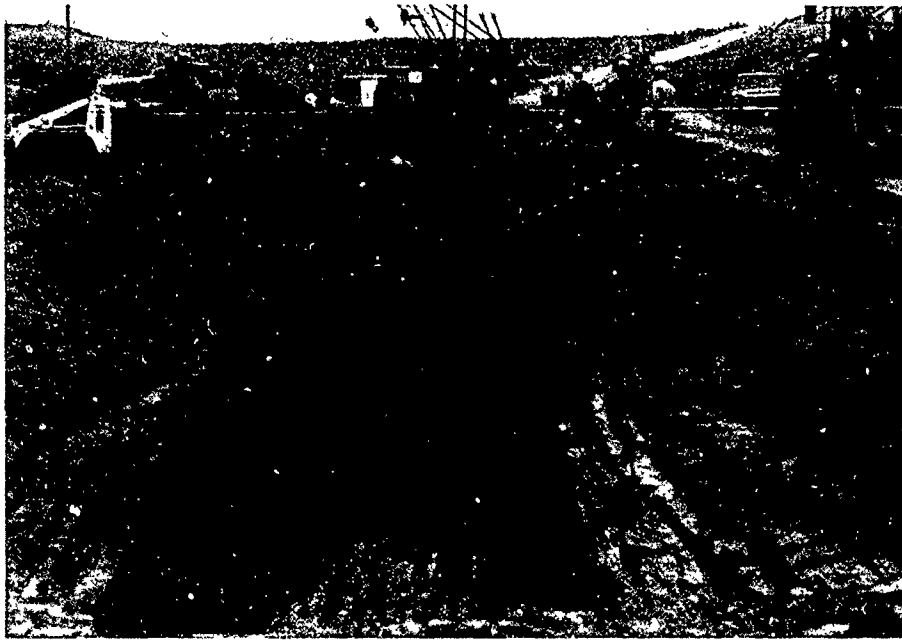


Figure 41. Hydropower conduit excavation showing gunite and aerospray application (looking upstream) Sta. 28+50 - 27+50.



Figure 42. Same as above.

accelerated, apparently because of a heavy rain on 25-26 November 1982. See Figures 43 through 46. From Station 28+25 to 30+85 the Gunite was severely cracked and broken and an estimated 30-foot long section on the east wall of the trench had fallen. Most of the Gunite on both walls in this section appeared loose and ready to fall. Portions of the Gunite, though still in-place, had void space between the Gunite and the rock face. This space could provide a seepage path along the outside of the conduit connected directly to the reservoir pool. A contract modification was signed on 3 December 1982 which stated:

(1) On remainder of penstock excavation (Station 30+85 to Station 34+07), delete pneumatic concrete from the IV: .09 H slopes, and spray these slopes with Aero-spray 70 as often as required to prevent weathering of shale.

(2) Between Stations 28+22 and 30+75 remove all pneumatic concrete which is drummy, cracked, or loose. Spray exposed shale with Aero-spray 70 as often as required to prevent weathering of shale.

(3) All future penstock excavation (Station 30+85 to Station 34+07) and removal of existing pneumatic concrete (Station 28+22 to Station 30+75), will proceed at a rate to accommodate one placement at a time to minimize shale exposure.

The contractor agreed that no more than 3 days would pass between exposure of the clay shale and concrete encasement. On occasions when exposure was more than 3 days, deterioration, consisting of severe drying, cracking and checking, was often noted. Contractor was then

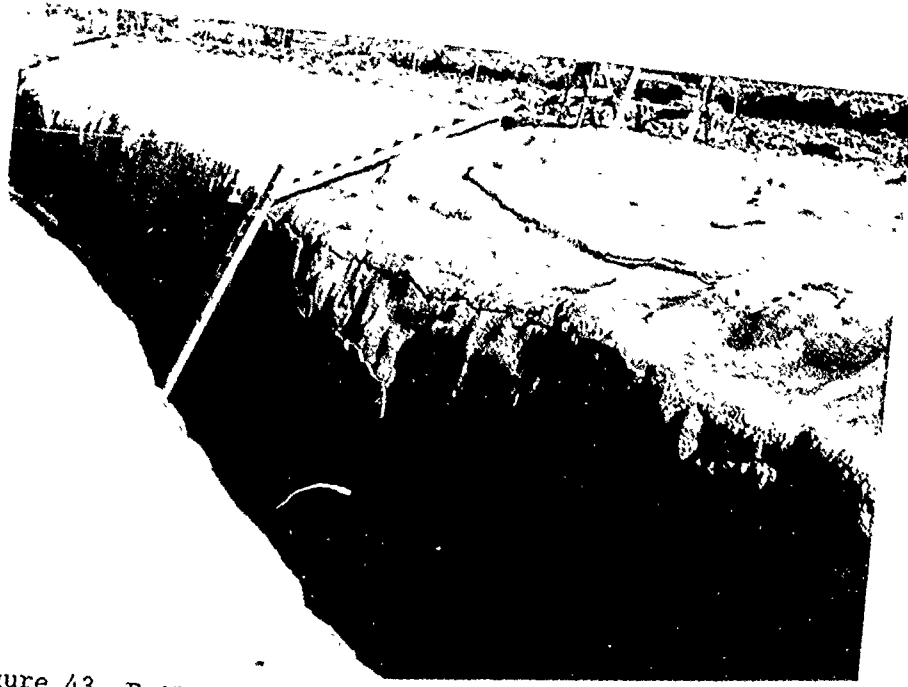


Figure 43. Failure of gunite on hydropower conduit excavation.



Figure 44. Same as above.

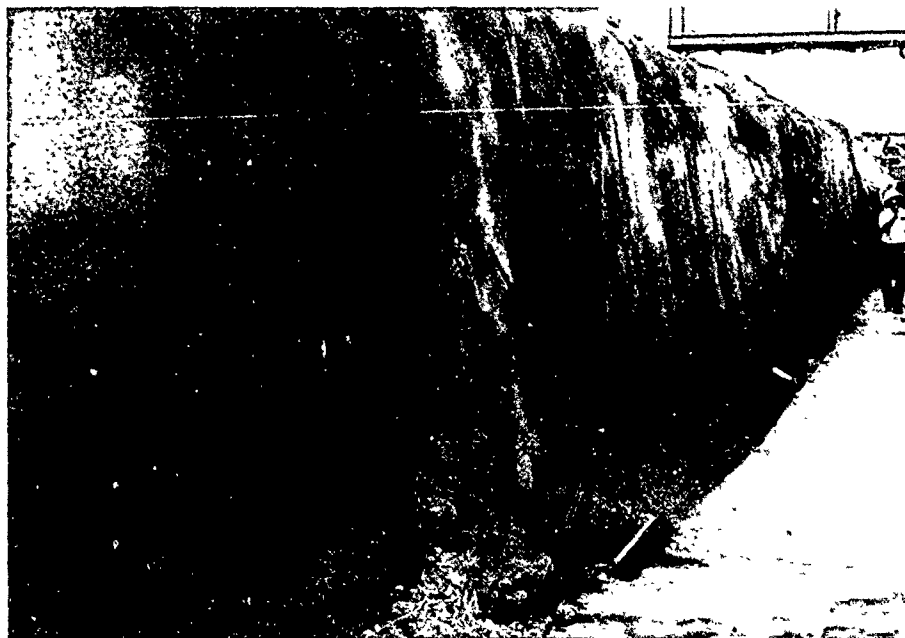


Figure 45. Failure of gunite on hydropower conduit excavation.

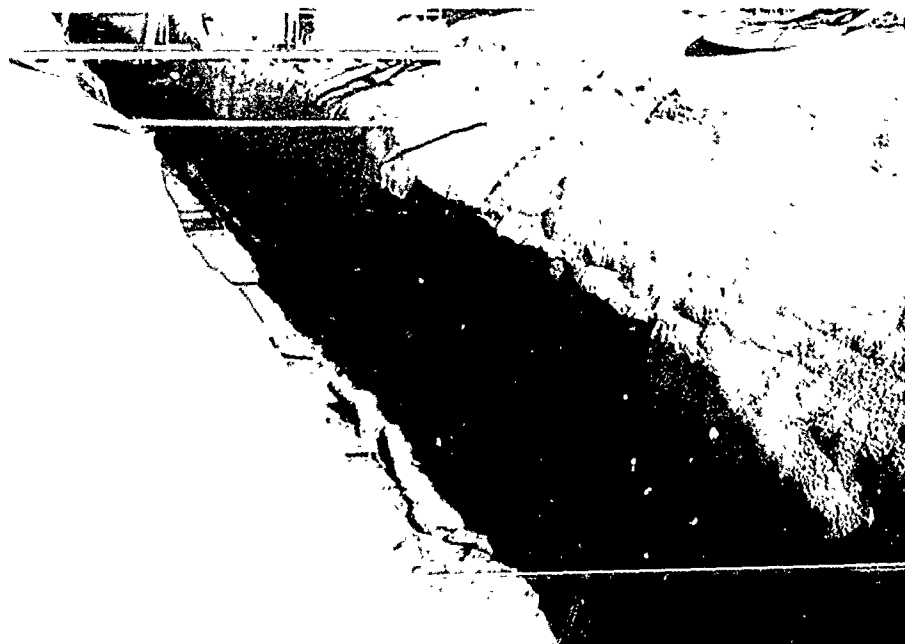


Figure 46. Same as above.

instructed to clean loose and drummy rock by jackhammer and to make final cleanup with compressed air before placement of concrete.

h. **Safety Protection Against Slides and Rock Falls.** Slopes excavated to design grade were generally not steep enough to require special protection against slides and rock falls.

5. **PILE DRIVING AND SPECIAL FOUNDATIONS.** No special foundations, such as driven piles, caissons, or drilled piers were utilized.

6. **TUNNELS, SHAFTS, AND UNDERGROUND STRUCTURES.** The construction of this project did not include any tunnel shafts or underground structures.

7. **FOUNDATION ANCHOR TEST.** A foundation anchor test was performed 4 April 1983 at Station 34+93.5, 5 feet west of outlet works centerline. See Figures 47 through 50. The surface elevation was 531.3. The test was performed in the chute foundation area on a 12-foot anchor with test results shown on pages 19 and 20.

8. **CHARACTER OF FOUNDATION.**

a. **General.** The limited service spillway is founded in weathered clay shale of the Pawpaw Formation of Lower Cretaceous age. The outlet works conduit, chute, and stilling basin are founded on unweathered clay shale of the Pawpaw Formation. Except for the left abutment, the inspection trench was almost entirely in overburden with clays and silty clays predominating. The Woodbine Formation, the basal formation of the Upper Cretaceous, was exposed in the inspection trench in the left abutment. It consists of weathered reddish-brown sands, clays,



Figure 47. Pullout test. Stilling Basin.

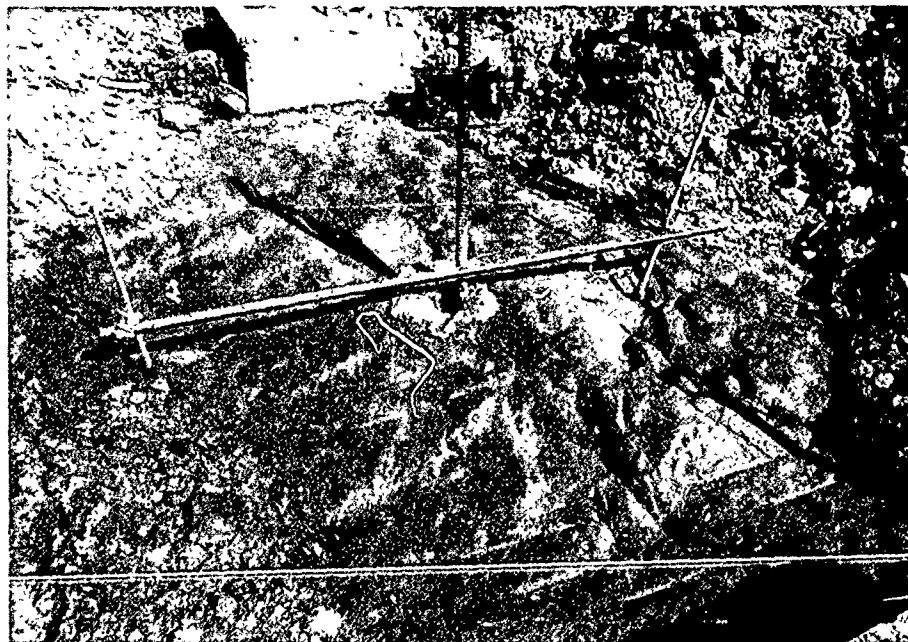


Figure 48. Same as above

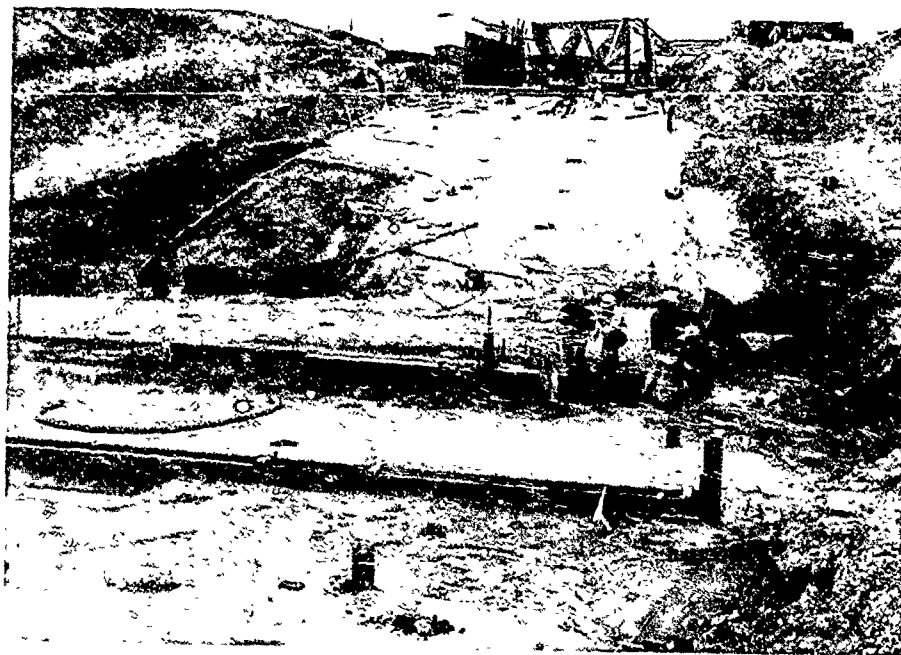


Figure 49. Pullout test. Stilling basin.



Figure 50. Same as above.

TEST NO. 1

<u>Time</u>	<u>Load In Tons</u>	<u>PSI</u>	<u>Deflection In Inches</u>
1044	0	0	.000
1044	5	930	.017
1049	5	930	.017
1050	12.7	2350	.026
1105	12.7	2350	.026
1105	17.7	3150	.035
1110	22.7		.046
1115	22.7		.046
1115	27.7		.059
1120	Stopped test - sag in "I" beam causing deflection in anchor bar.		

TEST NO. 2

<u>Time</u>	<u>Load In Tons</u>	<u>PSI</u>	<u>Deflection In Inches</u>
1137	5	930	.003
1142	5	930	.003
1142	12.7	2350	.015
1157	12.7	2350	.016
1157	17.7	3150	.023
1201	17.7	3150	.023
1201	22.7	4050	.034
1207	22.7	4050	.034
1207	27.7	4950	.045
1212	27.7	4950	.046
1212	32.7	5850	.060
1216	32.7	5850	.067
1216	36.0	6600	.075
1221	36.0	6600	.085
1222	32.7	5850	.085
1226	32.7	5850	.085
1226	27.7	4950	.078
1231	27.7	4950	.077
1231	22.7	4050	.068
1236	22.7	4050	.068
1236	17.7	3150	.057
1241	17.7	3150	.057
1241	12.7	2350	.043
1246	12.7	2350	.043

TEST NO. 2
(cont'd)

<u>Time</u>	<u>Load In Tons</u>	<u>PSI</u>	<u>Deflection In Inches</u>
1246	5	930	.018
1251	5	930	.018
1251	0	0	.000
1300	0	0	.000
1300	5	930	-.012
1305	5	930	-.012
1305	12.7	2350	.000
1310	0	0	.000
1310	5	930	-.006
1315	5	930	.000
Bar deflecting downward and horizontal under initial load.			
1320	5	930	.000
1320	12.7	2350	.016
1335	12.7	2350	.016
1335	5	930	.003
1340	5	930	.003
1340	0	0	-.006
1341	5	930	.001
1346	5	930	.001
1346	10	1820	.011
1351	10	1820	.011
1351	15	2750	.021
1356	15	2750	.023
1356	20	3650	.038
1401	20	3650	.038
1401	25	4550	.049
1406	25	4550	.050
1406	30	5450	.064
1411	30	5450	.064
1411	35	6300	.078
1416	35	6300	.083
1416	40	7200	.107
1421	40	7200	.109

Stop Test

and sandstones ranging from soft and friable to moderately hard.

b. **Character of Overburden Materials.** Overburden materials comprise the foundation for the embankment, in the outlet works approach and discharge channels, and in the approach and discharge channels for the spillway. Overburden materials exposed in the inspection trench and cutoff trench consist of alluvial clays, silts, sands, and gravels in the floodplain between Stations 105+00 and 136+00, and residual overburden on the abutments. Residual overburden consisting of clay and silty clay was exposed in the approach and discharge channels for the spillway. The outlet works approach and discharge channels were excavated in fluvial terrace and floodplain alluvial materials consisting of clay, sand, silt, and gravel.

c. **Character of Primary Materials.** The Pawpaw Formation comprises much of the foundation and was exposed in the outlet works and the spillway excavation. The Pawpaw is relatively level and finished grade was often on or near bedding planes. See Figures 13, 16, and 18. In the outlet works foundation, the clay shale is generally soft to moderately hard, unweathered, gray to dark gray and thin to medium bedded with scattered sandy seams and occasional sandstone seams north of Station 27+00. South of station 27+00 the clay shale contains up to 50 percent fine-to-medium grained sandstone and sandy seams. The base of the sandy phase was encountered at elevation 523, Station 36+15 in the chute foundation. A 2- to 3-inch thick fossiliferous zone was exposed near the base of the chute at elevation 520.0. Excavation,

cleaning of shale surfaces, and placement of fill are shown in Figures 51 through 64. The stilling basin foundation surface was described as shale, soft, slightly sandy with occasional sandy pockets and zones, fossiliferous, gray. See Figures 63 and 64.

The sill foundation for the limited use spillway was excavated down to a sandy, stiff, yellowish-brown to light gray clay, underlain by about 3 feet of gravelly clay. The edges and narrow sections in the middle, horizontal part of the foundation were keyed into weathered shale of the Pawpaw Formation. The approach and discharge channels were excavated in sandy clay. See Figures 27, 28, and 29.

9. FOUNDATION TREATMENT. No grouting was necessary at the project and no dental concrete or broom grouting were utilized.

10. FOUNDATION INSTRUMENTATION.

a. General. The instrumentation program at Ray Roberts Dam was designed to monitor five basic areas which are discussed below. A plan of instrumentation is shown on Plate 57. The following descriptions are taken from "Periodic Inspection No. 1, Ray Roberts Lake, July 1987."

(1) Initial Embankment and Closure Section. Nineteen piezometers were installed to monitor pore pressure development in the floodplain foundation during construction of the initial embankment and closure section. Settlement gages (12 deep settlement plates and 3 foundation surface settlement plates) were installed to monitor vertical movement of the foundation in the floodplain, and 8 surface

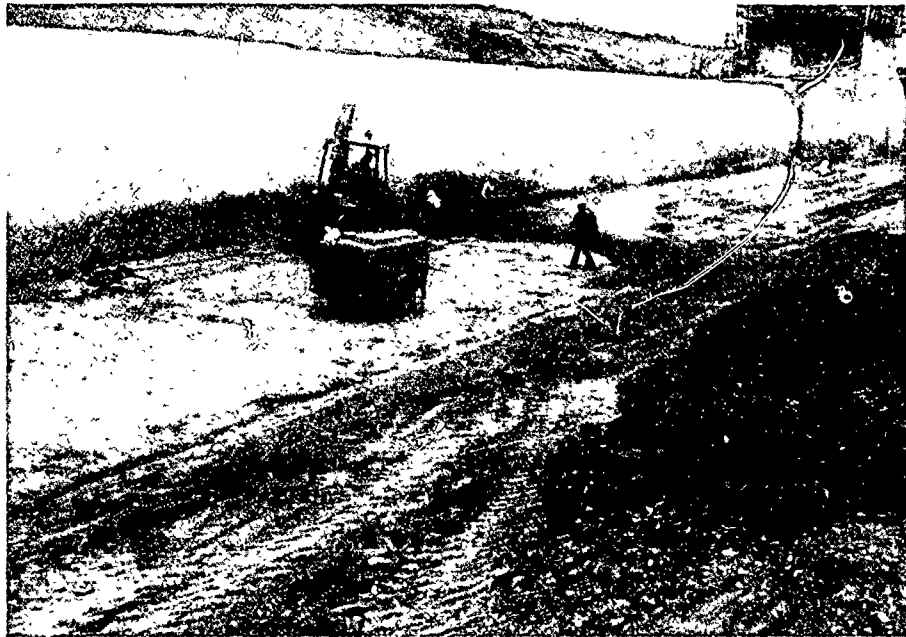


Figure 51. Outlet works, left side looking upstream. Fresh shale surface prior to placement of impervious material.



Figure 52. Same as above.

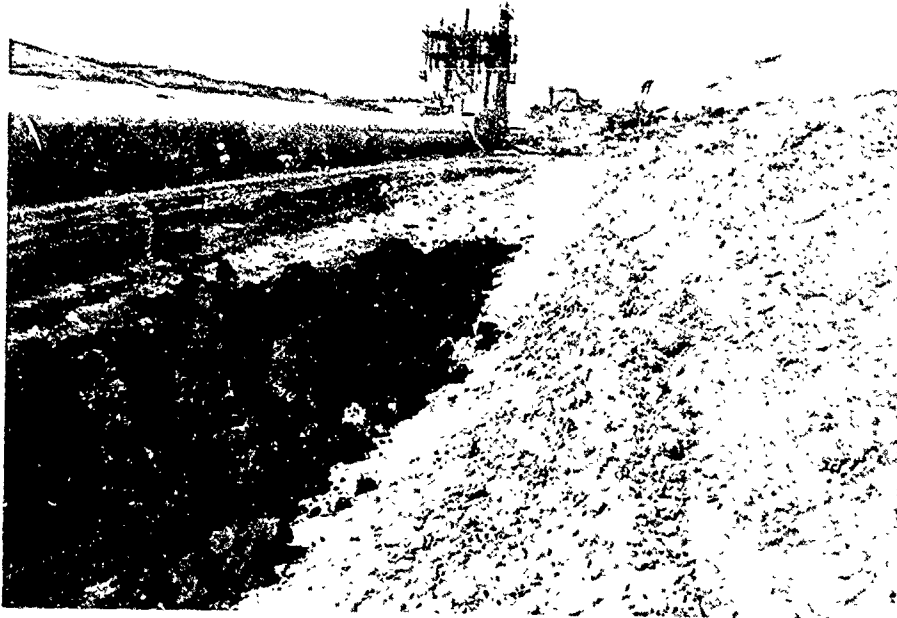


Figure 53. Outlet works conduit, left side, looking upstream. Placing fill on fresh shale surface.

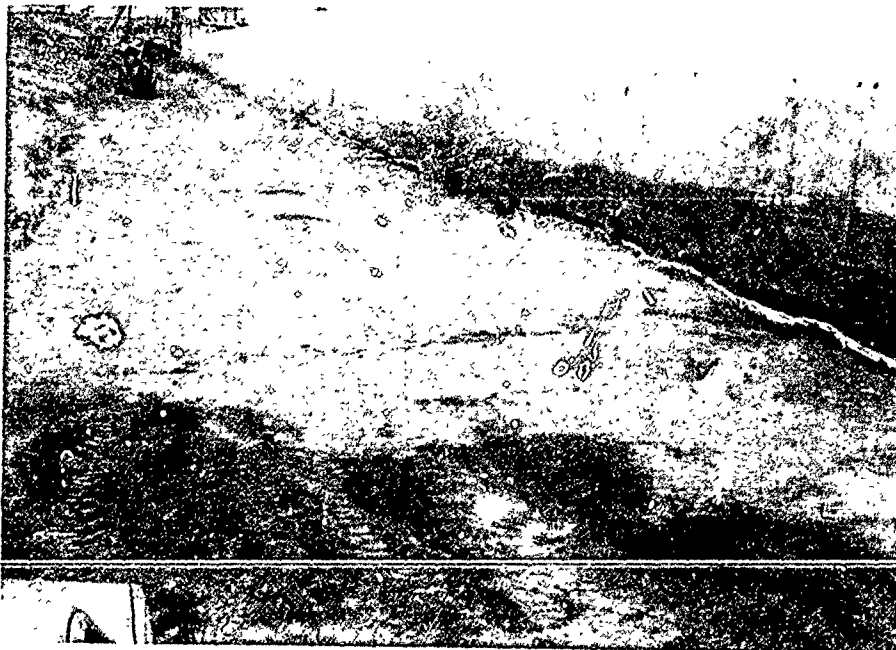


Figure 54. Outlet works conduit, right side, looking upstream. Fresh shale adjacent to conduit.

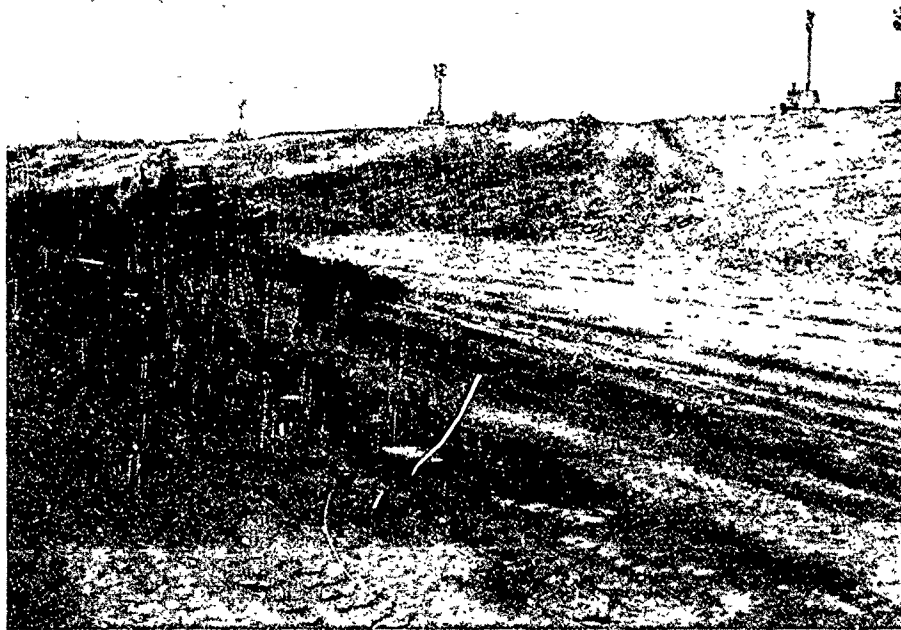


Figure 55. Outlet works excavation, right side looking downstream. Placing fill on fresh shale surface.



Figure 56. Outlet works, right side, looking upstream. Fresh shale surface.

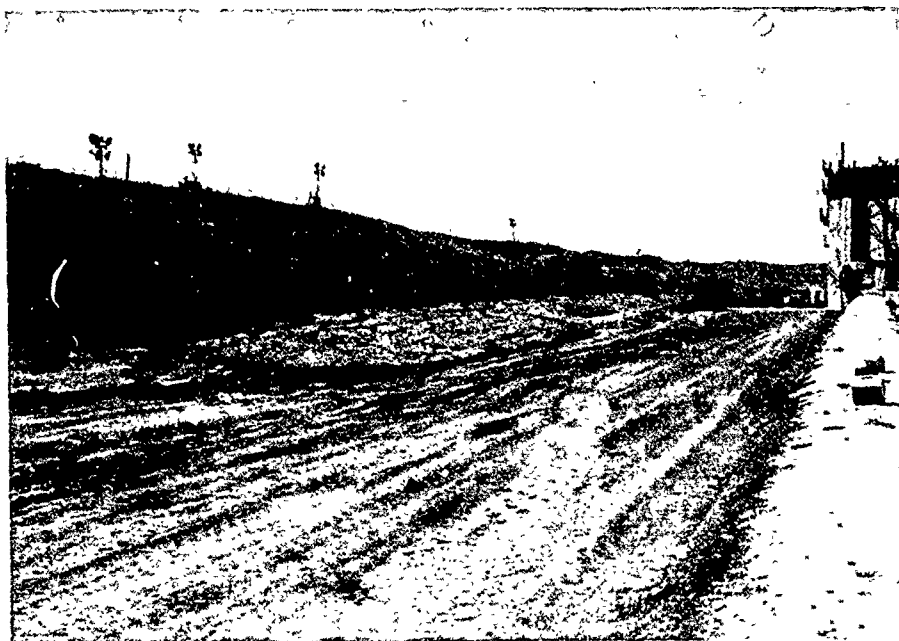


Figure 57. Outlet works, right side looking upstream. Cleaning shale surface in increments prior to placement of fill.

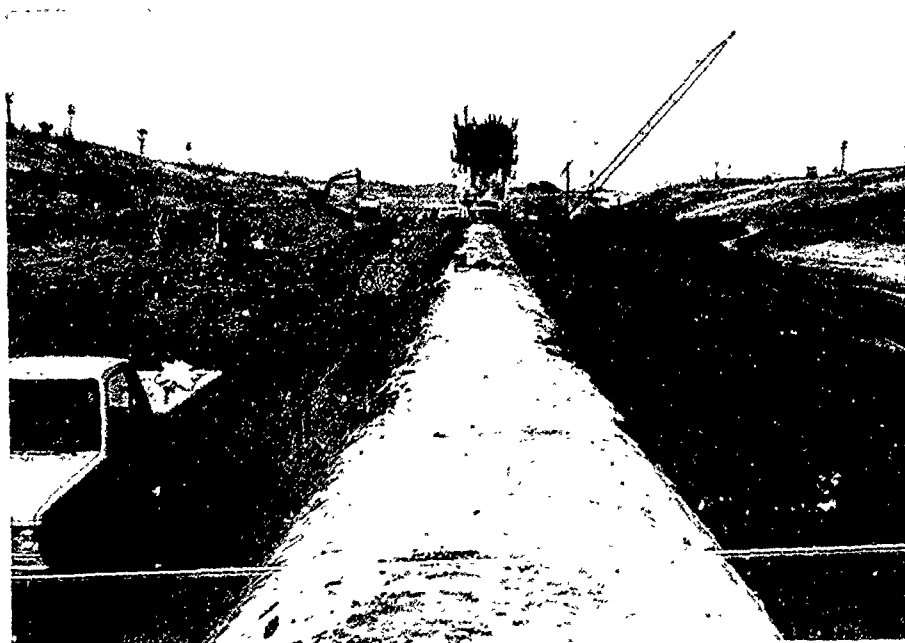


Figure 58. Outlets works conduit, looking upstream.



Figure 59. Outlet works looking downstream from tower.



Figure 60. Same as above.



Figure 61. Outlet works, right side, looking downstream. Cleaning shale surface prior to placement of fill.



Figure 62. Same area as above.



Figure 63. Stilling basin. Spraying aerospray.



Figure 64. Excavation for discharge from valve vault.

reference marks were provided to monitor embankment movement. Twelve inclinometers were installed to measure lateral displacement of the foundation during construction of the initial embankment and closure section. Of primary concern in planning the instrumentation program was the performance of the initial embankment which was designed to preload and consolidate the floodplain soils.

(2) **Left Abutment.** Nine piezometers were installed to monitor potential seepage effects at the left abutment (the upper portion of the abutment consists of pervious strata) including uplift pressures acting on the downstream portion of the embankment.

(3) **Embankment Underseepage.** Twenty-six seepage piezometers were installed in the embankment foundation to monitor underseepage.

(4) **Outlet Works.** To monitor movement of the outlet work structure, reference pins were installed within the conduit, on the stilling basin walls, and on the service bridge.

(5) **Embankment Crest.** A set of embankment station monuments has been installed along the downstream side of the crest to monitor post-construction settlement.

b. **Schedule of Instrumentation Reading.** Instrumentation located at the project will be read by CESWF-ED-G personnel according to the following schedule, or more frequently, if deemed necessary.

- o Piezometers - quarterly
- o Inclinometers - annually
- o Seepage Interceptor - monthly and when pool reaches 580, 590, 600, and 632.5

- o Settlement Gages - quarterly and when pool reaches 580, 590, 600, and 632.5
- o Outlet Works Reference Pins - semiannually
- o Embankment Reference Marks - quarterly

c. **Settlement Plates and Deep Settlement Plates.** Settlement Plates SP-1 through SP-3, and deep settlement Plates DSP-1 through DSP-12 were installed in the floodplain foundation prior to and during initial embankment construction to monitor foundation settlement. Settlement plates consist of a 36-inch square, $\frac{1}{4}$ -inch thick steel plate placed within the foundation materials and welded to a steel riser pipe extended through the embankment fill.

d. **Inclinometers.** I-1 through I-12 were installed within the floodplain embankment foundation prior to construction of the initial embankment to monitor horizontal deflection within the foundation. To provide a fixed frame of reference, all inclinometers were anchored in the primary clay shale. Inclinometers consist of a 3.34-inch diameter grooved ABS casing manufactured by Slope Indicator Company, Seattle Washington. Inclinometers were extended through the fill and steel casing.

e. **Piezometers.** Piezometers P-1 through P-43b have been installed within the embankment foundation materials to monitor foundation performance during construction and after impoundment. Open system piezometers utilizing porous plastic tips as manufactured by Slope Indicator Company, Seattle Washington, were installed using 3/8-inch diameter PVC risers and extended through the fill with steel casing.

Piezometers P-1 through P-19 were installed within the floodplain embankment foundation prior to construction of the initial embankment to monitor excess pore pressure development during construction. After embankment completion, piezometers P-20 through P-36 were installed on the downstream toe and slope within the sands and gravels overlying the shale. Piezometers P-37 through P-43b were installed after embankment completion, within the sandy abutment materials. All Piezometers (P-20 through P-43b) will monitor seepage within the foundation materials during and after reservoir filling.

f. **Surface Reference Marks.** Reference marks consisting of a brass monument, set into a 6-inch diameter pipe filled with concrete, were installed within the floodplain embankment to a depth of 5 feet to monitor vertical movement.

g. **Reference Pins.** Reference pins were installed along the outlet works conduit invert, stilling basin monolith walls, and service bridge. Reference pins which consist of bronze bolts embedded in concrete are used to monitor vertical movement of the monolith or slabs, and relative movement between monoliths or slabs.

h. **Seepage Interceptor System.** A seepage interceptor system has been installed within the left abutment embankment foundation to collect underseepage. The discharge is currently being monitored to record the normal ground-water flow. Flow from the system will be monitored, along with piezometers P-37 through P-43b, during impoundment when the pool reaches elevation 580, 590, 600, 620, and 632.5.

11. POSSIBLE FUTURE PROBLEMS. At the time foundations were approved and the dam completed in October 1986, no potential for future problems was apparent. The first periodic inspection was performed in July 1987. By that time several minor skin slides had occurred in the spillway approach channel slope. It was concluded that this problem could be easily remedied. Other minor problems are addressed in "Periodic Inspection Report No. 1, July 1987." The dam is considered to be in good general condition.

12. RECORD OF FOUNDATION APPROVAL. A record of the date when each section of the outlet works foundation was approved is shown on Plate 58. Records of approval of final foundation grades were kept for all foundations on which concrete was to be placed. The foundation for the emergency spillway was approved as a unit on 11 February 1984.



Figure 65. Outlet works, right side looking downstream. Cleaning shale surface in increments prior to placement of fill.



Figure 66. Placing fill.



Figure 67. Outlet works. Placing fill.

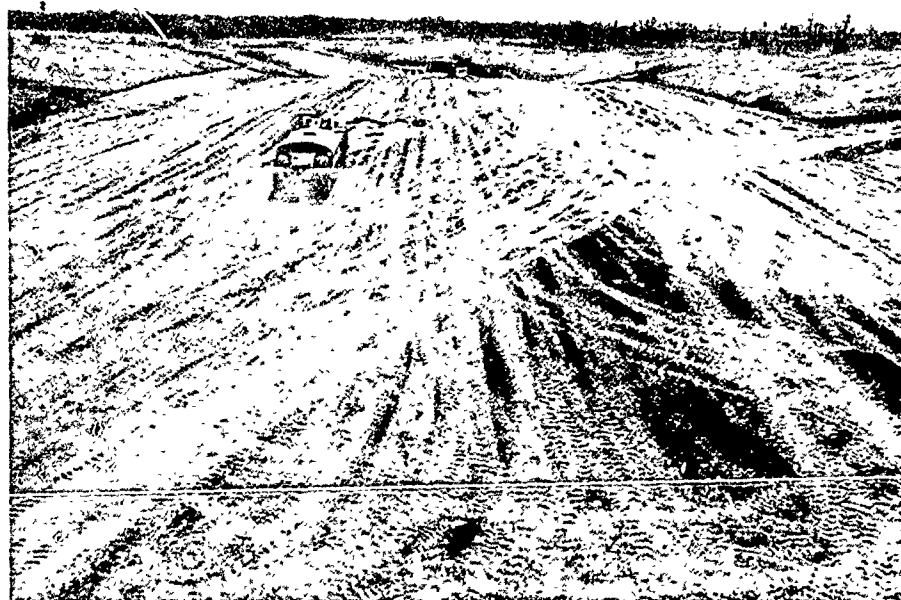


Figure 68. Outlet works backfill, looking downstream.



Figure 69. Excavation for valve vault.

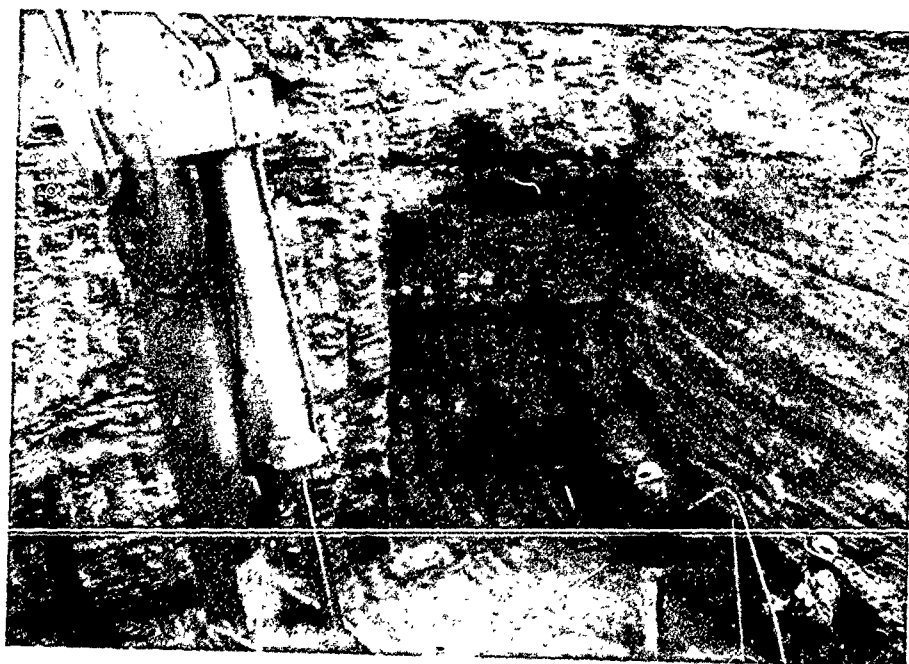


Figure 70. Same as above.

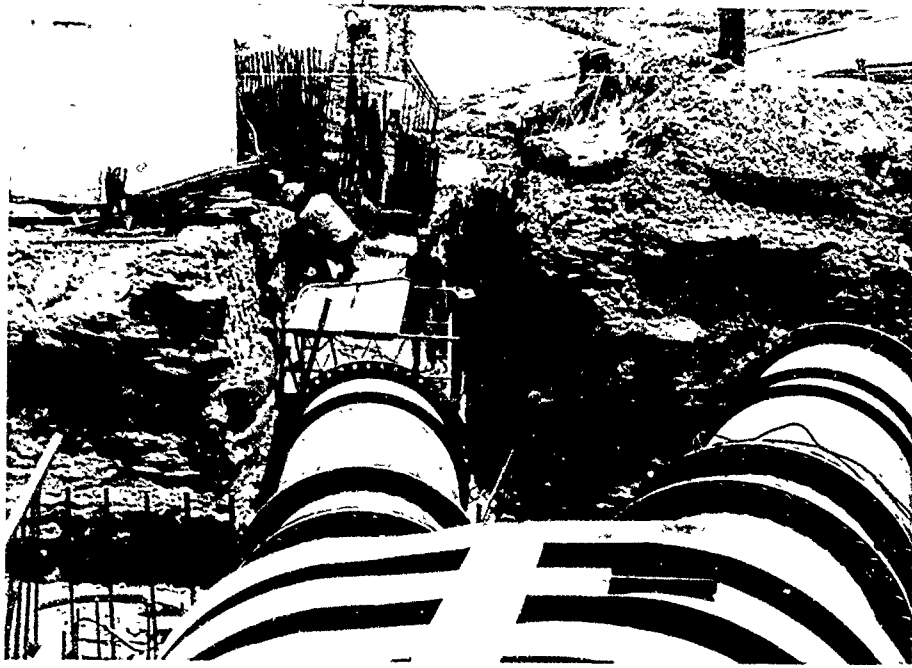


Figure 71. Discharge pipes from valve vault.



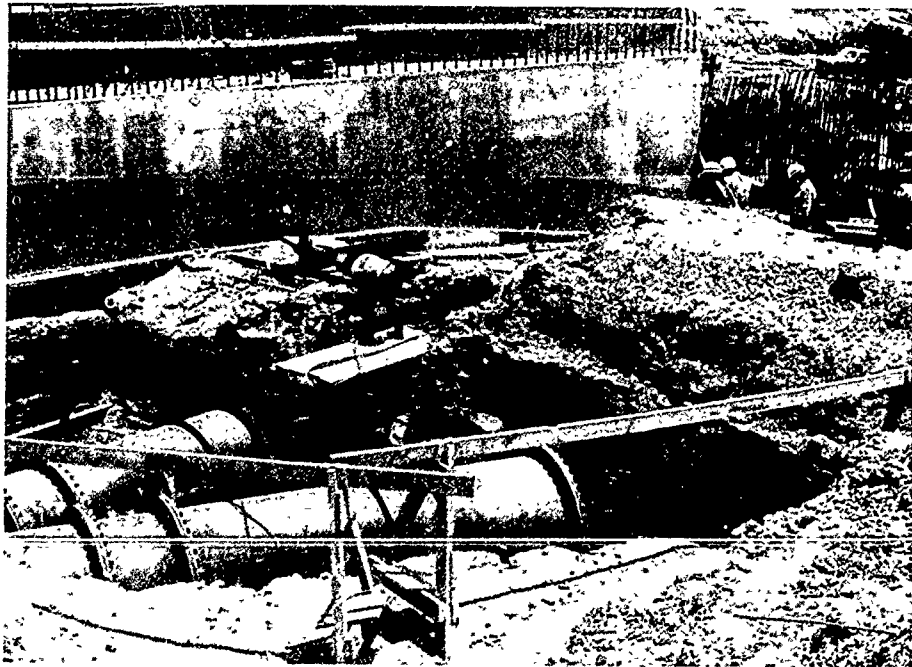


Figure 72. Same as above.

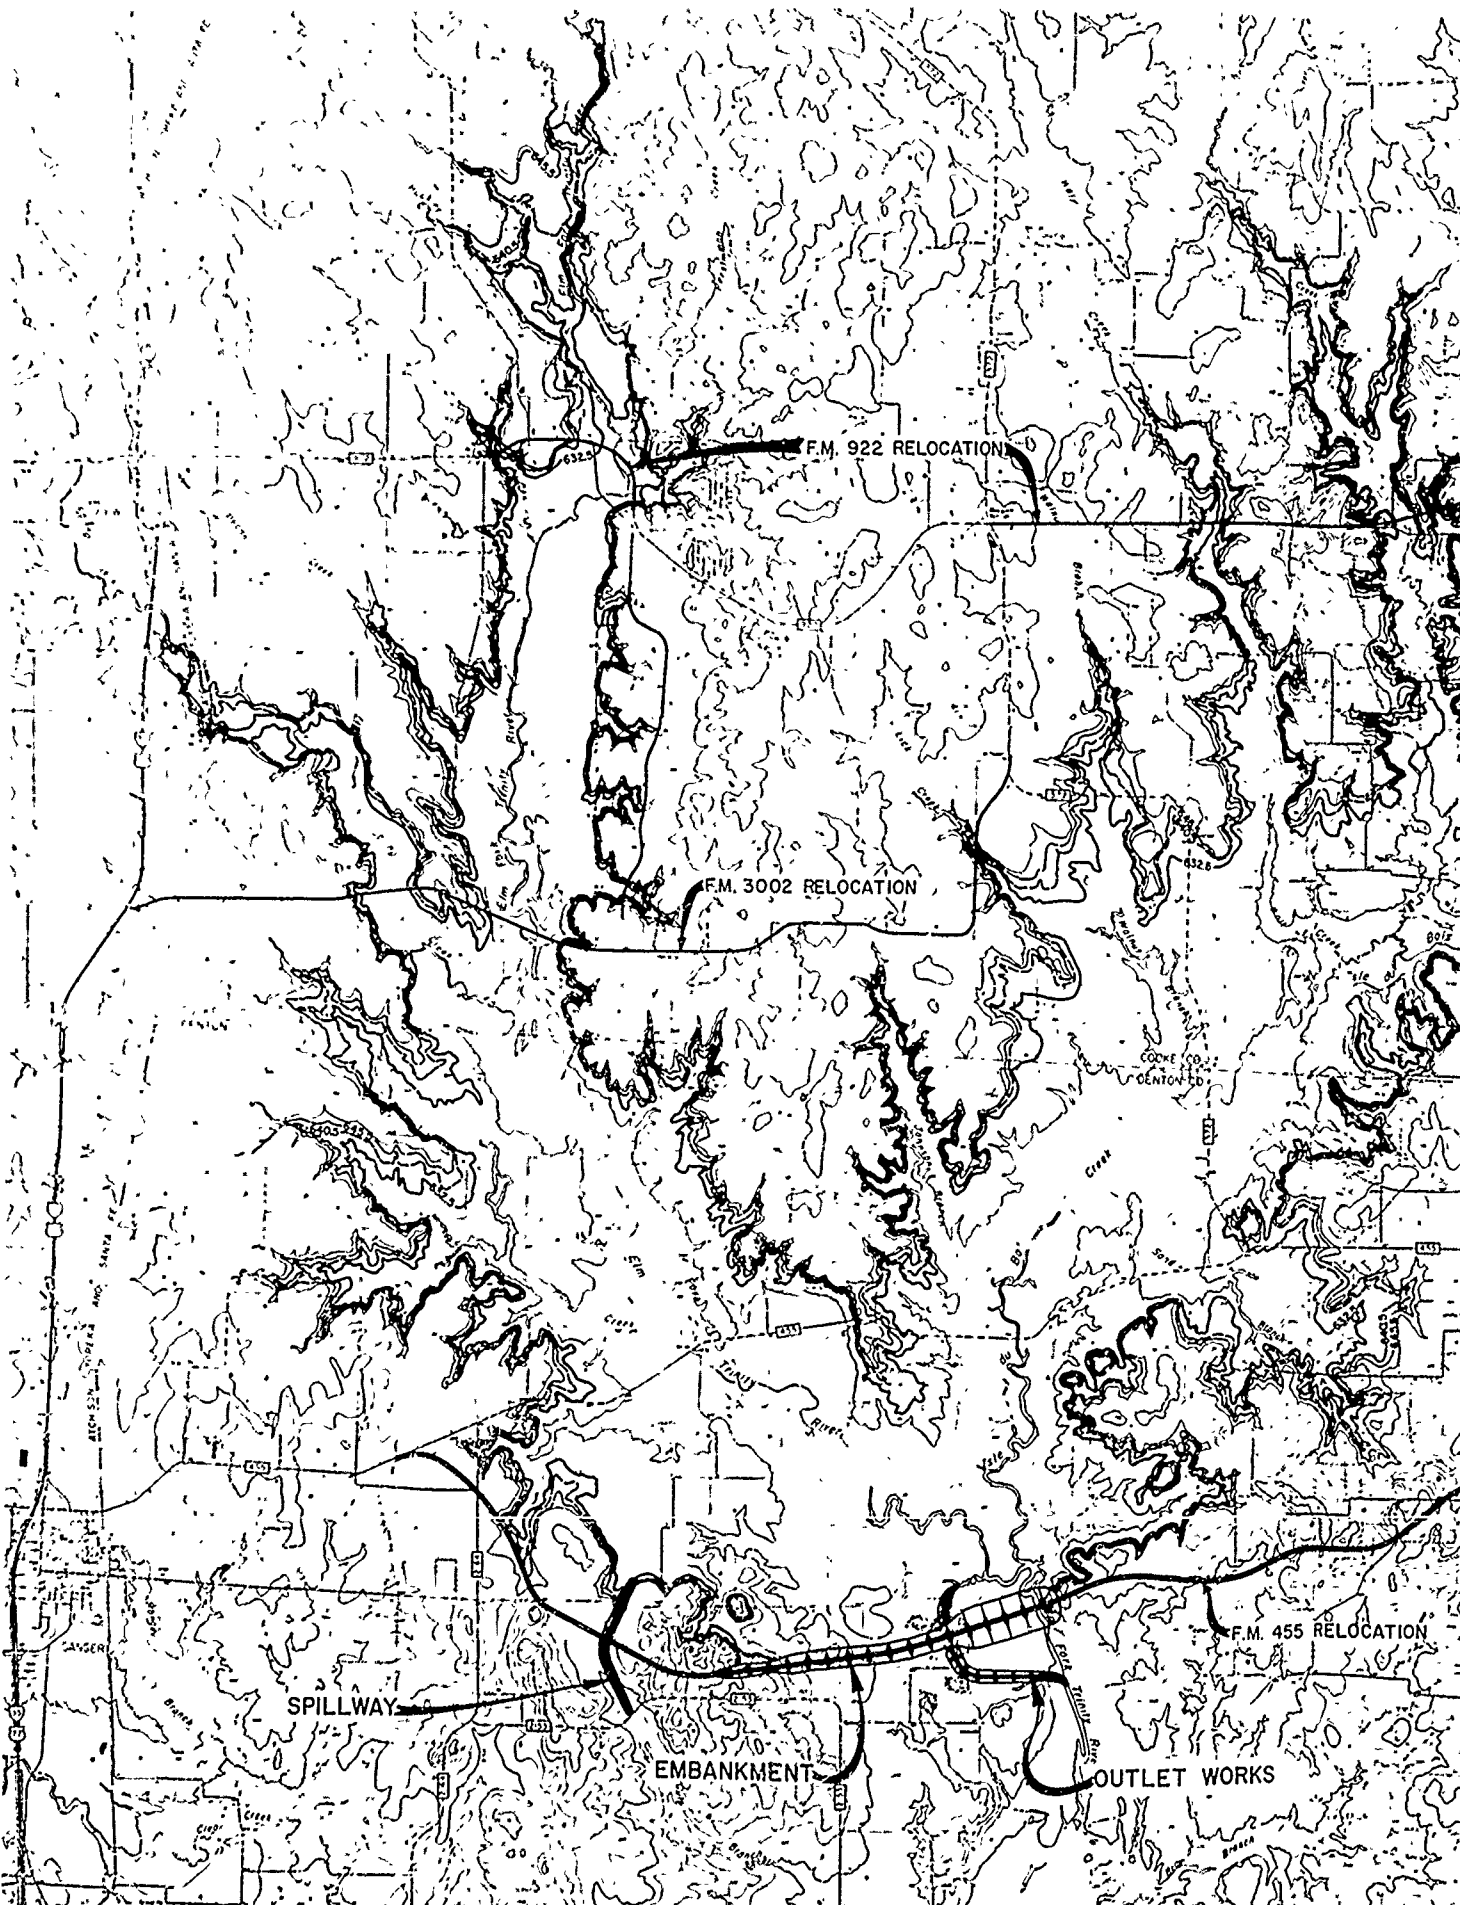


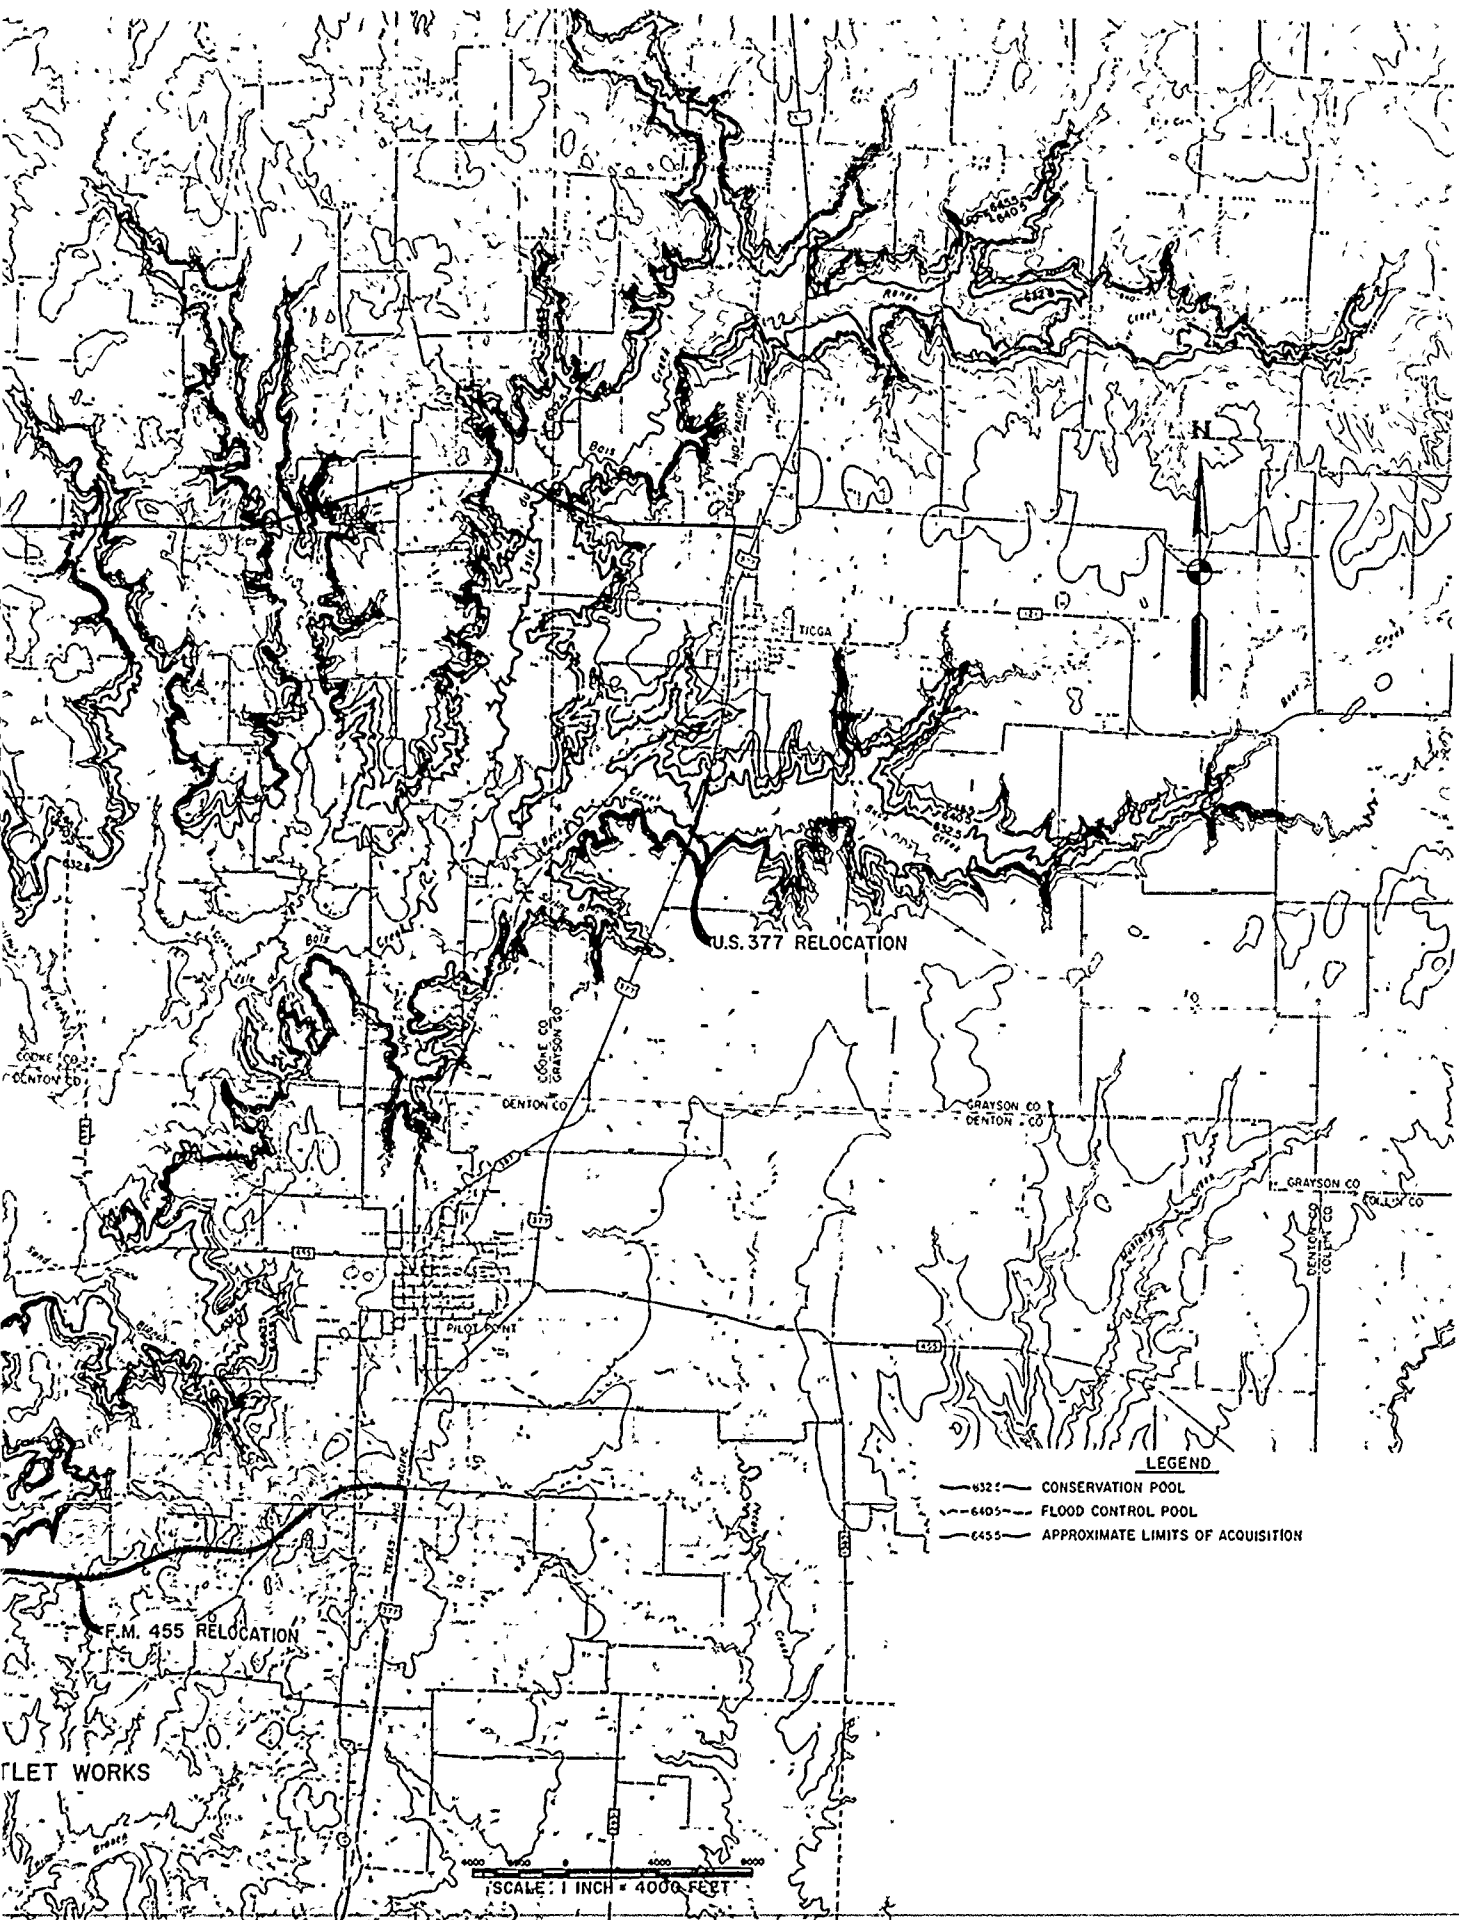


U.S. 377 RELOCATION

LEGEND

- 6322 — CONSERVATION POOL
- 6405 — FLOOD CONTROL POOL
- 6455 — APPROXIMATE LIMITS OF ACQUISITION


SCALE: 1 INCH = 4000 FEET

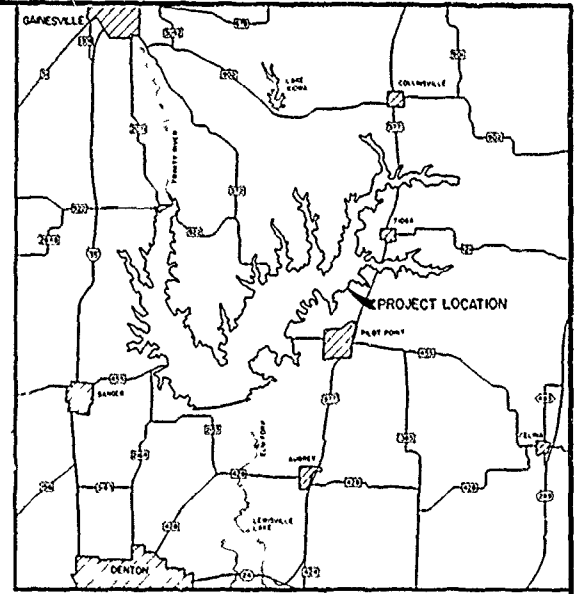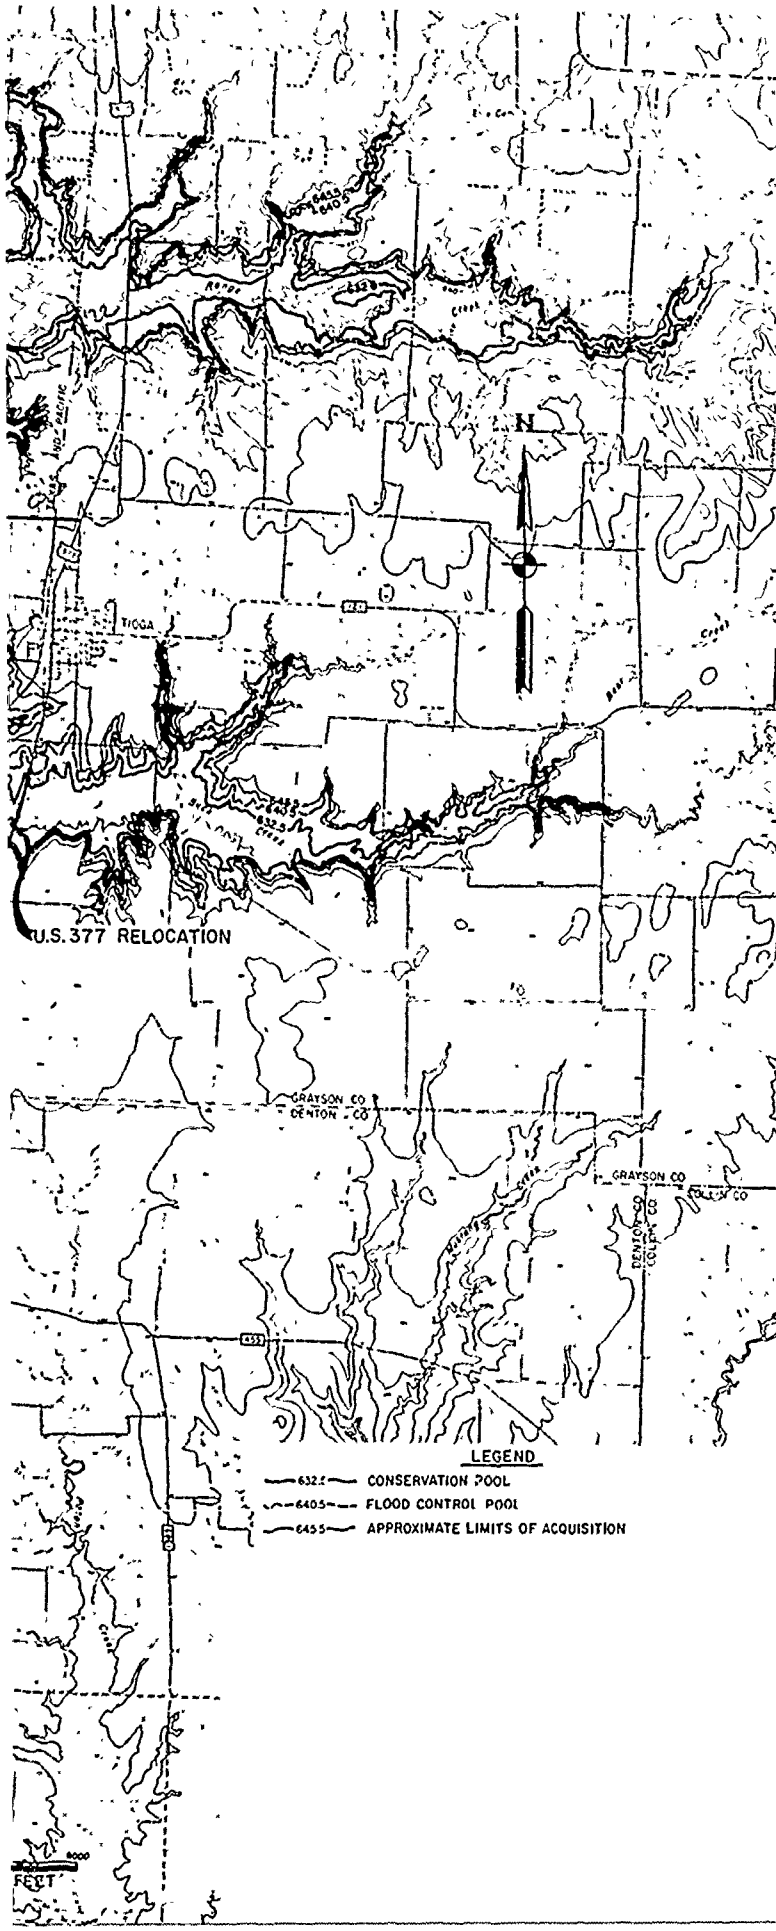

VICINITY MAP
SCALE: 1 INCH = 4 MILES APPROX.

SYM. OR. NO.	ACTION	DATE	DESCRIPTION OF REVISION
U.S. ARMY ENGINEER DISTRICT, FORT WORTH CORPS OF ENGINEERS FORT WORTH, TEXAS			
DESIGNED BY:	RAY ROBERTS LAKE ELM FORK, TRINITY RIVER, TEXAS FOUNDATION REPORT LAKE MAP AND VICINITY MAP		
DRAWN BY:			
REVIEWED BY:			
SUBMITTED BY:	INVITATION NO.	DATE:	
	CONTRACT NO.		

ATTACH 01

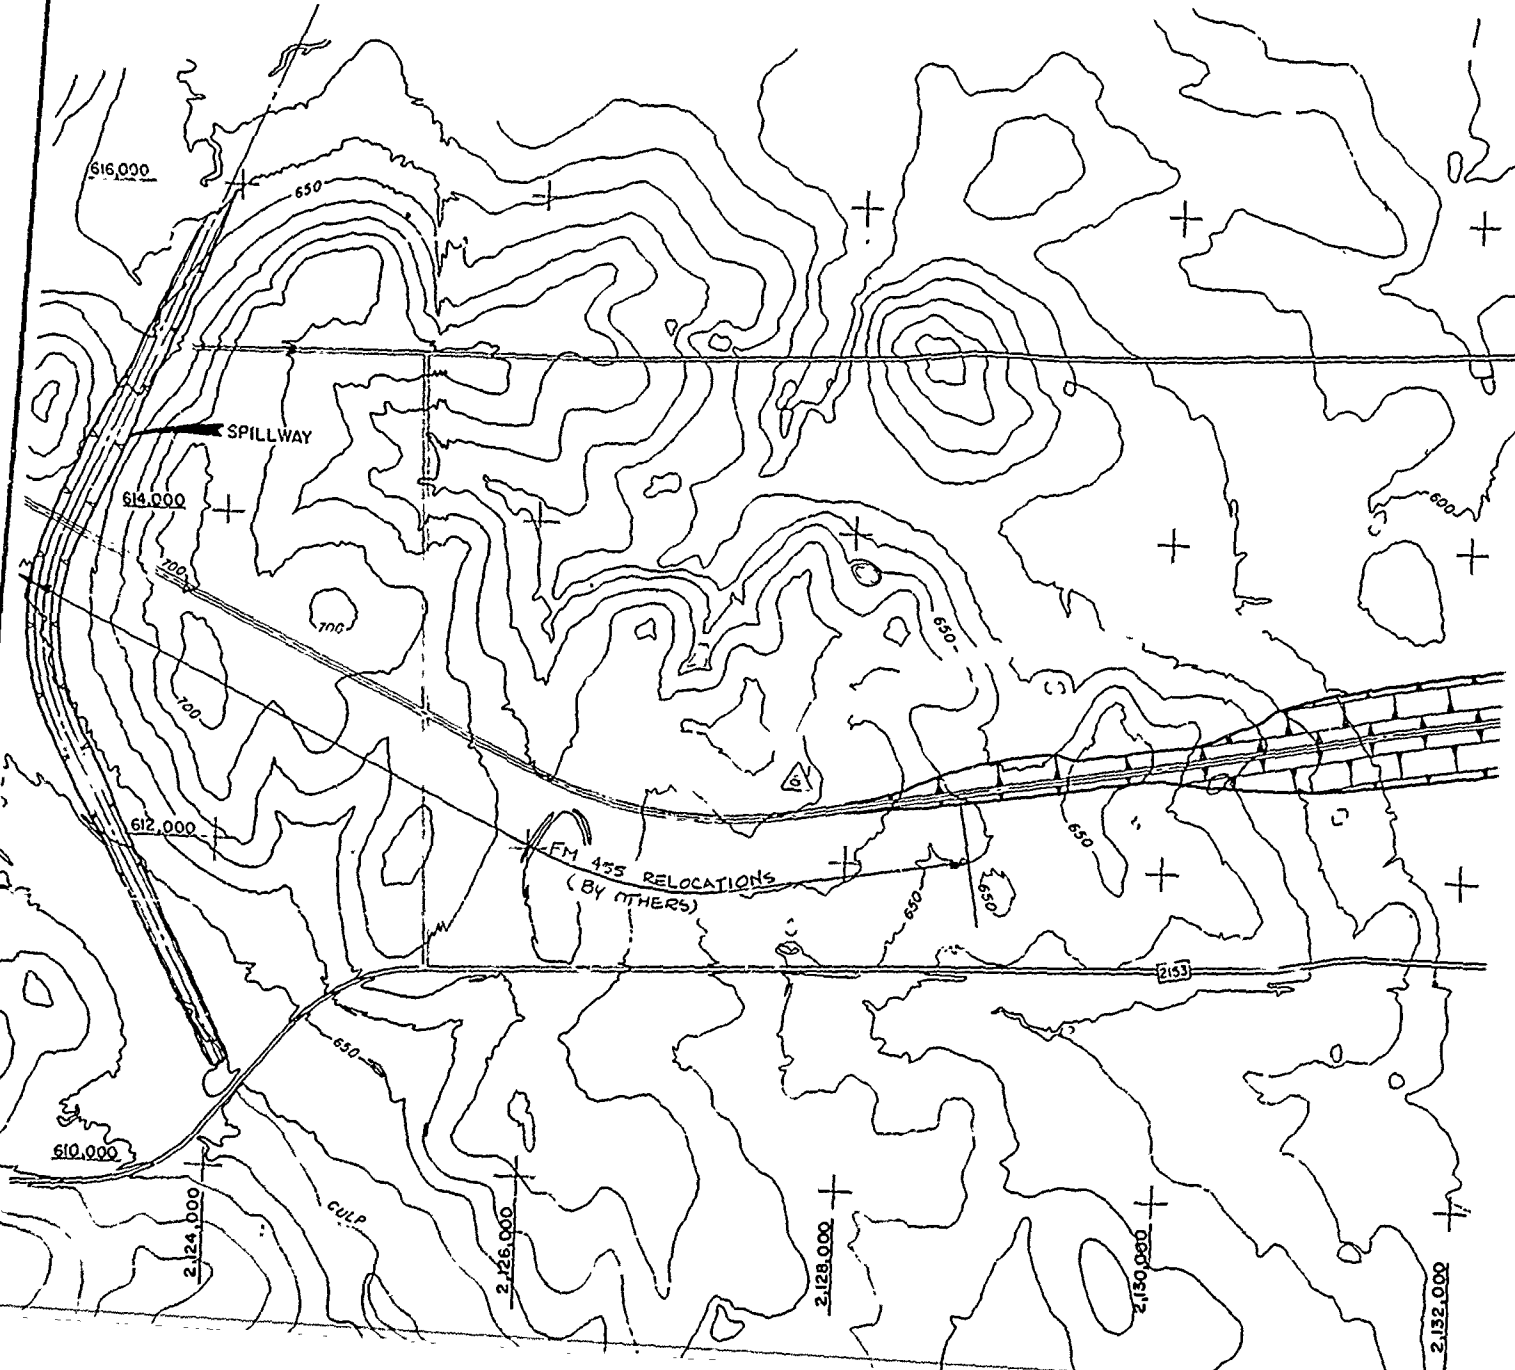

2,128,000

2,130,000

2,132,000

616,000

614,000

612,000

610,000

2,24,000

2,126,000

2,128,000


2,130,000

2,132,000


SPILLWAY

FM 455 RELOCATIONS
(BY OTHERS)

CULP

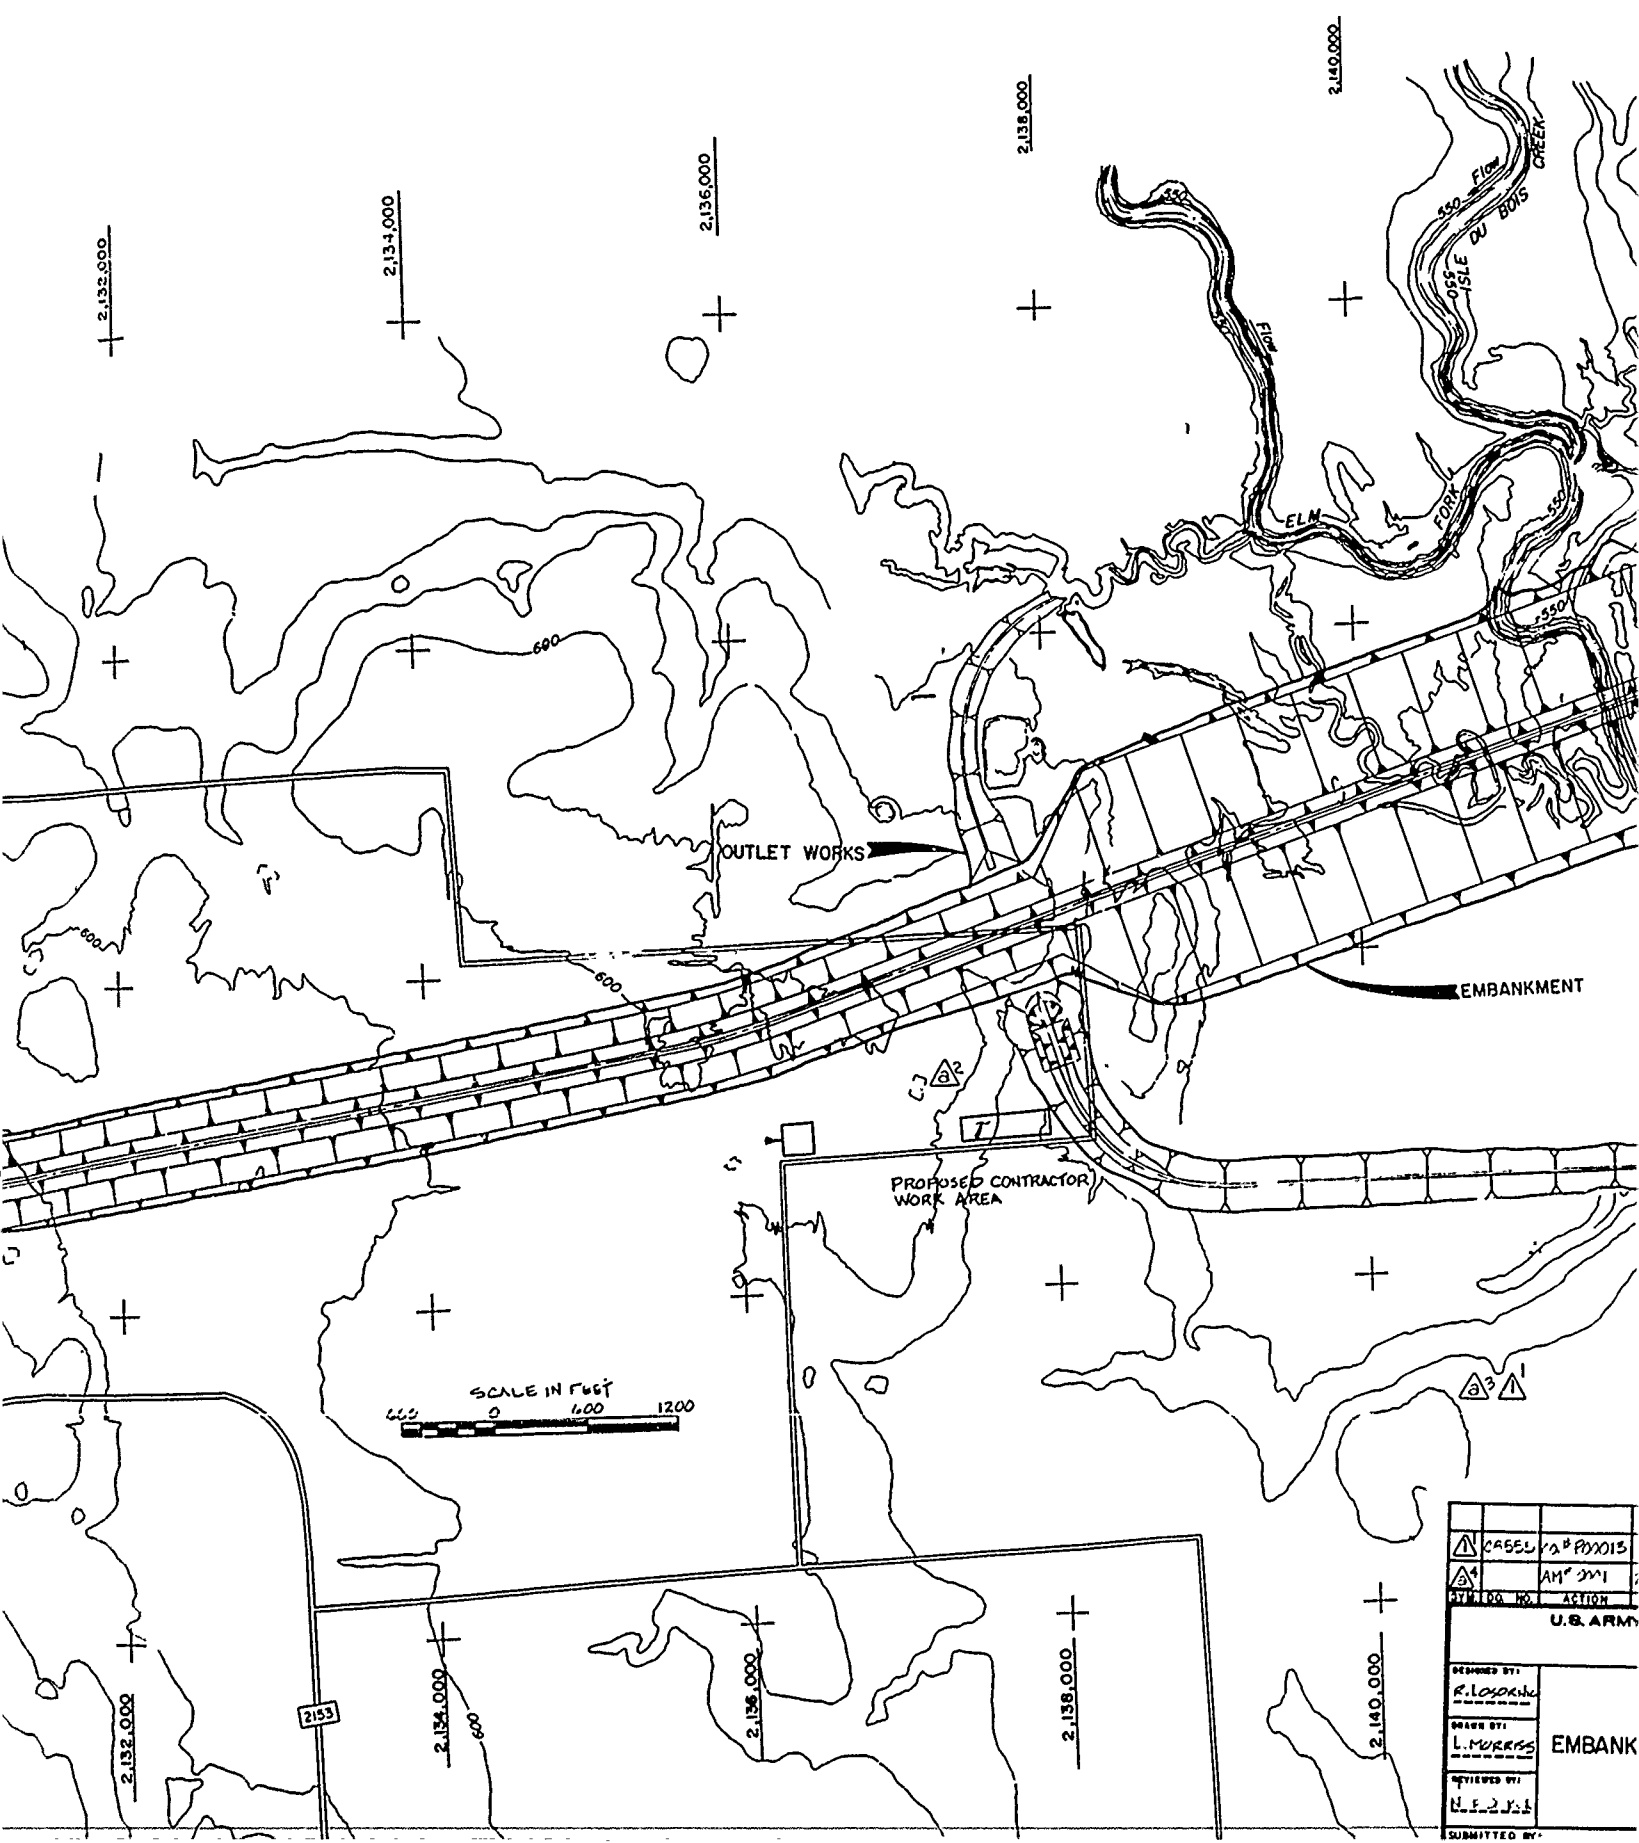

△	CASE NO. 2153
△	AM 211
△	ACTION
U.S. ARMY	
DESIGNED BY:	R. LOSORNE
DRAWN BY:	L. MURRES
APPROVED BY:	H. E. J. J.
SUBMITTED BY:	
EMBANK	

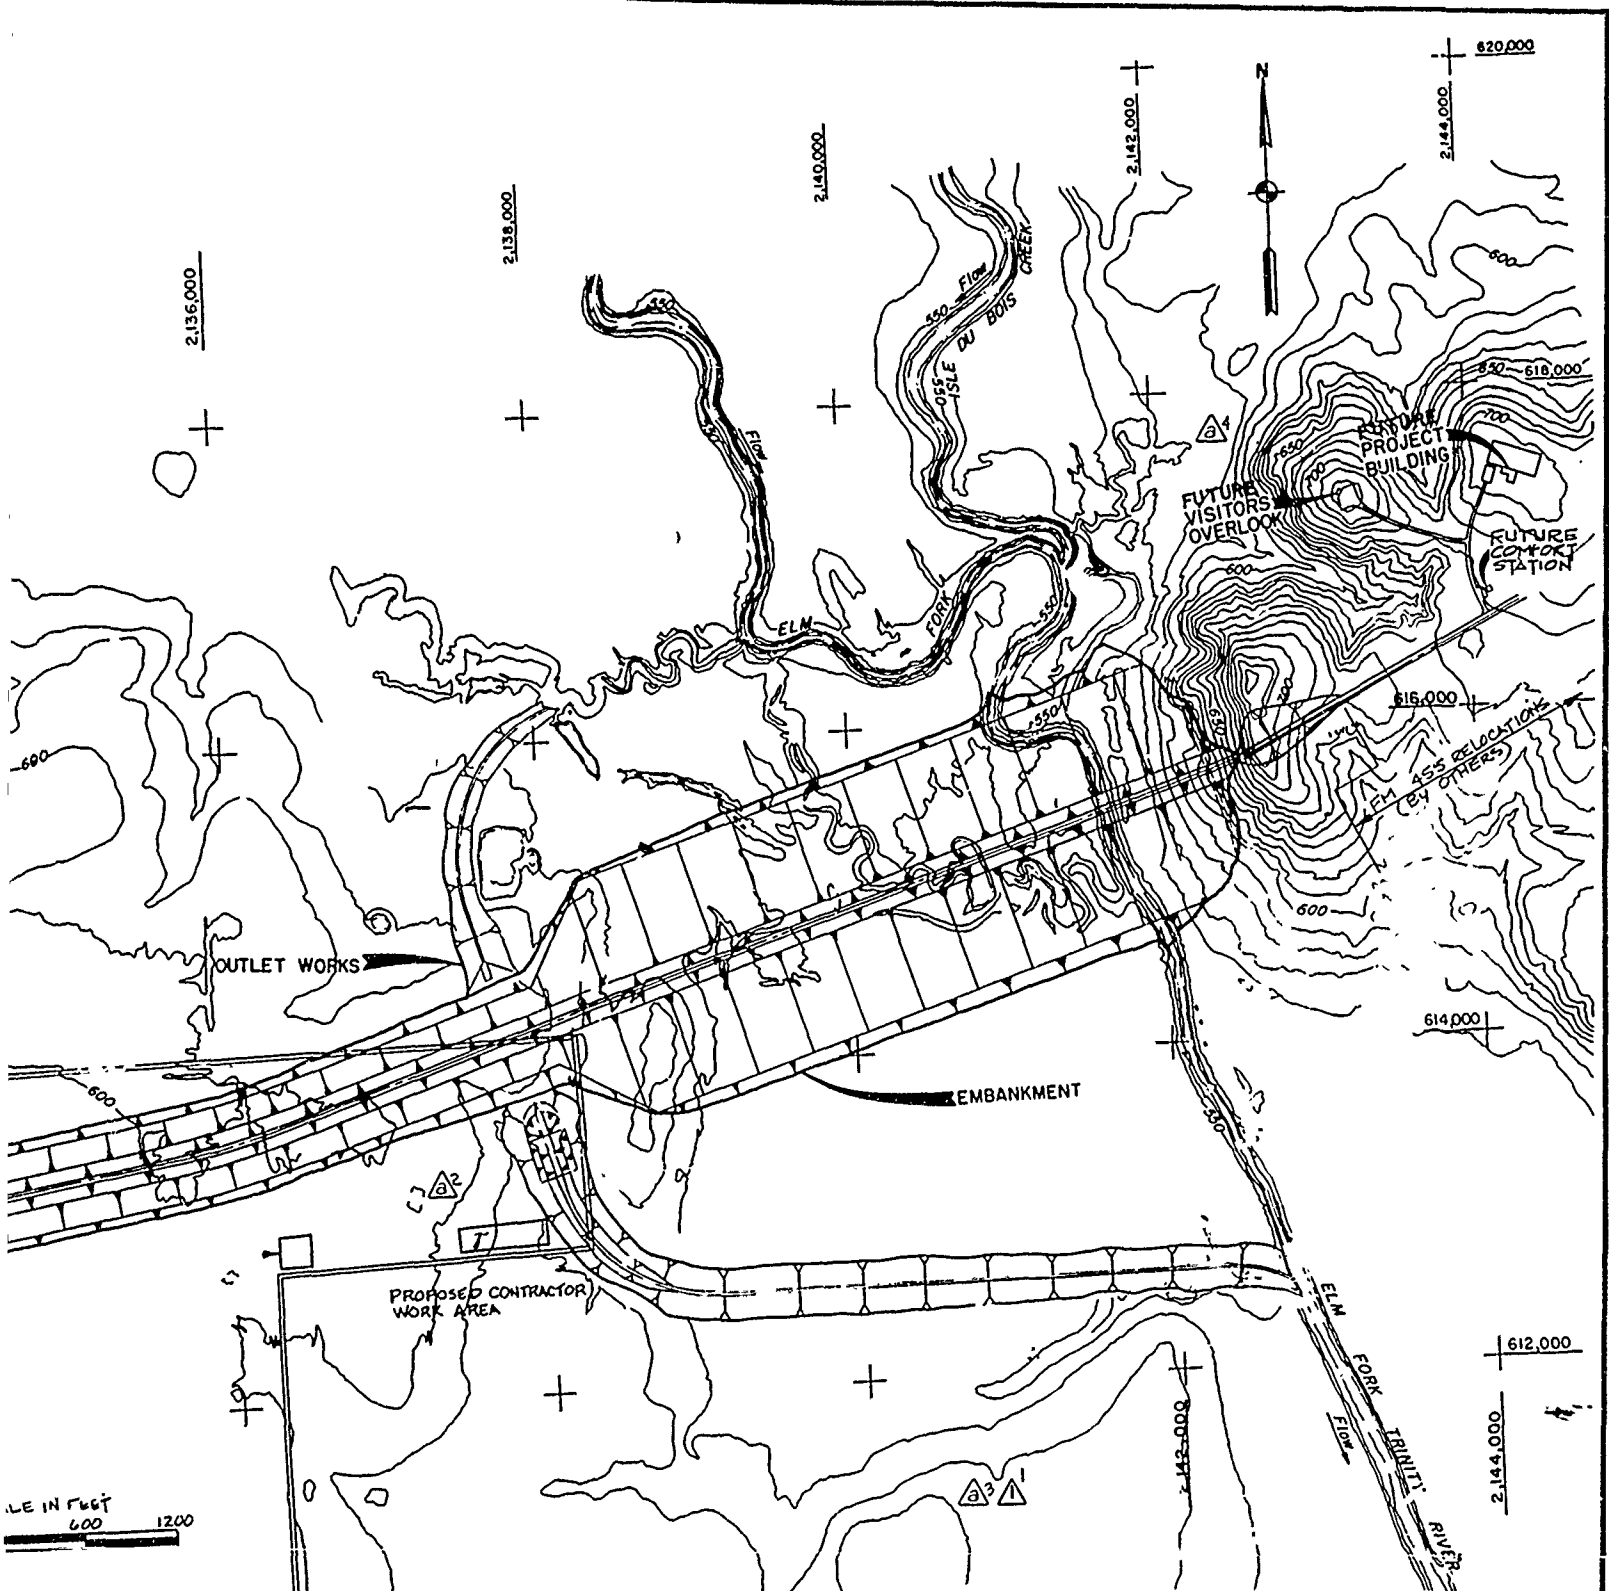

DESIGNED BY: R. LOSORNO	DATE: 10 FEB 84	REVISION: REVISED NOTE
DRAWN BY: L. MORRIS	DATE: 2 APR 82	REVISION: AUGDED NOTE & RELOCATED CONTRACTOR WORK AREA
CHECKED BY: L. F. J. J. J.	DATE:	REVISION:
SUBMITTED BY: L. F. J. J. J.	DATE:	REVISION:
U.S. ARMY ENGINEER DISTRICT, FORT WORTH CORPS OF ENGINEERS FORT WORTH, TEXAS		
RAY ROBERTS LAKE ELM FORK, TRINITY RIVER, TEXAS EMBANKMENT, SPILLWAY AND OUTLET WORKS GENERAL PLAN		
INVIATION NO.:	DATE:	DATE:
CONTRACT NO.:		


LEGEND

- 3F 3-INCH FISHTAIL BORING
- 8A 8-INCH AUGER BORING
- 3S 3-INCH SHELBY TUBE
- 4C 4-INCH CORE BORING
- 6C 6-INCH CORE BORING
- 6U 6-INCH DENISON BORING
- ==== COUNTY ROAD (GRAVEL)
- ==== FARM TO MARKET ROAD (PAVED)
- ⊗ GRAVEL PIT



- QAL ALLUVIUM
- QT FLUVIATILE TERRACE DEPOSIT
- KWB WOODBINE FORMATION
- KGY GRAYSON FORMATION
- KMS MAIN STREET FORMATION
- KPP PAWPAW FORMATION
- GEOLOGIC CONTACT (DASHED)
- ⊗ STOCK TANK

NOTES:

1. SEE PLATES III-6 THROUGH III-32 FOR DETAILED LOGS OF BORINGS.
2. GEOLOGY COMPILED FROM SUBSURFACE EXPLORATION AND SURFACE MAPPING.

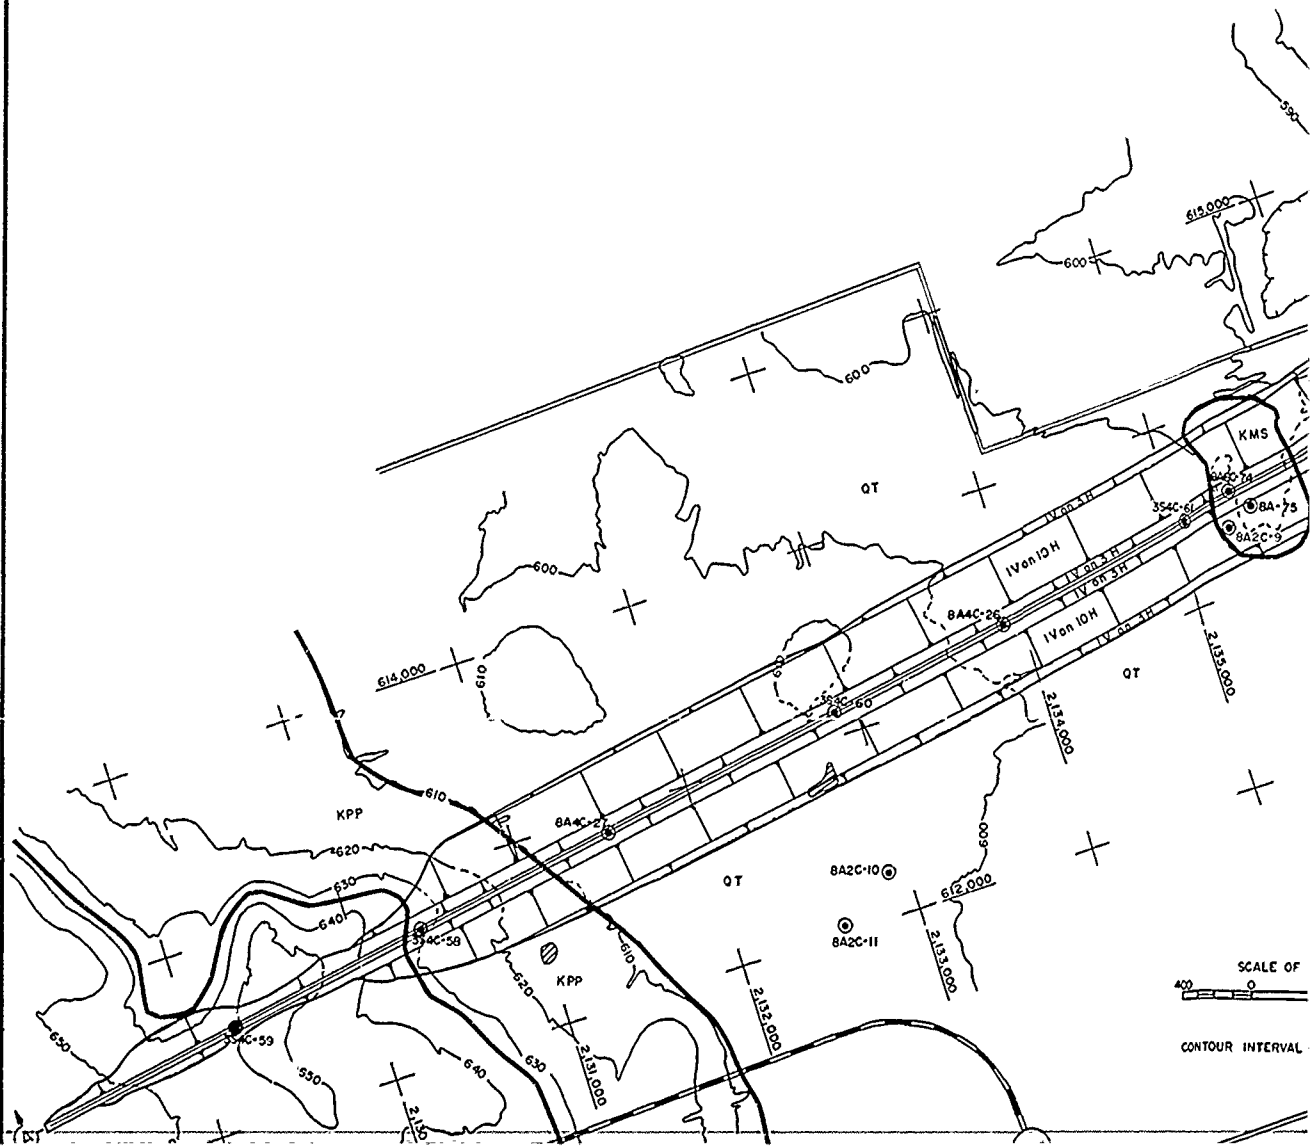



- ALLUVIUM
- FLUVIATILE TERRACE DEPOSIT
- WOODBINE FORMATION
- GRAYSON FORMATION
- MAIN STREET FORMATION
- PAWPAW FORMATION
- GEOLOGIC CONTACT (DASHED WHERE INFERRED)
- STOCK TANK

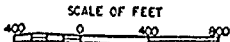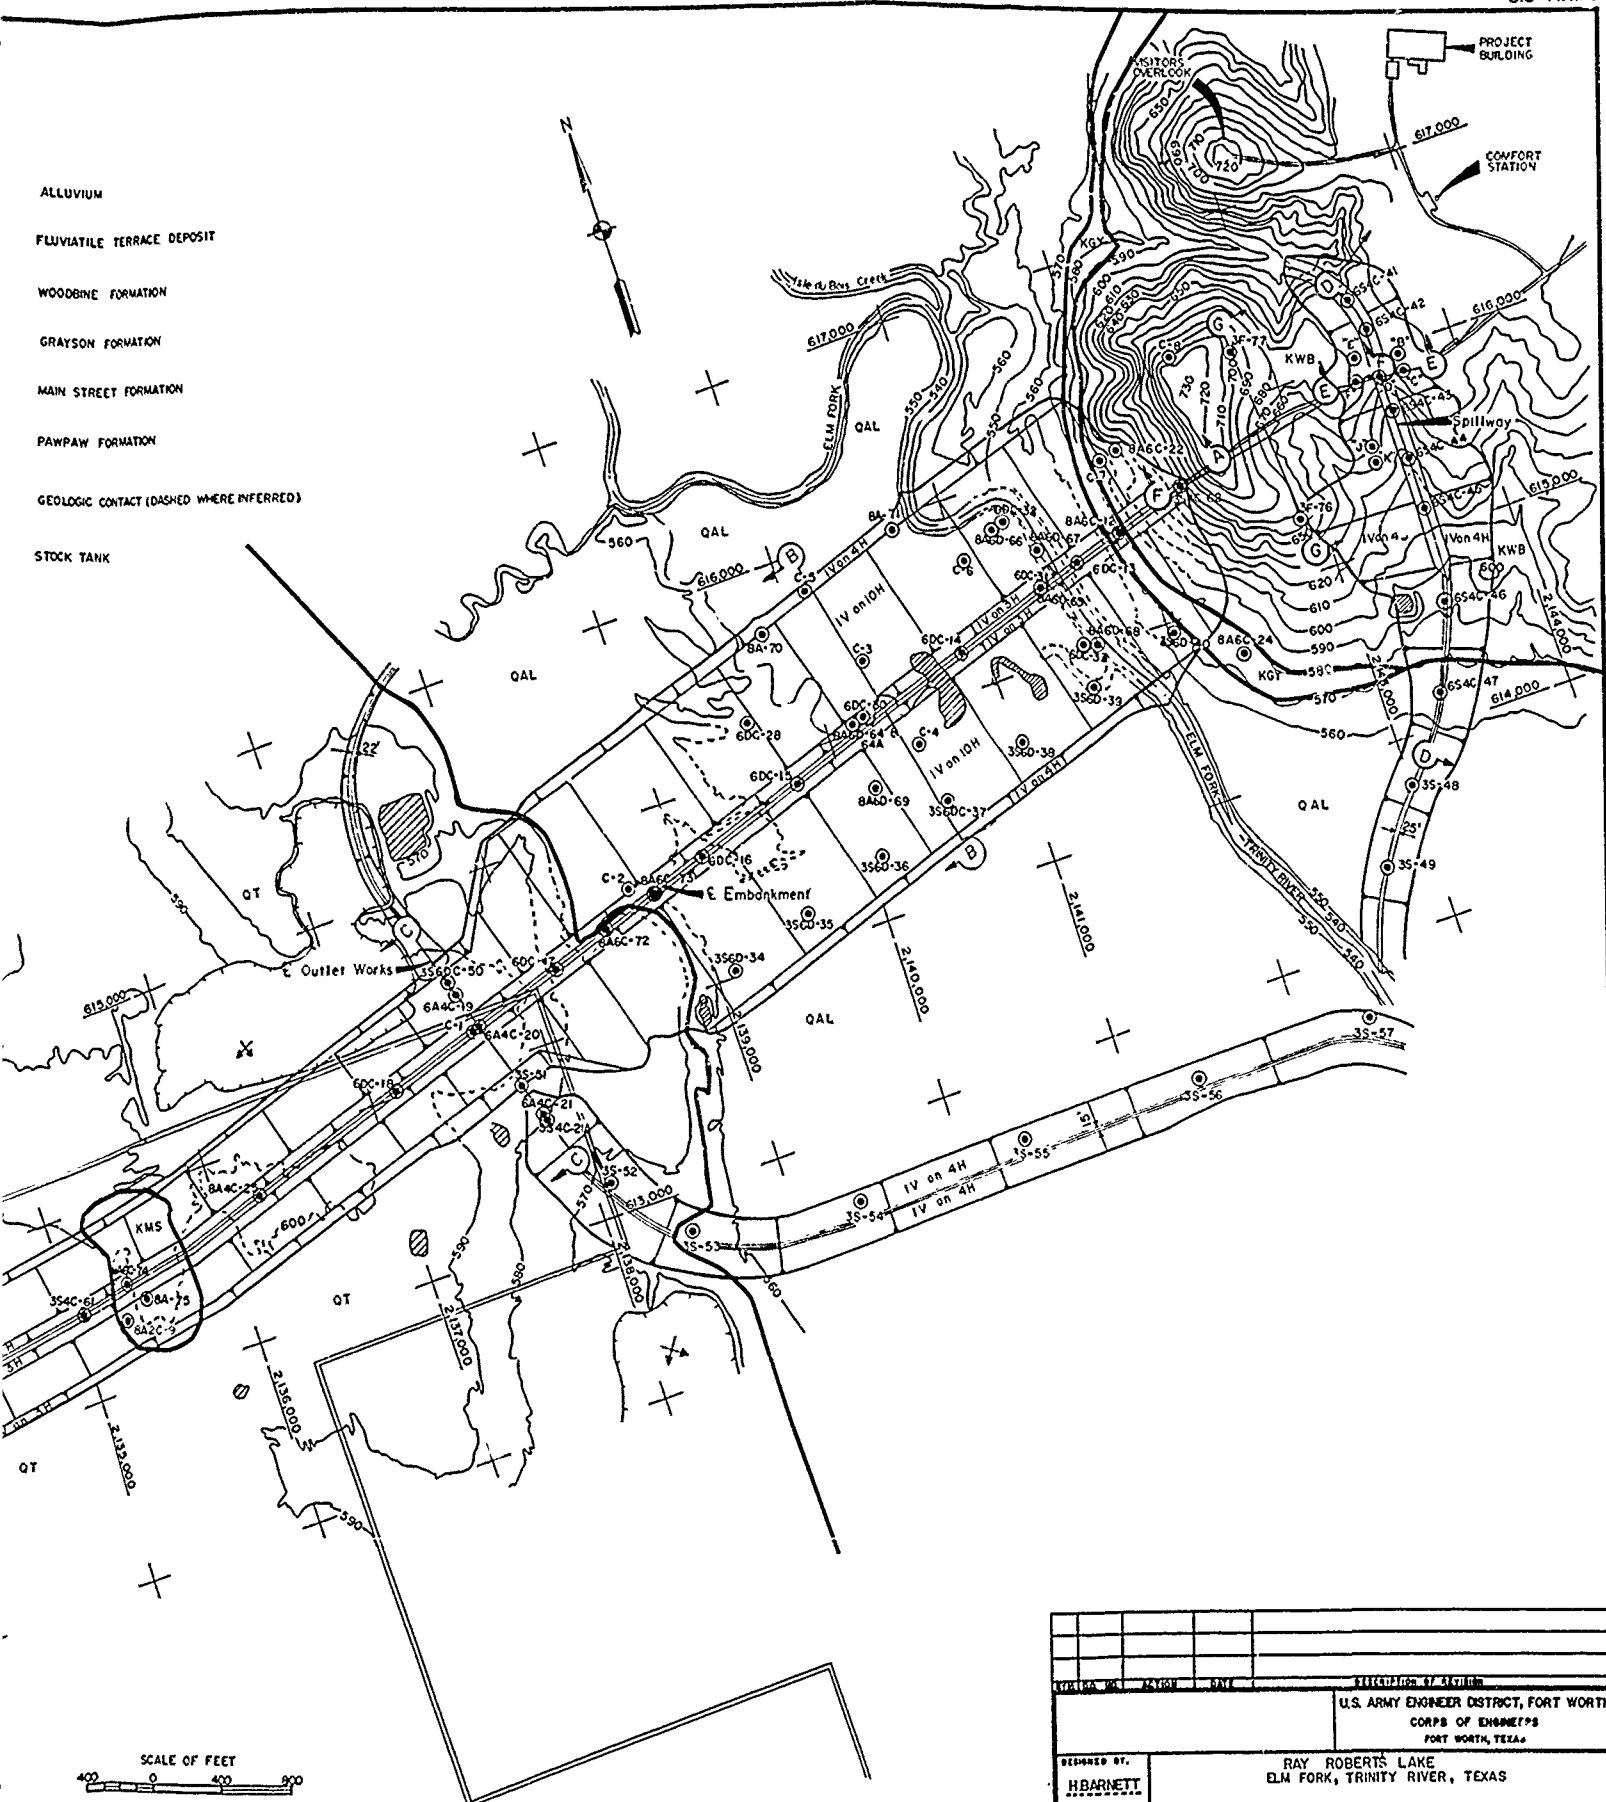


CONTOUR INTERVAL - 10 FEET


DESIGNED BY: H. BARNETT		RAY ROBERTS LAKE ELM FORK, TRINITY RIVER, TEXAS	
DRAWN BY: C. KIRBY		FOUNDATION REPORT	
REVIEWED BY: R. BEHM		DAM SITE GEOLOGY	
SUBMITTED BY: ROBERT C. BEHM		SOL. NO.	DATED:
		CONTR. NO.	REFERENCE NO.

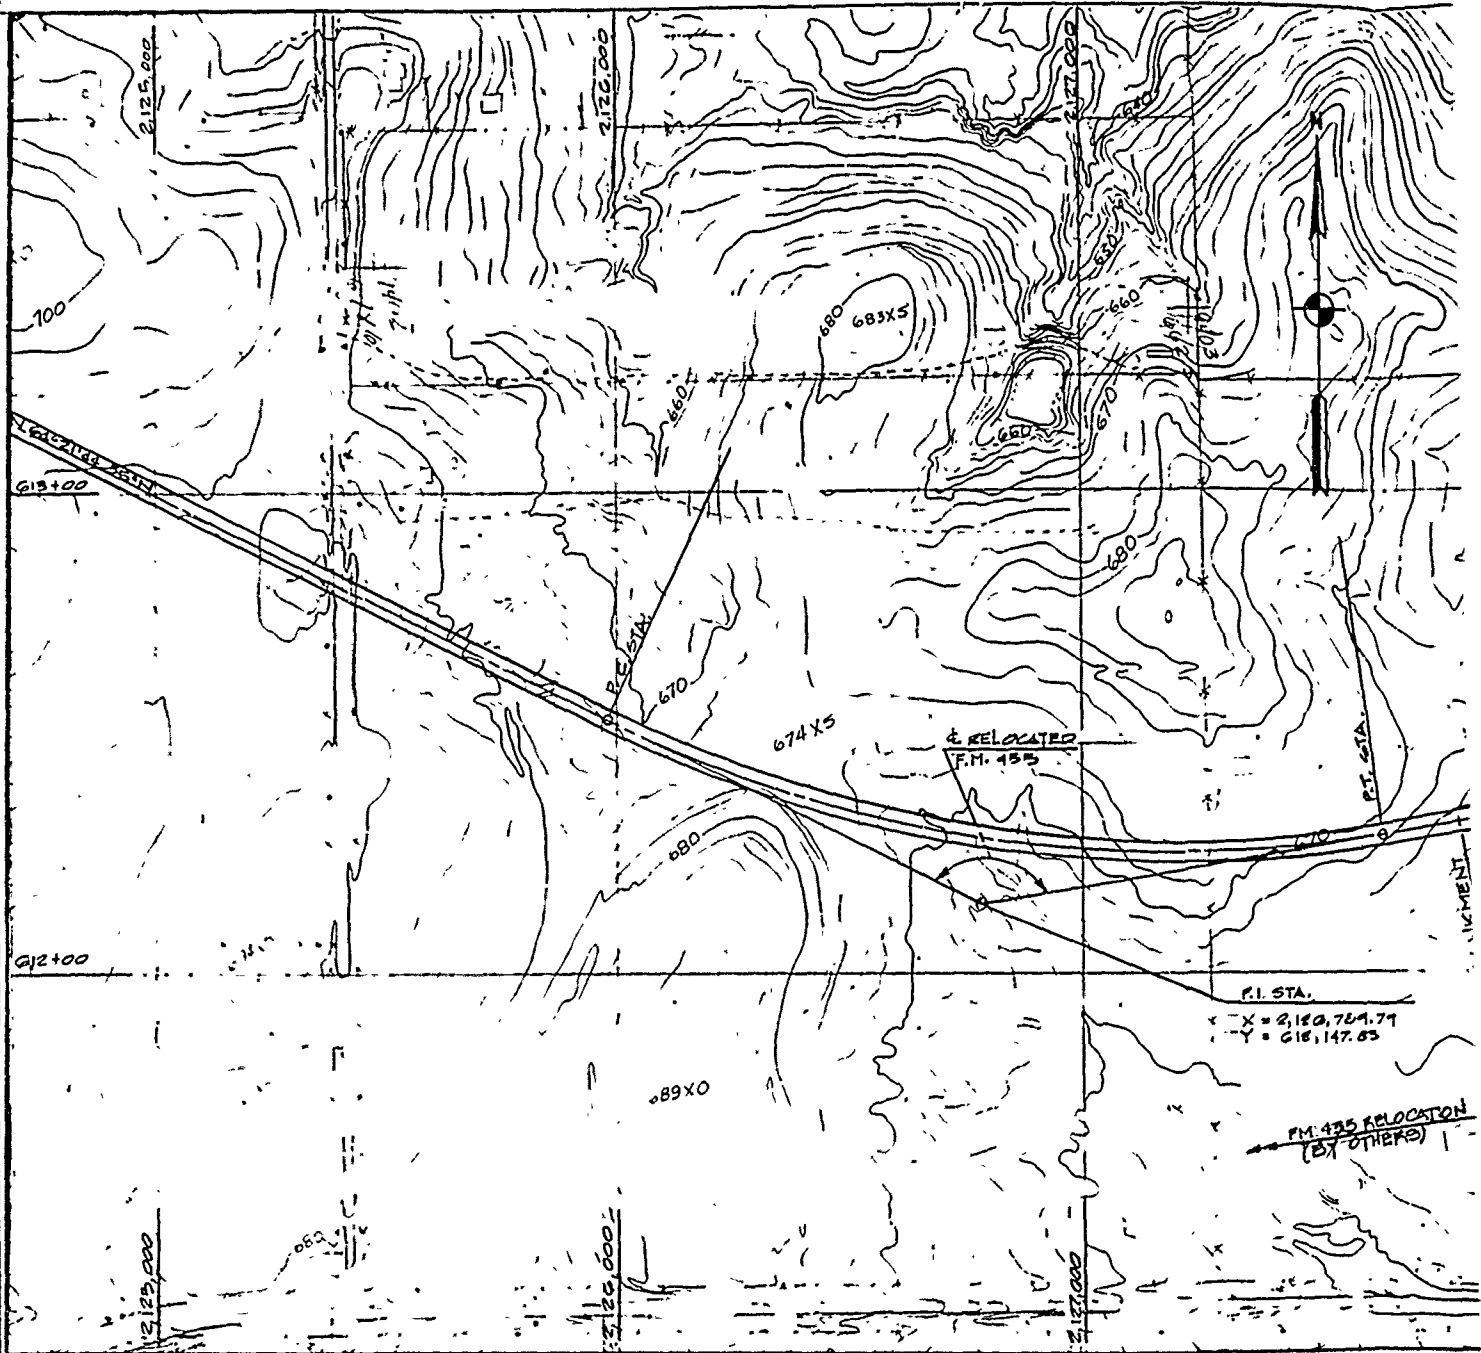

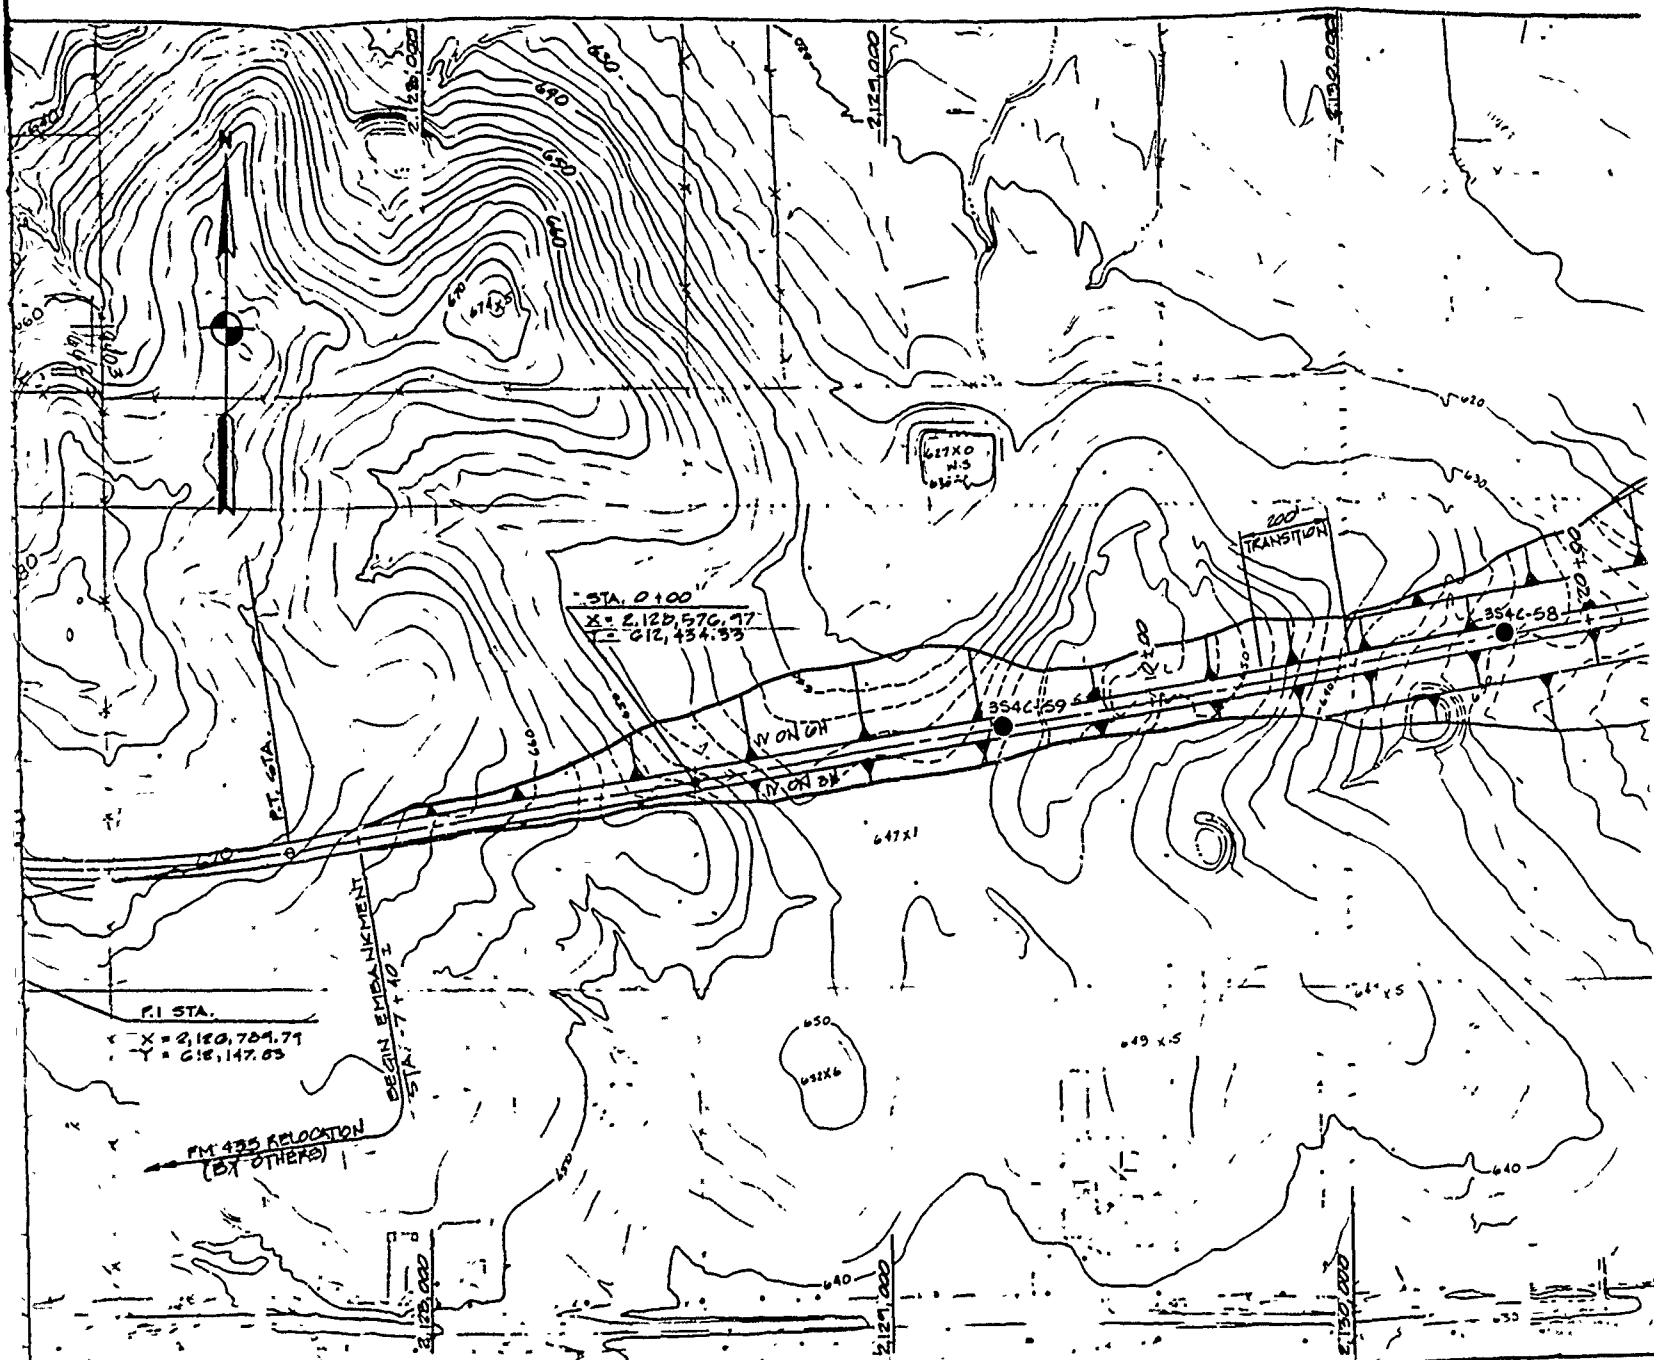


PLAN

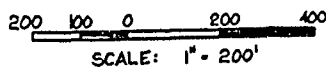

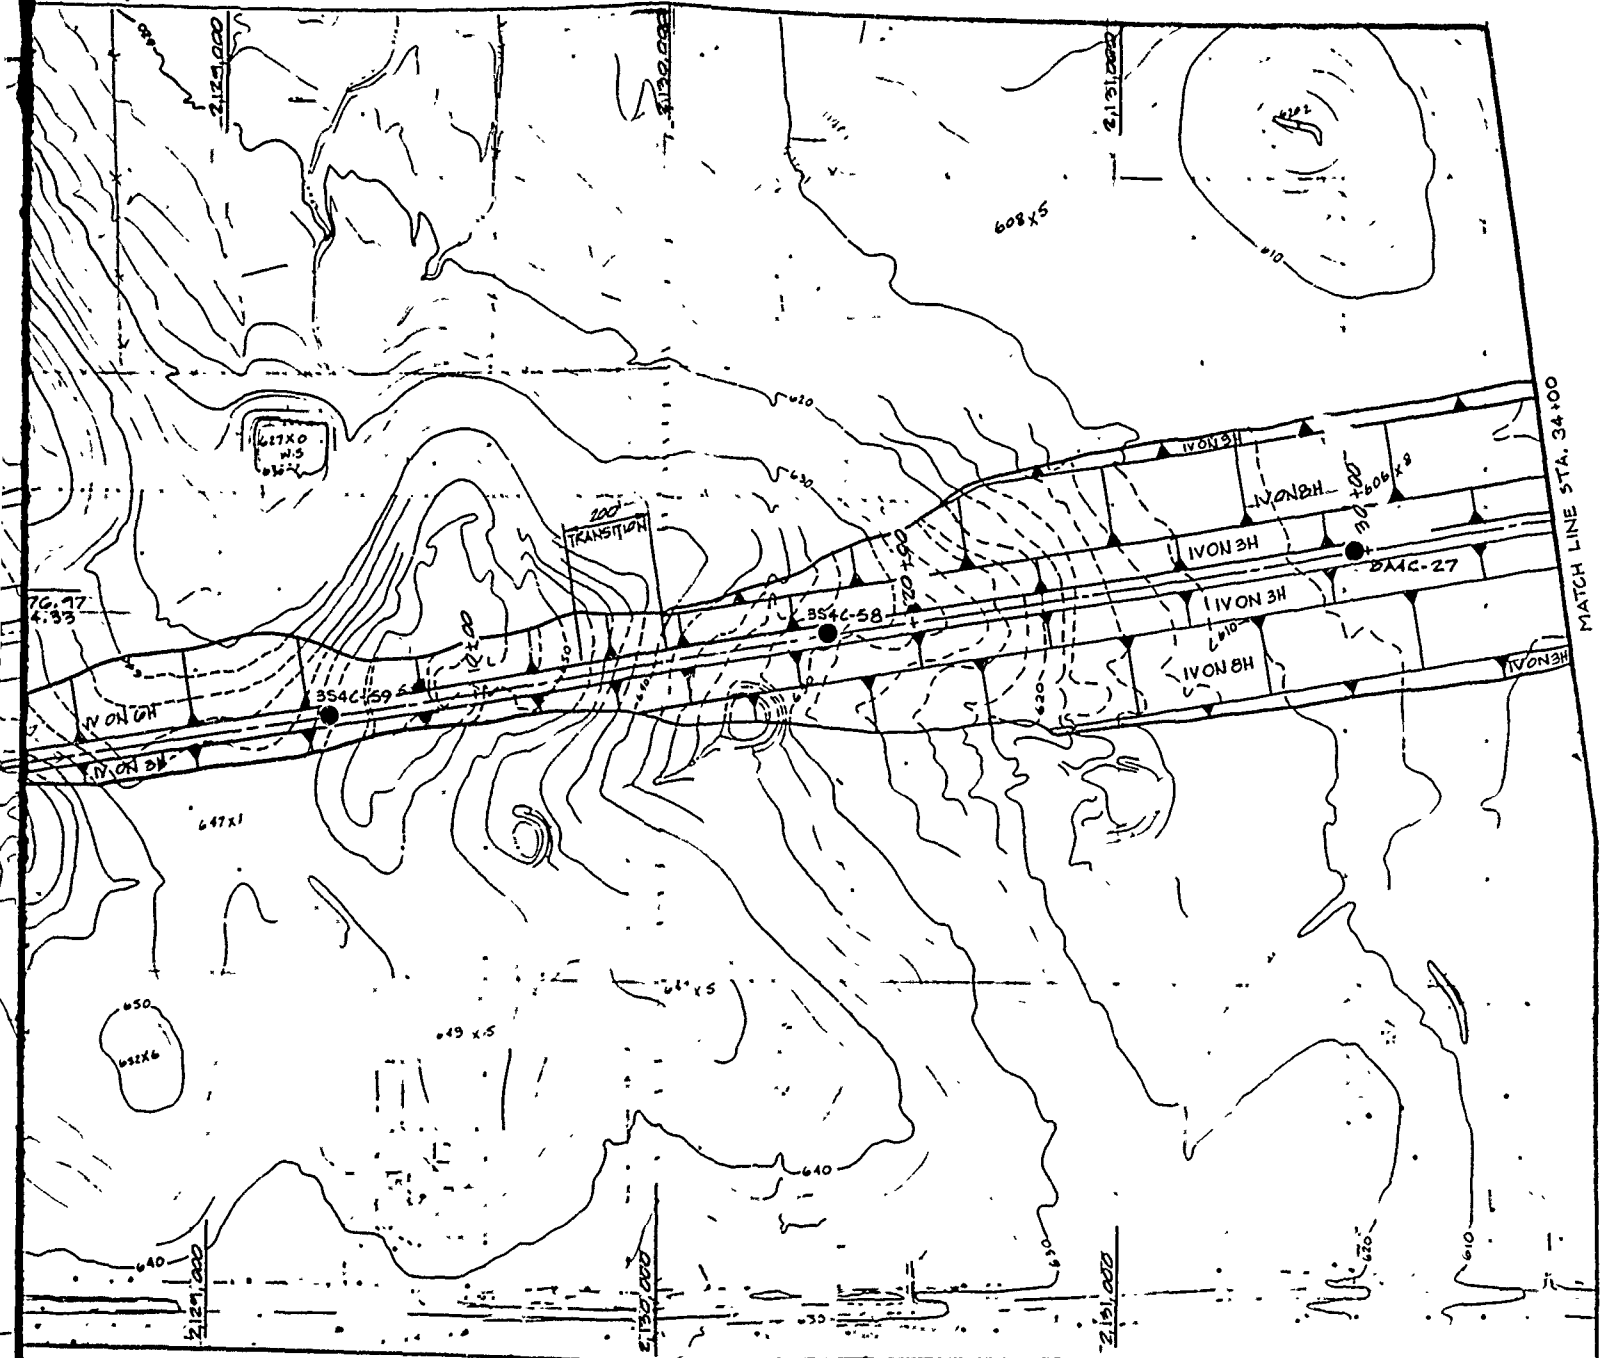


RECORD DRAWING-WORK AS BUILT


REVISION NO.	ACTION	DATE	DESCRIPTION OF REVISION
U.S. ARMY ENGINEER DISTRICT, FORT WORTH CORPS OF ENGINEERS FORT WORTH, TEXAS			
DESIGNED BY: A. BRANCH		RAY ROBERTS LAKE ELM FORK, TRINITY RIVER, TEXAS EMBANKMENT PLAN OF BORINGS I	
DRAWN BY: R. BAILEY			
REVIEWED BY: A. BRANCH			
SUBMITTED BY: H. KARBS		INVITATION NO. DACW 63-82-C-0026 DATE: MAR 61 CONTRACT NO. DACW 63-82-C-0093	

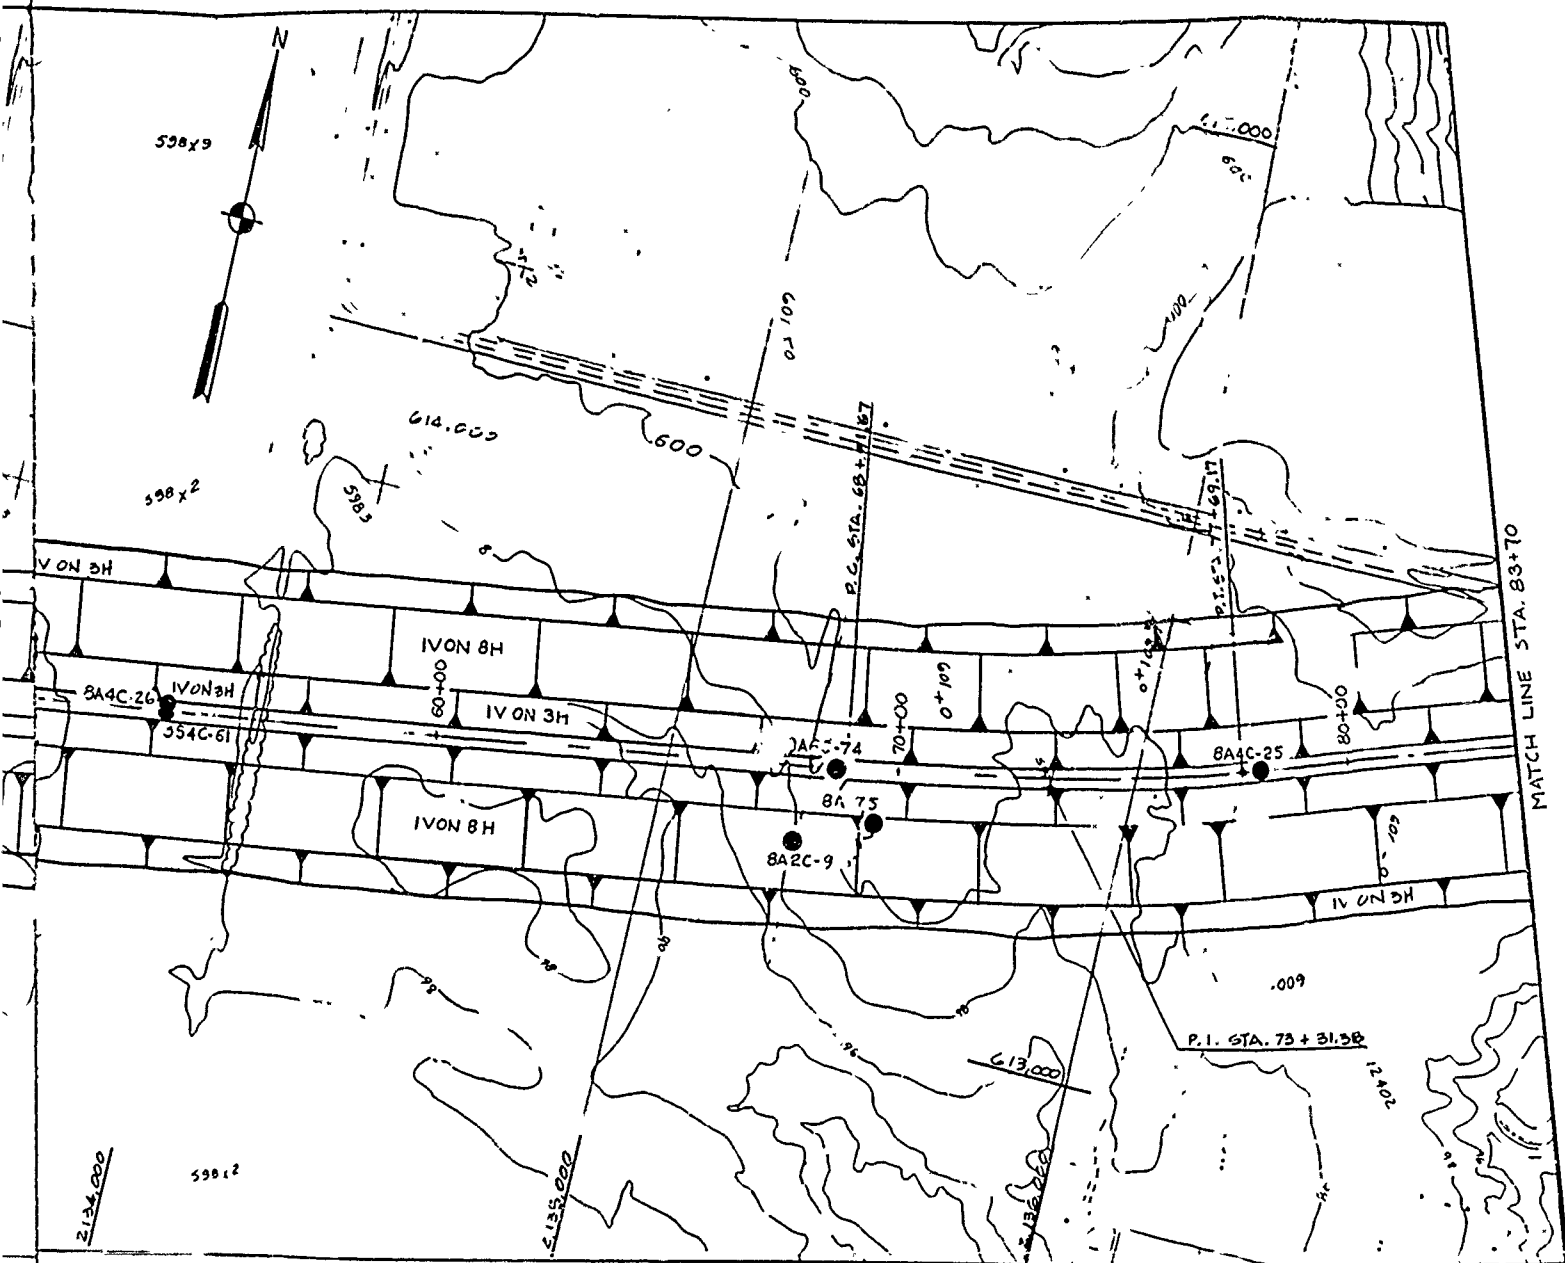

PLAN

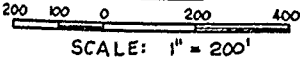

BY
A
P
A

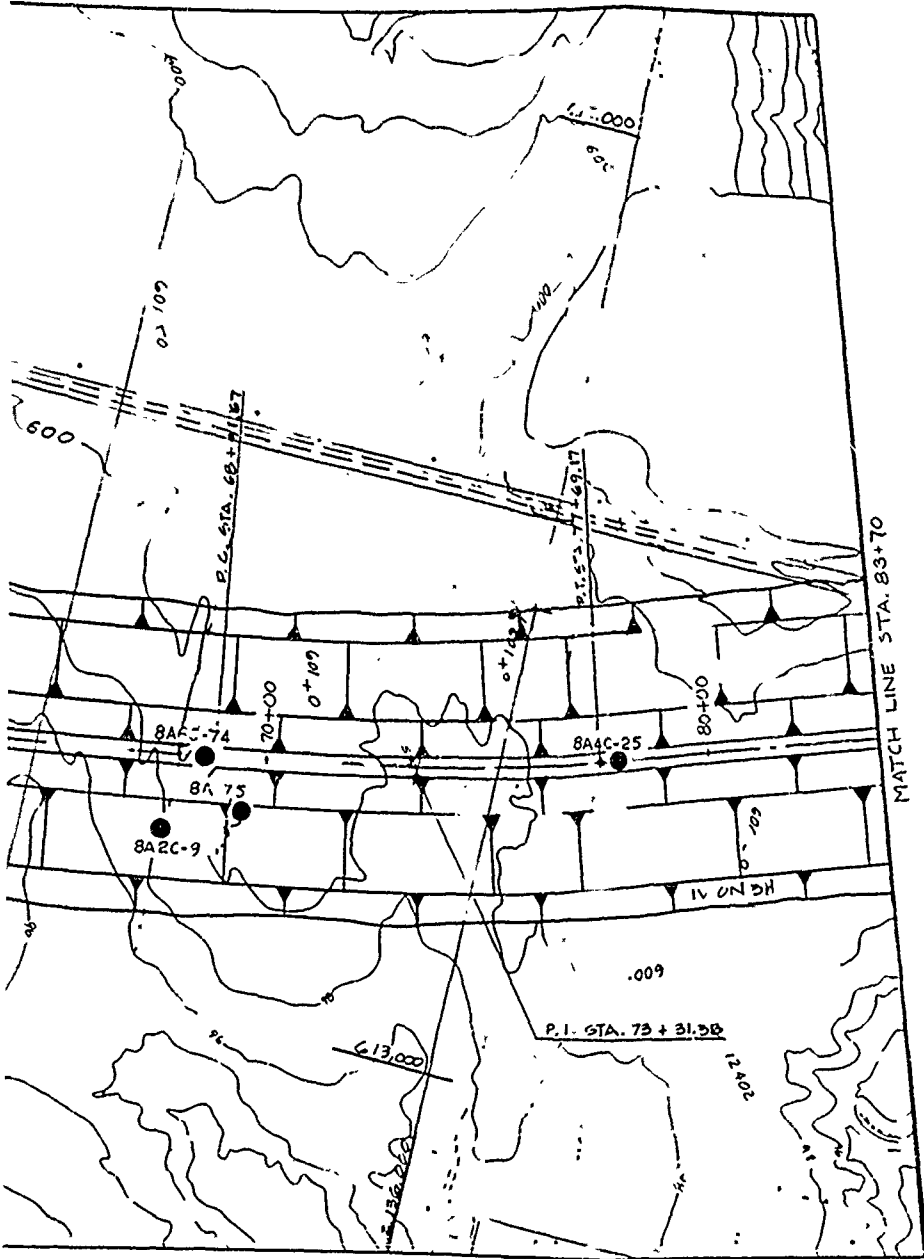


RECORD DRAWING-WORK AS BUILT

STATION
BAR

REV. NO.	ACTION	DATE	DESCRIPTION OF REVISION
U.S. ARMY ENGINEER DISTRICT, FORT WORTH CORPS OF ENGINEERS FORT WORTH, TEXAS			
DESIGNED BY:	RAY ROBERTS LAKE ELM FORK, TRINITY RIVER, TEXAS EMBANKMENT PLAN OF BORINGS II		
DRAWN BY:			
CHECKED BY:			
REVIEWED BY:			
SUBMITTED BY:			

INVESTIGATION NO. DA C 63-82-B-22 DATE: MAR 1959

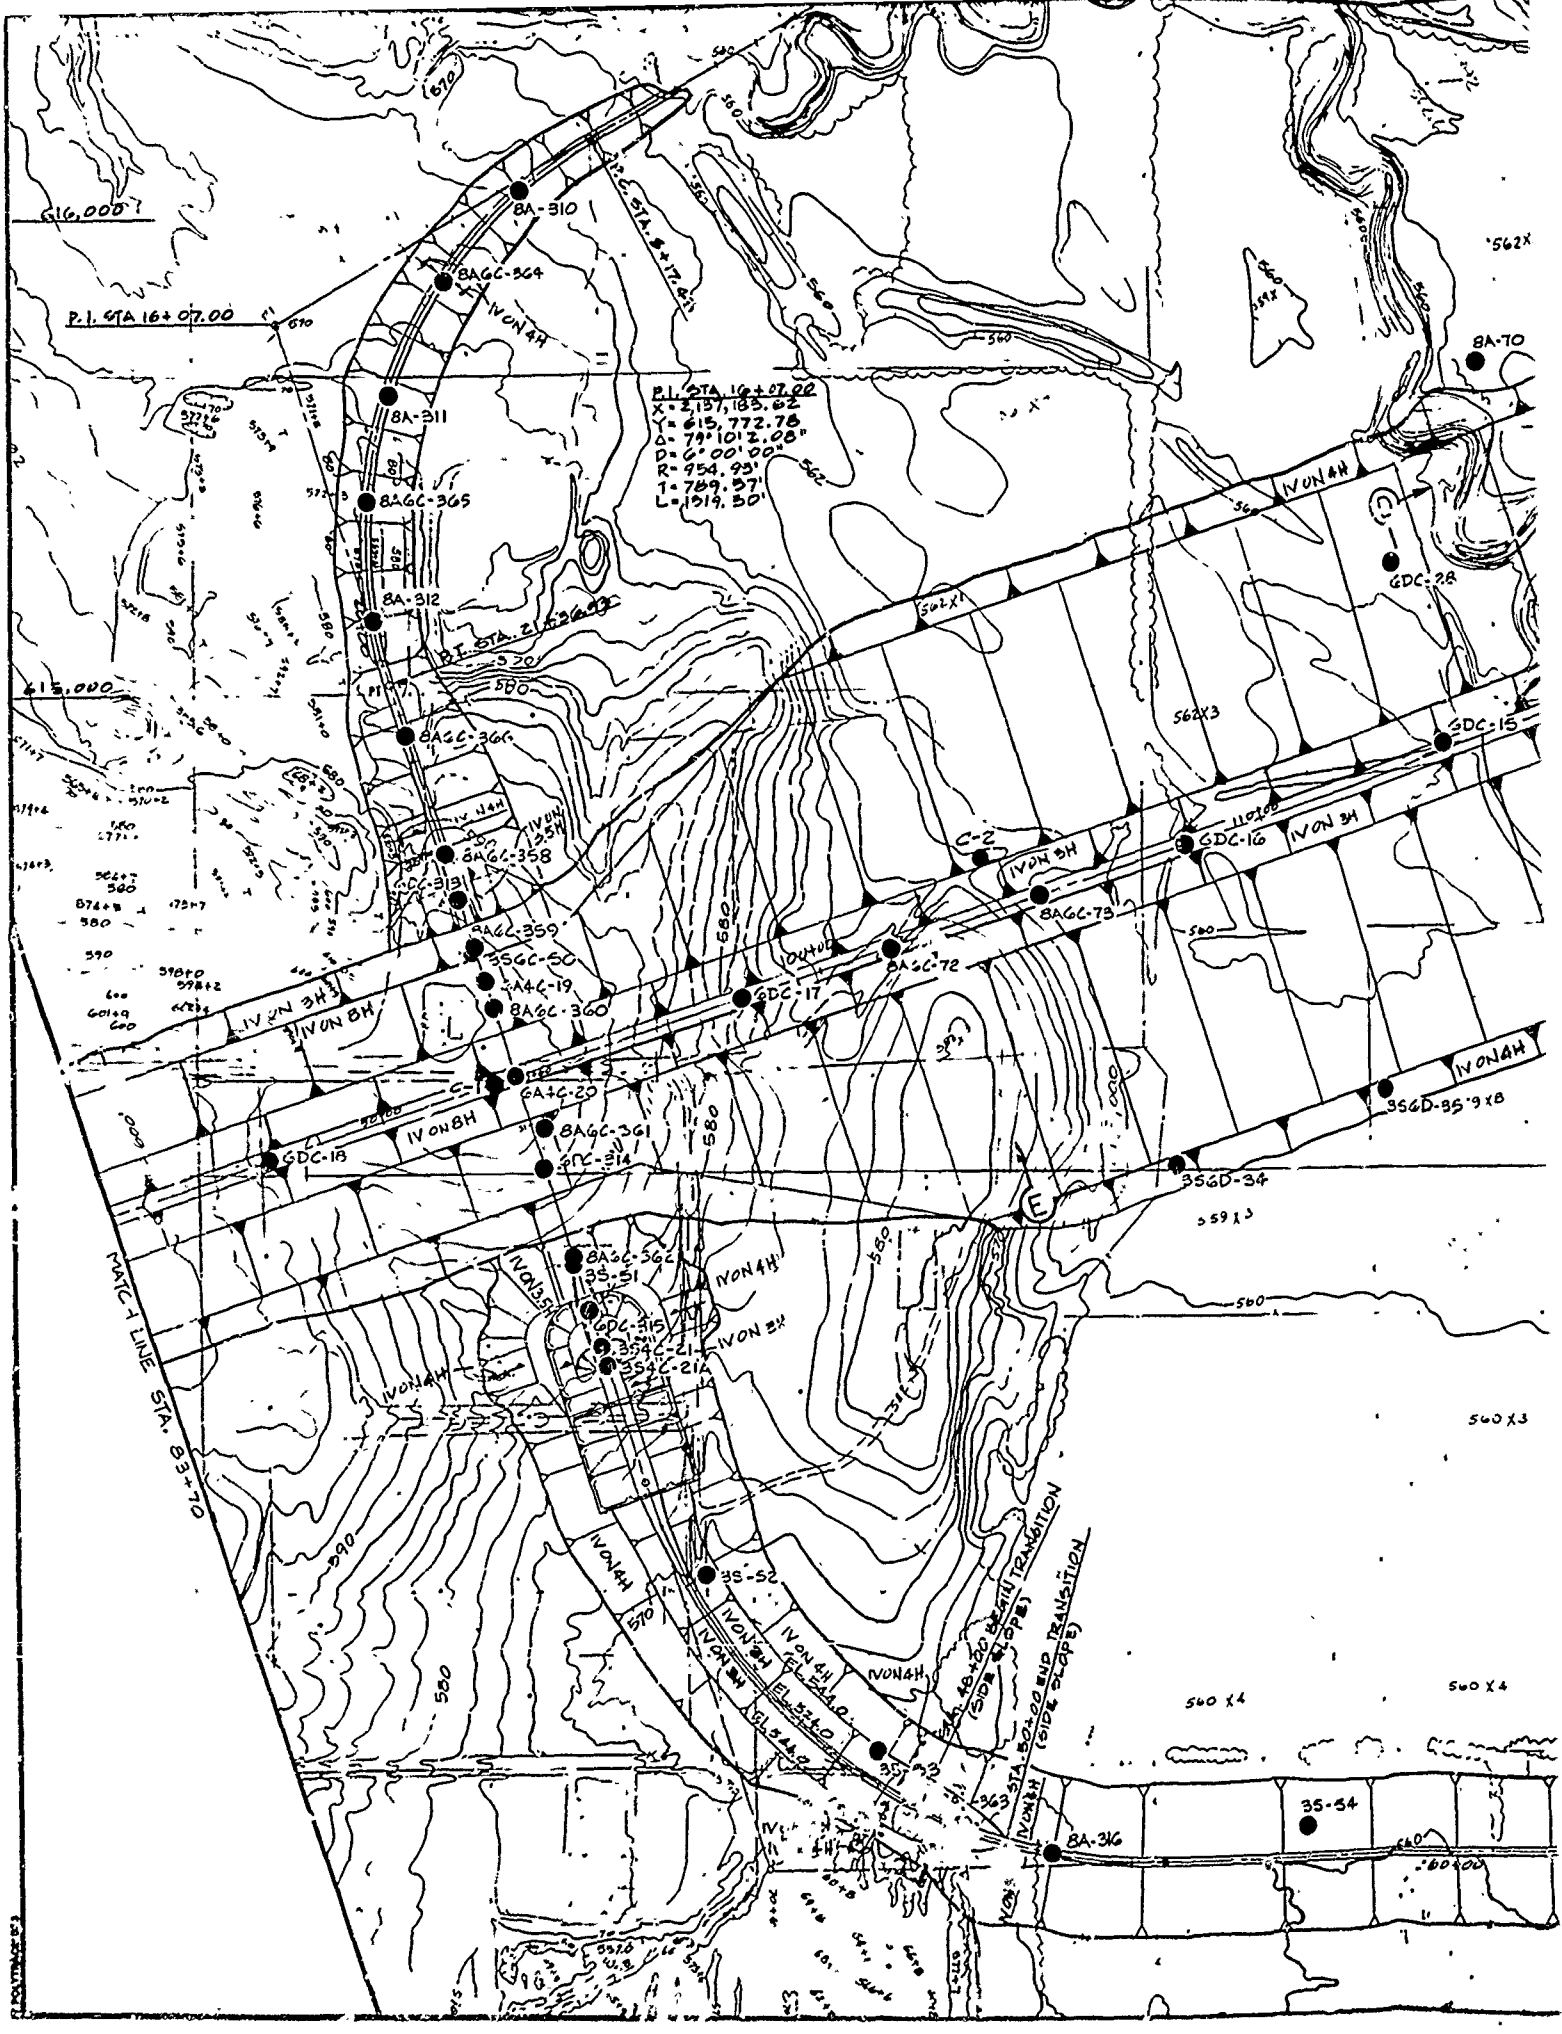

616.000'

P.I. STA 16+07.00

P.I. STA. 16+07.00
 X = 2157.185.02
 Y = 615.772.78
 Δ = 79°10'2.00"
 D = 6°00'00"
 R = 954.93'
 T = 789.37'
 L = 1919.50'

NORTH LINE
 STA. 8+55+10.0

IVONAH
 STA. 20+00 END TRANSITION
 (SIDE SLOPE)

35-54

BA-316

562X

BA-70

GDC-28

562X3

SDC-15

GDC-16

IVONAH

IVONAH

BAGC-73

BAGC-72

GDC-17

BAGC-300

BAGC-301

GDC-18

IVONAH

BAGC-362

GDC-315

IVONAH

IVONAH

560X3


560X4

560X4

560X4

560X4

FOURTH

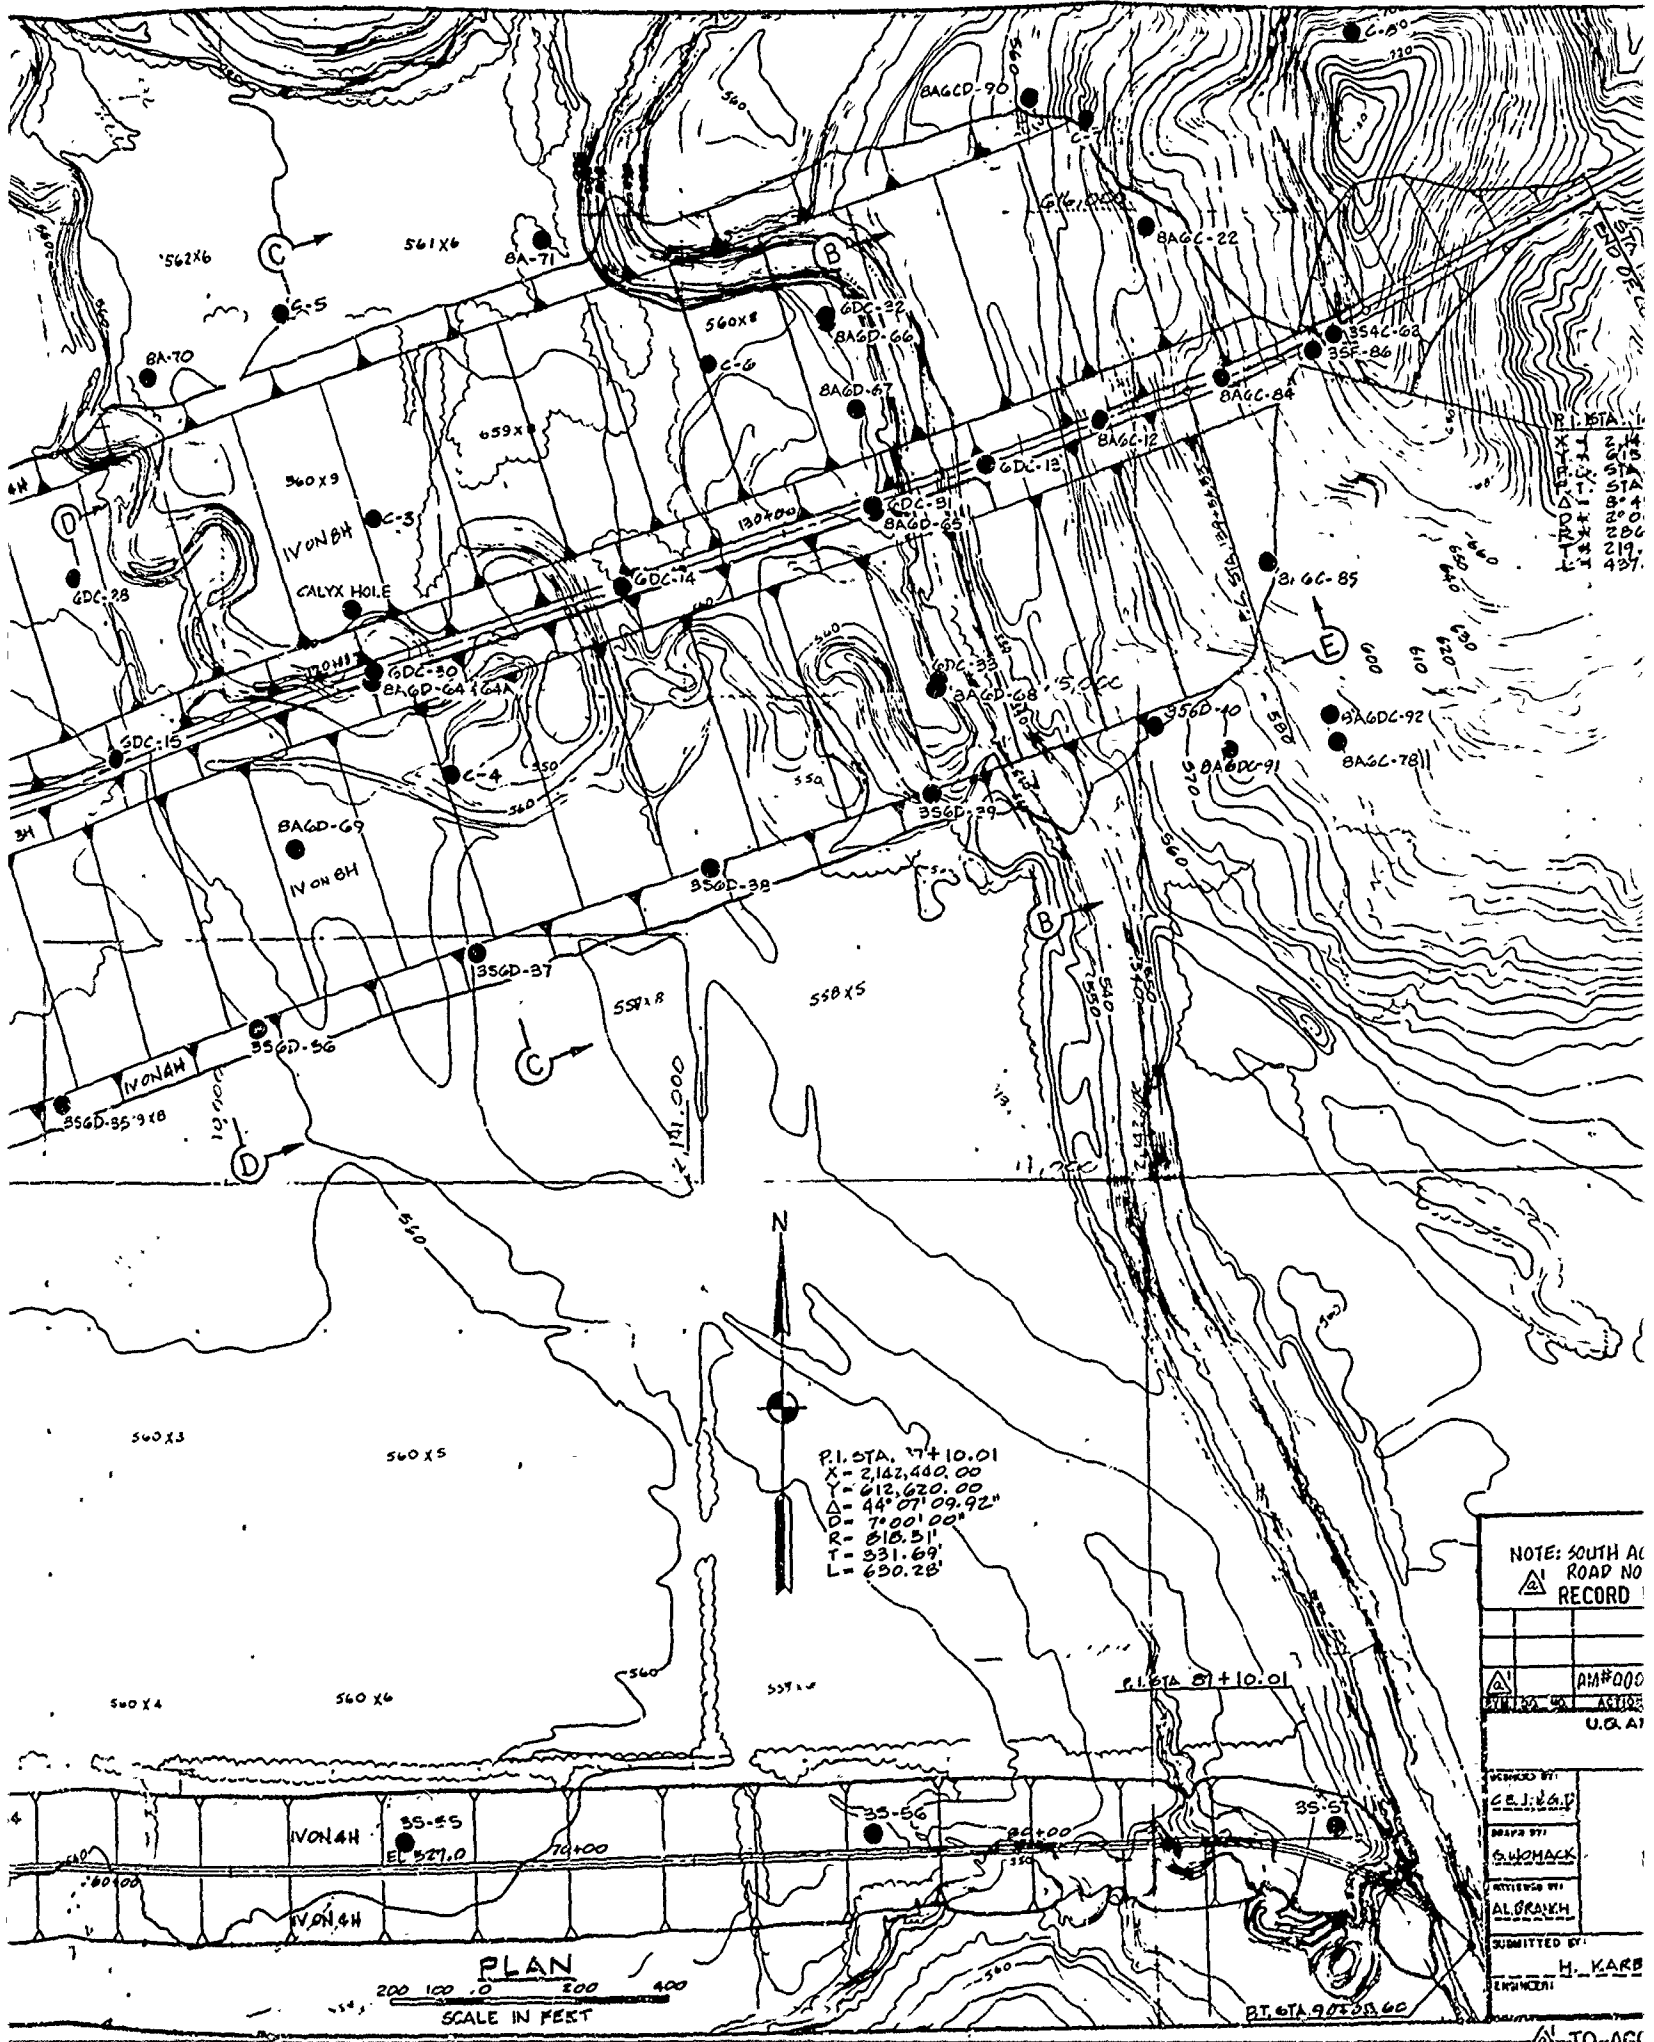


P.I. STA. 17+10.01
 X = 2,142,400.00
 Y = 612,620.00
 $\Delta = 44^{\circ} 07' 09.92''$
 D = 700' 00"
 R = 818.31'
 T = 331.69'
 L = 650.28'

NOTE: SOUTH AC ROAD NO RECORD

DESIGNED BY	C.E.J. & P.
DRAWN BY	G. W. H. MACK
REVIEWED BY	AL. GRAY
SUBMITTED BY	H. KARB
ENGINEER	

PLAN
 200 100 0 100 200 400
 SCALE IN FEET

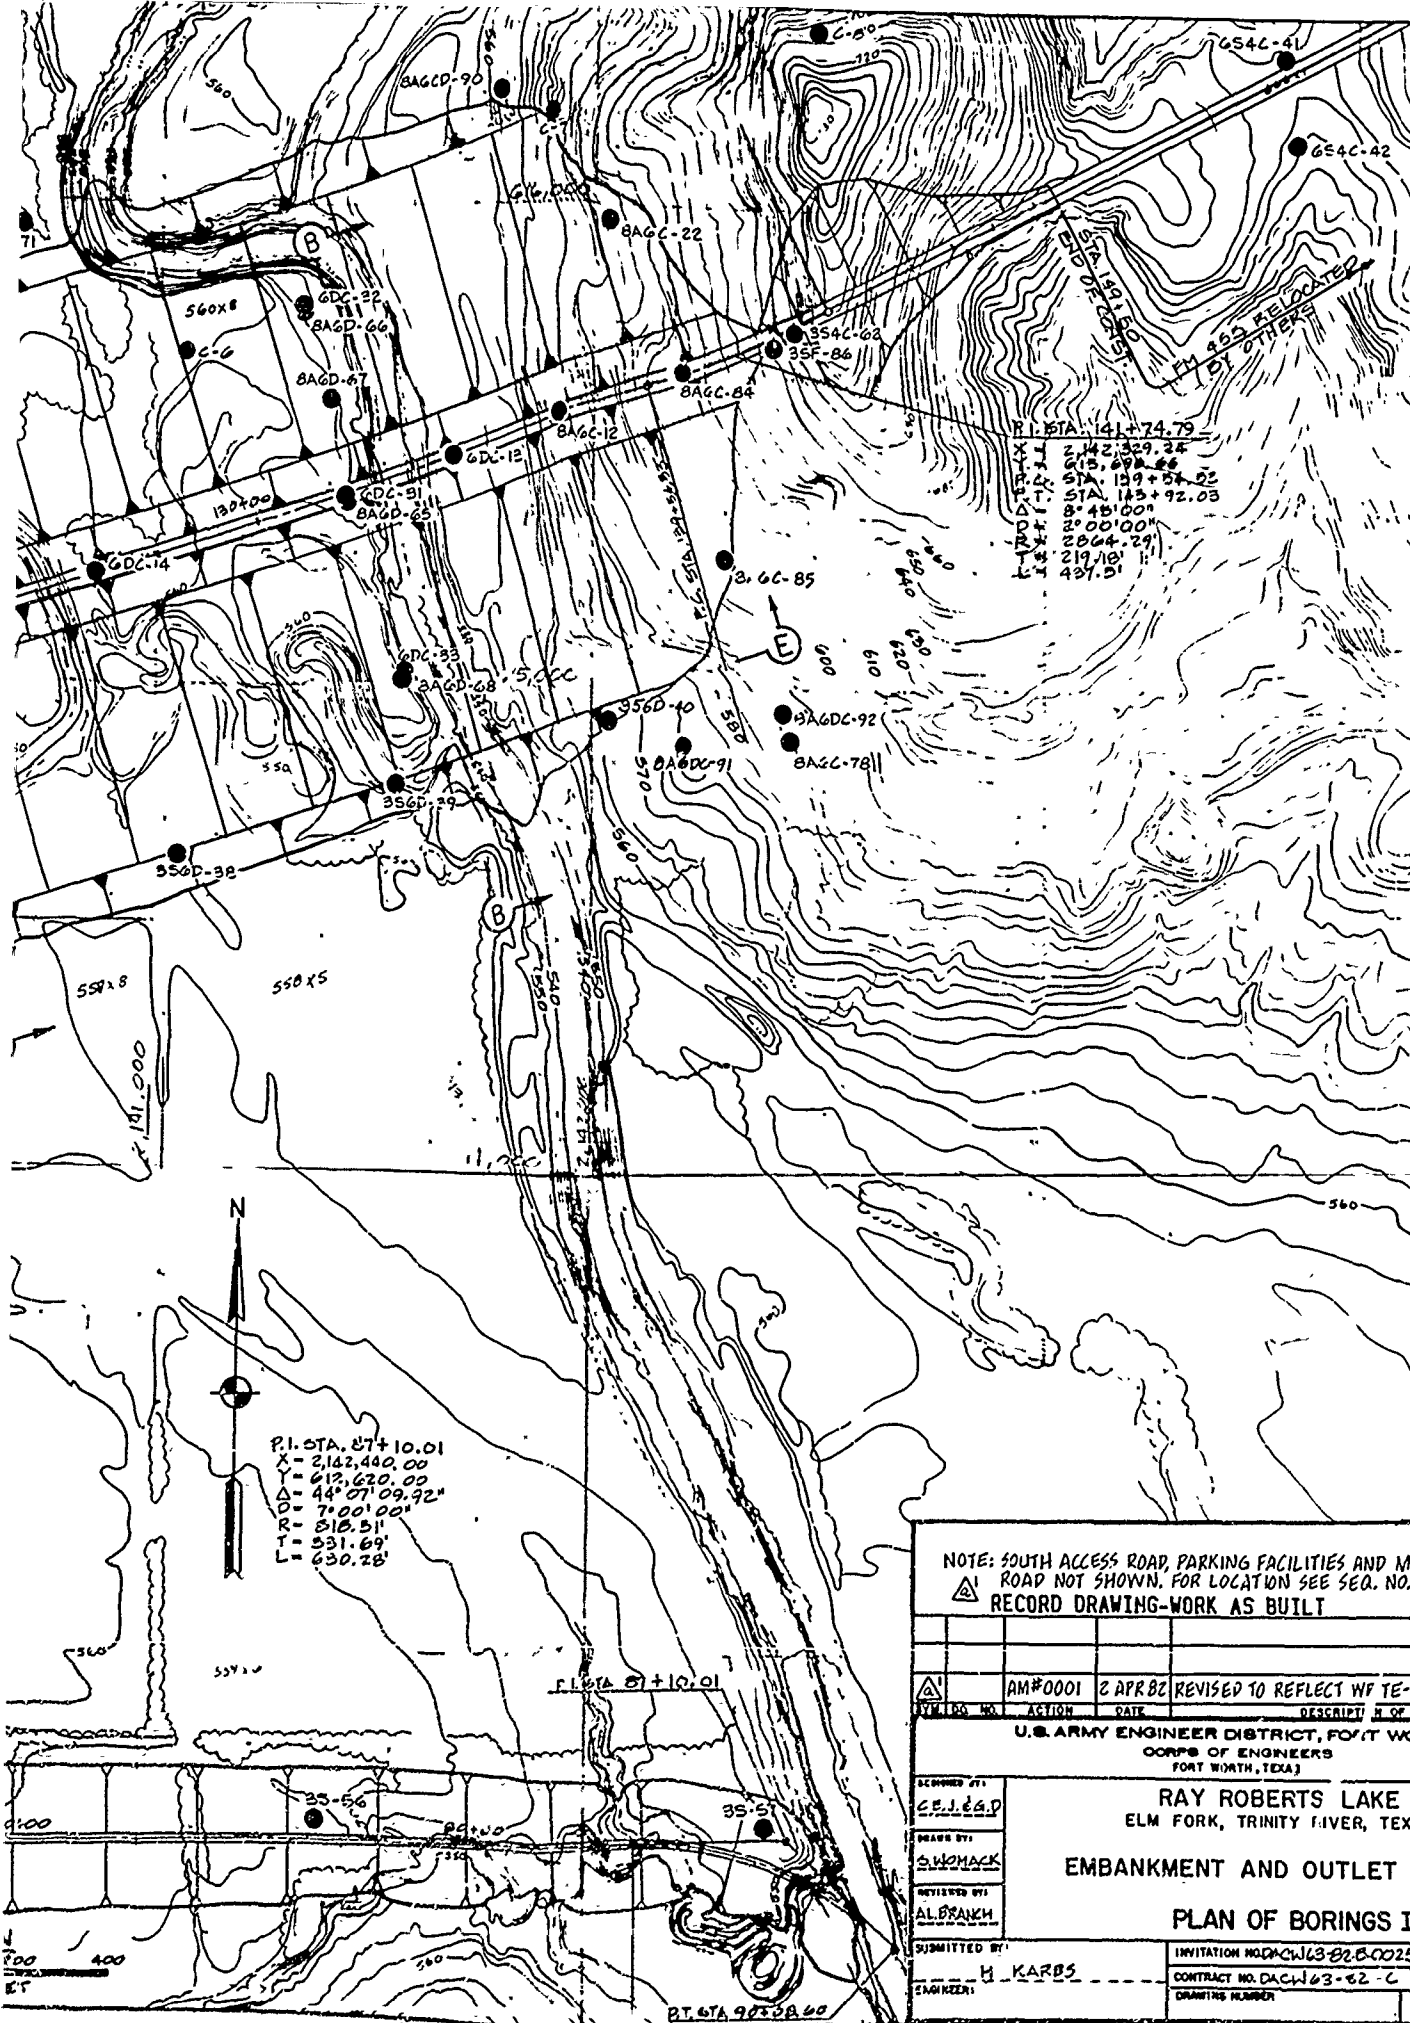

P.I. STA. 141+74.79
 X = 2,142,329.25
 Y = 515,878.86
 STA. 139+54.22
 STA. 143+92.03
 8° 45' 00"
 8° 00' 00"
 2864.29
 219.10
 437.5'

P.I. STA. 87+10.01
 X = 2,122,440.00
 Y = 612,620.00
 D = 44° 07' 09.92"
 R = 7,000.00'
 T = 518.51'
 L = 531.69'
 630.28'

NOTE: SOUTH ACCESS ROAD, PARKING FACILITIES AND MAINTENANCE ROAD NOT SHOWN. FOR LOCATION SEE SEC. NO. 157 AND 158. RECORD DRAWING-WORK AS BUILT

AM#0001	2 APR 82	REVISED TO REFLECT WF TE-IN CHANGE	
WORKING NO.	ACTION	DATE	DESCRIPTION OF REVISION

U.S. ARMY ENGINEER DISTRICT, FORT WORTH
 CORPS OF ENGINEERS
 FORT WORTH, TEXAS

RAY ROBERTS LAKE
 ELM FORK, TRINITY RIVER, TEXAS

EMBANKMENT AND OUTLET WORKS
 PLAN OF BORINGS III

SCHEMED BY: CE. J. E. G. P.
 DRAWN BY: S. W. MACK
 REVIEWED BY: AL. BRANKH
 SUBMITTED BY: H. KARBS

INVITATION NO. DACW 63-82-C-0025 DATE: MAR, 1982
 CONTRACT NO. DACW 63-82-C-0083
 DRAWING NUMBER: SHEET NO. OF 5

TO ACCOMPANY FOUNDATION REPORT

CONTRACT NO. DACW 63-82-C-0083


2125,000


Begin Sta. 0+00
X = 2124,500
Y = 617,205

2124,000

2123,000

2122,000

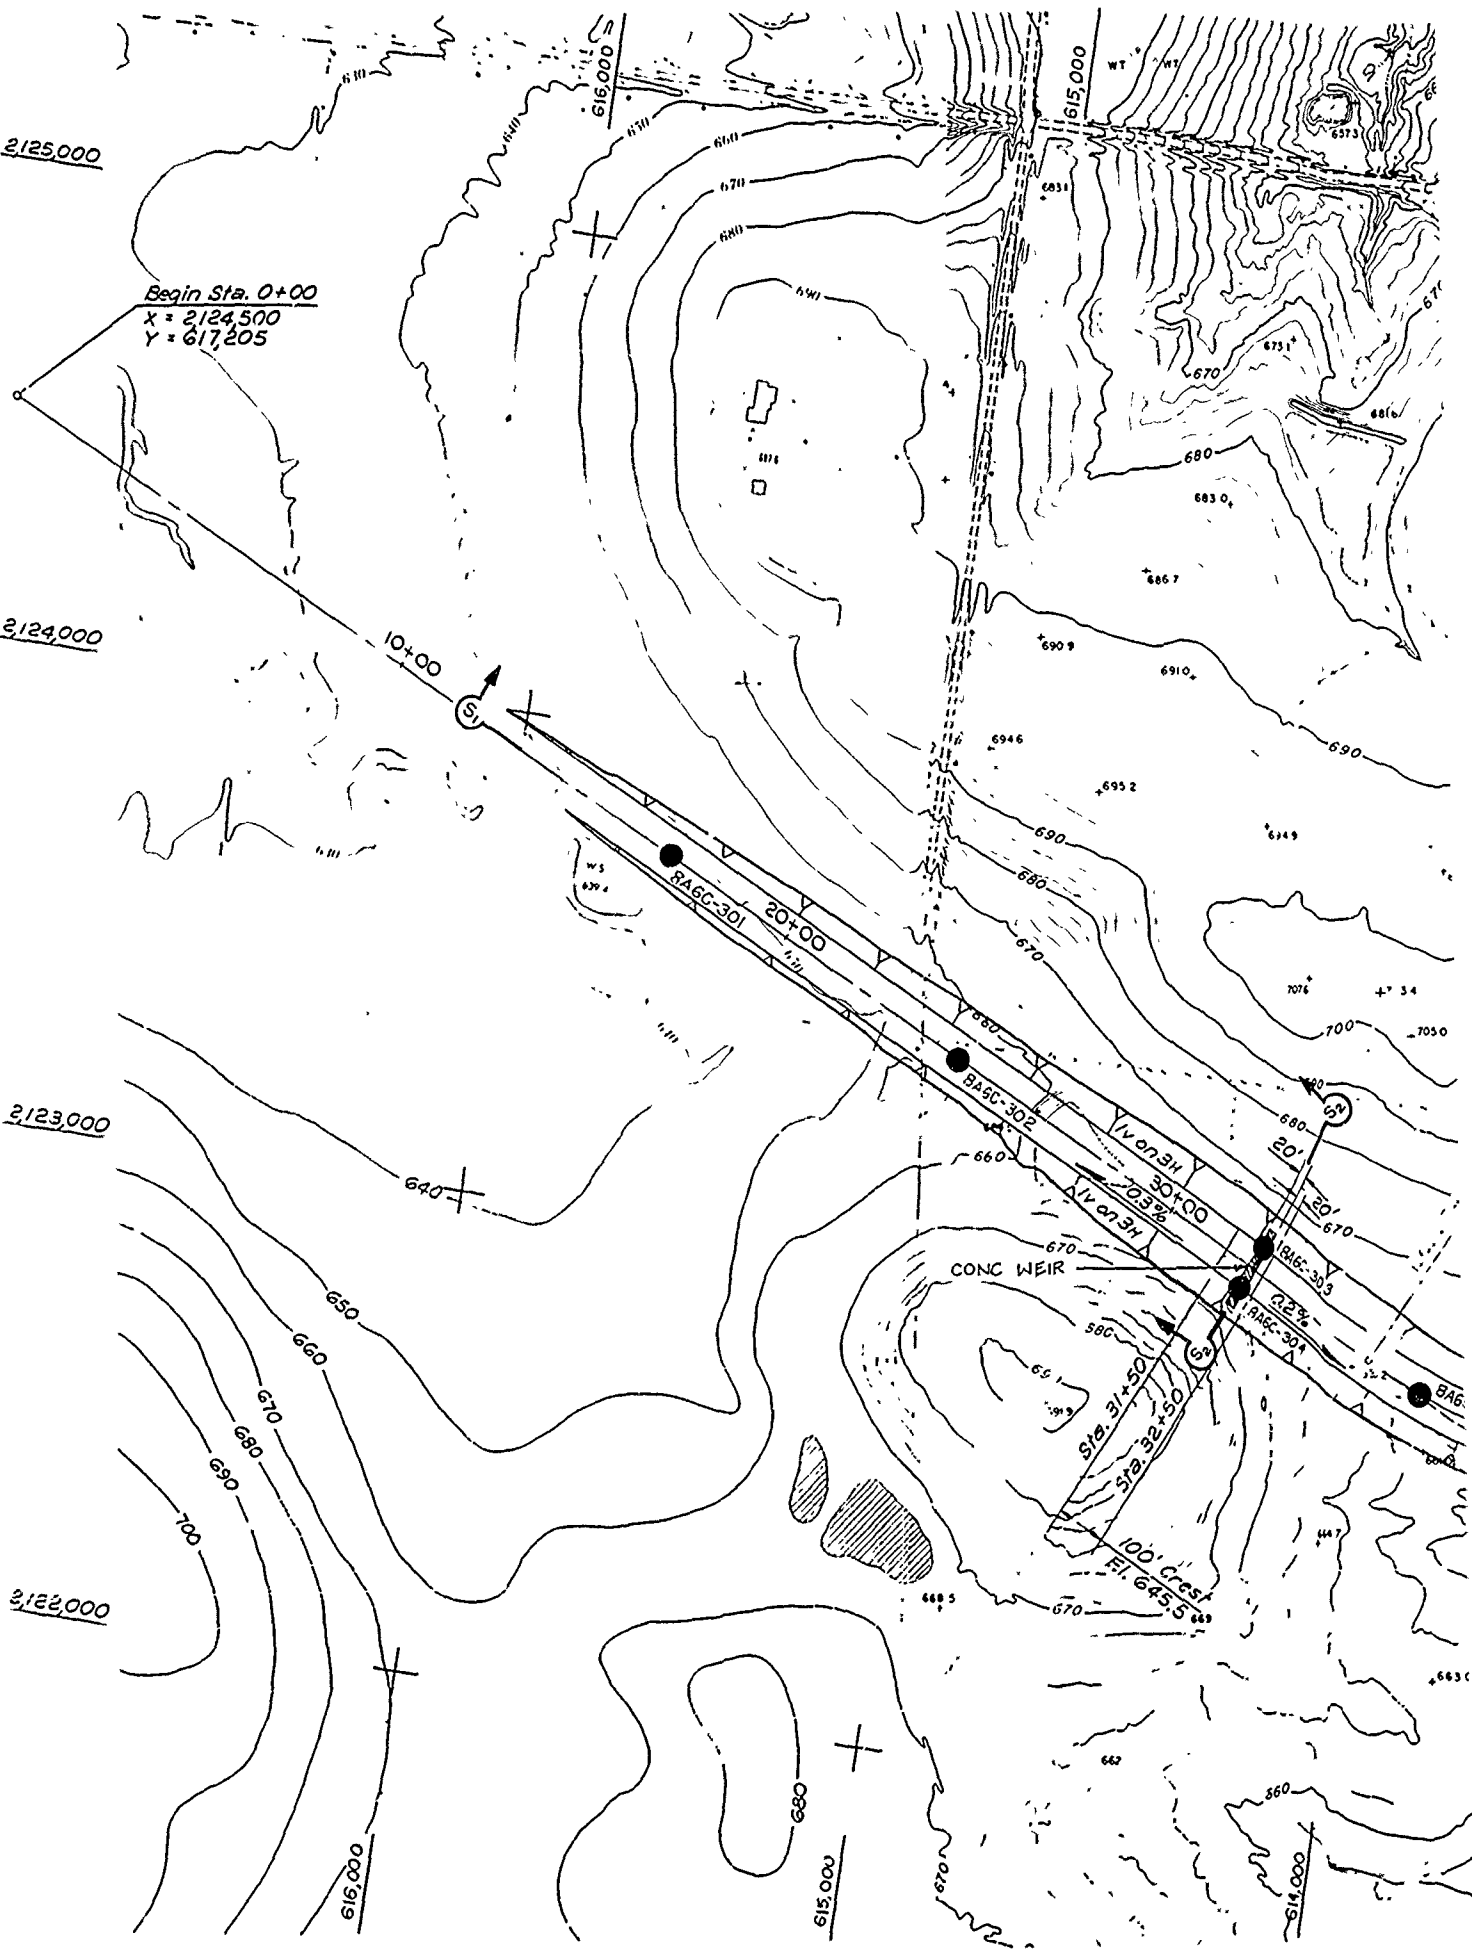


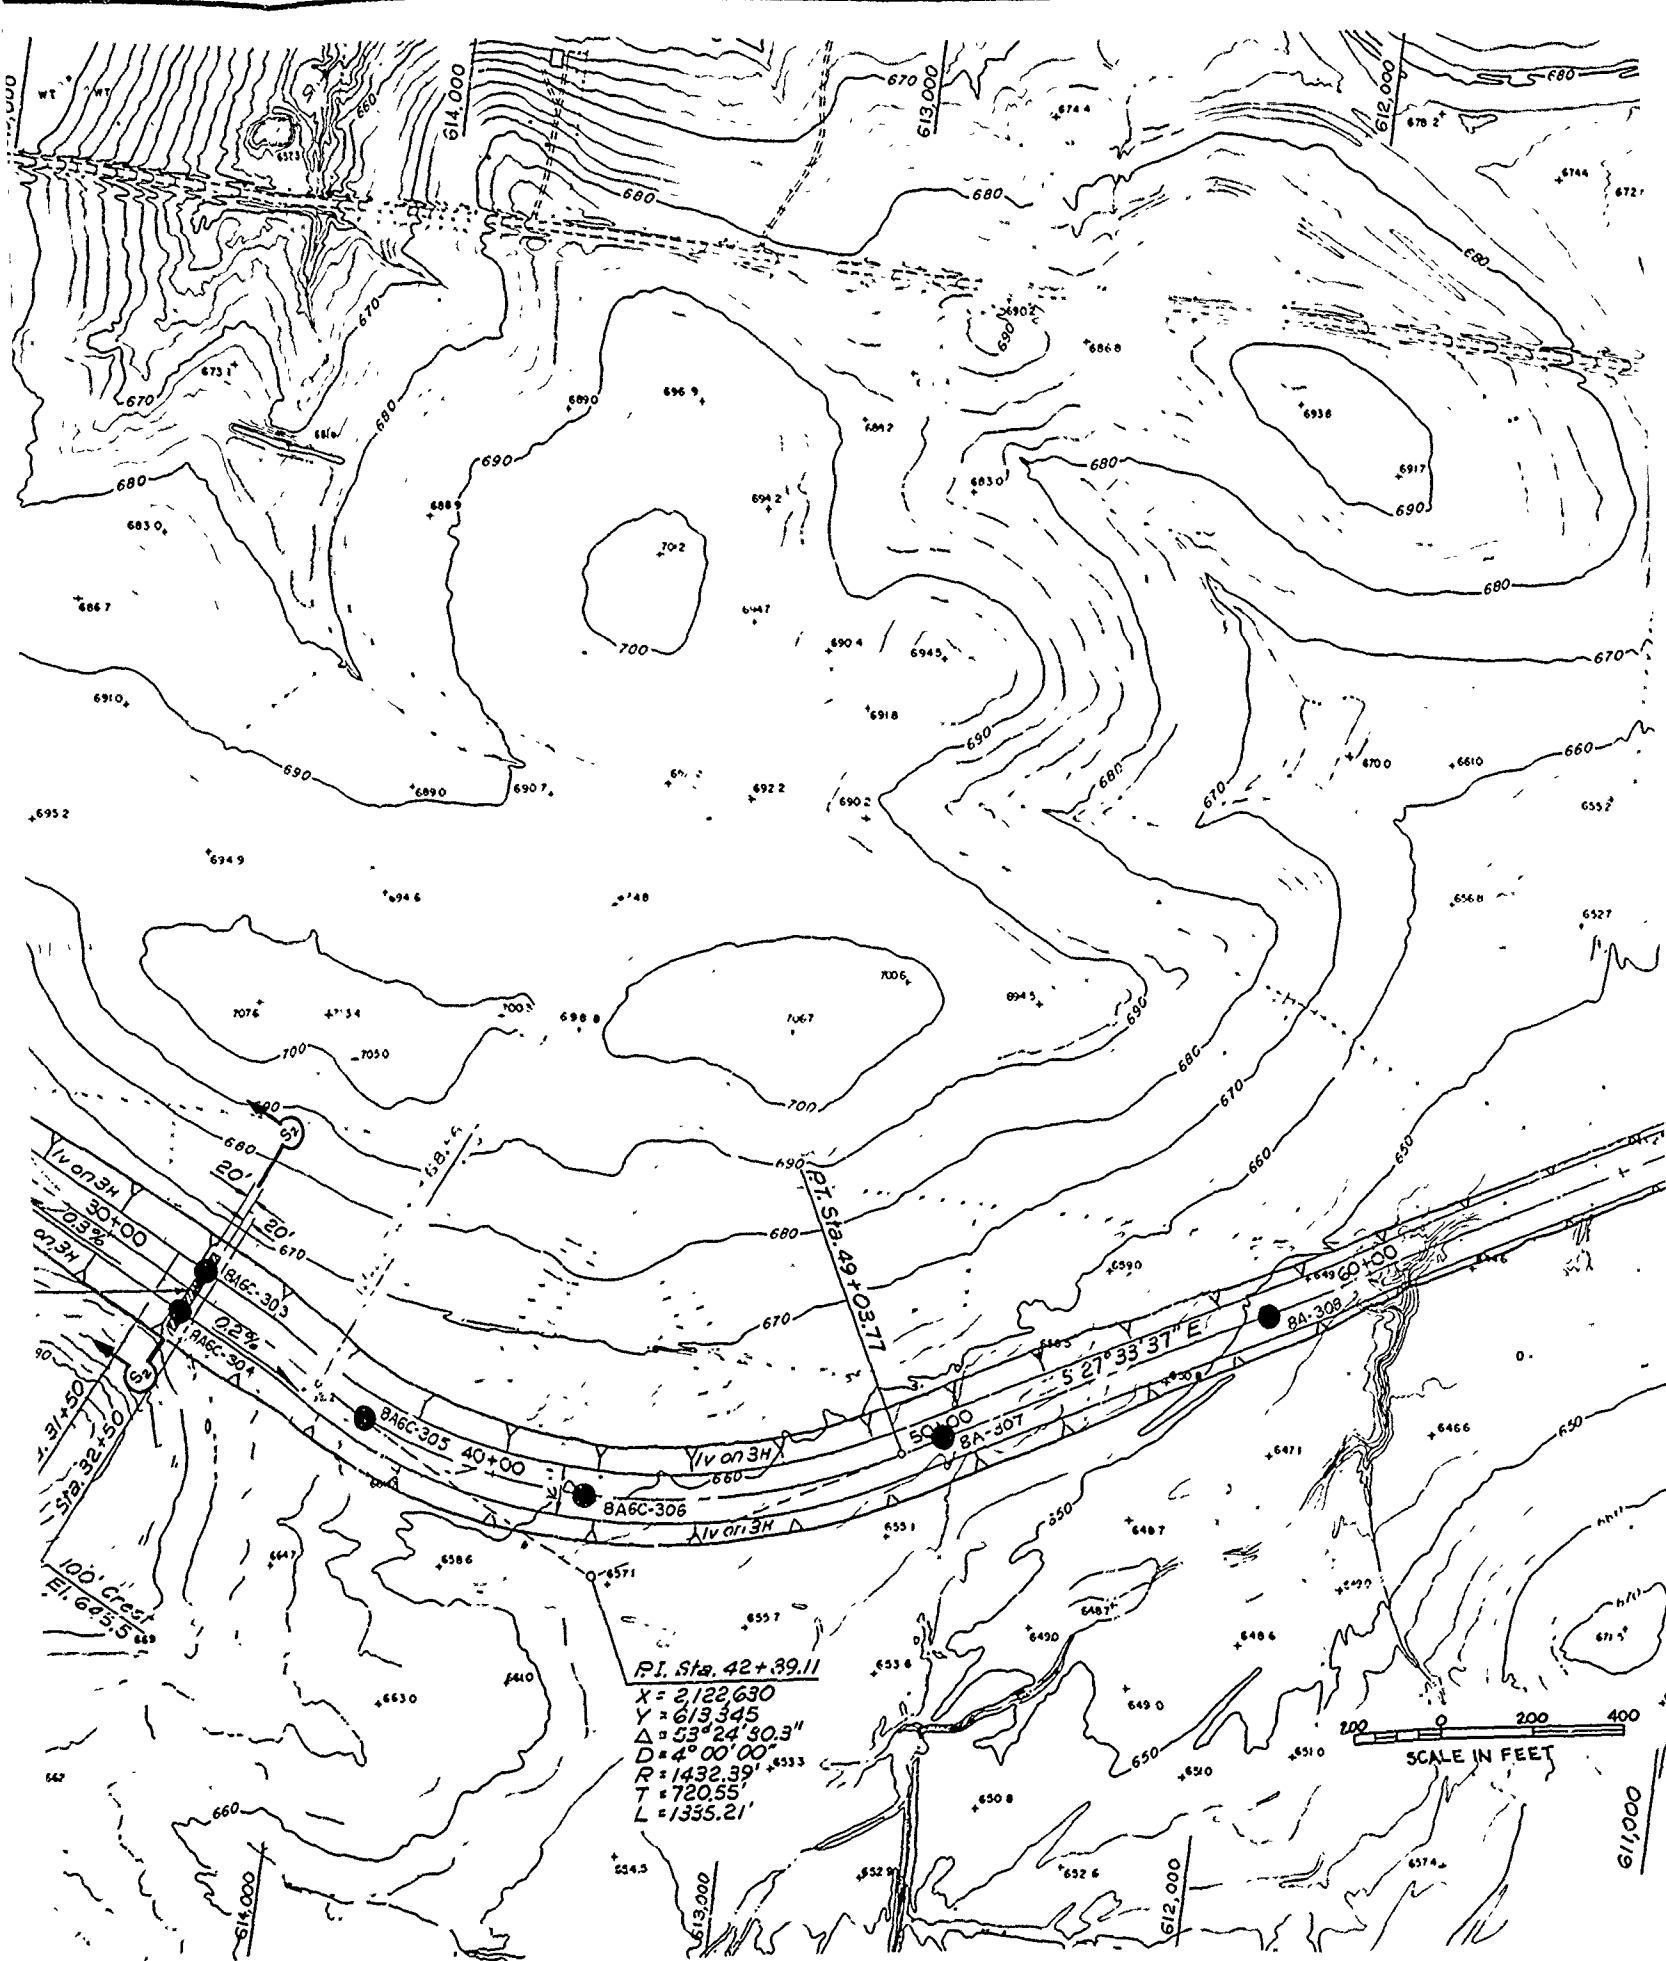

PI Sta. 42+39.11
 X = 2122.630
 Y = 613.345
 $\Delta = 53^{\circ}24'30.3''$
 D = 4^{\circ}00'00''
 R = 1432.39'
 T = 720.55'
 L = 1335.21'

0 200 400
 SCALE IN FEET

RECORD DRAWING-WORK AS BUILT

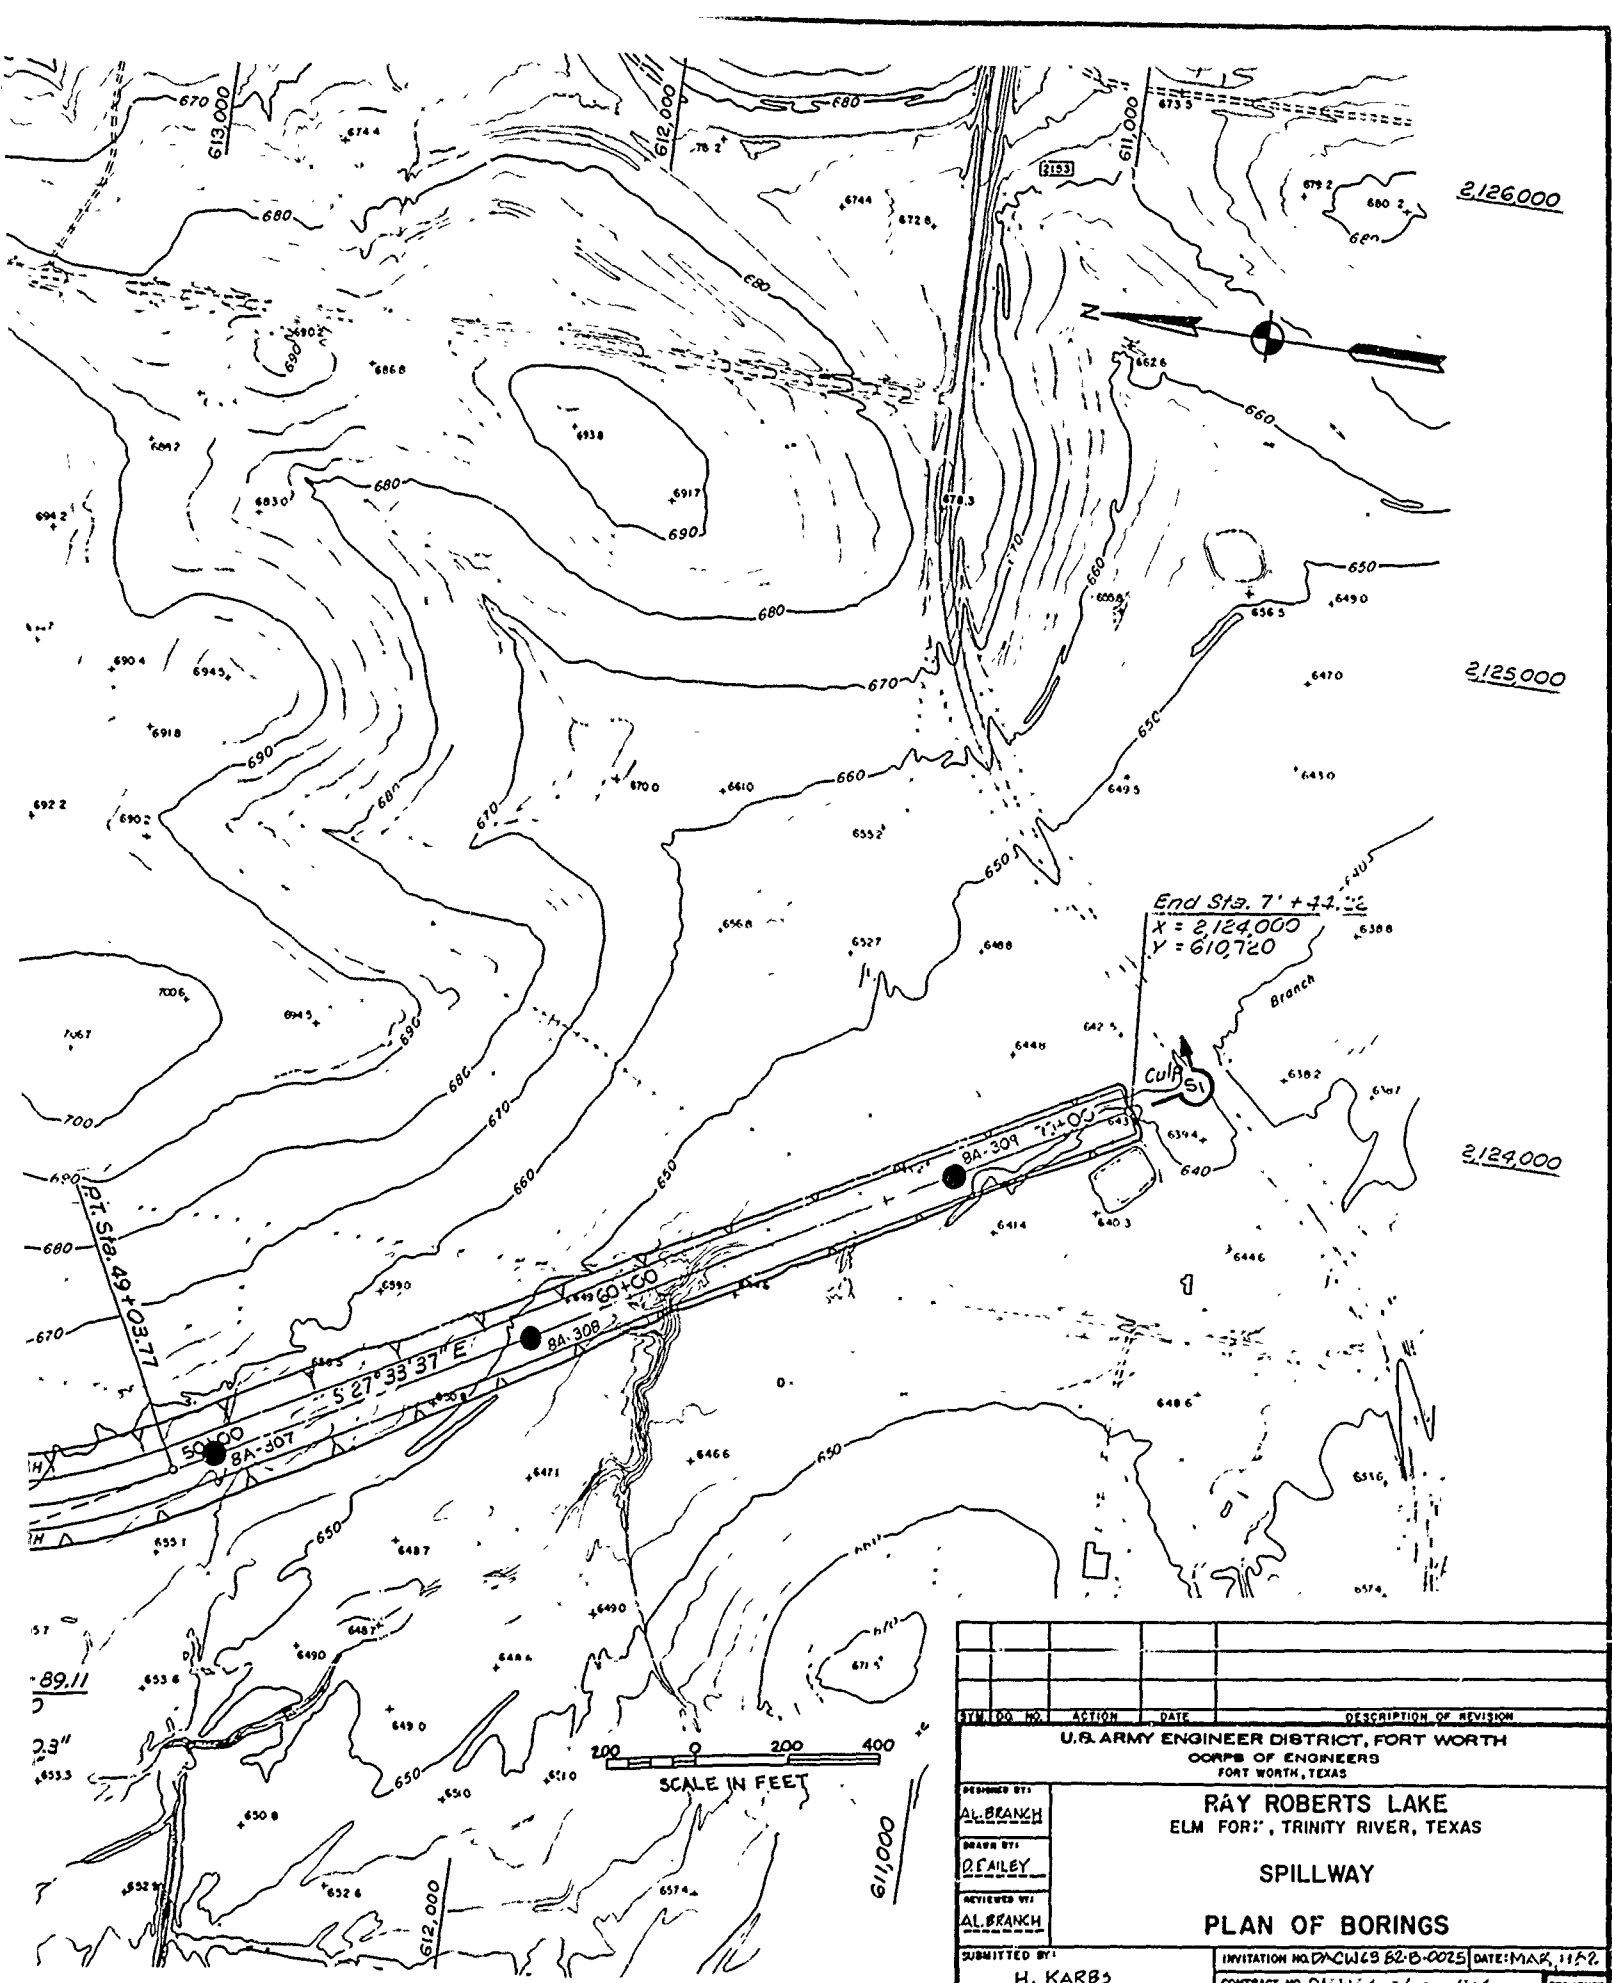

RECORD DRAWING-WORK AS BUILT

SYM. NO.	ACTION	DATE	DESCRIPTION OF REVISION
U.S. ARMY ENGINEER DISTRICT, FORT WORTH CORPS OF ENGINEERS FORT WORTH, TEXAS			
DESIGNED BY: AL BRANCH	RAY ROBERTS LAKE ELM FOR, TRINITY RIVER, TEXAS		
DRAWN BY: FAILEY			
REVIEWED BY: AL BRANCH	SPILLWAY		
PLAN OF BORINGS			
SUBMITTED BY: H. KARBS	INVITATION NO. DACW49 82-B-0025	DATE: MAR 11 1982	SEQUENCE NO. 7
DRAWING NUMBER		SHEET NO. OF	

TO ACCOMPANY FOUNDATION REPORT

UNITED STATES ENGINEER OFFICE
ENGINEERING DIVISION
FIELD INVESTIGATIONS SECTION
GALVESTON, TEXAS

LOG OF CORE DRILLING

Date 20 August 1946



Site Aubrey U.S.L. Sta. 4724 of 2
 Location Y
 Elevation of Top of Hole 597.2'
 Depth of Overburden 16.0'
 Elevation of Top of Bedrock 581.2'
 Potted Casing Top () No ()
 Elevation of Water Table _____
 Elevation of Bottom of Hole 500.2'
 Core Drilling 81.5' Recovery _____
 Date Hole Completed 6 January 1929
 Marked Upper Elm Creek G.L. Sta. 0/00
 Marked Upper Elm Creek G.L. Sta. 0/00
 Submitted by _____

Hole No. C-1 Drill No. _____
 Type of Bit _____
 Size of Core 2-inch
 Method of Arb. Sampling Earth Auger
 Set _____ of _____ Casing _____
 Depth to Water Table _____
 Total Depth of Hole 97.0'
 Overburden Sampling 16.0'
 Date Hole Started 8 January 1929
 Number of Jars/Tubes 1
 Number of Boxes 7
 Classified by _____

OF CORE DRILLING CONT

Site Aubrey Dam


Hole No. _____

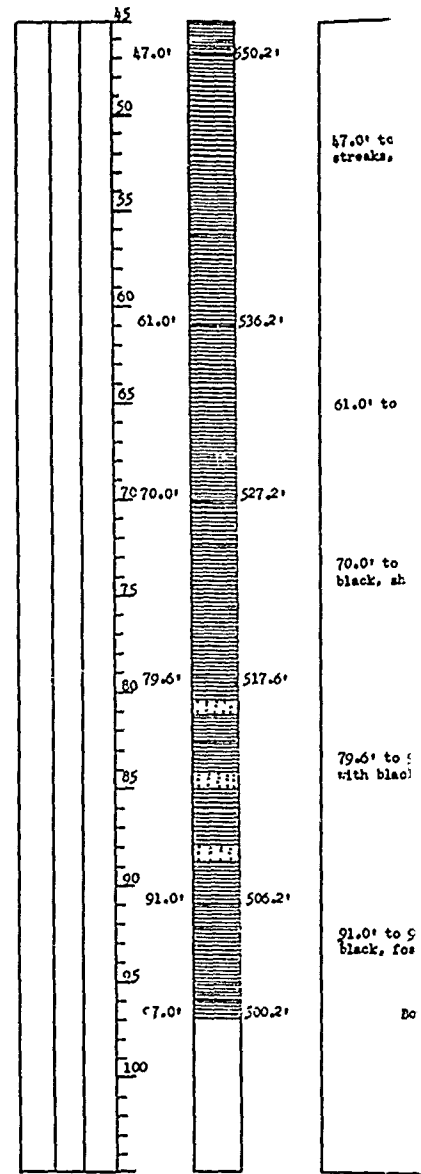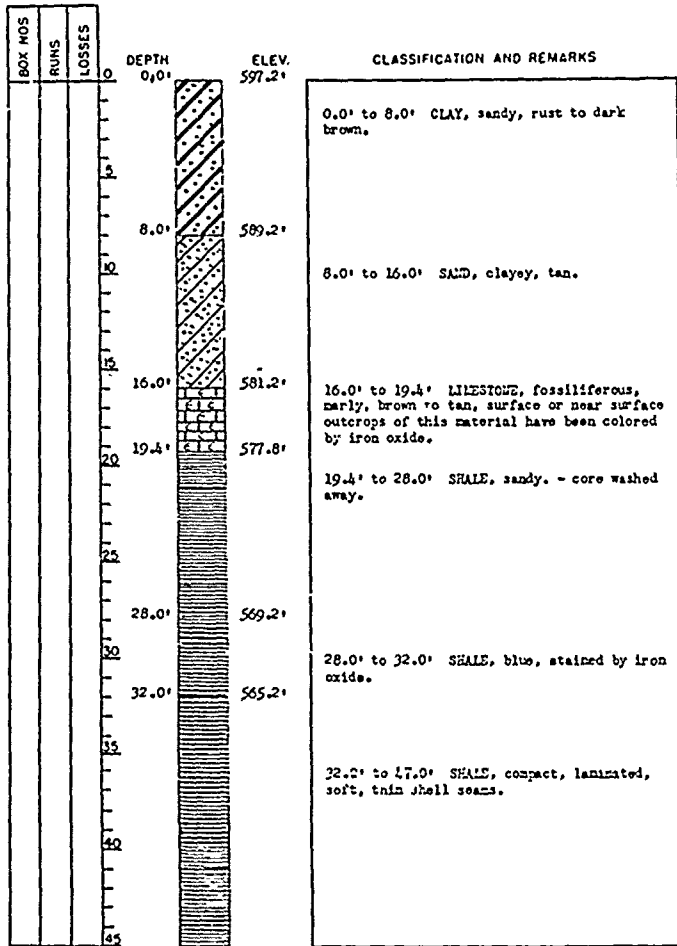

UNITED STATES ENGINEER OFFICE
ENGINEERING DIVISION
FIELD INVESTIGATIONS SECTION
GALVESTON, TEXAS

LOG OF CORE DRILLING

Site Aubrey Date 20 August 1946
Sheet 1 of 2
Hole No. C-2 Drill No. _____ Location C.L. Sta. 11/27
Type of Bit _____ Elevation of Top of Hole 562.0'
Size of Core 2-Inch Depth of Overburden 28.0'
Method of Overburden Sampling Earth Auger Elevation of Top of Bedrock 534.0'
Set _____ of _____ Casing Pulled Casing Yes () No ()
Depth to Water Table _____ Elevation of Water Table _____
Total Depth of Hole 68.0' Elevation of Bottom of Hole 494.0'
Overburden Sampling 28.0' Core Drilling 40.0' % Recovery _____
Date Hole Started 4 January 1939 Date Hole Completed 6 January 1939
Number of Jars/Tubes 1 Marked Upper Elm Creek C.L. Sta. 11/27
Number of Boxes 2 Marked Upper Elm Creek C.L. Sta. 11/27
Classified by _____ Submitted by _____

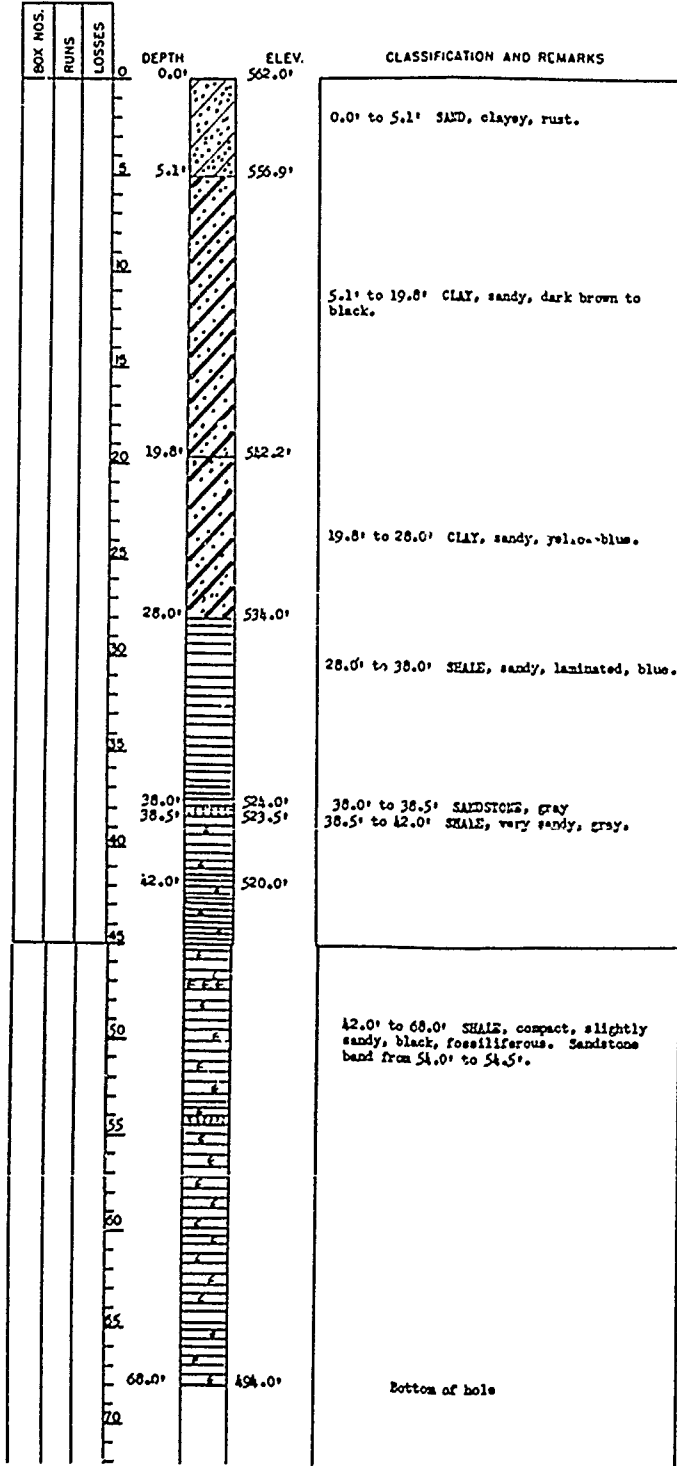

RECORD DRAWING-WORK AS BUILT

SYMBOL NO.	ACTION	DATE	DESCRIPTION OF REV. SIGN.
U.S. ARMY ENGINEER DISTRICT, FORT WORTH CORPS OF ENGINEERS FORT WORTH, TEXAS			
DESIGNED BY	RAY ROBERTS LAKE ELM FORK, TRINITY RIVER, TEXAS EMBANKMENT, SPILLWAY AND OUTLET WORKS LOGS OF BORINGS C-1 AND C-2		
DRAWN BY			
REVIEWED BY			
SUBMITTED BY			
ENGINEER	INVITATION NO. <u>DACW63-820 C025</u>	DATE <u>MAR, 1942</u>	SEQUENCE NO. <u>10</u>
	CONTRACT NO. <u>DACW63-82-C-6093</u>		
	DRAWING NUMBER	SHEET NO.	OF

TO ACCOMPANY FOUNDATION REPORT

PROJECT NO. DACW63-82-C-6093


UNITED STATES ENGINEER OFFICE
ENGINEERING DIVISION
FIELD INVESTIGATIONS SECTION
GALVESTON, TEXAS

LOG OF CORE DRILLING

Date 20 August 1946

Site Aubrey Sheet 1 of 2
C.L. Sta. 28700

Hole No. C-1	Drill No.	Location In
Type of Bit		Elevation of Top of Hole 559.2'
Size of Core 2-Inch		Depth of Overburden 85.0'
Method of Ovb. Sampling Earth Auger		Elevation of Top of Bedrock 514.2'
Set of Casing		Pulled Casing Yes () No ()
Depth to Water Table		Elevation of Water Table
Total Depth of Hole 67.0'		Elevation of Bottom of Hole 532.2'
Overburden Sampling 45.0'		Core Drilling 22.0' Recoveries
Date Hole Started 7 January 1939		Date Hole Completed 10 January 1939
Number of Jars/Tubes 1		Marker Upper Elm Creek C.L. Sta. 28700
Number of Boxes 1		Marker Lower Elm Creek C.L. Sta. 28700
Classified by		Submitted by

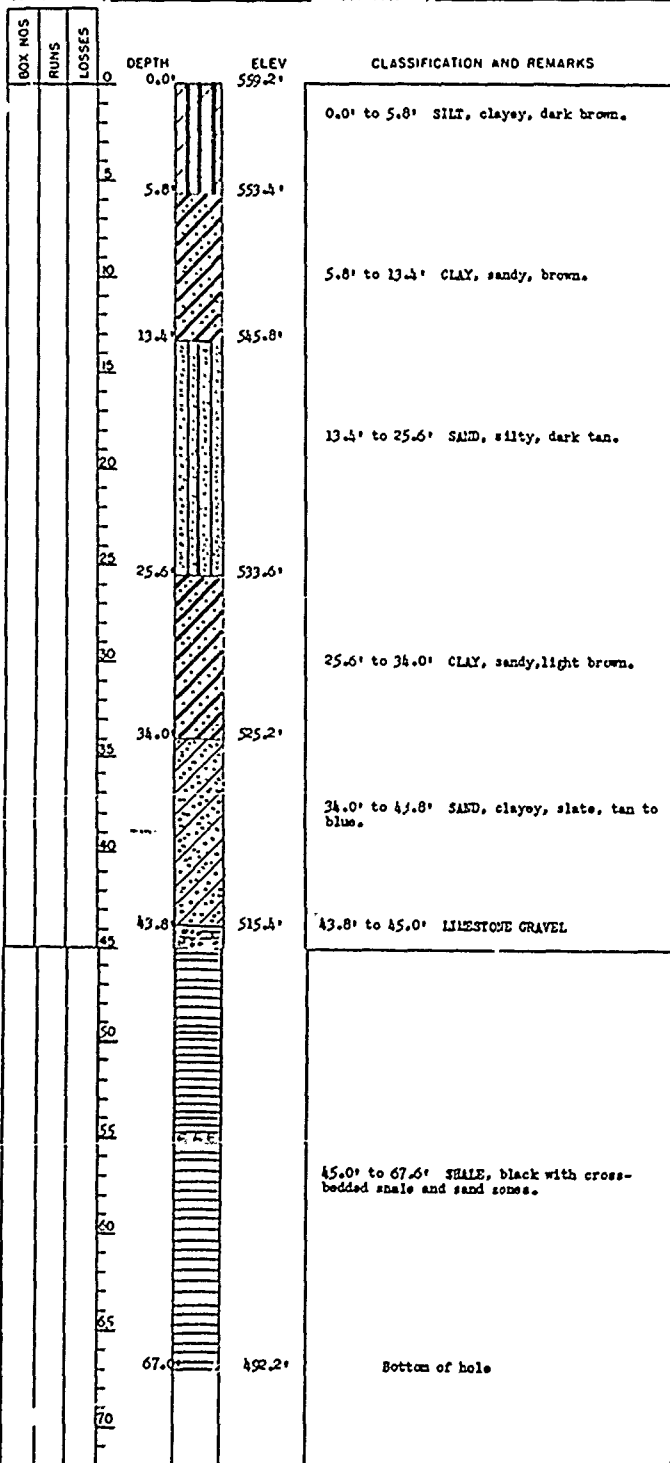


UNITED STATES ENGINEERING DIVISION
FIELD INVESTIGATIONS SECTION
GALVESTON, TEXAS

LOG OF CORE

Site Aubrey

Hole No. C-4	Drill No.	Location In
Type of Bit		Elevation of Top of Hole
Size of Core 2-Inch		Depth of Overburden
Method of Ovb. Sampling Earth Auger		Elevation of Top of Bedrock
Set of Casing		Pulled Casing Yes () No ()
Depth to Water Table		Elevation of Water Table
Total Depth of Hole 82.0'		Elevation of Bottom of Hole
Overburden Sampling 16.0'		Core Drilling Recoveries
Date Hole Started 6 January 1939		Date Hole Completed
Number of Jars/Tubes 2		Marker
Number of Boxes 1		Submitted by

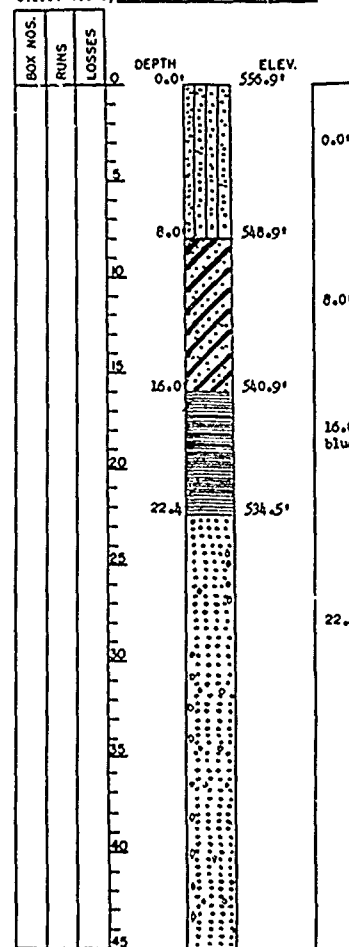


UNITED STATES ENGINEER OFFICE
ENGINEERING DIVISION
FIELD INVESTIGATIONS SECTION
GALVESTON, TEXAS

LOG OF CORE DRILLING

Date 20 August 1946

Site Aubrey C.L. Sta. 28735 500' below.

Hole No. C-4 Drill No. _____ Location No. _____
 Type of Bit _____ Elevation of Top of Hole 556.9'
 Size of Core 2-Inch Depth of Overburden 16.0'
 Method of Ovb. Sampling Wash Lucas Elevation of Top of Bedrock 530.9'
 Set _____ of _____ Casing Pulled Casing Yes () No ()
 Depth to Water Table _____ Elevation of Water Table _____
 Total Depth of Hole 82.0' Elevation of Bottom of Hole 478.9'
 Overburden Sampling 16.0' Core Drilling 76.0' Recovery _____
 Date Hole Started 6 January 1939 Bit Hole Completed 10 January 1939
 Number of Jars/Tubes 2 Marked Upper Elm Creek 500' below 28700
 Number of Boxes 1 Marked Upper Elm Creek 500' below 28700
 Classified by _____ Submitted by _____

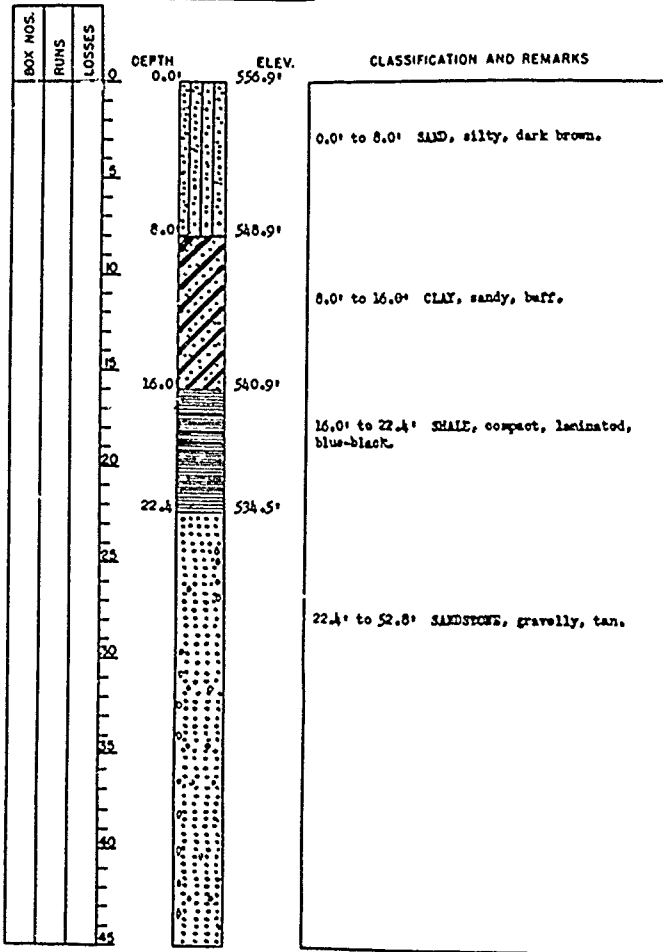



LOG OF CORE DRILLING CONTINUATION 3rd

Site Aubrey

Hole No. C-4

Sheet 2 of 2

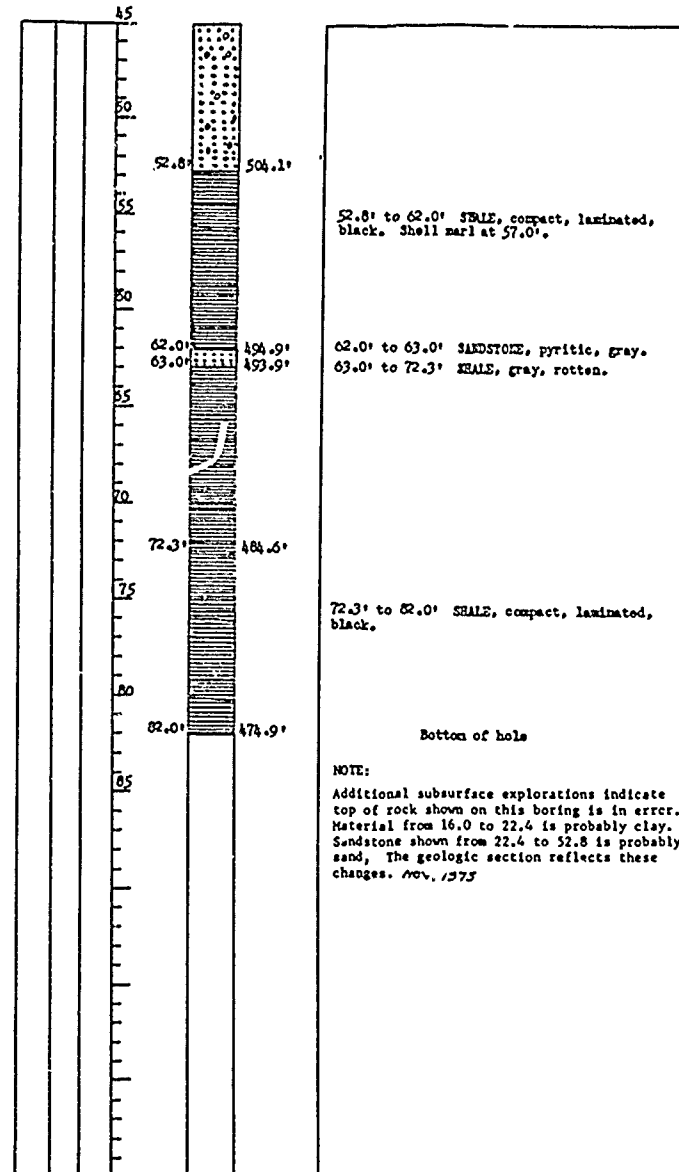

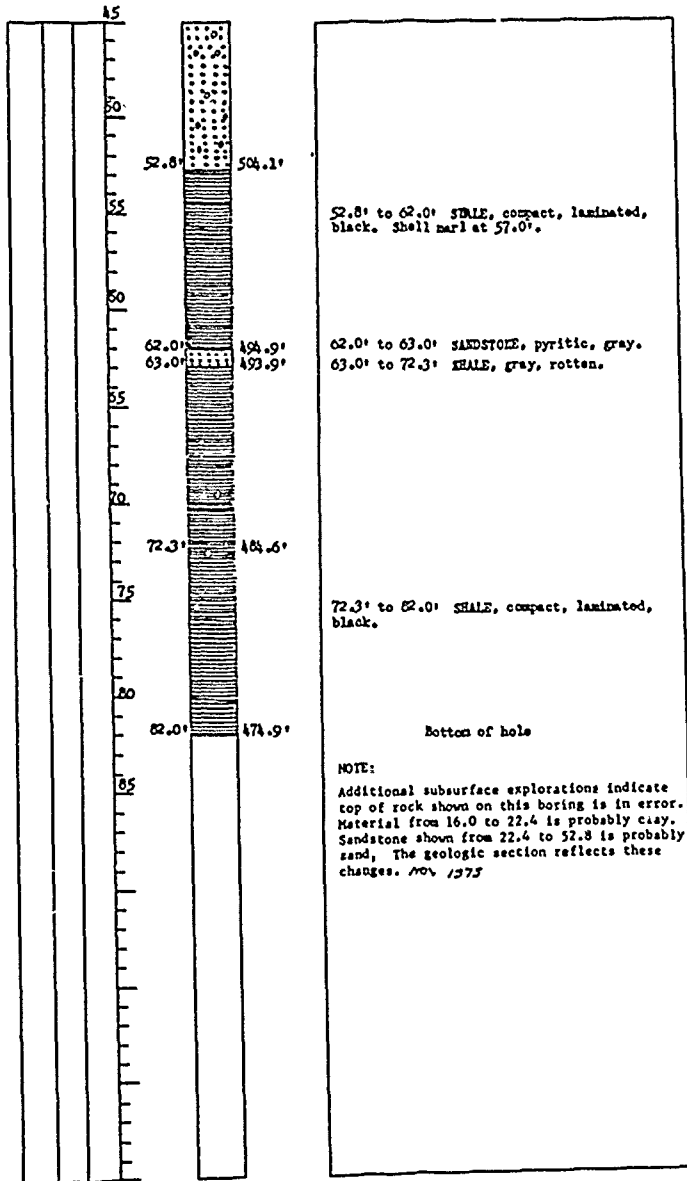


RECORD DRAWING-WORK AS BUILT

SYM	QC NO	ACTION	DATE	DESCR OF WORK	REV	SYM
U.S. ARMY ENGINEER DISTRICT, FORT WORTH CORPS OF ENGINEERS FORT WORTH, TEXAS						
DESIGNED BY:	RAY ROBERTS LAKE ELM FORK, TRINITY RIVER, TEXAS EMBANKMENT, SPILLWAY AND OUTLET WORKS LOGS OF BORINGS C-3 AND C-4					
DRAWN BY:						
REVIEWED BY:						
SUBMITTED BY:	INVITATION NO. DACW 63-82-B-0025	DATE	MAR, 1962			
ENGINEER	CONTRACT NO. DACW 63-72-C-0782	DRAWING NUMBER	SHEET NO. OF	9		

UNITED STATES ENGINEER OFFICE
ENGINEERING DIVISION
FIELD INVESTIGATIONS SECTION
GALVESTON, TEXAS

LOG OF CORE DRILLING


Site Aubrey Date 20 August 1946
 Hole No. C-5 Drill No. 1 Location 500' above Gal. Sta. 28700
 Type of Bit 2-Inch Elevation of Top of Hole 560.3'
 Size of Core 2-Inch Depth of Overburden 37.0'
 Method of Ovb. Sampling Earth Auger Elevation of Top of Bedrock 523.3'
 Set of Casing Pulled Casing Yes () No ()
 Depth to water Table Elevation of water Table
 Total Depth of Hole 68.0' Elevation of Bottom of Hole 492.3'
 Overburden Sampling 37.0' Core Drilling 31.0' Recovery
 Date Hole Started 18 January 1939 Date Hole Completed 20 January 1939
 Number of Jars/Tubes None Marked
 Number of Boxes 1 Marked Upper Elm Creek 500' Above Sta. 28700
 Classified by Submitted by

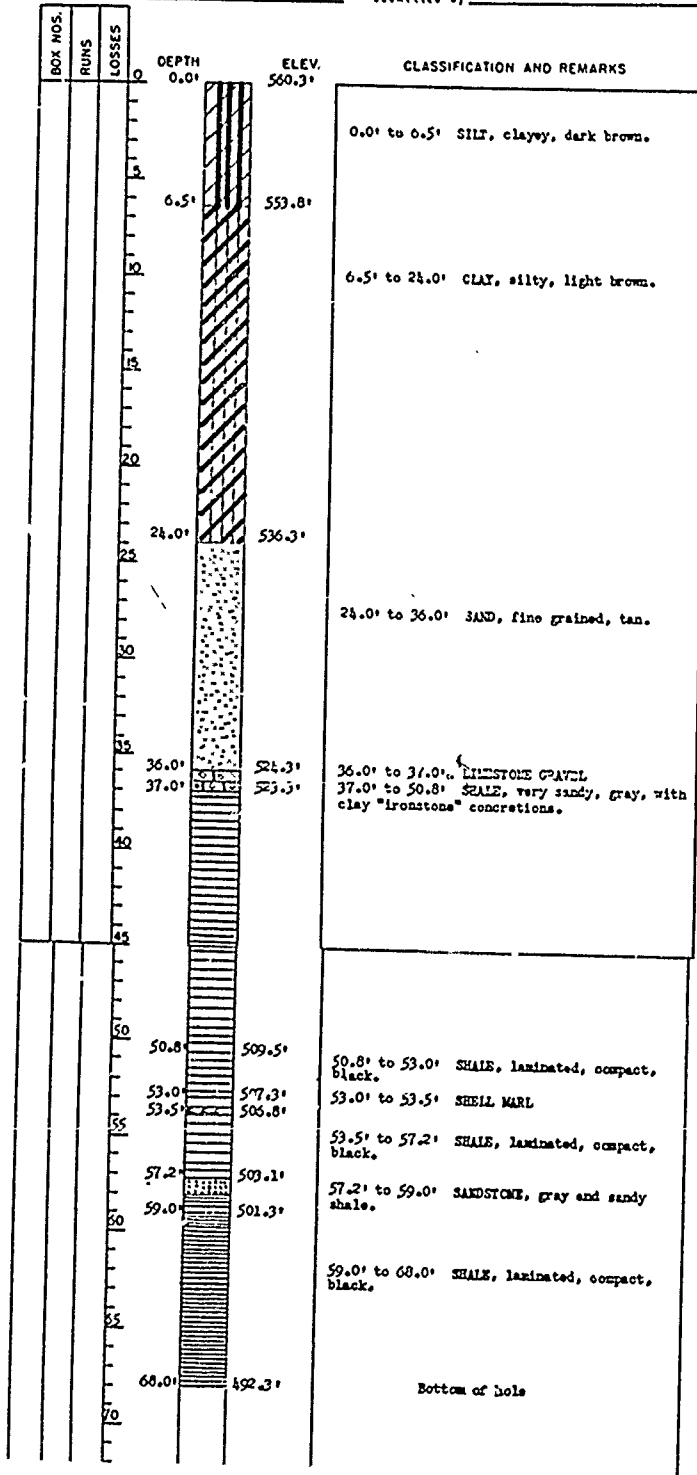

UNITED STATES ENGINEER OFFICE
ENGINEERING DIVISION
FIELD INVESTIGATIONS SECTION
GALVESTON, TEXAS

LOG OF CORE DRILLING

Site Aubrey Location
 Hole No. C-6 Drill No. Elevation of
 Type of Bit Depth of
 Size of Core 2-Inch Elevation of
 Method of Ovb. Sampling Earth Auger Elevation of
 Set of Casing Pulled Casing
 Depth to water Table Elevation of
 Total Depth of Hole Elevation of
 Overburden Sampling Core Drilling Recovery
 Date Hole Started 16 January 1939 Date Hole Completed
 Number of Jars/Tubes None Marked
 Number of Boxes 1 Marked
 Classified by Submitted by

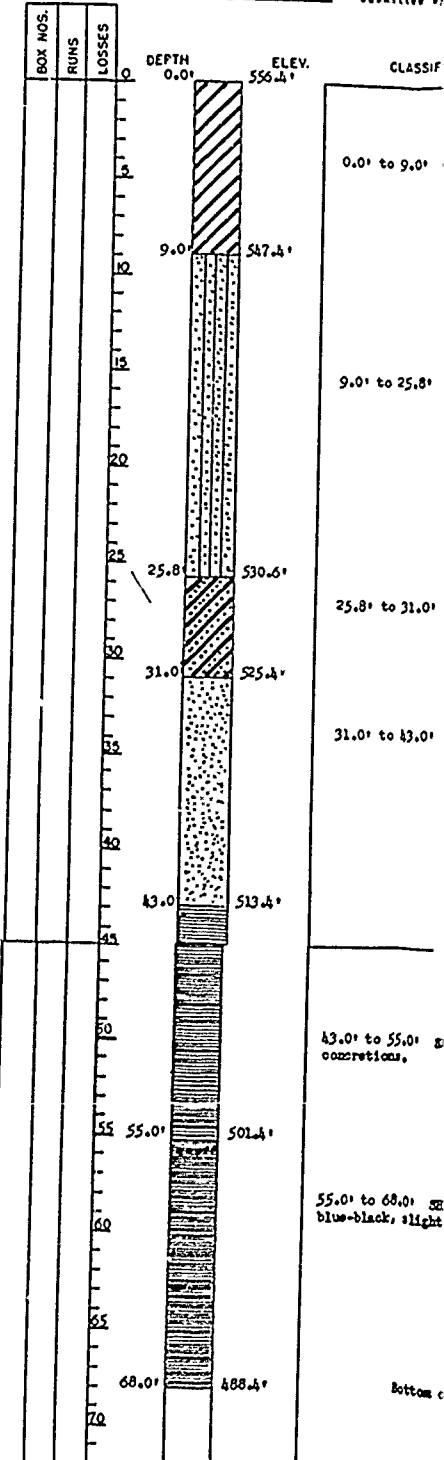


UNITED STATES ENGINEER OFFICE
ENGINEERING DIVISION
FIELD INVESTIGATIONS SECTION
GALVESTON, TEXAS

LOG OF CORE DRILLING

Date 20 August 1946

Site Aubrey Sheet 1 of 2
C.L. Sta. 36400
Hole No. C-6 Drill No. _____ Location In _____
Type of Bit _____ Elevation of Top of Hole 556.4'
Size of Core 2-inch Depth of Overburden 43.0'
Method of Overburden Sampling Earth Auger Elevation of Top of Bedrock 513.4'
Set _____ of _____ Casing Pulled Casing Top () No ()
Depth to Water Table _____ Elevation of Water Table _____
Total Depth of Hole 68.0' Elevation of Bottom of Hole 488.4'
Overburden Sampling 43.0' Core Drilling 25.0' Recovery _____
Date Hole Started 16 January 1939 Date Hole Completed 18 January 1939
Number of Jars/Tubes None Marked Upper Elm Creek C.L. Sta. 36400
Number of Boxes 1 Classified by _____
Submitted by _____

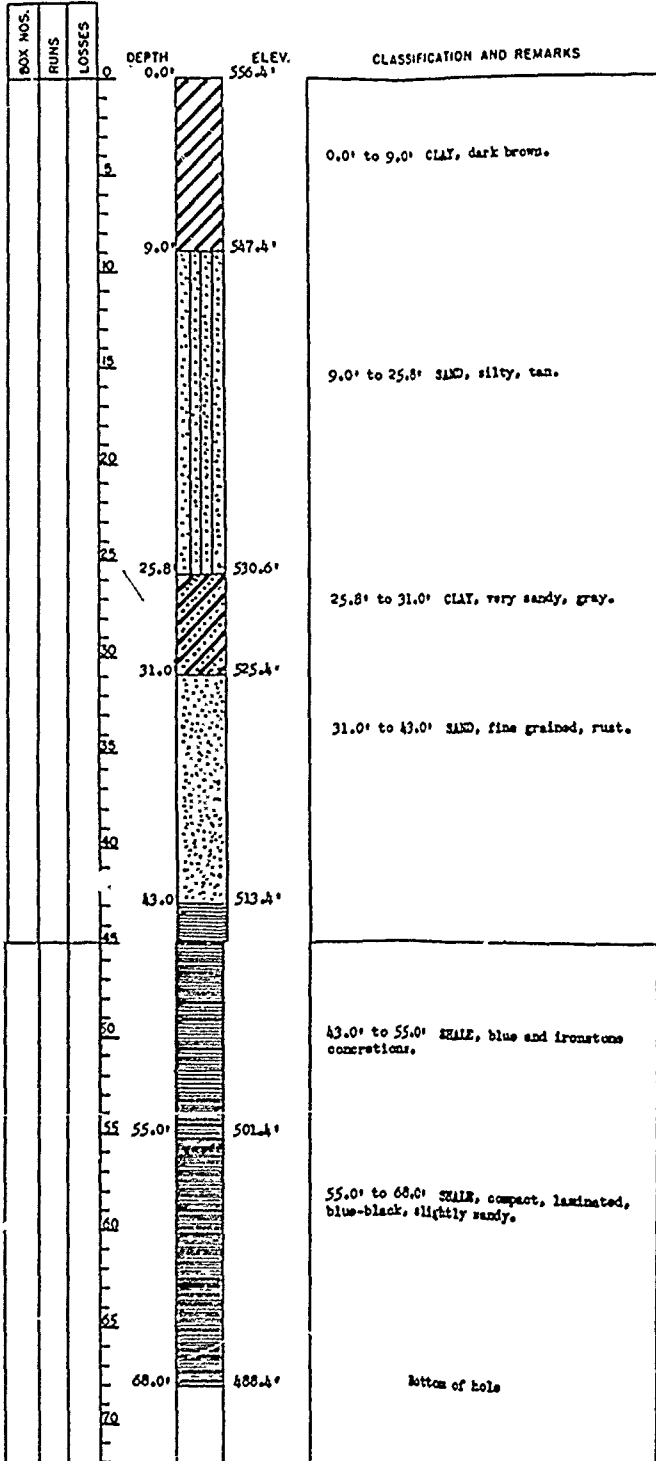


UNITED STATES ENGINEER OFFICE
ENGINEERING DIVISION
FIELD INVESTIGATIONS SECTION
GALVESTON, TEXAS

LOG OF CORE DRILLING

Date 20 August 1946

Site Aubrey Sheet 1 of 2
C.L. Sta. 45400
Hole No. C-7 Drill No. _____ Location In _____
Type of Bit _____ Elevation of Top of Hole 590.9'
Size of Core 2-inch Depth of Overburden 28.0'
Method of Overburden Sampling Earth Auger Elevation of Top of Bedrock 562.9'
Set _____ of _____ Casing Pulled Casing Top () No ()
Depth to Water Table _____ Elevation of Water Table _____
Total Depth of Hole 95.0' Elevation of Bottom of Hole 495.9'
Overburden Sampling 28.0' Core Drilling 67.0' Recovery _____
Date Hole Started 12 January 1939 Date Hole Completed 16 January 1939
Number of Jars/Tubes 1 Marked Upper Elm Creek C.L. Sta. 45400
Number of Boxes 2 Classified by _____
Submitted by _____

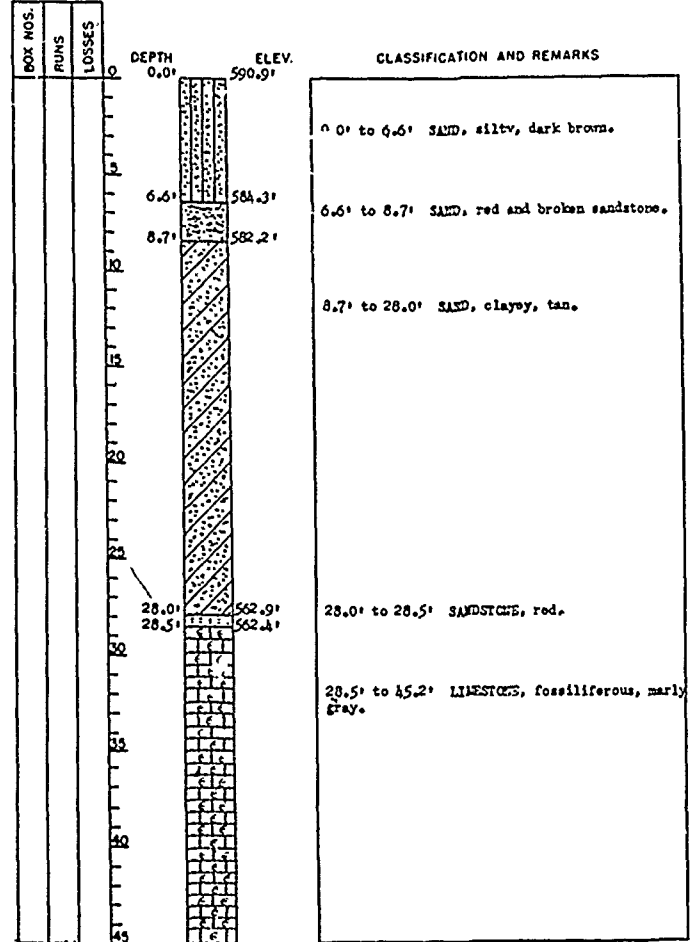


UNITED STATES ENGINEER OFFICE
ENGINEERING DIVISION
FIELD INVESTIGATIONS SECTION
GALVESTON, TEXAS

LOG OF CORE DRILLING

Date 20 August 1946
Sheet 1 of 2
Site Aubrey C.L. Sta. 45780
Drill No. C-7
Location In C.L. Sta. 45780
Elevation of Top of Hole 500.01
Depth of Overburden 28.01
Elevation of Top of Bedrock 522.91
Pulled Casing Yes () No ()
Elevation of Water Table 505.01
Elevation of Bottom of Hole 505.01
Core Drilling 67.01 % Recovery
Date Hole Completed 16 January 1939
Marked Upper Elm Creek C. L. Sta. 45780
Marked Lower Elm Creek C. L. Sta. 45780
Submitted by

Core No. C-7 Drill No. _____
Type of Bit _____
Size of Core 2-Inch
Method of Casing Earth Auger
Depth to Water Table _____
Total Depth of Hole 95.01
Overburden Sampling 28.01
Date Hole Started 12 January 1939
Number of Jars/Tubes 1
Number of Boxes 2
Classified by _____

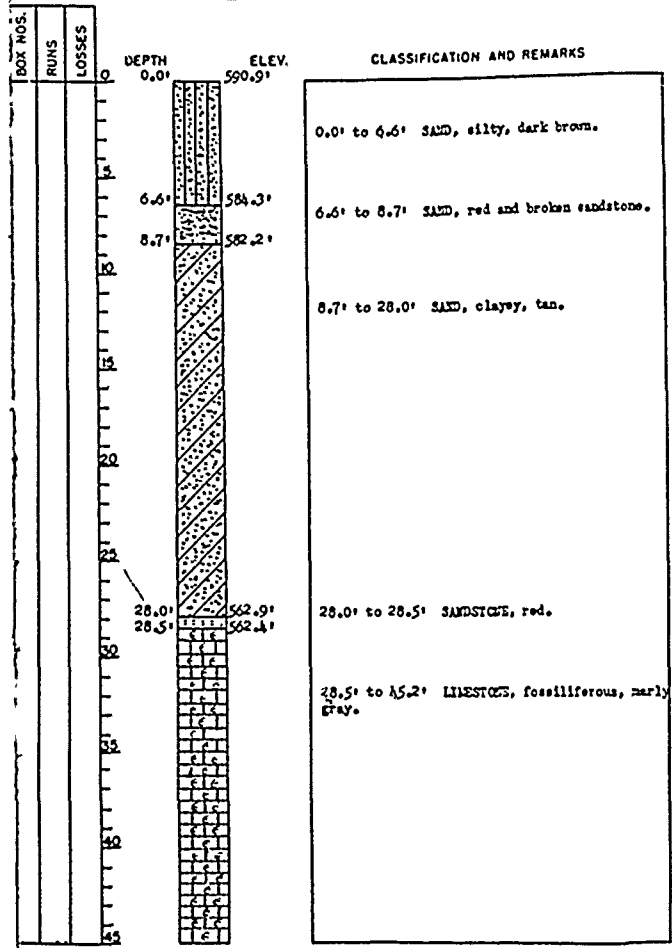


SM28-C-2

LOG OF CORE DRILLING CONTINUATION SHEET

Site Aubrey

Hole No. C-7

Sheet 2 of 2

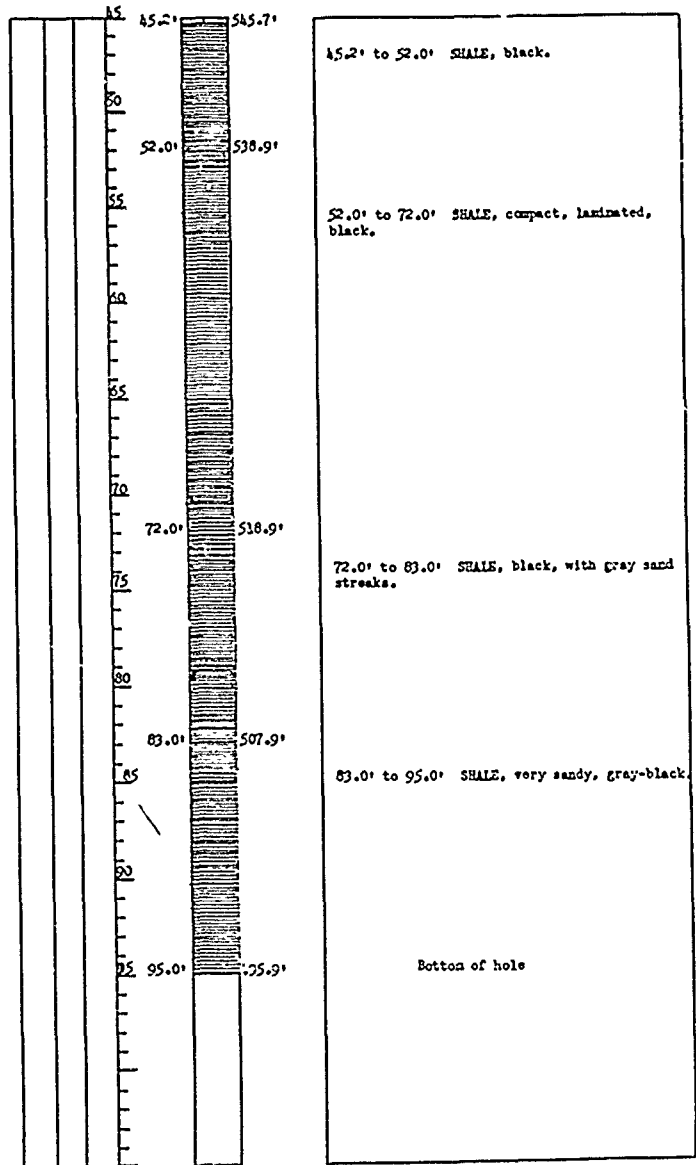

RECORD DRAWING-WORK AS BUILT

SYMBOL NO.	ACTION	DATE	DESCRIPTION OF REVISION
U.S. ARMY ENGINEER DISTRICT, FORT WORTH CORPS OF ENGINEERS FORT WORTH, TEXAS			
DESIGNED BY	RAY ROBERTS LAKE		
DRAWN BY	ELM FORK, TRINITY RIVER, TEXAS		
REVIEWED BY	EMBANKMENT, SPILLWAY AND		
	OUTLET WORKS		
	LOGS OF BORINGS		
	C-5, C-6 AND C-7		
SUBMITTED BY	INVITATION NO. DACW63-82-B-0025	DATE	MAR, 1962
ENGINEER	CONTRACT NO. DACW63-92-C-0095	SHEET NO.	10
	DRAWING NUMBER	OF	


TO ACCOMPANY FOUNDATION REPORT

SVER-C-1.

UNITED STATES ENGINEER OFFICE
ENGINEERING DIVISION
FIELD INVESTIGATIONS SECTION
GALVESTON, TEXAS

LOG OF CORE DRILLING


Site Aubrey Date 20 August 1946
 Hole No. C-8 Drill No. _____ Location Co. Ls. Sta. 51436
 Type of Bit _____ Elevation of Top of Hole 723.2'
 Size of Core 2-inch Depth of Overburden 17.0'
 Method of Ovb. Sampling Earth Auger Elevation of Top of Sadrack 706.2'
 Set _____ of Casing Pulled Casing Yes () No ()
 Depth to Water Table _____ Elevation of Water Table _____
 Total Depth of Hole 217.0' Elevation of Bottom of Hole 506.2'
 Overburden Sampling 17.0' Core Drilling 200.0' % Recovery _____
 Date Hole Started 12 January 1939 Date Hole Completed 30 January 1939
 Number of Jars/Tubes 1 Marked Upper Elm Creek C.L. Sta. 51436
 Number of Boxes 4 Marked Upper Elm Creek C.L. Sta. 51436
 Classified by _____ Submitted by _____

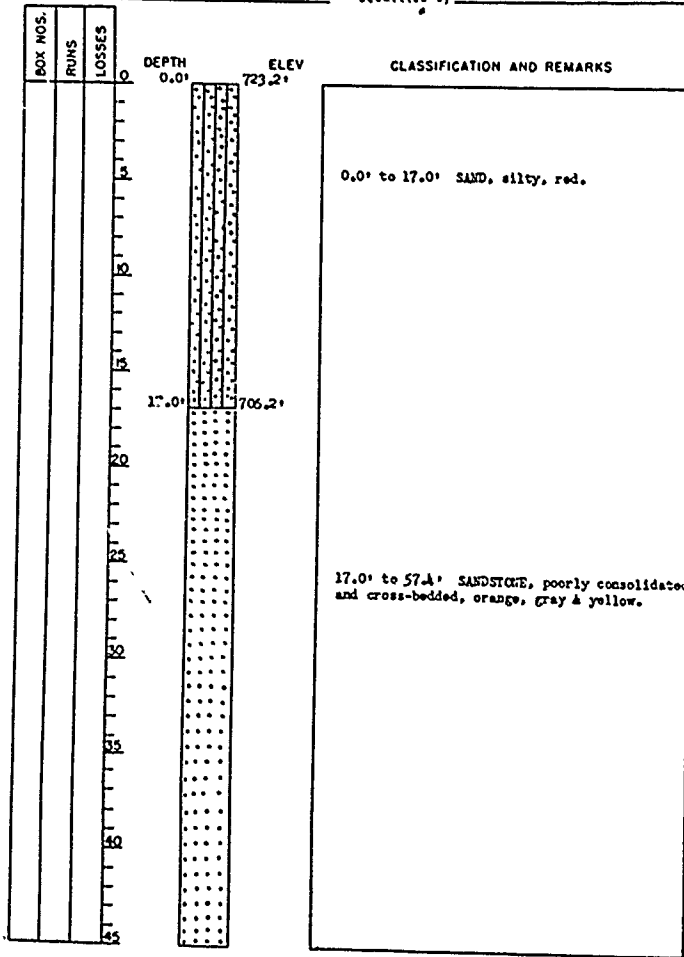

SVER-C-2.

LOG CORE DRILLING CONTINUATION SV

Site Aubrey Hole No. C-8

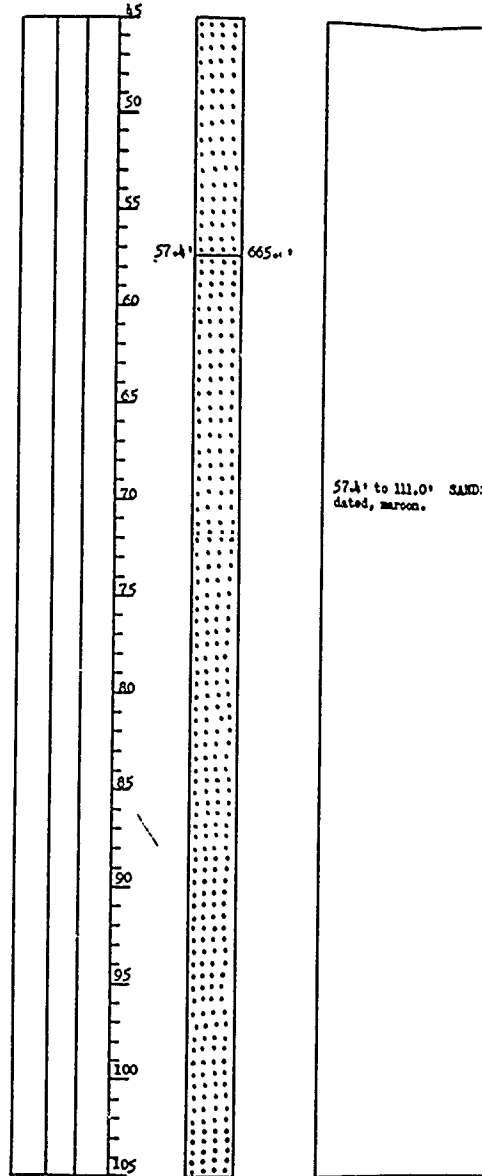

Hole No. C-8





Sheet 2 of 3



Site Aubrey

Hole No. C-8

Sheet 2 of 3

Site Aubrey

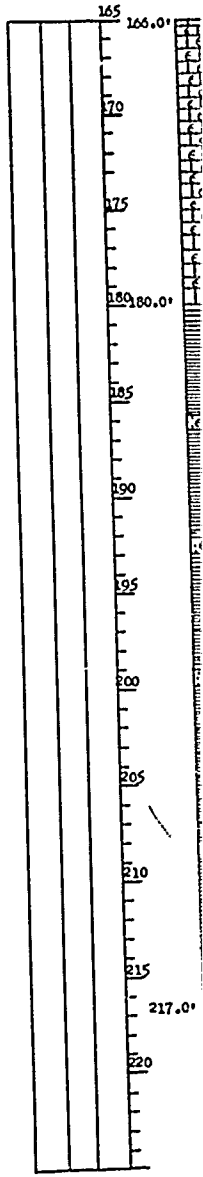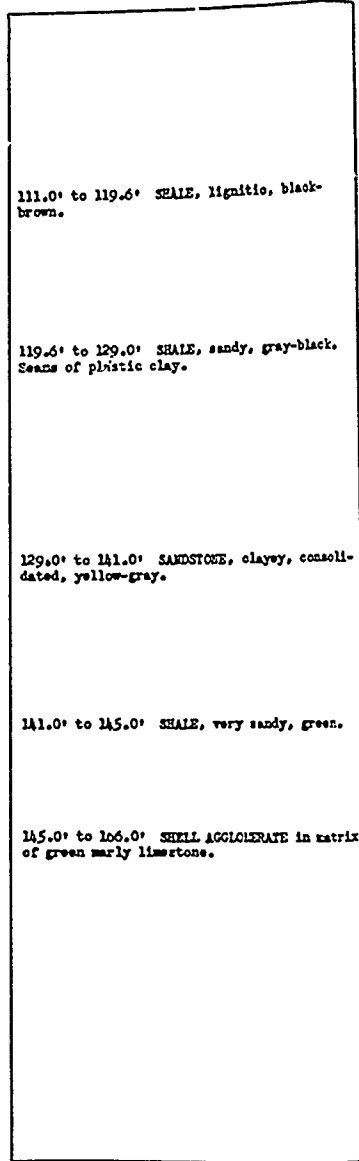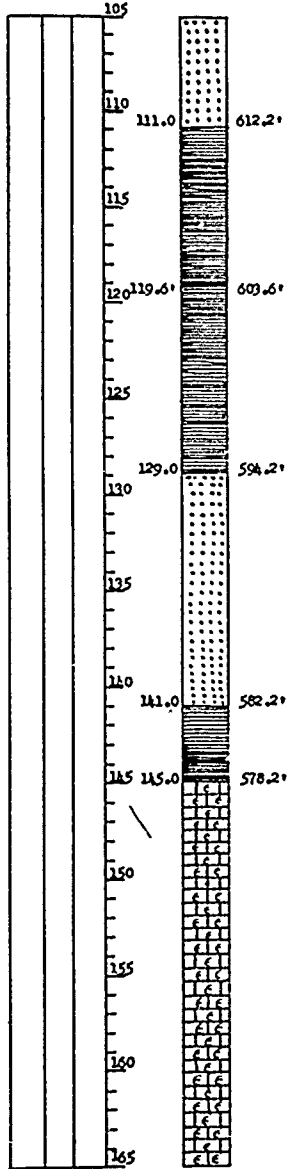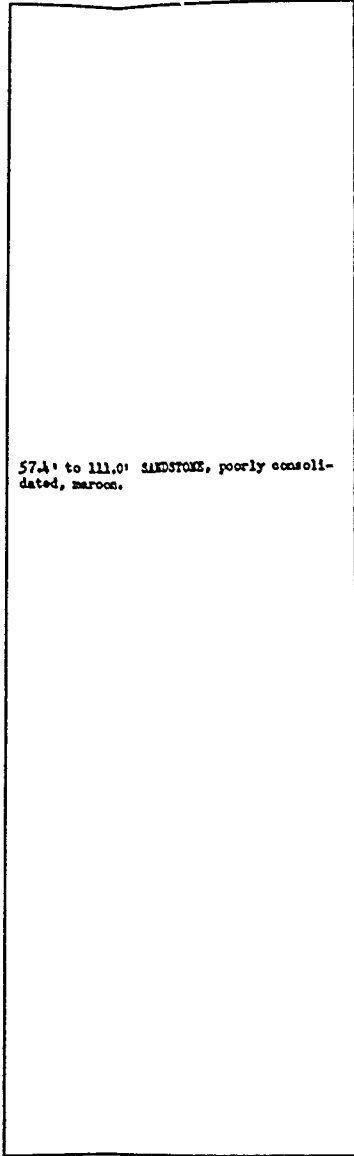

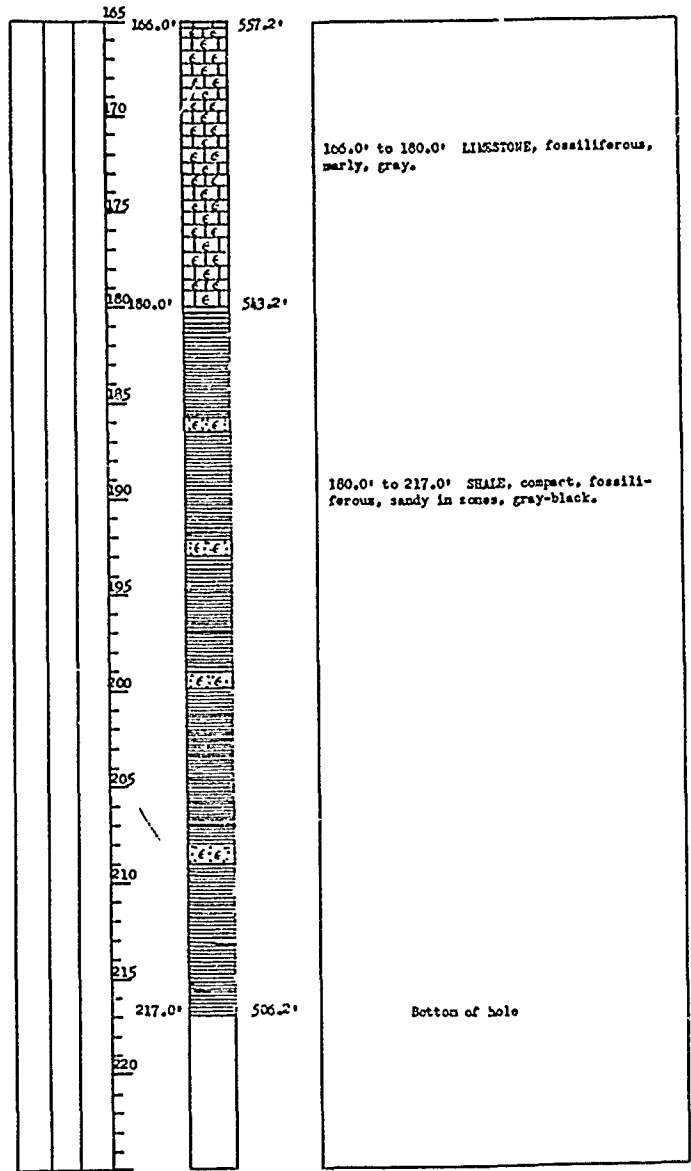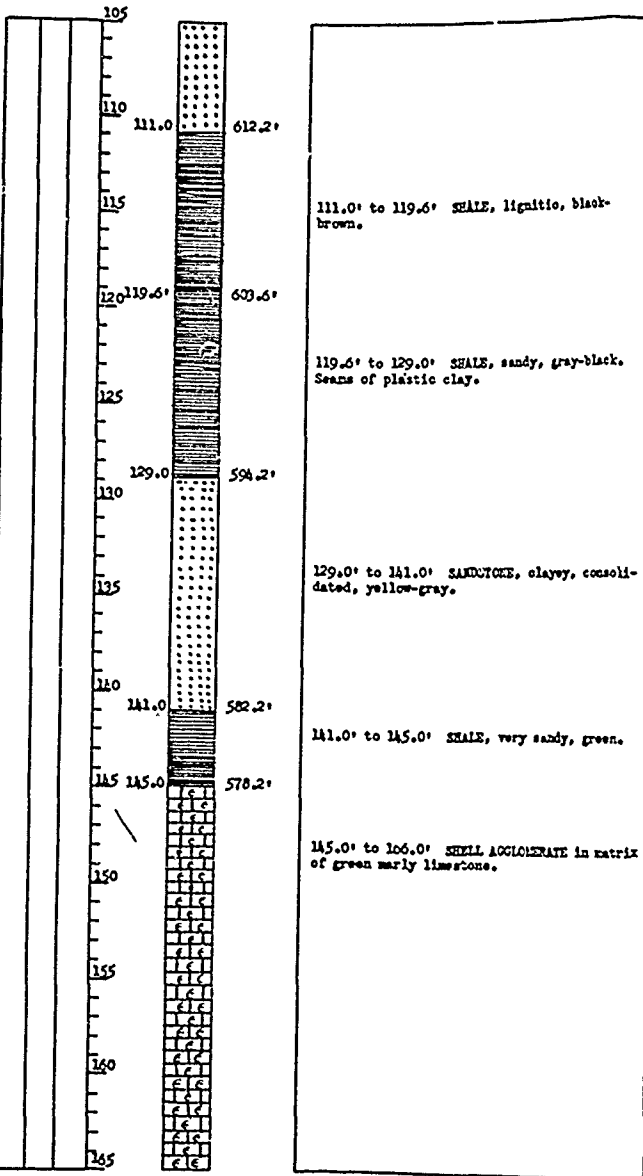

RECORD DRAWING - WORK AS BUILT

SYM	LOG NO	ACTION	DATE	DESCRIPTION OF REVISION
U.S. ARMY ENGINEER DISTRICT, FORT WORTH CORPS OF ENGINEERS FORT WORTH, TEXAS				
DESIGNED BY	RAY ROBERTS LAKE ELM FORK, TRINITY RIVER, TEXAS EMBANKMENT, SPILLWAY AND OUTLET WORKS LOGS OF BORINGS C-8			
DRAWN BY				
REVIEWED BY				
SUBMITTED BY				
ENGINEER	INVITATION NO. DACW63-82-B-0025	DATE: MAR, 1982	SEQUENCE NO. 11	
	CONTRACT NO. DACW63-72-C-0092		SHEET NO. OF 11	
	DRAWING NUMBER			

TO ACCOMPANY FOUNDATION REPORT

File No. 8A2C-9

DRILLING LOG			INSTALLATION		SHEET 1	
1. PROJECT Aubrey Dam Site			Port Worth District		of 3 SHEETS	
2. LOCATION (Continent or Feature)			3. SIZE AND TYPE OF BIT 8" Auger 2" Core Bbl		4. DATE FOR ELEVATION (Month/Day/Year)	
5. DRILLING AGENCY Corps of Engineers			6. HURST/TURK'S ORIENTATION Falling 1500		7. TOTAL NO. OF OVERBURDEN SAMPLES TAKEN	
8. HOLE NO. (As shown on drawing note) and file number 8A2C-9			9. TOTAL NUMBER CORE BOXES 5		10. ELEVATION GROUND WATER	
11. NAME OF DRILLER R. M. Dunn			12. DATE HOLE STARTED 5 Dec 50		13. DATE HOLE COMPLETED 8 Dec 60	
14. DIRECTION OF HOLE <input checked="" type="checkbox"/> Vertical <input type="checkbox"/> Inclined <input type="checkbox"/> Dev. from vert.			15. ELEVATION TOP OF HOLE 600.3'		16. TOTAL CORE RECOVERY FOR BORING 84	
17. THICKNESS OF OVERBURDEN 4.5			18. SIGNATURE OF INSPECTOR			
19. DEPTH DRILLED INTO ROCK 101.3						
20. TOTAL DEPTH OF HOLE 106.0						
ELEVATION	DEPTH	LEGEND	CLASSIFICATION OF MATERIALS (Description)	1. CORE RECOVERY	2. BOX OR SAMPLE NO.	REMARKS (Drilling time, water loss, depth of weathering, etc., if significant)
596.0'	4.5'		Start 2" core 4.5' to 3.9' limestone, marly, hard, siliceous, massive weathered, dark red oxidized streak from 8.0' to 8.4', gray to buff	75	Box 1	*Ground water elevation undetermined Jar Sample Depths A- 0.0 to 3.6' B- 3.6 to 4.3'
591.6'	8.9'		8.9 to 12.3 clay, shaly, sand lenses thru out, weathered, slightly laminated, tan to gray	80		
588.2'	12.3'		NOTE: Base of weathering zone	86		
30			12.3 to 96.5' shale, clayey, sandy, firm to medium hard, very fossiliferous, laminated, dark gray	86		
			NOTE: Medium hard sandstone streaks at following depths: 16.7 to 16.9 24.7 to 25.3 40.0 to 40.4 43.1 to 43.3 48.0 to 48.4 55.0 (Siltstone)	86	Box 2	
8				90		
				97		

ELEVATION	DEPTH	LEGEND	CLASSIFICATION OF MATERIALS (Description)	1. CORE RECOVERY	2. BOX OR SAMPLE NO.
504.0'	96.5'		96.5' to 100.0 LIMESTONE sandy, hard, massive, fossiliferous, gray	100	
			100' to 106.0' SHALE, clayey firm, laminated, gray	40	Box 5
494.5'	106.0'		T. D. 106.0'		

3. CORE RECOVERY %	4. BOX NO.	5. REMARKS (Drilling time, water flow, depth of weathering, etc., if significant)
84	Box 3	
92		
90	Box 4	
88		
100		
40	Box 5	

Hole No. **8A2C-10**

DRILLING LOG		INSTALLATION		SHEET		
1. PROJECT: Southwestern		Fort Worth District		1 of 2 INSETS		
2. LOCATION: Aubrey Dam Site		3. HOLE NO. AND TYPE OF HOLE: 8" Auger 2" Core 8bl		4. DATE OF LOGGING: 15 Dec 60		
5. DRILLING AGENCY: Corps of Engineers		6. HOLE NO. (As shown on drawing etc. and file number): 8A2C-10		7. DATE OF LOGGING: 15 Dec 60		
8. NAME OF DRILLER: R. M. Dunn		9. ELEVATION GROUND WATER: 0		10. SIGNATURE OF INSPECTOR: [Blank]		
11. THICKNESS OF OVERBURDEN: 19.5		12. TOTAL NO. OF OVERBURDEN SAMPLES TAKEN: 3		13. TOTAL NUMBER CORE BOIES: 2		
14. DEPTH DRILLED INTO ROCK: 45.5		15. ELEVATION TOP OF HOLE: 610.8		16. TOTAL CORE RECOVERY FOR BORING: 90		
17. TOTAL DEPTH OF HOLE: 60.0		18. DATE HOLE STARTED: 15 Dec 60		19. DATE HOLE COMPLETED: 15 Dec 60		
ELEVATION	DEPTH	LEGEND	CLASSIFICATION OF MATERIALS (Description)	3. CORE RECOVERY %	4. BOX ON SAMPLE NO.	5. REMARKS (Drilling time, water flow, depth of weathering, etc., if significant)
596.3'	14.5'		Start 2" Core 14.5'			*Ground water elevation on 16 Dec 1960 was (8.0)
			14.5' to 25.8' clay, shaly, firm, fine sand lenses thru out, soft sandstone; streak at 16.8, and 22.1, very hard limestone boulder at 17.6'; gray to yellow	72	Box 1	Jar Sample Depths: A - 0.0' to 5.5' B - 5.5' to 10.4' C - 10.4' to 13.8'
585.0'	25.0'		25.8' to 41.8' SHALE, clayey firm weathering stains in upper 3.0'; sandy, laminated small fossils thru out dark gray	100		
			NOTE: Base of weathering at 29.0'. Lime seam at 35.0' which is 0.1 thick	90		
569.0'	41.8'		41.8' to 43.3' SAND, clayey, firm-almost sandstone, distinct bedding, fine to medium gray	100		
567.5'	43.3'		43.3' to 60.0' SHALE, clayey sandy firm to medium hard lime boulder at 44.8, very fossiliferous from 47.0 to 51.0, laminated, 4' sandstone at 58.0', dark gray	100	Box 2	
				97		
550.8'	60.0'		T. D. 60.0'			

Hole No. **8A2C-11**

DRILLING LOG		INSTALLATION		SHEET		
1. PROJECT: Southwestern		Fort Worth District		1 of 2 INSETS		
2. LOCATION: Aubrey Dam Site		3. HOLE NO. AND TYPE OF HOLE: 8" Auger 2" Core 8bl		4. DATE OF LOGGING: 15 Dec 60		
5. DRILLING AGENCY: Corps of Engineers		6. HOLE NO. (As shown on drawing etc. and file number): 8A2C-11		7. DATE OF LOGGING: 15 Dec 60		
8. NAME OF DRILLER: R. M. Dunn		9. ELEVATION GROUND WATER: 0		10. SIGNATURE OF INSPECTOR: [Blank]		
11. THICKNESS OF OVERBURDEN: 7.0'		12. TOTAL NO. OF OVERBURDEN SAMPLES TAKEN: 0		13. TOTAL NUMBER CORE BOIES: 2		
14. DEPTH DRILLED INTO ROCK: 23.6'		15. ELEVATION TOP OF HOLE: 610.8		16. TOTAL CORE RECOVERY FOR BORING: 90		
17. TOTAL DEPTH OF HOLE: 30.6'		18. DATE HOLE STARTED: 15 Dec 60		19. DATE HOLE COMPLETED: 15 Dec 60		
ELEVATION	DEPTH	LEGEND	CLASSIFICATION OF MATERIALS (Description)	3. CORE RECOVERY %	4. BOX ON SAMPLE NO.	5. REMARKS (Drilling time, water flow, depth of weathering, etc., if significant)
605.2'	7.0'		Start 2" core 7.0'			
			7.0' to 14.4' clay, sandy, firm to medium very weathered, horizontal fractures, yellow to t			
597.8'	14.4'		14.4' to 15.8' sandstone medium hard, fine to grain, massive, tan t			
596.4'	15.8'		15.8' to 22.5' shale, firm to medium hard, containing seams of sand and shale, weathered to gray.			NOTE: Base of weathering zone
589.7'	22.3'		22.5' to 30.6' shale, sandy, firm laminated, marine fossils, dark t			
581.6'	30.6'		T. D. 30.6'			

ENG. FORM 1836 PREVIOUS EDITIONS ARE OBSOLETE MAR 57

REC

DESIGNED BY	_____
DRAWN BY	_____
REVIEWED BY	_____
SUBMITTED BY	_____
ENGINEER	_____

TO ACCOMPLISH

Hole No. **8A2C-10**

PROJECT Southwestern	INSTALLATION Fort Worth District	SHEET 1 of 2 SHEETS
DATE 1962	NO. AND TYPE OF BIT 8" Auger 2" Core Bbl	DATE FOR ELEVATION MEASUREMENT 1962
AGENCY Engineers	MANUFACTURER'S DESIGNATION OF DRILL Falling 1500	TOTAL NO. OF OVERBURDEN SAMPLES TAKEN 3
DRILLER Dunn	TOTAL NUMBER CORE BORES 2	ELEVATION GROUND WATER *
DATE HOLE STARTED 15 Dec 60	DATE HOLE COMPLETED 15 Dec 60	ELEVATION TOP OF HOLE 610.8
THICKNESS OF OVERBURDEN 19.5	TOTAL CORE RECOVERY FOR BORING 90	SIGNATURE OF INSPECTOR
DEPTH OF HOLE 60.0		

DEPTH	LEGEND	CLASSIFICATION OF MATERIALS (Description)	NO. OF CORE RECOVERY	BOX OR SAMPLE NO.	REMARKS (Drilling time, water loss, depth of weathering, etc.; if significant)
0.0					*Ground water elevation on 16 Dec 1960 was (8.0)
0.0				A	
0.0				B	Jar Sample Depths: A - 0.0' to 5.5' B - 5.5' to 10.4' C - 10.4' to 13.8'
0.0				C	
4.5		Start 2" Core 14.5'			
16.5		16.5' to 25.8' clay, shaly, firm, fine sand lenses thru out, soft sandstone; streak at 16.8, and 22.1, very hard limestone boulder at 17.6'; gray to yellow	72	Box 1	
25.8		25.8' to 41.8' SHALE, clayey firm weathering stains in upper 3.0'; sandy, laminated small fossils thru out dark gray	100		
29.0		NOTE: Base of weathering at 29.0'. Lime seam at 35.0' which is 0.1' thick	90		
41.8		41.8' to 43.3' SAND, clayey, firm-almost sandstone, distinct bedding, fine to medium gray.	95		
43.3		43.3' to 60.0' SHALE, clayey, sandy firm to medium hard lime boulder at 44.8, very fossiliferous from 47.0 to 51.0, laminated, 4' sandstone at 58.0', dark gray	100		
60.0		T. D. 60.0'	97	Box 2	

Hole No. **8A2C-11**

PROJECT Southwestern	INSTALLATION Fort Worth District	SHEET 1 of 1 SHEETS
DATE 1962	NO. AND TYPE OF BIT Auger, 2" Core Bbl	DATE FOR ELEVATION MEASUREMENT 1962
AGENCY Engineers	MANUFACTURER'S DESIGNATION OF DRILL Falling 1500	TOTAL NO. OF OVERBURDEN SAMPLES TAKEN 2
DRILLER Dunn	TOTAL NUMBER CORE BORES 1	ELEVATION GROUND WATER *
DATE HOLE STARTED 16 Dec 60	DATE HOLE COMPLETED 16 Dec 60	ELEVATION TOP OF HOLE 612.2'
THICKNESS OF OVERBURDEN 2.0'	TOTAL CORE RECOVERY FOR BORING 86	SIGNATURE OF INSPECTOR
DEPTH OF HOLE 30.6'		

ELEVATION	DEPTH	LEGEND	CLASSIFICATION OF MATERIALS (Description)	NO. OF CORE RECOVERY	BOX OR SAMPLE NO.	REMARKS (Drilling time, water loss, depth of weathering, etc.; if significant)
605.2	7.0		7.0' to 14.4' clay, shaly, sandy, firm to medium hard, very weathered, horizontal fractures, yellow to tan	100		*Ground water elevation on 19 Dec 60 (10')
597.8	14.4		14.4' to 15.8 sandstone, medium hard, fine to medium grain, massive, tan to gray	70		Jar Sample Depths A - 0.0 to 3.5' B - 3.5' to 6.5'
596.4	15.8		15.8' to 22.5 shale, sandy, firm to medium hard, alternating seams of sand stone and shale, weathered tan to gray.	75		
589.7	22.5		NOTE: Base of weathering zone	95		
581.6	30.6		22.5' to 30.6 shale, clayey, sandy, firm laminated, few marine fossils, dark gray	88		
			T. D. 30.6'			

ENG FORM 1836 PREVIOUS EDITIONS ARE OBSOLETE PROJECT HOLE NO

RECORD DRAWING-WORK AS BUILT

DESIGNED BY	RAY ROBERTS LAKE ELM FORK, TRINITY RIVER, TEXAS		
DRAWN BY	EMBANKMENT, SPILLWAY AND OUTLET WORKS		
REVIEWED BY	LOGS OF BORINGS 8A2C-9, 8A2C-10, AND 8A2C-11		
SUBMITTED BY	INVITATION NO. DACW 63-22-B-0026	DATE: MAR 1962	
ENGINEER	CONTRACT NO. DACW 63-97-C-0093	SHEET NO. 12	

TO ACCOMPANY FOUNDATION REPORT

CONTINUED ON DACW 63-97-C-0093

DRILLING LOG		Southwestern		INSTALLATION		Fort Worth		SHEET 1 of 2 SHEETS	
PROJECT Aubrey Dam Site No. 1				NO. SIZE AND TYPE OF BIT 8" auger, 5" carbide, 0					
LOCATION Sta. 134.70 - Centerline				DATE FOR ELEVATION 5'77.1					
DRILLING AGENCY Corps of Engineers				MANUFACTURER'S DESIGNATION OF DRILL Falline 1500					
HOLE NO. FOR WHICH THIS LOG WAS MADE 816C-12				TOTAL NO. OF CORES 5					
NAME OF DRILLER Schonover				TOTAL NUMBER CORE BOXES 7					
DIRECTION OF HOLE VERTICAL				ELEVATION GROUND WATER 0000					
THICKNESS OF OVERBURDEN 13.7				DATE HOLE STARTED 12 Nov 71					
DEPTH DRILLED INTO ROCK 37.3				TOTAL CORE RECOVERY FOR BORING 96.8%					
TOTAL DEPTH OF HOLE 51.0				SIGNATURE OF INSPECTOR <i>Walter L. Chisum</i>					
ELEVATION	DEPTH	LEGEND	CLASSIFICATION OF MATERIALS (Description)	NO. OF CORE RECOVERY FACETS	REMARKS (Drilling time, water loss, depth of penetration, etc., if significant)				
0.0'	13.7'		SAND - - -	A	1. After completion, hole was bailed to 43.5'. Same level after 24 hours. 2. Jars: A. 0.0 to 4.7 B. 4.7 to 6.2 C. 6.2 to 8.2 D. 8.2 to 10.0 E. 10.0 to 13.7 3. Cartons: 1. 14.2 to 15.1 2. 18.3 to 19.3 3. 23.5 to 24.5 4. 29.0 to 30.0 5. 35.7 to 36.7 6. 42.9 to 43.9 7. 48.3 to 49.1 4. 8" casing set to 14.3'. 5. Drilling methods: 1. 0.0 to 13.7 - 8" auger. 2. 13.7 to 23.3 - 6" carbide 3. 23.3 to 26.4 - 6" diamond 4. 26.4 to 51.0 - 6" carbide.				
0.0	10.0		0.0 to 10.0 - fine to medium grained, trace clay, medium compact, all. moist, red.	B					
10.0	13.7		10.0 to 13.7 - fine to medium grained, trace of fine-grained, well-rounded gravel (-5%), medium compact to dense, all. moist, red.	C					
13.7	13.7		--- Refusal w/auger @ 13.7'	D					
13.7	26.4		13.7' to 26.4' LIMESTONE - - -	E					
13.7	23.3		13.7 to 23.3 - shaley, highly fossilif., m. hard, thick-bedded, unfractured and unjointed, all. stained to 22.0', gray.	L					
23.3	26.4		23.3 to 26.4 - very hard, diamond bit used in this section.	1					
26.4	51.0		26.4' to 51.0' SANDS, non-calc., m. hard, no visible bedding, unjointed and unfractured, occas. siltstone concretions, black.	2					
26.4	35.0			L					
35.0	38.1			3					
38.1	41.2			L					
41.2	44.3			4					
44.3	47.2			L					
47.2	50.3			5					
50.3	51.0			L					
51.0	51.0		T.D. - 51.0'	6					
51.0	51.0			7					

DRILLING LOG		Southwestern		INSTALLATION		Fort Worth		SHEET 2 of 2 SHEETS	
PROJECT Aubrey Dam Site No. 1				NO. SIZE AND TYPE OF BIT 8" auger, 5" carbide, 0					
LOCATION Sta. 134.70 - Centerline				DATE FOR ELEVATION 5'77.1					
DRILLING AGENCY Corps of Engineers				MANUFACTURER'S DESIGNATION OF DRILL Falline 1500					
HOLE NO. FOR WHICH THIS LOG WAS MADE 816C-12				TOTAL NO. OF CORES 5					
NAME OF DRILLER Suits				TOTAL NUMBER CORE BOXES 7					
DIRECTION OF HOLE VERTICAL				ELEVATION GROUND WATER 0000					
THICKNESS OF OVERBURDEN 43.0				DATE HOLE STARTED 12 Nov 71					
DEPTH DRILLED INTO ROCK 52.2				TOTAL CORE RECOVERY FOR BORING 96.8%					
TOTAL DEPTH OF HOLE 95.2				SIGNATURE OF INSPECTOR <i>Walter L. Chisum</i>					
ELEVATION	DEPTH	LEGEND	CLASSIFICATION OF MATERIALS (Description)	NO. OF CORE RECOVERY FACETS	REMARKS (Drilling time, water loss, depth of penetration, etc., if significant)				
0.0'	26.6'		CLAY - - -		1. After completion, hole was bailed to 43.5'. Same level after 24 hours. 2. Jars: A. 0.0 to 4.7 B. 4.7 to 6.2 C. 6.2 to 8.2 D. 8.2 to 10.0 E. 10.0 to 13.7 3. Cartons: 1. 14.2 to 15.1 2. 18.3 to 19.3 3. 23.5 to 24.5 4. 29.0 to 30.0 5. 35.7 to 36.7 6. 42.9 to 43.9 7. 48.3 to 49.1 4. 8" casing set to 14.3'. 5. Drilling methods: 1. 0.0 to 13.7 - 8" auger. 2. 13.7 to 23.3 - 6" carbide 3. 23.3 to 26.4 - 6" diamond 4. 26.4 to 51.0 - 6" carbide.				
0.0	6.6		0.0 to 6.6 - non-calc. moist, stiff to hard scattered rootlets, black.						
6.6	12.6		6.6 to 12.6 - non-calc., moist, all. sandy, hard scattered rootlets, dk. brown.						
12.6	24.6		12.6 to 24.6 - calc., sandy, hard to 22.6', stiff from 22.6 to 24.6, moist, tan.						
24.6	28.6		24.6' to 28.6' SAND, all. clayey, non-calc., moist, medium compact, tan.						
28.6	39.6		28.6' to 39.6' CLAY, sandy, all. calc., moisture increasing with depth, hardness decreasing with depth, saturated from 36.6', tan.						
39.6	43.0		-- Drilled into sandy gravel @ 39.6' with d. bbl. -- -- Start 8" auger @ 39.6' --						
39.6	43.0		39.6' to 43.0' GRAVEL, fine to medium grained, sandy, water-bearing, loose to medium dense.						

1	INSTALLATION	Port Worth
2	SIZE AND TYPE OF BIT	8" SUCR, 6" d.b., 6" ESTEEL
3	DATE	Starting 1900
4	TOTAL LENGTH OF OPEN	1
5	TOTAL NUMBER CORP. BOIES	9
6	DATE	18 Nov 71
7	ELEVATION TOP OF HOLE	552.72
8	TOTAL CORE RECOVERY FOR BONES	88.5%
9	NAME OF INSPECTOR	[Signature]

DEPTH	DESCRIPTION OF MATERIALS	REMARKS
0.0 to 2.6'	1. After completion, hole was bailed to 90.0'. Water level will be set in at later date.	
2.6 to 6.6'	2. Jar: A. 0.0 to 2.6	
6.6 to 12.6'	3. Denison samples: 1. 2.6 to 4.6 2. 4.6 to 6.6 3. 6.6 to 8.6 4. 8.6 to 10.6 5. 10.6 to 12.6	
12.6 to 28.6'	4. Cartons: 1. 4.6 to 47.6 2. 47.6 to 51.8 3. 51.8 to 60.2 4. 60.2 to 65.7 5. 65.7 to 72.5 6. 72.5 to 77.9 7. 77.9 to 85.4 8. 85.4 to 94.4	
28.6 to 39.6'	5. 8" casing set to 45.0'	
39.6 to 43.0'	6. Drilling methods: 1. 0.0 to 2.6 - sugar 2. 2.6 to 39.6 - 6" d.b.	

ELEVATION	DEPTH	LEGEND	CLASSIFICATION OF MATERIALS	REMARKS
45.0'	45.0'	[Symbol]	Augered into primary material 43.0' - Set casing to 45.0', cleaned out, and started 6" core at 45.0'	3. 39.6 to 45.0 - auger 4. 45.0 to 95.2 - 6" carbonyl.
45.0'	45.0' to 93.4'	[Symbol]	SHALE, non-calc. to sil. calc. with depth, m. hard black to gray.	NOTE: Actual core loss from 45.0' to 53.2' was 14.6%. Hole tap for depth at 53.2'. Loss possibly occurred from 50.5 to 52.0, drilling was very rough in this zone. 53.2 to 95.2 - core recovery was 98%
45.0'	45.0 to 57.2	[Symbol]	Thin to medium bedded, with core separating at sand seams listed below.	
57.2'	57.2 to 93.4	[Symbol]	Sandstone, fine-grained, friable, laminated, following depths: 45.0 to 45.3, 45.6 (0.1) 51.3 to 52.3, 53.3 (0.1) 54.2 (0.1), 55.4 (0.1) 55.6 (0.1)	
58.8'	58.8' - 0.05 seam of broken shells.	[Symbol]		
61.2'	61.2 to 61.7 - zone of numerous broken shells.	[Symbol]		*** Marker bed - see 60C-14 at 56.2 to 56.8
62.8'	62.8 to 93.4 - occas. thin, poorly-defined, friable sandstone seam.	[Symbol]		
93.4'	93.4' to 95.2'	[Symbol]	LIMESTONE, shaley, sil. nodular, fossilif., hard gray.	*** Marker bed see 60C-14 at 88.4'
95.2'	95.2' -	[Symbol]		

DESIGNED BY	
REVISION BY	
REVIEWED BY	
SUBMITTED BY	
APPROVED BY	

ELEVATION	DEPTH	LEGEND	CLASSIFICATION OF MATERIALS (Description)	SCORE RECORDED BY	BOX OR SAMPLE NO.	REMARKS (Drilling time, water loss, depth of penetration, etc.)
			-- Augered into primary material @ 43.0' -- Set casing to cleaned out, and started 6" core @ 45.0'			3. 39.6 to 45.0 - surty L. 45.0 to 95.2 - 6" carbology.
	45.0'		45.0' to 93.4'	hsc		
			SHALE, non-calc. to all calc. with depth, m. hard, black to gray.	L c7	1	NOTE: Actual core loss from 45.0' to 53.2' was 12.6%. Hole top for depth at 53.2'. Loss possibly occur from 50.5 to 52.0, drilling was very rough in this zone.
	50.0		45.0 to 57.2 - thin to medium bedded, with core separating at sand seams listed below.	L c5		53.2 to 95.2 - core recovery was 98%
			57.2 to 93.4 - core removed from bb'l. as continuity stalks	53.2 09	2	
			Sandstone, fine-grained, friable, laminated, G following depths:	57.2		
	50.0		45.0 to 45.3, 45.6 (0.1)	01	3	
			51.3 to 52.3, 53.3 (0.1)	02		
			54.2 (0.1), 55.4 (0.1)	09		
			55.6 (0.1)	09		
			@ 58.8' - 0.05 seam of broken shells.	L c12		
			61.2 to 61.7 - zone of numerous broken shells	L c12	4	*** Marker bed - see 60C-14 at 56.2 to 56.8
			From 62.8' to 93.4' - occas. thin, poorly- defined, friable sand seams.	L 11	5	
	70.0			G 04		
				73.2	6	
				L c1		
				77.2		
				G c1	7	
				81.2		
				L 01		
				85.2	8	
				L 02		
				89.2		
				L 03	9	
			93.4' to 95.2'	93.2		*** Marker bed see 60C-14 at 88.4'
			LIMESTONE, shaley, all. nodular, fossilif., hard gray.	93.2		
			T.D. - 95.2' -			

RECIPIENT DRAWING NUMBER A. 1111

SYM	DL NO	ACTION	DATE	DESCRIPTION OF REV'S
U.S. ARMY ENGINEER DISTRICT, FORT WORTH CORPS OF ENGINEERS FORT WORTH, TEXAS				
DESIGNED BY	RAY ROBERTS LAKE			
DRAWN BY	ELM FORK, TRINITY RIVER, TEXAS			
REVIEWED BY	EMBANKMENT, SPILLWAY AND OUTLET WORKS			
	LOGS OF BORINGS 8A6C-12 AND 6 DC-13			
SUBMITTED BY	INVITATION NO. SACW03-820-0025		DATE MAR. 1982	
ENGINEER	CONTRACT NO. SACW03-F4 C 0013		REL. FILE	
	DRAWING NUMBER		13	

TO ACCOMPANY FOUNDATION REPORT

DRILLING LOG		LOCATION		WELL NO.		SHEET	
Southwestern		Fort Worth		60C-14		1 of 3 sheets	
PROJECT: Aubrey Dam Site No. 1				WELL TYPE AND TYPE OF BIT: 8" ALUM., 6" d.b., 6" core			
LOCATION (Coordinates or Name)				WELL IDENTIFICATION NUMBER: 11			
DRILLING AGENCY: Corne of Engineers				WELL IDENTIFICATION NUMBER: 11			
WELL NO. (As shown on existing logs and site number): 60C-14				WELL IDENTIFICATION NUMBER: 11			
NAME OF DRILLER: Suits				WELL IDENTIFICATION NUMBER: 11			
DIRECTION OF HOLE: <input checked="" type="checkbox"/> Vertical <input type="checkbox"/> Inclined				WELL IDENTIFICATION NUMBER: 11			
THICKNESS OF OVERBURDEN: 45.3				WELL IDENTIFICATION NUMBER: 11			
DEPTH DRILLED INTO ROCK: 44.7				WELL IDENTIFICATION NUMBER: 11			
TOTAL DEPTH OF HOLE: 90.0				WELL IDENTIFICATION NUMBER: 11			
ELEVATION		DEPTH		CLASSIFICATION OF MATERIALS (Description)		REMARKS	
				0.0' to 38.6'		CLAY - - -	
				0.0 to 18.6 - calc., moist, hard, scattered rootlets to 8.6', tan.			
				18.6 to 38.6 - calc., sandy, stiff, with hardness decreasing with depth, moist to very moist, tan.			
				NOTE: 26.6 to 28.6 - attempted 3 times to recover sample. No recovery.			
				1. After completion, was bailed to 89.0' casing; was pulled. hour water check -			
				2. Jars: A. 0.0 to 2.6			
				3. Denison cans:			
				1. 2.6 to 4.6			
				2. 4.6 to 6.6			
				3. 6.6 to 8.6			
				4. 8.6 to 10.6			
				5. 10.6 to 12.6			
				6. 12.6 to 14.6			
				7. 14.6 to 16.6			
				8. 16.6 to 18.6			
				9. 18.6 to 20.6			
				10. 20.6 to 22.6			
				11. 22.6 to 24.6			
				12. 24.6 to 26.6			
				13. 26.6 to 28.6			
				14. 28.6 to 30.6			
				15. 30.6 to 32.6			
				16. 32.6 to 34.6			
				17. 34.6 to 36.6			
				4. Penetrator tests on bottom of cans:			
				Cans 1 thru 7 - 4.5			
				8. 2.75			
				9. 1.75			
				10. 2.5			
				11. 2.0			
				12. 1.5			
				13. 1.25			
				14. 1.0			
				15. 2.0			
				16. 1.0			
				17. N.A.			
				5. All core was wrapped in aluminum foil and placed in cartons. Depths shown on p. 2			
				6. 8" casing set to 46.0'.			

ELEVATION	DEPTH	LEGEND	CLASSIFICATION OF MATERIALS (Description)	SCORE
			38.6' to 44.2'	
			S&D and GRAVEL, (recovered only trace in bottom of can 17.), logged by drill action and cutting.	
			--- Drilled into primary material @ 44.2', set casing to 46.0', cleaned out, and started 8" core @ 47.2'	
			47.2' to 88.4'	
			SPALE, all. to non-calc., sandy, hard (pen. # 4.5) thin to medium bedded from 75.1', thick-bedded from 75.1' to 88.4, unjointed and unfractured, unweathered, gray.	
			Sedimentary features:	
			Sandstone beds at the following depths:	
			47.5 to 47.8, 48.0 to 48.2, 48.5 to 48.8, 49.4 to 49.7, 50.7 to 51.1, 51.3 to 51.6, 59.1 to 59.3, 62.8 to 63.1, 64.8 to 65.0, 65.6 to 65.8, 67.4 to 67.6, 70.8 to 70.9, 71.3 to 71.5, 73.0 to 73.1, 74.7 to 74.9, 79.1 to 79.2, 81.2 to 81.4. Most beds were soft and crumbly, crushed with moderate amount of finger pressure.	
			56.2 to 56.8 - highly fossiliferous section, very calc. Possible marker bed - see 60C-15	
			Structural features:	
			None	
			88.4' to 90.0'	
			LIMESTONE, all. shaly, nodular, fossiliferous, hard, gray.	
			T.D. - 90.0'	
			Core was separated at the following depths:	
			47.5, 47.9, 48.3, 49.0, 49.4, 50.7, 51.0, 51.3, 51.4, 51.6, 59.1, 59.3, 60.1, 61.2, 62.0, 62.8, 63.1, 64.8, 65.0, 65.6, 65.8, 67.4, 67.6, 70.8, 70.9, 71.3, 71.5, 73.0, 73.1, 74.7, 74.9, 79.1, 79.2, 81.2, 81.4	
			was removed as continuous talks	

POSITION Southwestern	INSTALLATION Fort Worth	DATE L-46	SHEET 1 OF 2 SHEETS
NO. 1	NO. 1	NO. 1	NO. 1
1. SIZE AND TYPE OF BIT 8" SURF, 6" d.b., 6" carbide core			
2. MANUFACTURER'S DESIGNATION OF DRILL Pulling 1500			
3. TOTAL NO. OF OVER-BURDEN SAMPLES TAKEN 16		4. TOTAL NO. OF STOPPED CORES 16	
5. TOTAL NUMBER CORE BORES 5			
6. ELEVATION GROUND WATER 6000			
7. DATE HOLE STARTED 21 Sept. 71		8. DATE HOLE STOPPED 24 Sept. 71	
9. ELEVATION TOP OF HOLE 588.48			
10. TOTAL CORE RECOVERY FOR BORING 41.0%			
11. SIGNATURE OF INSPECTOR <i>James L. Miller</i>			

CLASSIFICATION OF MATERIAL (Description)	1. CORE RECOVERY %	2. BOR OR SAMPLE NO.	REMARKS (Drilling time, water used, depth of penetration, etc., if significant)
0.0' to 38.7'		A	1. After completion, casing was pulled, and hole was bailed to 55.0'. Water check after 24 hrs. was 24.0'.
CLAY, calc., sil. moist to 6.7', with gradual moisture increase with depth, hard to 8.7' with strength decreasing with depth (Note penetrometer tests in remarks column), brown to tan.		1	2. Jars:
		2	A. 0.0 to 2.7
		3	Jar samples taken from Denison bb'l shoe except where noted by an asterisk.
		4	3. Denison cans.
		5	Depth Penet. test
		6	1. 2.7 - 4.7 4.5
		7	2. 4.7 - 6.7 4.25
		8	3. 6.7 - 8.7 4.5
		9	4. 8.7 - 10.7 4.25
		10	5. 10.7 - 12.7 "
		11	6. 12.7 - 14.7 "
		12	7. 14.7 - 16.7 3.75
		13	8. 16.7 - 18.7 "
		14	9. 18.7 - 20.7 "
		15	10. 20.7 - 22.7 "
		16	11. 22.7 - 24.7 3.0
		17	12. 24.7 - 26.7 "
		18	13. 26.7 - 28.7 "
		19	14. 28.7 - 30.7 2.75
		20	15. 30.7 - 32.7 1.75
		21	16. 32.7 - 34.7 1.75
		22	Note: Can #8 - sample slipped out on initial retrieve and was not covered on second attempt.
		23	Can #15 - poor recovery. Lost 1.0'
		24	4. Cartons:
		25	1. 41.1 to 41.9
		26	2. 47.5 to 48.5
		27	3. 52.2 to 53.2
		28	4. 56.8 to 57.7
		29	5. 58.5 to 59.5
34.7' to 38.7' - no recovery except for a fine to med. grained sand from 38.2' to 38.7' loose, trace clay, gray.		30	5. 8" casing set to 40.0'.
--- Drilled into primary material @ 38.7', set casing to 40.0', cleaned out, and started 6" core @ 40.7' ---		31	6. Drilling methods:
		32	1. 0.0 to 2.7 - 8" auger
		33	2. 2.7 to 40.7 - d. bit.
		34	3. 40.7 to 61.2 - 6" core
40.7' to 61.2'	40.7	40.7	
SPALLS, sil. to non-calc. sandy, hard (pen. 4.5), medium to thin-bedded, unjointed and unfractured (except where noted) unweathered, gray.	45.2	1	Structural features:
	45.2	2	In the upper 10ft., core seems to have a slight dip (approx. 5°).
	49.2	3	0.2' fracture with poorly formed slickensides at 56.2'.
Sedimentary features:			
Sandstone at the following depths:			
42.6 to 43.3 - laminated shaly, sil. fissile, crumbly.	53.2	3	
43.3 to 44.0 - scattered concretions.			
53.2 to 53.4 - laminated shaly, sil. fissile.	57.2	4	
55.0 to 56.1 - laminated shaly, sil. fissile.			
48.5 to 49.1 - highly fossilif. (broken shells), calc. possible marker bed	61.2	5	See 6DC-14, 56.2 to 57.8
T.D. - 61.2'			

RECORD DRAWING - JOHN A. MILLER

SYM	DC	NO.	ACTION	DATE	DESCRIPTION OF REVISION
U.S. ARMY ENGINEER DISTRICT, FORT WORTH CORPS OF ENGINEERS FORT WORTH, TEXAS					
DESIGNED BY	RAY ROBERTS LAKE ELM FORK, TRINITY RIVER, TEXAS EMBANKMENT, SPILLWAY AND OUTLET WORKS LOGS OF BORINGS 6 DC-14 AND 6 DC-15				
DRAWN BY					
REVIEWED BY					
SUBMITTED BY					
INVITATION NO. DACW63-82-E-0025			DATE MAR. 1982		
CONTRACT NO. DACW63-82-C-0083			SEQUENCE NO.		
DRAWING NUMBER			SHEET NO.		14

TO ACCOMPANY FOUNDATION REPORT

Memo No. **6DC-16**

DRILLING LOG		SHEET 1 OF 2	
PROJECT: FLUOR 1, D.M.		DATE: 17 SEPT 71	
LOCATION: FLUOR 1, D.M.		ELEVATION: 559.66	
DRILLING AGENCY: Geoff's of Engineers		HOLE NO. (As shown on drawing) and file number: 6DC-17	
NAME OF DRILLER: Schoodover		DATE HOLE STARTED: 17 SEPT 71	
DIRECTION OF HOLE: <input checked="" type="checkbox"/> VERTICAL <input type="checkbox"/> INCLINED		THICKNESS OF OVERBURDEN: 35.0	
DEPTH DRILLED INTO ROCK: 12.0		TOTAL DEPTH OF HOLE: 50.0	
CLASSIFICATION OF MATERIALS		REMARKS	
0.0' to 3.0' CLAY; SILTY, SAT MOIST; HARD, ROOT ZONE; DARK BROWN 3.0' to 19.6' CLAY; WITH TRACE OF SILT; W/ CALC. NODULES; W/ ORGANIC MATTER; MOIST; HARD; BROWN		I. DRILLING: 8" FLIGHT AUGER 0.0' - 2.6' 6" DENISON 2.6' - 32.6' NOTE: SAMPLES 22- 24.0' - 28.0' AT 30.0' - 32.0' THE SAMPLES WERE TAKEN 8" FLIGHT AUGER 32.6' - 41.0' CLEANED OUT WITH 10" AUGER & SET CASING TO 41.0'. CLEANED OUT WITH 8" AUGER TO 42.0'. 6" CORE BARREL 42.0' - 50.0'.	
19.6' to 29.6' CLAY; SILTY; W/ CALC. NODULES; MOIST; V. STIFF; BROWN TO GRAY BROWN		II. SAMPLES: A: 4.6' B: 6.6' C: 8.6' D: 10.6' E: 12.6' F: 14.6' G: 16.6' H: 18.6' I: 20.6' J: 22.6' K: 24.6' L: 26.6' - 28.6' M: 30.6' - 32.6' N: 32.6' - 37.0' O: 38.0' - 40.5' P: 40.5' - 42.0' Q: 42.0' - 44.0' R: 44.0' - 46.0' S: 46.0' - 48.0' T: 48.0' - 50.0'	
29.6' to 32.0' CLAY; WITH TRACE OF SILT & FINE SAND; MOIST; V. STIFF; BROWN-TAN		III. WATER LEVEL: FLOWING BUILT TO 24.0' W/ K. SEPT. 71 & CHECKED AFTER 24 HOURS. WATER LEVEL AT 24.0'	
32.0' to 37.0' CLAY; SILTY, V. MOIST; V. STIFF DOWN TO STIFF; BROWN-TAN		IV. DEPTH & WIDTH MAT'L. WIDTH TO 38.0'	
37.0' to 39.0' SAND; CLAYEY; W/ SOFT GRAVEL FINE TO MED GRAIN; MOD. FINE		V. MISC POCKET PENETROMETER READINGS ARE IN COLUIN 'E'. ALSO THE SAMPLES WERE TAKEN FROM DENISON SHOE.	
39.0' to 40.5' SANDSTONE - SHADY SHALE; LAMINATE; SORT THIN SS. PLACES ALTERNATING WITH SOFT SANDY SHALE; MOIST; BLUE GRAY		VI. Misc SANDSTONE CONCRETIONS 28.5' - 37.9'	
40.5' to 50.0' SHALE; ESS. UNWEATHERED; W/ SANDY LAMINATIONS; W/ SCAT. S.S. CONCRETIONS; ESS.; SLT. MOIST; SOFT (POCK CLASS) BLUE GRAY		VII. Misc SHALEY SANDSTONE BEDS AT THE FOLLOWING DEPTHS: 27.0 to 27.4 - laminate 36.8 to 37.1 - " " 42.0 to 42.9 - " and all fissile. Zone badly washed by core bit, action.	
T.D. 50.0'		T.D. - 50.0'	

Memo No. **6DC-16**

DRILLING LOG		SHEET 2 OF 2	
PROJECT: Aubrey Dam Site No. 1		DATE: 17 SEPT 71	
LOCATION: Southwestern		ELEVATION: 559.66	
DRILLING AGENCY: Geoff's of Engineers		HOLE NO. (As shown on drawing) and file number: 6DC-17	
NAME OF DRILLER: Schoodover		DATE HOLE STARTED: 17 SEPT 71	
DIRECTION OF HOLE: <input checked="" type="checkbox"/> VERTICAL <input type="checkbox"/> INCLINED		THICKNESS OF OVERBURDEN: 23.5	
DEPTH DRILLED INTO ROCK: 26.5		TOTAL DEPTH OF HOLE: 50.0	
CLASSIFICATION OF MATERIALS		REMARKS	
0.0' to 5.5' SAND, fine-grained, clayey, hard, sil. moist, brown		1. After core bit was pulled, 2/ check	
5.5' to 22.0' CLAY, sandy, non-calc., sil. moist, hard, mottled tan and gray.		2. Jar A. 0.0 to	
22.0' to 23.5' CLAY, calc., w/ scattered gravel and well-rounded siltstone concretions, moist, medium to stiff, tan.		3. Denison 1. 2.7 to 4.0 2. 4.7 to 6.0 3. 6.7 to 8.0 4. 8.7 to 10.7 5. 10.7 to 12.7 6. 12.7 to 14.7 7. 14.7 to 16.7 8. 16.7 to 18.7 9. 18.7 to 20.7 10. 20.7 to 22.7	
26.2' to 50.0' SHALE, sandy, non-calc., hard (penetrometer 4.5), thin-bedded, fossilif., unjointed and unfractured to T.D., unweathered, gray		4. Cartons: 1. 27.4 to 28.5 2. 31.6 to 32.7 3. 38.8 to 40.0 4. 43.8 to 45.0 5. Shale west 24.9'	
27.0 to 27.4 - laminate 36.8 to 37.1 - " " 42.0 to 42.9 - " " and all fissile. Zone badly washed by core bit, action.		6. 8" casing 25.0'	
T.D. - 50.0'		T.D. - 50.0'	

Hole No. 6DC-17

DRILLING LOG		Division	INSTALLATION	SHEET 1 of 2 SHEETS
PROJECT Aubrey Dam Site No. 1		SWD	FWD 129	
LOCATION (Continence or Stream)		PROJECT AUBREY DAM		
DRILLING AGENCY Corps of Engineers		MANUFACTURER'S DESIGNATION OF DRILL PAILING 1500		
HOLE NO. (As shown on drawing sheet and its number)		TOTAL NO. OF OVERBURDEN SAMPLES TAKEN		
6DC-17		1		
NAME OF DRILLER Schoonover		TOTAL NUMBER CORE BOXES		
DIRECTION OF HOLE Vertical		ELEVATION GROUND WATER		
THICKNESS OF OVERBURDEN 23.5		DATE MOLE		
DEPTH DRILLED INTO ROCK 26.5		STARTED 17 Sept. 71		
TOTAL DEPTH OF HOLE 50.0		COMPLETED 20 Sept. 71		
ELEVATION		REMARKS		
DEPTH		(Drilling time, water level, depth of overburden, etc. if significant)		
LEGEND		CLASSIFICATION OF MATERIALS (Description)		
0.0' to 5.5'		SAND, fine-grained, clayey, hard, sil. moist, brown.		
5.5' to 22.0'		CLAY, sandy, non-calc., sil. moist, hard, mottled tan and gray.		
22.0' to 23.5'		CLAY, calc., w/ scattered gravel and well-rounded siltstone concretions, moist, medium to stiff, tan.		
26.2' to 50.0'		SHALE, sandy, non-calc., hard (penetrometer 4.5), thin-bedded, fossilif., unjointed and unfractured to T.D., unweathered, gray.		
Sandstone concretions avg. 0.1' in thickness at the following depths: 28.5', 29.3', 30.3', 31.2', 37.9'.				
Silty sandstone beds at the following depths:				
27.0 to 27.4 - laminated				
36.8 to 37.1 - "				
42.0 to 42.9 - " and sil. fissile. Zone badly washed by core bit. action.				
T.D. - 50.0' -				

Hole No. 6DC-18

DRILLING LOG		Division	INSTALLATION	SHEET 1 of 1 SHEETS
PROJECT Aubrey Dam		SWD	FWD 129	
LOCATION (Continence or Stream)		PROJECT AUBREY DAM		
DRILLING AGENCY USC&A		MANUFACTURER'S DESIGNATION OF DRILL PAILING 1500		
HOLE NO. (As shown on drawing sheet and its number)		TOTAL NO. OF OVERBURDEN SAMPLES TAKEN		
6DC-18		8		
NAME OF DRILLER G. Schuchler		TOTAL NUMBER CORE BOXES		
DIRECTION OF HOLE Vertical		ELEVATION GROUND WATER		
THICKNESS OF OVERBURDEN 18.2		DATE MOLE		
DEPTH DRILLED INTO ROCK 11.8		STARTED 7 SEPT. 71		
TOTAL DEPTH OF HOLE 30.0		COMPLETED 9 SEPT. 71		
ELEVATION		REMARKS		
DEPTH		(Drilling time, water level, depth of overburden, etc. if significant)		
LEGEND		CLASSIFICATION OF MATERIALS (Description)		
0.0' to 1.0'		CLAY: SILTY, W/ TRACE OF FINE SAND, STIFF, SIL. MOIST. ROOT SOIL, DARK BROWN. 1.0' TO 6.6'		
1.0' to 10.0'		CLAY: W/ TRACE OF FINE SAND & SILT, W/ CARBON STAINS, MOIST, V. STIFF DOWN TO HARD. RUST BROWN. 10.0' TO 18.2'		
18.2' to 30.0'		CLAY: SANDY, W/ CARBON STAINS, MOIST, V. STIFF, RUST BROWN. 10.0' TO 18.2'		
18.2' to 30.0'		SAND - GRAVEL: GRADED SAND, W/ FINE TO COARSE GRAVEL, W/ TRACE OF FINE SAND, RUST COL. 18.2' TO 30.0' T.D.		
30.0'		SHALE: MOD. WEATH. DOWN TO RES. UNWEATH. W/ SANDY LAMINATIONS & OCCASIONAL SANDSTONE FRAGS. W/ PURPLE IRONSTONE CONCRETIONS IN UPPER THREE FEET; W/ TIGHT FRACTURES IN WEATH. ZONE; SIL. MOIST, SORT (ROCK CLASS); WEATH. ZONE PREDOM. GRAY BROWN W/ RUST YELLOW UNWEATH. ZONE IS BLISH GRAY. 18.2 - 25.2: MOD. WEATH. 25.2 - 30.2: SIL. WEATH. 27.2 - 27.4: S.S. FLAG 27.4: IRONSTONE CONCRETION T.D. 30.0'		
I. DRILLING:		8" RIGHT AUGER		
II. SAMPLES:		A: 0.0' - 1.0'		
III. WATER LEVEL:		BORING BAILED TO 29.2' ON 21st OF 8 SEPT & LEFT OPEN 24 HOURS; WATER LEVEL AT 15.6'		
IV. DEPTH OF WEATH.:		MOD. WEATH. TO 28.2'		
V. MISC.		POCKET PENETROMETER READINGS IN COLUMN 'P' AND JAR SAMPLES WERE TAKEN FROM DENISON SHOES.		

Hole No. **6DC-16**

DIVISION SND	INSTALLATION FND	SHEET 1 OF 2 SHEETS
PROJECT DAM	NO. SIZE AND TYPE OF BIT 6" CAPACORV	DATE 7 SEPT 71
MANUFACTURER'S DESIGNATION OF DRILL MSI	TOTAL NO. OF OVERSAMPLER SAMPLES TAKEN 8	TOTAL NUMBER CORE BOXES 2
DATE MOLE 7 SEPT 71	ELEVATION GROUND WATER 595.11	ELEVATION TOP OF MOLE 595.11
DEPTH MOLE 18.2'	TOTAL CORE RECOVERY FOR BORING 95	SIGNATURE OF INSPECTOR J. R. [Signature]
ROCK 11.8'		
T.D. 30.0'		

CLASSIFICATION OF MATERIALS (Description)	CORE NO.	BOX OR SECTION NO.	REMARKS (Including time, hole loss, depth of penetration, etc., if significant)
0.0' to 1.0'	1.0	A	I. DRILLING: 8" RIGHT ANGLE; 0.0' - 1.0' 1.0' - 1.6' 1.6' - 1.6' C 8" RIGHT ANGLE; 1.6' - 30.0' CLEANED OUT WITH 10" ANGLE & SET CASING TO 30.0'; CLEANED OUT CASING TO 21.2' 6" CORE BARREL; 21.2' - 30.0'
1.0' to 6.6'	6.6	B	
6.6' to 10.0'	10.0	C	
10.0' to 12.6'	12.6	D	
12.6' to 14.6'	14.6	E	
14.6' to 18.2'	18.2	F	
18.2' to 20.0'	20.0	G	
20.0' to 21.2'	21.2	H	
21.2' to 22.0'	22.0	I	
22.0' to 23.2'	23.2	J	
23.2' to 24.0'	24.0	K	
24.0' to 25.2'	25.2	L	
25.2' to 26.2'	26.2	M	
26.2' to 27.2'	27.2	N	
27.2' to 28.2'	28.2	O	
28.2' to 29.2'	29.2	P	
29.2' to 30.0'	30.0	Q	

II. SAMPLES:
A: 0.0' - 1.0'
B: 1.6' - 1.6'
C: 1.6' - 1.6'
D: 1.6' - 1.6'
E: 1.6' - 1.6'
F: 1.6' - 1.6'
G: 1.6' - 1.6'
H: 1.6' - 1.6'
I: 1.6' - 1.6'
J: 1.6' - 1.6'
K: 1.6' - 1.6'
L: 1.6' - 1.6'
M: 1.6' - 1.6'
N: 1.6' - 1.6'
O: 1.6' - 1.6'
P: 1.6' - 1.6'
Q: 1.6' - 1.6'

III. WATER LEVEL:
BORING BORED TO
29.2' ON 21.0" B.S.P.
& LEFT OPEN 24 HOURS;
WATER LEVEL AT 15.6'

IV. DEPTH OF WEATH:
MAX. WEATH TO
20.2'

V. MISS:
POCKET DEVIATION
READINGS IN COLUMN 'B'
AND THE SAMPLES
WAS TAKEN FROM
DEVIATION STOP.

NOTES: CORRECTION FROM 76" TO 10.6"
REVISION SAMPLE
DISTURBED FROM
12.6" - 14.6" TOOK
FOR SAMPLE
C - L: 22.4' - 23.4'
2: 26.2' - 27.2'

Hole No. **6DC-16**

DIVISION SND	INSTALLATION FND	SHEET 1 OF 2 SHEETS
PROJECT DAM	NO. SIZE AND TYPE OF BIT 6" CAPACORV	DATE 7 SEPT 71
MANUFACTURER'S DESIGNATION OF DRILL MSI	TOTAL NO. OF OVERSAMPLER SAMPLES TAKEN 8	TOTAL NUMBER CORE BOXES 2
DATE MOLE 7 SEPT 71	ELEVATION GROUND WATER 595.11	ELEVATION TOP OF MOLE 595.11
DEPTH MOLE 18.2'	TOTAL CORE RECOVERY FOR BORING 95	SIGNATURE OF INSPECTOR J. R. [Signature]
ROCK 11.8'		
T.D. 30.0'		

CLASSIFICATION OF MATERIALS (Description)	CORE NO.	BOX OR SECTION NO.	REMARKS (Including time, hole loss, depth of penetration, etc., if significant)
0.0' to 15.0'	1.0	A	I. DRILLING: 8" RIGHT ANGLE; 0.0' - 1.0' 1.0' - 1.6' 1.6' - 1.6' C 8" RIGHT ANGLE; 1.6' - 30.0' CLEANED OUT WITH 10" ANGLE & SET CASING TO 30.0'; CLEANED OUT CASING TO 21.2' 6" CORE BARREL; 21.2' - 30.0'
15.0' to 22.0'	22.0	B	
22.0' to 43.0'	43.0	C	
43.0' to 45.2'	45.2	D	
45.2' to 47.6'	47.6	E	
47.6' to 50.0'	50.0	F	
50.0' to 52.4'	52.4	G	
52.4' to 54.8'	54.8	H	
54.8' to 57.2'	57.2	I	
57.2' to 59.6'	59.6	J	
59.6' to 62.0'	62.0	K	
62.0' to 64.4'	64.4	L	
64.4' to 66.8'	66.8	M	
66.8' to 69.2'	69.2	N	
69.2' to 71.6'	71.6	O	
71.6' to 74.0'	74.0	P	
74.0' to 76.4'	76.4	Q	
76.4' to 78.8'	78.8	R	
78.8' to 81.2'	81.2	S	
81.2' to 83.6'	83.6	T	
83.6' to 86.0'	86.0	U	
86.0' to 88.4'	88.4	V	
88.4' to 90.8'	90.8	W	
90.8' to 93.2'	93.2	X	
93.2' to 95.6'	95.6	Y	
95.6' to 98.0'	98.0	Z	

II. SAMPLES:
A: 0.0' - 1.0'
B: 1.6' - 1.6'
C: 1.6' - 1.6'
D: 1.6' - 1.6'
E: 1.6' - 1.6'
F: 1.6' - 1.6'
G: 1.6' - 1.6'
H: 1.6' - 1.6'
I: 1.6' - 1.6'
J: 1.6' - 1.6'
K: 1.6' - 1.6'
L: 1.6' - 1.6'
M: 1.6' - 1.6'
N: 1.6' - 1.6'
O: 1.6' - 1.6'
P: 1.6' - 1.6'
Q: 1.6' - 1.6'
R: 1.6' - 1.6'
S: 1.6' - 1.6'
T: 1.6' - 1.6'
U: 1.6' - 1.6'
V: 1.6' - 1.6'
W: 1.6' - 1.6'
X: 1.6' - 1.6'
Y: 1.6' - 1.6'
Z: 1.6' - 1.6'

III. WATER LEVEL:
BORING BORED TO
29.2' ON 21.0" B.S.P.
& LEFT OPEN 24 HOURS;
WATER LEVEL AT 15.6'

IV. DEPTH OF WEATH:
MAX. WEATH TO
20.2'

V. MISS:
POCKET DEVIATION
READINGS IN COLUMN 'B'
AND THE SAMPLES
WAS TAKEN FROM
DEVIATION STOP.

NOTES: CORRECTION FROM 76" TO 10.6"
REVISION SAMPLE
DISTURBED FROM
12.6" - 14.6" TOOK
FOR SAMPLE
C - L: 22.4' - 23.4'
2: 26.2' - 27.2'

RECORD DRAWING-WORK AS BUILT

SYMBOL NO.	ACTION	DATE	DESCRIPTION OF REVISION
U.S. ARMY ENGINEER DISTRICT, FORT WORTH CORPS OF ENGINEERS FORT WORTH, TEXAS			
DESIGNED BY	RAY ROBERTS LAKE ELM FORK, TRINITY RIVER, TEXAS EMBANKMENT, SPILLWAY AND OUTLET WORKS LOGS OF BORINGS 6 DC-16, 6DC-17, 6 DC-18, AND 6A4C-19		
DRAWN BY			
REVIEWED BY			
SUBMITTED BY			
ENGINEER	INVITATION NO. DACW63-82-B-0025	DATE	MAR 1982
	CONTRACT NO. DACW63-82-C-0012		
	DRAWING NUMBER	SHEET NO.	15

TO ACCOMPANY FOUNDATION REPORT

Drilling Log		Installation	
Southwestern		Fort Worth	
Aubrey Dam Site No. 1		Shelby & 4" Core	
Not Shown Y 2117, R22 Y 613, 407		MSL	
Corps of Engineers		DAMCO Model 1250	
354C-21A		7 17	
Bill Stanton Trinity Engineering Testing Corporation		See Note 2	
5 May 72		12-6-72 12-13-72	
30.6		579.74	
69.4		93.2	
100.0		See Note 1 under "Remarks"	

DEPTH	LEGEND	CLASSIFICATION OF MATERIALS	REMARKS
0.0' to 23.7'	A	CLAY, non-calc., sandy, moist, stiff, tan to gray.	1. After completion, hole was bailed to 46.0' and 3" I.D. perforated plastic pipe was placed to T.D.
23.7' to 28.2'	B	SAND, clayey, moist, m. dense, tan and gray.	2. Jars: A. 0.0 to 1.0 B. 2.0 to 3.0 C. 5.0 to 6.0 D. 10.0 to 11.0 E. 15.0 to 16.0 F. 20.0 to 21.0 G. 25.0 to 26.0 H. 29.0 to 30.2 Jar samples were selected from continuous shaly tub samples through overburden.
28.2' to 29.2'	C	GRAVEL, sandy, max. size 3/4", well-rounded, moist, tan.	3. Cartons: 1. 36.2 to 37.2 2. 42.1 to 43.1 3. 45.2 to 46.2 4. 50.0 to 50.9 4. Primary material was not weathered.
29.2' to 31.7'	D	Drilled into unweathered primary material @ 29.2'	
31.7' to 52.2'	E	SHALE, sil. calc., unves. n. hard, thick-bedded, sil. sandy, some jointed zones below 42.1', gray	
40.6' to 42.1'	F	SANDSTONE soft, with SHALE laminae, tan.	
T.D. - 52.2'	G		

ELEVATION	DEPTH	LEGEND	CLASSIFICATION OF MATERIALS	% CORE RECOVERY	BOX OR SAMPLE NO.	REMARKS
577.74	2	Brown Clay		100	W1	3" Shelby Tube
	2			100	W2	Samples 0.0'-28.0'
	4	Reddish Brown Sandy Clay		100	W3	JAR SAMPLES
573.74	6			100	W4	1. 2.0'-3.0'
	8	Tan Silty Clay w/Sand Lenses		100	W5	2. 6.0'-7.0'
	10			100	W6	3. 10.0'-11.0'
	12			100	W7	4. 14.0'-15.0'
	14			100	W8	5. 18.0'-19.0'
	16			100	W9	6. 22.0'-23.0'
	18			100	W10	7. 26.0'-27.0'
561.74	18	18.0'		100	W10	8. 30.0'-31.0'
	20	Tan Sandy Clay		100	W11	WRAP SAMPLES
558.74	21	21.0'		100	W12	1. 0.0'-1.0'
557.74	22	22.5' Tan Clayey Sand		100	W13	2. 1.0'-2.0'
	24	Tan Clay w/Sand Lenses		100	W14	3. 3.0'-4.5'
554.94	24	24.8'		100	W15	4. 4.5'-6.0'
553.24	26	26.5' Tan Clayey Sand		100	W16	5. 7.0'-8.5'
	28	Tan Silty Sand and Gravel		100	W17	6. 8.5'-10.0'
549.14	30	30.6'		100	W18	7. 11.0'-12.5'
	32	30.6'-50.0'	SHALE, Soft-Mod. Hard, Unweath., Gray-Dark Gray, Thin-Bedded to Massive, Non-Jointed, Often Sandy, w/Numerous Sand Pockets and Lenses.	R-1	Box 1	8. 12.5'-14.0'
	34		M. -Hard, Gry., Lam. W. 45.0'-45.3', Limestone, Gray, Hard, Fossiliferous, Oolitic.	R-2	Box 2	9. 15.0'-16.5'
	36		Sand Pockets and Lenses, Gray, Med. -Fine-Grained, Friable, Soft-Mod. Hard	R-3	Box 2	10. 16.5'-18.0'
	38		at: 31.5-31.7, 31.9-32.1, 32.4-32.6, 40.0-40.5, 40.9-41.0, 41.7-42.1, 42.4-42.5, 43.8-44.2, 44.6-45.0, 46.3-46.5, 46.8-47.0, 48.0'-50.0'; Sandstone, Mod. Hard, Well-Cemented, Gray.	R-3	Box 2	11. 19.0'-20.0'
	40		50.0'-80.0'	R-3	Box 2	12. 20.0'-21.0'
	42		SHALE, Moderately Hard, Unweathered, Dark Gray to Black, Laminated, Non-Jointed, w/Numerous Sand Pockets and Lenses.	R-3	Box 2	13. 21.0'-22.0'
	44		53.5'-55.0', Sandstone, Hard, Fine-Med. -Grained, Well-Cemented, Gray.	R-3	Box 2	14. 23.0'-24.0'
	46		Sand Pockets and Lenses, Gray, Med. -Fine-Grained, Friable, Soft-Med. Hard, at 55.0-55.9, 56.1-56.2, 56.9-57.4, 58.1-58.5, 67.2-71.3.	R-3	Box 2	15. 24.0'-25.0'
	48		64.4'-65.0', Fossiliferous Zone, Hard, Calcareous.	R-3	Box 2	16. 25.0'-26.0'
	50		79.3'-79.5', Sandstone, Mod. Hard, Gray, Fine-Med. -Grained, Well-Cemented	R-3	Box 2	17. 27.0'-28.0'
529.74	50		80.0'-96.3'	R-3	Box 2	18. 28.0'-29.0'
	52		SHALE, Mod. Hard-Hard, Unweath., Very Dark Gray to Black, Massive, Non-Jointed.	R-3	Box 2	19. 29.0'-30.0'
	54		82.1', Numerous Siltstone Nodules, Tan, Very Hard.	R-3	Box 2	20. 30.0'-31.0'
	56			R-3	Box 2	21. 31.0'-32.0'
	58			R-3	Box 2	22. 32.0'-33.0'
	60			R-3	Box 2	23. 33.0'-34.0'
	62			R-3	Box 2	24. 34.0'-35.0'
	64			R-3	Box 2	25. 35.0'-36.0'
	66			R-3	Box 2	26. 36.0'-37.0'
	68			R-3	Box 2	27. 37.0'-38.0'
	70			R-3	Box 2	28. 38.0'-39.0'
	72			R-3	Box 2	29. 39.0'-40.0'
	74			R-3	Box 2	30. 40.0'-41.0'
	76			R-3	Box 2	31. 41.0'-42.0'
	78			R-3	Box 2	32. 42.0'-43.0'
499.74	80			R-3	Box 2	33. 43.0'-44.0'
	82			R-3	Box 2	34. 44.0'-45.0'
	84			R-3	Box 2	35. 45.0'-46.0'
	86			R-3	Box 2	36. 46.0'-47.0'
	88			R-3	Box 2	37. 47.0'-48.0'
	90			R-3	Box 2	38. 48.0'-49.0'
	92			R-3	Box 2	39. 49.0'-50.0'
	94			R-3	Box 2	40. 50.0'-51.0'
	96			R-3	Box 2	41. 51.0'-52.0'
	98			R-3	Box 2	42. 52.0'-53.0'
	100			R-3	Box 2	43. 53.0'-54.0'

Division Southwestern	INSTALLATION Fort Worth	SHEET 03 OF 3 SHEETS
No. 1 of 12,824 Y: 613,500		
No. 1 of 12,824 Y: 613,500		
3S4C-21A Bill Stanton Log Testing Corporation		
MED. DES. FROM VERT.		
ORDEN 30.6		
ROCK 69.4		
E 100.0		
CLASSIFICATION OF MATERIALS (Designated)		
REMARKS (Drilling time, water loss, depth of weathering, etc., of significance)		

CLASSIFICATION OF MATERIALS (Designated)	% CORE RECOVERED	BOX OR SAMPLE NO.	REMARKS (Drilling time, water loss, depth of weathering, etc., of significance)
Brown Clay	100	W1	3" Shelby Tube
2.0'	100	W2	Samples 0.0'-28.0'
Reddish Brown Sandy Clay	100	W3	JAR SAMPLES
6.0'	100	W4	1. 2.0'-3.0'
Tan Silty Clay w/Sand Lenses	100	W5	2. 6.0'-7.0'
	100	W6	3. 10.0'-11.0'
	100	W7	4. 14.0'-15.0'
	100	W8	5. 18.0'-19.0'
	100	W9	6. 22.0'-23.0'
	100	W10	7. 26.0'-27.0'
	100	W11	8. 30.0'-31.0'
	100	W12	WRAP SAMPLES
	100	W13	1. 0.0'-1.0'
	100	W14	2. 1.0'-2.0'
	100	W15	3. 3.0'-4.5'
	100	W16	4. 4.5'-6.0'
	100	W17	5. 7.0'-8.5'
	100	W18	6. 8.5'-10.0'
	100	W19	7. 11.0'-12.5'
	100	W20	8. 12.5'-14.0'
	100	W21	9. 15.0'-16.5'
	100	W22	10. 16.5'-18.0'
	100	W23	11. 19.0'-20.0'
	100	W24	12. 20.0'-21.0'
	100	W25	13. 21.0'-22.0'
	100	W26	14. 23.0'-24.0'
	100	W27	15. 24.0'-25.0'
	100	W28	16. 25.0'-26.0'
	100	W29	17. 27.0'-28.0'
	90%	Box 1	Moist at 18.0'-22.5'
	35.0	R-1	Wet at 22.5'-30.6'
	90%	Box 2	Set Tub at 28.0' and Cleaned Hole to 30.0'
	40.0	R-2	3" Shelby Tube Sample 30.0'-31.0'
	90%	Box 2	(Continued) Began Coring w/4" bbl. at 31.0'
	45.0	R-3	CARTON SAMPLES
	90%	Box 3	1. 33.6'-34.5'
	50.0	R-4	2. 36.7'-37.7'
	86%	Box 4	3. 40.9'-41.8'
	55.0	R-5	4. 45.6'-46.5'
	84%	Box 5	5. 49.1'-49.7'
	60.0	R-6	6. 50.7'-51.5'
	100%	Box 6	7. 57.3'-57.8'
	65.0	R-7	8. 61.2'-61.7'
	75.0	R-8	9. 67.8'-68.7'
	89.0	Box 7	10. 70.0'-70.9'
	85.0	R-9	11. 77.0'-77.9'
	90.0	Box 8	12. 83.6'-84.5'
	90.0	R-10	13. 85.0'-85.9'
	90.0	Box 9	14. 90.0'-90.9'
	90.0	R-11	15. 93.4'-94.3'
	90.0	Box 10	16. 98.0'-98.9'
	90.0	R-12	BOXES
	90.0	Box 11	1. 31.0'-36.7'
	90.0	Box 12	2. 36.7'-43.5'
	90.0	Box 13	3. 43.5'-49.1'
	90.0	Box 14	4. 49.1'-56.6'
	90.0	Box 15	5. 56.6'-64.4'
	90.0	Box 16	6. 64.4'-71.3'
	90.0	Box 17	7. 71.3'-77.9'
	90.0	Box 18	8. 77.9'-82.8'
	90.0	Box 19	9. 82.8'-90.9'
	90.0	Box 20	10. 90.9'-96.3'
	90.0	Box 21	11. 96.3'-100.0'

ELEVATION	DEPTH	LOGGED	CLASSIFICATION OF MATERIALS (Designated)	% CORE RECOVERED	BOX OR SAMPLE NO.	REMARKS (Drilling time, water loss, depth of weathering, etc., of significance)
483.44	94			93.0	R-14	Box 10
	96		96.3'-100.0'	92.5		
	98		LIMESTONE, Gray, Hard, Unweathered	97.0	R-15	Box 11
479.74	100		Total Depth = 100.0'	100.0		

Note 1:
Soils Logged By:
A. J. Simpson,
Trinity Engineering
Testing Corporation;
Primary Logged By:
Marr and Marple,
Corps of Engineers,
Fort Worth District
Note 2:
Installed 2" Plastic
Pipe from 581.34
to _____ for ground
water observations.

RECORD DRAWING-WORK AS BUILT

SYM	DO NO	ACTION	DATE	DESCRIPTION OF REVISION
U.S. ARMY ENGINEER DISTRICT, FORT WORTH CORPS OF ENGINEERS FORT WORTH, TEXAS				
DESIGNED BY:	RAY ROBERTS LAKE			
DRAWN BY:	ELM FORK, TRINITY RIVER, TEXAS			
REVIEWED BY:	EMBANKMENT, SPILLWAY AND			
	OUTLET WORKS			
	LOGS OF BORINGS			
	6A4C-20, 6A4C-21, AND 3S4C-21A			
SUBMITTED BY:	INVITATION NO. DACW63-82-B-0025		DATE: MAR, 1982	
ENGINEER:	CONTRACT NO. DACW63-92-C-0083		SEQUENCE NO. 16	
	DRAWING NUMBER		SHEET NO. OF	

CONTRACT NO. DACW63-92-C-0083

Hole No. **BA6C-22**

DRILLING LOG		Division	Installation	SHEET 1
Southwestern		Southwestern	Port Worth	of 2 SHEETS
PROJECT: Aubrey Dam Site		HOLE NO. AND TYPE OF BIT: 6" AUBREY 6" CARBOLITE 6" diamond		
LOCATION: Intake structure		HOLE NO. AND TYPE OF BIT: 6" AUBREY 6" CARBOLITE 6" diamond		
DRILLING AGENCY: Corps of Engineers		INSTALLATION: Pulling 1500		
HOLE NO. (As shown on drawing sheet and log number): BA6C-22		TOTAL NO. OF CORES: 8		
NAME OF DRILLER: Schoonover		ELEVATION GROUND WATER: 28.5 17/21/72		
DIRECTION OF HOLE: <input checked="" type="checkbox"/> Vertical <input type="checkbox"/> Inclined		DATE MADE: 4 May 72		
THICKNESS OF OVERBURDEN: 8.0		ELEVATION TOP OF HOLE: 593.5		
DEPTH DRILLED INTO ROCK: 40.5		TOTAL CORE RECOVERY FOR BORING: 96.5		
TOTAL DEPTH OF HOLE: 48.5		SIGNATURE OF INSPECTOR: <i>Raymond E. ...</i>		

ELEVATION	DEPTH	LEGEND	CLASSIFICATION OF MATERIALS (Description)	REMARKS (Including core number, depth of weathering, etc., if significant)
0.0'	2.6'	A	SAND, sli. clayey, fine to med. grained, sli. moist brown.	1. After completion, bore was bailed to 45.0' and 2 1/2" I.D. perforated pipe was placed in hole.
2.6'	8.0'	B	CLAY, sandy, moist, medium red to tan.	2. Jars:
8.0'	10.0'	C	CLAY-SHALE, calc., moist, stiff, tan.	A. 0.0 to 2.6 B. 2.6 to 6.5 C. 6.5 to 8.0 D. 8.0 to 9.0 E. 9.0 to 10.0
10.0'	10.0'	D	-- Start 6" core @ 10.0'	
10.0'	19.0'	E	CLAY-SHALE, calc., highly jointed, m. hard, numerous rootlets, open, highly-stained joint from 14.1 to 15.3, tan and gray.	3. Carbons:
19.0'	19.0'	L	-- Transitional weathering contact @ 19.0'	1. 10.0 to 11.0 2. 17.2 to 18.2 3. 22.6 to 23.6 4. 27.7 to 28.7 5. 38.4 to 39.4 6. 45.2 to 46.2
19.0'	36.9'	L	SHALE, calc., jointed and stained to 22.6', thick bedded, fossilif., gray	4. Weathered to 19.0'
36.9'	36.9'	L	-- Start 4" core @ 20.0'	5. Base of jointing at 22.6'
36.9'	30.9'	G	SHALE, soft - moderately hard, moist, interbedded with scattered, thin sandstone seams.	
30.9'	30.9'	G	20.0' - 2500' - weathered, oxide stains, yellow-brown & gray.	
30.9'	36.9'	G	26.6' - 24.8' - SANDSTONE, fine, argillaceous, moderately cemented.	
36.9'	43.6'	G	25.0 - 33.3' - Predom dark gray with oxide staining limited to bedding planes.	
43.6'	43.6'	L	36.9' to 42.1' - m. hard fossilif., shaly, gray	
43.6'	47.2'	L	42.1' to 43.6' - sandy, fossilif., shaly, HARD gray.	
47.2'	47.2'	L	43.6' to 47.2' SHALE, calc., m. hard, scattered LIMESTONE concretions, gray.	
47.2'	48.5'	L	43.6' to 43.8' SILTSTONE, m. hard, tan.	
48.5'	48.5'	L	47.2' to 48.5' NO RECOVERY	
48.5'	48.5'	L	2.D. 48.5' -	

Hole No. **BA6C-23**

DRILLING LOG		Division	Installation	SHEET 1
Southwestern		Southwestern	Port Worth District	of 2 SHEETS
PROJECT: Aubrey Dam		HOLE NO. AND TYPE OF BIT: 6" AUBREY 6" CARBOLITE 6" diamond		
LOCATION: Sta 78400, West Abutment C L		HOLE NO. AND TYPE OF BIT: 6" AUBREY 6" CARBOLITE 6" diamond		
DRILLING AGENCY: USACE-C		INSTALLATION: Pulling 350		
HOLE NO. (As shown on drawing sheet and log number): BA6C-23		TOTAL NO. OF CORES: 8		
NAME OF DRILLER: Jay Creman		ELEVATION GROUND WATER: 28.5 17/21/72		
DIRECTION OF HOLE: <input checked="" type="checkbox"/> Vertical <input type="checkbox"/> Inclined		DATE MADE: 9 May 72		
THICKNESS OF OVERBURDEN: 19.0'		ELEVATION TOP OF HOLE: 593.5		
DEPTH DRILLED INTO ROCK: 51.0'		TOTAL CORE RECOVERY FOR BORING: 96.5		
TOTAL DEPTH OF HOLE: 70.6		SIGNATURE OF INSPECTOR: <i>Raymond E. ...</i>		

ELEVATION	DEPTH	LEGEND	CLASSIFICATION OF MATERIALS (Description)	REMARKS (Including core number, depth of weathering, etc., if significant)
0.0'	17.6'	A	CLAY-lean, sandy-fine; silty; dry.	
0.6'	0.6'	B	@ 0.6 - becomes moist.	
1.7'	1.7'	C	@ 1.7' - becomes stiff, well consolidated, fat	
5.3'	5.3'	C	@ 5.3' - becomes gravelly limestone, hard, max size 1"; lean, with color change. Yellowish brown.	
13.6'	13.6'	D	@ 13.6' - becomes very lean with more sand fines	
17.6'	17.6'	F	17.6 to 19.0' - angular limestone, size 1-1/2"; sand coarse; silty; moist; brown, gray, & yellowish-brown	
19.0'	19.0'	G	-- Start 4" core at 20.0'	
20.0'	20.0'	L	20.0' to 69.2'	
20.0'	20.0'	L	SHALE, soft - moderately hard, moist, interbedded with scattered, thin sandstone seams.	
20.0'	2500'	L	20.0' - 2500' - weathered, oxide stains, yellow-brown & gray.	
24.8'	24.8'	L	26.6' - 24.8' - SANDSTONE, fine, argillaceous, moderately cemented.	
25.0'	25.0'	L	25.0 - 33.3' - Predom dark gray with oxide staining limited to bedding planes.	
29.6'	29.6'	L	36.9' to 42.1' - m. hard fossilif., shaly, gray	
32.8'	32.8'	L	42.1' to 43.6' - sandy, fossilif., shaly, HARD gray.	
43.6'	43.6'	L	43.6' to 47.2' SHALE, calc., m. hard, scattered LIMESTONE concretions, gray.	
43.8'	43.8'	L	43.6' to 43.8' SILTSTONE, m. hard, tan.	
48.5'	48.5'	L	47.2' to 48.5' NO RECOVERY	

Well No. 844C-25

Western	INSTALLATION Fort Worth District	SHEET 1 of 2 SHEETS
C.L.	10. SIZE AND TYPE OF BIT 4" Core Barrel	
84C-25	11. DATE OF ELEVATION MEASUREMENT	
	12. MANUFACTURER'S DESIGNATION OF GILL Falling 350	
	13. TOTAL NO. OF CORES UNDISTURBED 7 DISTURBED 8	
	14. TOTAL NUMBER CORE BOARDS 8	
	15. ELEVATION GROUND WATER	
	16. DATE MOLE STARTED 25 May 72 COMPLETED 26 May 72	
	17. ELEVATION TOP OF MOLE 600.66	
	18. TOTAL CORE RECOVERY FOR BORING	
	19. SIGNATURE OF INSPECTOR Raymond E. Hagen	

DESCRIPTION OF MATERIALS (Descriptive)	1. CORE RECOVERY %	2. BOX OR SAMPLE NO.	REMARKS (Drilling time, water loss, depth of casing, etc. if significant)
17.6'		A	JAR SAMPLES
lean, sandy-fine; dry.		B	A - 0.02' to 1.0' B - 3.0' to 4.0' C - 6.0' to 7.0' D - 9.0' to 10.0' E - 12.0' to 13.0' F - 15.0' to 16.0' G - 18.0' to 19.5'
becomes moist, consolidated, fat tone, hard, max 1"; lean, with change.		C	CARTON SAMPLES
ish brown.		D	1 - 22.3' to 23.3' 2 - 29.4' to 30.4' 3 - 34.0' to 35.0' 4 - 36.4' to 37.4' 5 - 46.9' to 47.9' 6 - 49.0' to 49.8' 7 - 52.0' to 53.0' 8 - 58.8' to 59.8'
- becomes very sh more sand fines		E	
		F	PENTROMETER BLOWS
18.3'		G	13.6' to 14.1' - 43 14.1' to 15.1' - 72
hard, rounded & limestone; max 1/2"; sandy-fine to silty; mottled-gray, & yellowish-			Sec casing to 20.0' and started coring at that depth.
" core at 20.0'----	L-0.5		
69.2'	L-0.2	1	
silt - moderately silty, interbedded, stored, thin seams.	L-0.4		
	L-0.5		
100' - red, oxide stains, brown & gray.	L-0		
4.8' - SANDSTONE, argillaceous, silty cemented.	L-0.4	2	
" - Predom silty with containing limited bedding planes.	L-0.5	3	
6' - Fossiliferous	L-0.6	4	
8' - Sandstone			
1.2' - Sandstone			
	L-0.8		

ELEVATION	DEPTH	LEADER	CLASSIFICATION OF MATERIALS (Descriptive)	1. CORE RECOVERY %	2. BOX OR SAMPLE NO.	REMARKS (Drilling time, water loss, depth of casing, etc. if significant)
	40		33.3'-69.2' Unweathered, dark gray, moderately hard.	41.5		
	50		36.5'-36.8' - SANDSTONE, moderately hard, moderately cemented, very silty, thinly bedded, light gray-tan.	46.5		
	60		37.3'-37.6' - Fossiliferous	55.5		
	70		46.7-47.4' - SANDSTONE			
			47.9-48.4' - "			
			50.4-50.6' - "			
			53.5-54.2' - "			
			54.6-54.9' - "			
			55.3-55.4' - "			
			56.4-56.5' - "			
			57.8-58.1' - "			
			58.2-58.7' - "			
			61.4-61.6' - "			
			62.9-64.4' - Fossiliferous			
			64.4-64.9' - Fossiliferous			
			66.6-66.9' - SANDSTONE			
			67.0-67.6' - "			
			67.6-68.0' - "			
			68.5-68.7' - "			
			7.0 72.0'			

Unable to obtain
Carton samples
for last 10' of hole
due to fragmentation
of core

SYM	DD	NO
DESIGNED BY		
DRAWN BY		
REVIEWED BY		
SUBMITTED BY		
ENGINEER		

ELEVATION	DEPTH	LEGEND	CLASSIFICATION OF MATERIALS (Description)	% CORE RECOVERY	BOX OR SAMPLE NO.	REMARKS (Distinguishing marks, depth of penetration, etc., if significant)
	40		33.3'-69.2' Unweathered, dark gray, moderately hard.	41.5		
				L-1.0		
			36.5'-36.8' - SANDSTONE, moderately hard, mod- erately cemented, very fine, thinly bedded, light gray-tan.	46.5		
			37.3-37.6' - Fossiliferous	55.5	5	
			46.7-47.6' - SANDSTONE			
			47.9-48.4' - "		6	
			50.4-50.6' - "			
	50		53.5-54.2' - "	50.5		
			54.6-54.9' - "			
			55.3-55.4' - "	L-0.9		
			56.4-56.5' - "		7	
			57.8-58.1' - "			
			58.2-58.7' - "			
			61.4-61.6' - "			
			62.9-64.4' - "	55.5		
			64.4-64.9' - Fossiliferous			
			66.6-66.9' - SANDSTONE	L-0.7		
			67.0-67.6' - "			
			67.6-68.0' - "			
			68.5-68.7' - "		8	
	60			62.5		
				L-0.2		
				65.5		
				60.8		
	70		7.0 70.0'	70.0		

Unable to obtain
Carbon samples
for last 10' of hole
due to fragmentation
of core

DWG FORM 1036 PREVIOUS EDITIONS ARE OBSOLETE. PROJECT: Aubrey Dam. SHEET NO: 846C-25

RECORD DRAWING-WORK AS BUILT

ITEM	NO.	ACTION	DATE	DESCRIPTION OF REVISION
U.S. ARMY ENGINEER DISTRICT, FORT WORTH CORPS OF ENGINEERS FORT WORTH, TEXAS				
DESIGNED BY:	RAY ROBERTS LAKE ELM FORK, TRINITY RIVER, TEXAS EMBANKMENT, SPILLWAY AND OUTLET WORKS LOGS OF BORINGS 846C-22 AND 844C-25			
DRAWN BY:				
REVIEWED BY:				
SUBMITTED BY:	INVITATION NO. DACW63-82-B-0025	DATE	MAR, 1982	
ENGINEER:	CONTRACT NO. DACW63-82-C-0083	SHEET NO.	17	SEQUENCE NO.

TO ACCOMPANY FOUNDATION REPORT

CONTRACT NO. DACW63-82-B-0025

8A-4C-26

DRILLING LOG		Project		Location		Date	
Aubrey Dan		Southwestern		Fort Worth District		May 22	
USACE-C		Sta 29+50 West Abundant C.L.		Falling 350		26 May 72	
Jay Creeman		8A-4C-26		Falline 350		25 May 72	
Vertical		30.5'		598.91		35.0'	
30.5'		24.5'		Raymond T. Hagen		35.0'	

ELEVATION	DEPTH	LEGEND	CLASSIFICATION OF MATERIALS	CORE RECOVERY	REMARKS
			0.0' to 18.8'	A	JAR SAMPLES
			CLAY-dry, lean, loose, sandy-fine; dark grayish brown.	B	A - 0.0' to 1.0'
			@ 0.8 becomes fat, stiff, wet	C	B - 3.0' to 4.0'
			@ 2.3' color changes to light grayish-brown	D	C - 6.0' to 7.0'
			@ 8.2' becomes very stiff, much fatter, well consolidated, with color change to dark grayish-brown	E	D - 9.0' to 10.0'
			@ 11.2' becomes lean, very sandy-fine, with color change to yellowish brown.	F	E - 12.0' to 13.0'
			18.8' to 26.6'	G	F - 15.0' to 16.0'
			SAND-fine, clayey, lean, wet, silty; yellowish-brown	H	G - 18.0' to 19.0'
			26.9' to 29.0'	I	H - 21.0' to 22.0'
			GRAVEL-hard, well rounded, max size 1-1/2"; clayey, lean, sandy-fine; yellowish brown	J	I - 24.0' to 25.0'
			@ 27.0 - becomes banded with Gravel & Sand bedding. Sand-fine to coarse; micaceous		J - 27.0' to 28.6'
			--Start 4" Core at 31.5'		
			31.5' to 34.6'		
			SHALE, moderately hard, moist, dark gray, fissile, unweathered (except for oxide staining to 33.1), non-jointed.		
			31.5-31.6 SANDSTONE, argillaceous, moderately hard, moderately cemented, thin bedded, oxide stained.		
			31.8-32.6 SANDSTONE		
			35.2-44.1 Interbedded with thin, very fine, thin bedded, tan-lt gray sandstone seams.		
			36.8-37.0 SANDSTONE		
			39.3-40.0 SANDSTONE		
			39.8-40.0 Fossiliferous		
			41.8-42.4 SANDSTONE		
			42.8-43.8 "		
			44.0-44.1 "		
			46.9-49.8 Slightly fossiliferous throughout.		
			46.9-47.3 Sand with fossil detritus		
			49.4-49.8 Very fossiliferous, very well cemented, claystone - nodules from 49.4 - 49.6.		
			T.D. 55.0'		

DRILLING LOG		Project		Location		Date	
Aubrey Dan		Southwestern		Fort Worth District		May 22	
USACE-C		Sta 29+50 West Abundant C.L.		Falling 350		26 May 72	
Jay Creeman		8A-4C-27		Falline 350		25 May 72	
Vertical		28.0'		598.91		35.0'	
28.0'		16.9'		Raymond T. Hagen		35.0'	

ELEVATION	DEPTH	LEGEND	CLASSIFICATION OF MATERIALS	CORE RECOVERY	REMARKS
			0.0' to 20.6'		CLAY-fat, moist, sandy-fine to coarse; very dark gray.
			@ 2.1' - becomes soft, wet		
			@ 5.2' - becomes stiff with more coarse sand (line nodules) with color change to grayish-brown		
			@ 11.1' - Color change to mottled-yellowish brown, gray, and red.		
			@ 15.0' - loses coarse sand and becomes lean.		
			@ 17.6' - becomes gravelly, well rounded, hard, max size 1/2"		
			20.6' to 23.7' - GRAVEL-hard, rounded, max size 2"; clayey, very lean sandy-fine to coarse; yellowish brown.		
			Started 4" core at 25.0'		
			26.5' to 26.7' SANDSTONE, fine-grained, soft, tan, friable, stained.		
			26.7' to 32.7' SHALE, sandy, moderately hard, gray to brown, slightly stained, moderately hard sandstone bed at 29.3' to 29.4'.		
			32.7' to 40.0' SHALE, moderately hard, dark gray, fresh.		
			TOTAL DEPTH - 40.0'		

POLYTRAC-033

Male No. 8AAC-27

Southwestern

Fort Worth District

4" Core Barrel

MSL

Falling Model 44

6DC-28

Boyd Lane Trinity Engineering Testing Corporation

27 May 72

407.03

40.0'

Raymond T. Nagen

LEGEND	CLASSIFICATION OF MATERIALS (Description)	SCORE PERCENT	BOX OR SAMPLE NO.	REMARKS (Drilling time, color logs, depth of penetration, etc., at 20 ft/min)
	0.0' to 20.6' - CLAY-fac, moist, sandy-fine to coarse; very dark gray.		A	Jar Samples A - 0.0' to 1.0' B - 3.0' to 4.0' C - 6.0' to 7.0' D - 9.0' to 10.0' E - 12.0' to 13.0' F - 15.0' to 16.0' G - 18.0' to 19.0' H - 21.0' to 22.0'
	@ 2.1' - becomes soft, wet		B	
	@ 5.2' - becomes stiff with more coarse sand (line nodules) with color change to grayish-brown		C	
	@ 11.1' - color change to mottled-yellowish brown, gray, and red.		D	
	@ 15.0' - loses coarse sand and becomes lean.		E	Set casing to 25.0'. Started coring at this depth.
	@ 17.6' - becomes gravelly, well rounded, hard, max size 1/2".		F	Bailed hole to 37.2'.
	20.6' to 23.7' - GRAVEL-hard, rounded, max size 2", clayey, very lean; sandy-fine to coarse; yellowish brown.		G	
	Started 4" core at 25.0'.		H	
	26.5' to 26.7' SANDSTONE, fine-grained, soft, tan, friable, stained.	15.0		
	26.7' to 32.7' SHALE, sandy, moderately hard, gray to brown, slightly stained, moderately hard sandstone bed at 29.3' to 29.4'.	14.5 16.5 10.0 18.5		
	32.7' to 40.0' SHALE, moderately hard, dark gray, fresh.	16.3		
	TOTAL DEPTH - 40.0'.			

PREVIOUS EDITIONS ARE OBSOLETE. PROJECT: Aubrey Dam. HOLE NO.: 8AAC-27

Male No. 6DC-28

Southwestern

Fort Worth

Aubrey Dam Site No. 1

Not Shown

6DC-28

Boyd Lane Trinity Engineering Testing Corporation

27 May 72

558.84

60.0'

See Note 1 under "Remarks"

ELEVATION	DEPTH	LEGEND	CLASSIFICATION OF MATERIALS (Description)	% CORE RECOVERY	BOX OR SAMPLE NO.	REMARKS (Drilling time, color logs, depth of penetration, etc., at 20 ft/min)
556.84	2		Dark Brown Clay		J1	Used 8" Auger from 0.0'-3.0'
	4		Tan Clay	100	D1	Used 6" d, b, from 3.0'-38.0'
	6			100	D2	Jar sample taken from shoe of each Denison sample.
550.34	8		8.5'	100	D3	JAR SAMPLES
	10		Tan Sandy Clay	100	D4	1. 0.0'-3.0'
	12			100	D5	2. 5.0'
	14			100	D6	3. 7.0'
	16		16.5'	100	D7	4. 9.0'
542.34	18		Tan Clay	100	D8	5. 11.0'
	20		21.0'	100	D9	6. 13.0'
537.84	22		Tan Sandy Clay	100	D10	7. 15.0'
	24		25.0'	100	D11	8. 17.0'
533.84	26		Tan Sand and Gravel	50	D12	9. 19.0'
	28		29.0'	75	D13	10. 21.0'
529.84	30		Tan Gravel and Sand	25	D14	11. 23.0'
	32			75	D15	12. 25.0'
	34			75	D16	13. 27.0'
522.84	36		36.0'	0		14. 29.0'
	38		36.0'-44.9' SHALE, Mod. Hard, Non-Jointed, Laminated, Dark (Continued)	100	D17	15. 31.0'
	40		Gray, Often Sandy w/Thin Sandstone Seams.	R-1 100%	Box 1	16. 33.0'
	42		39.3'-41.5', Sand, Fine-Med.-Grained, Well-Compacted, Gray, Scat. Thin Tan Siltstone Nodules.	R-2 100%	Box 2	17. 35.0'
513.94	44		41.7'-42.9', Sand w/Scat. Siltstone Nodules.	R-3 48.0		CLEANED OUT FROM 35.5'-36.0'
	46		43.0'-44.1', Sand Seams.	R-4 100%	Box 3	Set casing to 36.0'
	48		44.1'-44.5', Sandstone, Well-Cemented, Mod. Hard, Med.-Fine-Grained, Sil. Friable, Gray.	R-5 53.0		Began coring w/6" bbl. at 38.0'
	50		44.5'-44.9', Sand w/Siltstone Nodules	R-6 100%	Box 4	
	52		44.9'-60.0'	R-7 58.0		
	54		SHALE, Mod. Hard, Non-Jointed, Laminated, Dark Gray, w/Sand Seams at 46.8-47.5, 52.9-53.0, 54.95-57.9, 58.5-60.0, 47.8'-48.0', Fossiliferous Zone.	R-8 100%	Box 5	
498.84	60		Total Depth = 60.0'			

CARTON SAMPLES

- 39.8'-40.8'
- 43.8'-44.8'
- 50.0'-50.8'
- 55.3'-56.3'
- 58.8'-59.8'

Note 1:
Soils Logged by:
A. J. Simpson,
Trinity Engineering Testing Corporation;

Primary Logged By:
Marr, Corps of Engineers, Fort Worth District

Note 2:
Installed 4" Plastic Pipe from 560.34 to 529.74 for ground-water observations.

Memo No. 6DC-28

DRILLING LOG	Division: Southwestern	Installation: Fort Worth	Sheet 1 of 2
PROJECT: Subrey Dam Site No. 1	NO. SIZE AND TYPE OF BIT: 8" A.S., 6" Den, 6" Core		
LOCATION (Continuation of Form 101 Shown): T: 2, 119, 250 V: 415, 255	DATE FOR ELEVATION DATA: 12-7-72		
DATE OF LOG: 6DC-28	MSL		
DRILLING AGENCY: Corps of Engineers	MFG. MANUFACTURER'S DESIGNATION OF DRILL: Falling Model 44		
NO. OF LOGS: 18	NO. OF UNTESTED BOREHOLE SAMPLES TAKEN: 16	NO. TOTAL NUMBER CORE BOXES: 5	
NO. OF DRILLER: Boyd Lane	ELEVATION GROUND WATER: See Note 2		
NO. OF TESTS: 1	DATE MOLE STARTED: 11-14-72 COMPLETED: 12-7-72		
NO. OF OVERBURDEN: 36.0'	ELEVATION TOP OF HOLE: 558.84		
DEPTH DRILLED INTO ROCK: 24.0'	TOTAL CORE RECOVERY FOR BORING: 100.0		
TOTAL DEPTH OF HOLE: 60.0'	SIGNATURE OF INSPECTOR: See Note 1 under "Remarks"		

DEPTH	LOG	CLASSIFICATION OF MATERIALS (Description)	% CORE RECOVERY	BOX NO.	REMARKS (Depth, moisture, etc., of samples)
0-2.0'		Dark Brown Clay		J1	Used 8" Auger from 0.0'-3.0'
2.0'-3.0'		Tan Clay	100	D1	Used 6" d.b. from 3.0'-38.0'
3.0'-4.0'			100	D2	Jar sample taken from shoe of each Denison sample.
4.0'-8.5'			100	D3	
8.5'-10.0'		Tan Sandy Clay	100	D4	JAR SAMPLES
10.0'-11.0'			100	D5	1. 0.0'-3.0'
11.0'-12.0'			100	D6	2. 5.0'
12.0'-13.0'			100	D7	3. 7.0'
13.0'-14.0'			100	D8	4. 9.0'
14.0'-15.0'			100	D9	5. 11.0'
15.0'-16.5'			100	D10	6. 13.0'
16.5'-17.0'			100	D11	7. 15.0'
17.0'-18.0'			100	D12	8. 17.0'
18.0'-19.0'			100	D13	9. 19.0'
19.0'-20.0'			100	D14	10. 21.0'
20.0'-21.0'			100	D15	11. 23.0'
21.0'-22.0'			100	D16	12. 25.0'
22.0'-23.0'			100	D17	13. 27.0'
23.0'-24.0'			100	D18	14. 29.0'
24.0'-25.0'			100	D19	15. 31.0'
25.0'-26.0'			100	D20	16. 33.0'
26.0'-27.0'			100	D21	17. 35.0'
27.0'-28.0'			100	D22	18. 38.0'
28.0'-29.0'			100	D23	
29.0'-30.0'			100	D24	
30.0'-31.0'			100	D25	
59.0'-60.0'			100	D54	

Denison Samples

- 3.0'-5.0'
- 5.0'-7.0'
- 7.0'-9.0'
- 9.0'-11.0'
- 11.0'-13.0'
- 13.0'-15.0'
- 15.0'-17.0'
- 17.0'-19.0'
- 19.0'-21.0'
- 21.0'-23.0'
- 23.0'-25.0'
- 25.0'-27.0'
- 27.0'-29.0'
- 29.0'-31.0'
- 31.0'-33.0'
- 33.0'-35.0'
- 35.0'-38.0'

Carton Samples

- 39.8'-40.8'
- 43.8'-44.8'
- 50.0'-50.8'
- 55.3'-56.3'
- 58.8'-59.8'

Note 1:
Soils Logged By: A. J. Simpson, Trinity Engineering Testing Corporation;

Primary Logged By:
Marr, Corps of Engineers, Fort Worth District

Note 2:
Installed 4" Plastic Pipe from 560.34 to 529.74 for ground-water observations.

RECORD DRAWING-WORK AS BUILT

SYM	DC	NO	ACTION	DATE	DESCRIPTION OF REVISION
U.S. ARMY ENGINEER DISTRICT, FORT WORTH CORPS OF ENGINEERS FORT WORTH, TEXAS					
RAY ROBERTS LAKE ELM FORK, TRINITY RIVER, TEXAS EMBANKMENT, SPILLWAY AND OUTLET WORKS LOGS OF BORINGS 8A4C-26, 8A4C-27, AND 6 DC-28					
DESIGNED BY:			INVESTIGATION NO. DACW 63-82-B-0025 DATE: MAR, 1962		
DRAWN BY:			CONTRACT NO. DACW 63-82-C-0083		
REVIEWED BY:			ENGINEER		
SUBMITTED BY:			DRAWING NUMBER		
			SHEET NO. OF 18		

TO ACCOMPANY FOUNDATION REPORT

CONTRACT NO. DACW 63-82-C-0083

DEPTH	LOG NO.	CLASSIFICATION OF MATERIALS (Description)	% CORE RECOVERED	LOG OF SAMPLE NO.	REMARKS (Drilling data, water level, depth of water, etc., if applicable)
					<p>Note 1: Soils Logged By: A. J. Simpson, Trinity Engineering Testing Corporation;</p> <p>Primary Logged By: Green and Marr, Corps of Engineers, Fort Worth District.</p> <p>Note 2: Installed 4" Plastic Pipe from 558.50 to 520.50 for ground- water observations.</p>

1836-A (MODIFIED) PROJECT: Aubrey Dam Site No. 1 LOG NO.: 6DC-31

DRILLING LOG		Location		Date	
PROJECT		DISTRICT		DATE	
Aubrey Dam Site No. 1		Southwestern		Fort Worth	
X-2 141 403 Y-615 328 Sta. 132+00		6DC-31		12-18-72	
Corps of Engineers		Boyd Lane		12-29-72	
Trinity Engineering Testing Corporation		Trinity Engineering Testing Corporation		See Note 2	
ELEVATION OF SURFACE		ELEVATION TOP OF SOLE		ELEVATION OF SURFACE	
39.0'		555.18		12-18-72	
DEPTH DRILLED INTO SOLE		TOTAL CORE RECOVERED		PERCENTAGE OF RECOVERY	
51.0'		100.0%		100.0%	
TOTAL DEPTH OF SOLE		TOTAL DEPTH OF SOLE		TOTAL DEPTH OF SOLE	
90.0'		90.0'		90.0'	
DEPTH	ELEVATION	DESCRIPTION OF MATERIALS (Description)	PERCENTAGE RECOVERED	LOG NO.	REMARKS
2		Brown Clay	0	J1	Used 8" Auger from 0.0'-3.0'
550.38		5.0'	50	D1	Used 6" Denison bbl. 3.0'-40.0'
6		Brown Sandy Clay	100	D2	Jar sample taken from shoe of each Denison sample.
546.38		9.0'	100	D3	JAR SAMPLES
10		Brown Silty Clay w/Sand Lenses	100	D4	1. 0.0'-3.0'
12			80	D5	2. 5.0'
540.38		15.0'	100	D6	3. 7.0'
16		Brown Silty Sand w/Clay Lenses	90	D7	4. 9.0'
18			100	D8	5. 11.0'
20			100	D9	6. 13.0'
532.38		23.0'	50	D10	7. 15.0'
24		Tan and Gray Sandy Clay w/Silt Lenses	100	D11	8. 17.0'
530.38		25.0'	75	D13	9. 19.0'
26		Tan and Gray Silty Clay w/Iron Ore	50	D12	10. 21.0'
28			90	D14	11. 23.0'
30			100	D15	12. 25.0'
522.38		33.0'	100	D16	13. 27.0'
34		Gray Silty Sand w/Scattered Gravel	90	D17	14. 29.0'
36			100	D18	15. 31.0'
516.38		39.0'	40	D18	16. 33.0'
40		39.0'-45.0' SHALE	R-1		17. 35.0'
42		39.0'-45.0' SHALE, Mod. Hard, Dk. Gray Thin-Bedded-Massive, w/Num. Lt. Gray Sand Pockets and Lenses	100%	Box 1	18. 38.0'-40.0'
510.38		43.4' Siltstone Nods., Hard Tan	R-2		Reamed from 0.0'-38.0' w/8" bit. Began coring w/6" core bbl. at 40.0'. Set 8" casing to 44.0'
46		45.0'-55.6' Shale & Sandstone, Alt. Bed w/occas. Sand Lenses	100%	Box 2	CARTON SAMPLES
50		Shale is Gray, Massive, Mod. Hard, Sandy Unweathered	100%	Box 3	1. 42.3'-43.3'
48		45.0'-55.6' Sandstone is Fine-Med. Gray, Soft-Mod. Hard, Gray-Lt. Gray, Yell Cemented	100%	Box 4	2. 46.2'-46.8'
54		55.6'-64.0' Shale, Mod. Hard-Hard, Dk. Gray Laminated, Unweathered	100%	Box 5	3. 51.6'-52.6'
489.78		58.6'-59.4' Fossiliferous soft-Mod. Hard, Calc.	100%	Box 6	4. 56.5'-57.5'
58		64.0'-75.4' Shale & Sandstone, Alt. Bed w/occas. Sand Lenses	100%	Box 7	5. 61.2'-62.2'
60		Shale is Mod Hard-Hard, Dk. Gray, Laminated	69.0	Box 8	6. 64.7'-65.7'
591.38		75.4'	100%	Box 9	7. 72.8'-73.8'
62			100%	Box 10	8. 75.4'-76.4'
64			100%	Box 11	9. 80.3'-81.3'
66			100%	Box 12	10. 85.5'-86.5'
68			100%	Box 13	Note 1: Soils Logged By: A. J. Simpson, Trinity Engineering Testing Corporation
479.58		75.4'-90.0' Shale, Gray-Dk. Gray, Mod. Hard-Hard, Laminated Calc.	100%	Box 14	Primary Logged By: Green and Marr, Corps of Engineers, Fort Worth District
70			100%	Box 15	Note 2: Installed 4" plastic pipe from 556.6 to 511.6 for ground- water observations.
72			100%	Box 16	
74			100%	Box 17	
76			100%	Box 18	
78			100%	Box 19	
80			100%	Box 20	
82			100%	Box 21	
84			100%	Box 22	
86			100%	Box 23	
88			100%	Box 24	
465.38		90.0'	100%	Box 25	
Total Depth = 90.0 Feet					

1834-A (MODIFIED) PROJECT: Aubrey Dam Site No. 1 LOG NO.: 6DC-31

DESIGNED BY	_____ _____ _____
DRAWN BY	_____ _____ _____
REVIEWED BY	_____ _____ _____
SUBMITTED BY	_____ _____ _____
ENGINEER	_____ _____ _____

TO ACCO...

BILLING LOG		PROJECT		LOCATION		DATE	
Aubrey Dam Site No. 1		Southwestern		Fort Worth		1972	
X-2, 131, 403, 2415, 278- Sta. 132400		6DC-31		Fall Line Model 44		12-18-72	
Boyd Lane Trinity Engineering Testing Corporation		19.0'		555.38		12-29-72	
6DC-31		99.0'		See Note 1 under "Remarks"			
ELEVATION	DEPTH	LOGS	EXPLANATION OF MATERIALS	DEPTH TO TOP OF MATERIAL	DEPTH TO BOTTOM OF MATERIAL	REMARKS	REMARKS
550.38	2		Brown Clay	0	J1	Used 8" Auger from 0.0'-3.0'	
	4			50	D1	Used 6" Denison bbl. 3.0'-10.0'	
546.38	6		Brown Sandy Clay	100	D2	Jar sample taken from shoe of each Denison sample.	
	8			100	D3		
	10		Brown Silty Clay w/Sand Lenses	100	D4	JAR SAMPLES	
	12			80	D5	1. 0.0'-3.0'	
540.38	14			100	D6	2. 5.0'	
	16		Brown Silty Sand w/Clay Lenses	90	D7	3. 7.0'	
	18			100	D8	4. 9.0'	
	20			100	D9	5. 11.0'	
532.38	22			50	D10	6. 13.0'	
	24		Tan and Gray Sandy Clay w/Silt Lenses	100	D11	7. 15.0'	
530.38	26			50	D12	8. 17.0'	
	28		Tan and Gray Silty Clay w/Iron Ore	75	D13	9. 19.0'	
	30			90	D14	10. 21.0'	
522.38	32			100	D15	11. 23.0'	
	34		Gray Silty Sand w/ Scattered Gravel	90	D16	12. 25.0'	
	36			100	D17	13. 27.0'	
516.38	38			0		14. 29.0'	
	40		39.0'-45.0' SHALE	40	D18	15. 31.0'	
	42		39.0'-45.0' SHALE, Mod. Hard, Dk. Gray Thin-Bedded-Massive, w/Num. Lt. Gray Sand Pockets and Lenses	100%	Box 1	16. 33.0'-35.0'	
510.38	44		43.4' Siltstone Nods., Hard Tan	45.0	R-2	17. 35.0'-37.0'	
	46		45.0'-55.6' Shale & Sandstone, Alt. Bed w/occas. Sand Lenses	100%	Box 2	18. 38.0'-40.0'	
	48		Shale is Gray, Massive, Mod. Hard, Sandy Unweathered	50.0	R-3	Reamed from 0.0'-38.0' w/8" bit.	
	50		Sandstone is Fine-Med. Grs Soft-Mod. Hard, Gray-Lt. Gray, Well Cemented	100%	Box 3	Began coring w/6" core bbl. at 40.0'	
	52		55.6'-64.0' Shale, Mod. Hard-Hard, Dk. Gray Laminated, Unweathered	54.0	R-5	Set 8" casing to 44.0'	
499.78	54		58.6'-59.4' Fossiliferous zone Soft-Mod. Hard, Calc	59.0	Box 4	CARTON SAMPLES	
	56		64.0'-75.4' Shale & Sandstone, Alt. Bed w/occas. Sand Lenses	64.0	R-6	1. 42.3'-43.3'	
	58		Shale is Mod Hard-Hard, Dk. Gray, Laminated	69.0	Box 5	2. 46.2'-46.8'	
	60			100%	R-7	3. 51.6'-52.6'	
	62			100%	R-8	4. 56.5'-57.5'	
491.38	64			100%	Box 6	5. 61.2'-62.2'	
	66			100%	R-9	6. 64.7'-65.7'	
	68			100%	R-10	7. 72.8'-73.8'	
	70			100%	Box 7	8. 75.4'-76.4'	
	72			100%	R-11	9. 80.9'-81.9'	
	74			100%	Box 8	10. 85.5'-86.5'	
479.38	76		75.4'-90.0' Shale, Gray-Dk. Gray, Mod. Hard-Hard, Laminated Calc.	79.0	Box 9	Note 1: Soils Logged By: A. J. Simpson, Trinity Engineering Testing Corporation	
	78			100%	R-12	Primary Logged By: Marr Corps of Engineers, Fort Worth District	
	80			100%	R-13	Note 2: Installed 4" plastic pipe from 556.6 to 511.6 for ground-water observations.	
	82			100%	Box 10		
	84			100%	R-14		
	86			100%	Box 11		
	88			100%	R-15		
465.38	90		Total Depth = 90.0 Feet	99.0	Box 12		

1834-A (MODIFIED) Aubrey Dam Site No. 1 6DC-31

RECORD DRAWING-WORK AS BUILT

SYM	DO	NO	ACTION	DATE	DESCRIPTION OF REVISION
U.S. ARMY ENGINEER DISTRICT, FORT WORTH CORPS OF ENGINEERS FORT WORTH, TEXAS					
DESIGNED BY:	RAY ROBERTS LAKE				
DRAWN BY:	ELM FORK, TRINITY RIVER, TEXAS				
REVIEWED BY:	EMBANKMENT, SPILLWAY AND				
	OUTLET WORKS				
	LOGS OF BORINGS				
	6DC-30 AND 6 DC-31				
SUBMITTED BY:	INVITATION NO. DACW 63-82-B 0025			DATE MAR, 1982	
ENGINEER:	CONTRACT NO. DACW 63-72-C-0093			SEQUENCE NO.	
	DRAWING NUMBER			SHEET NO.	
				19	

TO ACCOMPANY FOUNDATION REPORT

CONTRACT NO. DACW 63-82-B 0025

Memo No. 356DC 32

DRILLING LOG		DIVISION		INSTALLATION		TEST	
Southwestern		Fort Worth		or 2 inches			
PROJECT: Aubrey Dam Site No. 1							
LOCATION (Coordinate as Station): Not Shown Y 2141 310 Y 415 790							
DRILLING AGENCY: Corps of Engineers							
NAME OF DRILLER: Trinity Engineering Testing Corporation							
DIRECTION OF HOLE: <input checked="" type="checkbox"/> Vertical <input type="checkbox"/> Inclined <input type="checkbox"/> See from vent							
THICKNESS OF OVERBURDEN: 41.5							
DEPTH DRILLED INTO ROCK: 18.5							
TOTAL DEPTH OF HOLE: 60.0							
See Note 1 under "Remarks"							
ELEVATION	DEPTH	LEGEND	CLASSIFICATION OF MATERIALS (Color-coded)	NO. OF CORE RECON. CUT	BOX OR SAMPLE NO.	REMARKS (Drilling time, water used, depth of penetration, etc.)	REMARKS (Soils logged, etc.)
555.05	2		Brown Clay 2.0'	100	W1	3" Shelby Tube Samples	
	4		Brown Sandy Clay	100	W2	0.0'-20.0'	
	6			100	W3	Denison bbl. Samples	
	8			100	W4	20.0'-44.0'	
	10			100	W5	Jar Samples Nos. 6 - 16 were taken from the shoe of the Denison sample.	
	12		Brown Silty Sand	100	W6		
	14			100	W7	JAR SAMPLES	
	16			100	W8	1. 2.0'-3.0'	
	18			100	W9	2. 6.0- 7.0'	
	20			100	W10	3. 10.0'-11.0'	
	22			100	W11	4. 14.0'-15.0'	
	24			100	W12	5. 18.0'-19.0'	
	26			100	W13	6. 22.0'	
	28			100	W14	7. 24.0'	
	30			100	W15	8. 26.0'	
	32			100	W16	9. 28.0'	
	34			100	W17	10. 30.0'	
	36			75	D2	11. 32.0'	
	38			100	D3	12. 34.0'	
	40			100	D4	13. 38.0'	
	42			100	D5	14. 40.0'	
	44			100	D6	15. 42.0'	
	46			50	D7	16. 44.0'	
	48			0	Lost Sam.	Reamed hole to 42.0' w/8" bit.	
	50			50	D8	Set 8" casing to 42.0'. Used 6" core bbl. from 44.0'-60.0'	
	52			50	D9		
	54			65	D10	WRAP SAMPLES	
	56			75	D11	1. 0.0'- 1.0'	
	58			R-1	Box 1	2. 1.0'- 2.0'	
	60			100%	R-2	3. 3.0'- 4.5'	
				49.0	R-3	4. 4.5'- 6.0'	
				100%	Box 2	5. 7.0'- 8.5'	
				54.0	R-1	6. 8.5'-10.0'	
				100%	Box 3	7. 11.0'-12.5'	
				59.0	R-2	8. 12.5'-14.0'	
				100%	R-3	9. 15.0'-16.5'	
				59.0	Box 1	10. 16.5'-18.0'	
				100%	Box 2	11. 19.0'-20.0'	
				59.0	Box 3	DENISON SAMPLES	
				100%	Box 1	1. 20.0'-22.0'	
				100%	Box 2	2. 22.0'-24.0'	
				100%	Box 3	3. 24.0'-26.0'	
				100%	Box 4	4. 26.0'-28.0'	
				100%	Box 5	5. 28.0'-30.0'	
				100%	Box 6	6. 30.0'-32.0'	
				100%	Box 7	7. 32.0'-34.0'	
				100%	Box 8	8. 36.0'-38.0'	
				100%	Box 9	9. 38.0'-40.0'	
				100%	Box 10	10. 40.0'-42.0'	
				100%	Box 11	11. 42.0'-44.0'	
				100%	Box 12	CARTON SAMPLES	
				100%	Box 13	1. 45.3'-46.2'	
				100%	Box 14	2. 52.6'-53.6'	
				100%	Box 15	3. 57.3'-58.1'	
				100%	Box 16		
				100%	Box 17		
				100%	Box 18		
				100%	Box 160		

Drilling Log header information including project name, location, and company details for the left log.

Drilling Log Table (Left): Contains columns for Elevation, Depth, Legend, Classification of Materials, and Remarks. Includes detailed soil descriptions like 'Brown Clay' and 'Light Brown Sandy Clay'.

Additional notes and sample data for the left log, including sample depths and descriptions.

Drilling Log Table (Right): Contains columns for Elevation, Depth, Legend, Classification of Materials, and Remarks. Includes detailed soil descriptions like 'Dark Brown Clay' and 'Brown Silty Clay'.

Additional notes and sample data for the right log, including sample depths and descriptions.

Administrative form at the bottom right with fields for 'DESIGNED BY', 'DRAWN BY', 'REVIEWED BY', and 'SUBMITTED BY'.

ELEVATION		DEPTH		LEGEND		CLASSIFICATION OF MATERIALS (Designation)		CORE RECOVERY %		SOIL OR SAMPLE NO.		REMARKS (Disturbance, main logs, depth of weathering, etc., if significant)	
546.58	13.0'					Dark Brown Clay			W1	Boring advanced with 3" Shelby tube from 0.0'-40.5'. Cleaned out 40.5'-41.0'.			
									W2				
									J1	Used 6" Denison barrel 41.0'-47.0'. Set 8" casing to 45.0' depth.			
									W3	Encountered moisture at 23.0' and water at 38.0'.			
									W4				
									J2	JAR SAMPLES			
									W5	1. 2.0' - 3.0'			
									W6	2. 6.0' - 7.0'			
									W7	3. 10.0' - 11.0'			
									J3	4. 14.0' - 15.0'			
									W8	5. 18.0' - 19.0'			
									W9	6. 22.0' - 23.0'			
									J4	7. 26.0' - 27.0'			
									W10	8. 30.0' - 31.0'			
									J5	9. 34.0' - 35.0'			
									W11	10. 38.0' - 39.0'			
									J6	11. 43.0'			
									W12	12. 45.0'			
									J7	13. 47.0'			
									W13	DENISON SAMPLES			
									J8	1. 41.0' - 43.0'			
									W14	2. 43.0' - 45.0'			
									J9	3. 45.0' - 47.0'			
									W15				
									J10				
									W16				
									J11				
									W17				
									J12				
									W18				
									J13				
									W19				
									J14				
									W20				
									J15				
									W21				
									J16				
									W22				
									J17				
									W23				
									J18				
									W24				
									J19				
									W25				
									J20				
									W26				
									J21				
									W27				
									J22				
									W28				
									J23				
									W29				
									J24				
									W30				
									J25				
									W31				
									J26				
									W32				
									J27				
									W33				
									J28				
									W34				
									J29				
									W35				
									J30				
									W36				
									J31				
									W37				
									J32				
									W38				
									J33				
									W39				
									J34				
									W40				
									J35				
									W41				
									J36				
									W42				
									J37				
									W43				
									J38				
									W44				
									J39				
									W45				
									J40				
									W46				
									J41				
									W47				
									J42				
									W48				
									J43				
									W49				
									J44				
									W50				
									J45				
									W51				
									J46				
									W52				
									J47				
									W53				
									J48				
									W54				
									J49				
									W55				
									J50				
									W56				
									J51				
									W57				
									J52				
									W58				
									J53				
									W59				
									J54				
									W60				
									J55				
									W61				
									J56				
									W62				
									J57				
									W63				
									J58				
									W64				
									J59				
									W65				
									J60				
									W66				
									J61				
									W67				
									J62				
									W68				
									J63				
									W69				
									J64				
									W70				
									J65				
									W71				
									J66				
									W72				
									J67				
									W73				
									J68				
									W74				
									J69				
									W75				
									J70				
									W76				
									J71				
									W77				

Hole No. 356D-36

DRILLING		INSTALLATION	
PROJECT: Fort Worth		HOLE NO. AND TYPE OF BIT: 3" Shelby, 6" Denison	
1. LOCATION: MSL		2. DATE MOLE STARTED: 1-29-73	
3. DRILLING AGENCY: Falling Model 44		3. DATE MOLE COMPLETED: 1-30-73	
4. NAME OF DRILLER: Boyd Lane		4. ELEVATION TOP OF MOLE: 557.89	
5. TRINITY ENGINEERING TESTING CORPORATION		5. ELEVATION GROUND WATER: See Note 2	
6. THICKNESS OF OVERBURDEN: 44.0'		6. TOTAL CORE RECOVERY FOR BORING: See Note 1 under "Remarks"	
7. DEPTH OF LIES INTO ROCK: 2.0'		7. SIGNATURE OF INSPECTOR: See Note 1 under "Remarks"	
8. TOTAL DEPTH OF HOLE: 46.0'		8. SIGNATURE OF INSPECTOR: See Note 1 under "Remarks"	

ELEVATION	DEPTH	LEGEND	CLASSIFICATION OF MATERIALS (Description)	% CORE RECOVERY	BOX OF SAMPLES NO.	REMARKS (Drilling time, water loss, depth of penetration, etc.)
549.38	2		Brown Clay	100%	W1	Drilling
	3				W2	3" Shelby; 0.0'-26.0'
	4				W3	Cleaned out
	6				W4	Set 26.0' of 8" casing
	8				J2	6" d. b. from 26.0'-46.0'. Advanced casing to 45.0'.
	10				W6	WRAP SAMPLES
	12				J3	1. 0.0'-1.0'
	14				W7	2. 1.0'-2.0'
	16				W8	3. 3.0'-4.5'
	18				J4	4. 4.5'-6.0'
	20				W9	5. 7.0'-8.5'
	22				W10	6. 8.5'-10.0'
	24				J5	7. 11.0'-12.5'
	26				W11	8. 12.5'-14.0'
	28				J6	9. 15.0'-16.5'
	30				W12	10. 16.5'-18.0'
	32				J7	11. 19.0'-20.5'
	34				W13	12. 20.5'-22.0'
	36				J8	13. 23.0'-24.5'
	38				W14	JAR SAMPLES
	40				D1	1. 2.0'-3.0'
	42				D2	2. 6.0'-7.0'
	44				D3	3. 10.0'-11.0'
	46				D4	4. 14.0'-15.0'
					D5	5. 18.0'-19.0'
					D6	6. 22.0'-23.0'
					D7	7. 28.0'
					D8	8. 30.0'
					D9	9. 32.0'
					D10	10. 34.0'
					D11	11. 36.0'
					D12	12. 38.0'
					D13	13. 40.0'
					D14	14. 42.0'
					D15	15. 44.0'
					D16	16. 46.0'
					D17	1. 2.0'-3.0'
					D18	2. 6.0'-7.0'
					D19	3. 10.0'-11.0'
					D20	4. 14.0'-15.0'
					D21	5. 18.0'-19.0'
					D22	6. 22.0'-23.0'
					D23	7. 28.0'
					D24	8. 30.0'
					D25	9. 32.0'
					D26	10. 34.0'
					D27	11. 36.0'
					D28	12. 38.0'
					D29	13. 40.0'
					D30	14. 42.0'
					D31	15. 44.0'
					D32	16. 46.0'
					D33	1. 26.0'-28.0'
					D34	2. 28.0'-30.0'
					D35	3. 30.0'-32.0'
					D36	4. 32.0'-34.0'
					D37	5. 34.0'-36.0'
					D38	6. 36.0'-38.0'
					D39	7. 38.0'-40.0'
					D40	8. 40.0'-42.0'
					D41	9. 42.0'-44.0'
					D42	10. 44.0'-46.0'

Note 1:
Soils logged by:
A. J. Simpson,
Trinity Engineering
Testing Corporation.

Note 2:
Install 4" plastic pipe
from 559.18 to 513.18
for groundwater
observations.

Boring was advanced to
26.0 feet below the
ground surface prior
to using drilling fluid
and groundwater was
encountered at the
18.0-foot depth.

Hole

DRILLING		INSTALLATION	
PROJECT: Southwestern		HOLE NO. AND TYPE OF BIT: 3" Shelby	
1. LOCATION: MSL		2. DATE MOLE STARTED: 1-20-73	
3. DRILLING AGENCY: Falling Model 44		3. DATE MOLE COMPLETED: 1-20-73	
4. NAME OF DRILLER: Boyd Lane		4. ELEVATION TOP OF MOLE: 556.0	
5. TRINITY ENGINEERING TESTING CORPORATION		5. ELEVATION GROUND WATER: See Note 1 under "Remarks"	
6. THICKNESS OF OVERBURDEN: 44.0'		6. TOTAL CORE RECOVERY FOR BORING: See Note 1 under "Remarks"	
7. DEPTH OF LIES INTO ROCK: 2.0'		7. SIGNATURE OF INSPECTOR: See Note 1 under "Remarks"	
8. TOTAL DEPTH OF HOLE: 46.0'		8. SIGNATURE OF INSPECTOR: See Note 1 under "Remarks"	

ELEVATION	DEPTH	LEGEND	CLASSIFICATION OF MATERIALS (Description)	% CORE RECOVERY	BOX OF SAMPLES NO.	REMARKS (Drilling time, water loss, depth of penetration, etc.)
553.68	2		Brown Clay	100%	W1	DRILLING
	3				W2	3" Shelby
	4				W3	Cleaned out
	6				W4	31.0'-46.0'
549.68	6		Tan Silty Clay	100%	W4	WRAP
	7				J2	1. 0.0'
	8				W5	2. 1.0'
	10				W6	3. 3.0'
	12				J3	4. 4.0'
	14				W7	5. 7.0'
	16				W8	6. 8.0'
	18				J4	7. 11.0'
	20				W9	8. 12.0'
	22				J5	9. 15.0'
	24				W10	10. 16.0'
	26				J6	11. 19.0'
	28				W11	12. 20.5'
	30				J7	13. 23.0'
	32				W12	JAR SA
	34				J8	1. 2.0'
	36				W13	2. 6.0'
	38				W14	3. 10.0'
	40				W15	4. 14.0'
	42				W16	5. 18.0'
	44				J9	6. 22.0'
	46				D1	7. 26.0'
					D2	8. 30.0'
					D3	9. 33.0'
					D4	10. 35.0'
					D5	11. 37.0'
					D6	12. 38.0'
					D7	13. 38.0'
					D8	14. 42.0'
					D9	15. 42.0'
					J15	16. 46.0'
					D6	DENISON
					D1	1. 31.0'
					D2	2. 33.0'
					D3	3. 35.0'
					D4	4. 37.0'
					D5	5. 40.0'
					D6	6. 44.0'
						Set 8" casing
						Note 1: Soils logged A. J. Simpson, Trinity Eng Testing Co
						Note 2: Installed 4" pipe from 511.68 for water obser

Division	Southwestern	INSTALLATION	Fort Worth	SHEET	1	OF 2 SHEETS
PROJECT	Dam Site No. 1	NO. SIZE AND TYPE OF BIT	3" Shelby, 6" d.b.	DATE FOR ELEVATION	1-18-73	MSL
LOCATION	Not Shown	MANUFACTURER'S DESIGNATION OF DRILL	Falling Model 44	TOTAL NO. OF OVERBURDEN SAMPLES TAKEN	11	UNDISTURBED
DRILLING AGENCY	Corps of Engineers	MANUFACTURER'S DESIGNATION OF DRILL	Falling Model 44	TOTAL NO. OF OVERBURDEN SAMPLES TAKEN	19	UNDISTURBED
NAME OF DRILLER	Boyd Lane	TRINITY ENGINEERING TESTING CORPORATION		DATE HOLE	1-18-73	COMPLETED
DIRECTION OF HOLE	Vertical	DATE HOLE	1-18-73	COMPLETED	1-20-73	
THICKNESS OF OVERBURDEN	44.0'	ELEVATION TOP OF HOLE	559.07	TOTAL CORE RECOVERY FOR BORING	---	
DEPTH DRILLED INTO ROCK	1.5'	SIGNATURE OF INSPECTOR		TOTAL DEPTH OF HOLE	47.0'	
TOTAL DEPTH OF HOLE	45.5'	See Note 1 under "Remarks"				

DEPTH	LEGEND	CLASSIFICATION OF MATERIALS (Description)	% CORE RECOVERY	BOX OR SAMPLE NO.	REMARKS (Drilling time, water loss, depth of overburden, etc., if significant)
0-3.0'		Dark Brown Clay		W1	3" Shelby tube samples from 0.0'-30.0'. Boring was advanced to 30.0' prior to using drilling fluid. Water at 20.5'. 6" d.b. from 30.0'-45.5'. Set 8" casing to 44.0'.
3.0-4.5'		Brown Clay		W2	
4.5-6.0'				W3	
6.0-8.5'				W4	
8.5-10.0'				W5	
10.0-11.5'		Light Brown Silty Clay		W6	WRAP SAMPLES
11.5-13.0'				J3	
13.0-14.5'				W7	
14.5-16.0'				W8	
16.0-17.5'				W9	
17.5-19.0'				W10	
19.0-20.5'				J5	
20.5-22.0'				W11	
22.0-23.5'				W12	
23.5-25.0'				J7	
25.0-26.5'				W13	
26.5-28.0'				W14	
28.0-30.0'				J8	
30.0-31.5'		Tan Sandy Clay		W15	DENISON SAMPLES
31.5-33.0'				W16	
33.0-34.5'				J8	
34.5-36.0'				W17	
36.0-37.5'		Tan Sand w/Gravel	100%	D1	DENISON SAMPLES
37.5-39.0'			100%	D2	
39.0-40.5'			0%		
40.5-42.0'			10%	J11	
42.0-43.5'		Tan Sand and Gravel	0%		JAR SAMPLES
43.5-45.0'			50%	D3	
45.0-46.5'			100%	D4	
46.5-48.0'					
Total Depth = 45.5 Feet					

Note 1: Soils logged by: A. J. Simpson, Trinity Engineering Testing Corporation.

Note 2: Installed 4" plastic pipe from for groundwater observations.

RECORD DRAWING-WORK AS BUILT

Division	Southwestern	INSTALLATION	Fort Worth	SHEET	2	OF 2 SHEETS
PROJECT	Aubrey Dam Site No. 1	NO. SIZE AND TYPE OF BIT	3" Shelby, 6" d.b.	DATE FOR ELEVATION	1-16-73	MSL
LOCATION	Not Shown	MANUFACTURER'S DESIGNATION OF DRILL	Falling Model 44	TOTAL NO. OF OVERBURDEN SAMPLES TAKEN	11	UNDISTURBED
DRILLING AGENCY	Corps of Engineers	MANUFACTURER'S DESIGNATION OF DRILL	Falling Model 44	TOTAL NO. OF OVERBURDEN SAMPLES TAKEN	19	UNDISTURBED
NAME OF DRILLER	Boyd Lane	TRINITY ENGINEERING TESTING CORPORATION		DATE HOLE	1-16-73	COMPLETED
DIRECTION OF HOLE	Vertical	DATE HOLE	1-16-73	COMPLETED	1-17-73	
THICKNESS OF OVERBURDEN	45.5'	ELEVATION TOP OF HOLE	560.61	TOTAL CORE RECOVERY FOR BORING	---	
DEPTH DRILLED INTO ROCK	1.5'	SIGNATURE OF INSPECTOR		TOTAL DEPTH OF HOLE	47.0'	
TOTAL DEPTH OF HOLE	45.5'	See Note 1 under "Remarks"				

ELEVATION	DEPTH	LEGEND	CLASSIFICATION OF MATERIALS (Description)	% CORE RECOVERY	BOX OR SAMPLE NO.	REMARKS (Drilling time, water loss, depth of overburden, etc., if significant)
556.11	2		Dark Brown Clay		W1	3" Shelby tube samples from 0.0'-34.0'. 6" d.b. samples from 34.0'-47.0'. Boring was advanced to 34.0' prior to using drilling fluid.
	4				W2	
	6				J1	
	8		Brown Silty Clay		W3	
	10				W4	
	12				J2	
	14				W5	WRAP SAMPLES
	16				W6	
	18				J3	
	20				W7	
	22				W8	
	24				J4	
	26				W9	
	28				W10	
	30				J5	
	32				W11	
	34				W12	
	36				J6	
533.61	27.0'		Tan Sandy Clay		W13	
532.11	28				W14	
	30		Tan Clayey Sand		J7	
	32				W15	
	34				W16	DENISON SAMPLES
	36				J8	
	38				W17	
	40				W18	
521.11	39.5'		Tan Sand and Gravel	75%	D3	A jar sample was taken from the shoe of each denison barrel run.
	42		Tan Sand and Gravel	85%	D4	
	44			90%	D5	
	46			33%	J14	
515.11	45.5'		Gray Shale	100%	D6	JAR SAMPLES
513.61	46					
	48					
Total Depth = 47.0 Feet						

Note 1: Soils logged by: A. J. Simpson, Trinity Engineering Testing Corporation.

DESIGNED BY:	
DRAWN BY:	
CHECKED BY:	
SUBMITTED BY:	
ENGINEER:	

U.S. ARMY ENGINEER DISTRICT, FORT WORTH
CORPS OF ENGINEERS
FORT WORTH, TEXAS

RAY ROBERTS LAKE
ELM FORK, TRINITY RIVER, TEXAS
EMBANKMENT, SPILLWAY AND
OUTLET WORKS
LOGS OF BORINGS
8S6D-36, 3S6DC-37, 3S6D-38, AND 3S6D-39

INVITATION NO. DACW63-82-B-0025 DATE MAR, 1982
CONTRACT NO. CACW63-82-C-0023
DRAWING NUMBER

SEQUENCE NO. 21

TO ACCOMPANY FOUNDATION REPORT

CONTRACT NO. DACW63-82-C-0023

Mole No. 354C-42	
DRILLING LOG	Southwestern
Aubrey Dam Site No. 1	
X-2, 137, 603, Y-2614, 466.	
Corps of Engineers	
356DC-50	
Bord Lane	
Trinity Engineering Testing Corporation	
See Note 2	
1-7-73	
662.00	
31	
Remarks	
<p>DRILLING:</p> <p>0.0'-13.0', 3" Shelby Tube</p> <p>13.0'-50.0', NX-Cora</p> <p>21.0'-41.0', Split-Spoon Samples at 5' Intervals.</p> <p>50.0'-55.0', 4" Core</p> <p>Drilling fluid was used below the 10.5' depth. Set casing to 50.0'</p> <p>WRAP SAMPLES:</p> <p>1. 0.0'-2.0'</p> <p>2. 3.0'-4.0'</p> <p>3. 4.0'-5.0'</p> <p>4. 5.0'-6.0'</p> <p>5. 7.0'-8.0'</p> <p>6. 8.0'-9.0'</p> <p>7. 9.0'-10.0'</p> <p>8. 43.2'-43.7'</p> <p>9. 43.7'-44.3'</p> <p>10. 45.0'-46.2'</p> <p>11. 46.2'-46.8'</p> <p>12. 46.8'-47.6'</p> <p>JAR SAMPLES:</p> <p>1. 2.0'-3.0'</p> <p>2. 6.0'-7.0'</p> <p>3. 10.0'-10.5'</p> <p>RAC SAMPLES:</p> <p>1. 10.5'-12.0'</p> <p>2. 12.0'-13.0'</p> <p>3. 16.0'-21.0'</p> <p>4. 25.0'-26.0'</p> <p>5. 30.0'-31.0'</p> <p>6. 35.0'-35.6'</p> <p>7. 40.0'-41.0'</p> <p>BOX 1: 5.0'-55.0'</p> <p>CARTON 1: 31.8'-52.7'</p> <p>Note 1:</p> <p>Soils Logged By: A. J. Simpson, Trinity Engineering Testing Corporation</p> <p>Primary Logged By: Marr Corps of Engineers Fort Worth District</p> <p>Note 2:</p> <p>Installed 2" plastic pipe from 653.0 to 613.0 for ground water observations.</p>	

Mole No. 356DC-50	
DRILLING LOG	Southwestern
Aubrey Dam Site No. 1	
X-2, 137, 603, Y-2614, 466.	
Corps of Engineers	
356DC-50	
Bord Lane	
Trinity Engineering Testing Corporation	
See Note 2	
1-5-73	
556.34	
98.0	
Remarks	
<p>DRILLING:</p> <p>0.0'-13.0', 3" Shelby Tube</p> <p>13.0'-50.0', NX-Cora</p> <p>21.0'-41.0', Split-Spoon Samples at 5' Intervals.</p> <p>50.0'-55.0', 4" Core</p> <p>Drilling fluid was used below the 10.5' depth. Set casing to 50.0'</p> <p>WRAP SAMPLES:</p> <p>1. 0.0'-2.0'</p> <p>2. 3.0'-4.0'</p> <p>3. 4.0'-5.0'</p> <p>4. 5.0'-6.0'</p> <p>5. 7.0'-8.0'</p> <p>6. 8.0'-9.0'</p> <p>7. 9.0'-10.0'</p> <p>8. 43.2'-43.7'</p> <p>9. 43.7'-44.3'</p> <p>10. 45.0'-46.2'</p> <p>11. 46.2'-46.8'</p> <p>12. 46.8'-47.6'</p> <p>JAR SAMPLES:</p> <p>1. 2.0'-3.0'</p> <p>2. 6.0'-7.0'</p> <p>3. 10.0'-10.5'</p> <p>RAC SAMPLES:</p> <p>1. 10.5'-12.0'</p> <p>2. 12.0'-13.0'</p> <p>3. 16.0'-21.0'</p> <p>4. 25.0'-26.0'</p> <p>5. 30.0'-31.0'</p> <p>6. 35.0'-35.6'</p> <p>7. 40.0'-41.0'</p> <p>BOX 1: 5.0'-55.0'</p> <p>CARTON 1: 31.8'-52.7'</p> <p>Note 1:</p> <p>Soils Logged By: A. J. Simpson, Trinity Engineering Testing Corporation</p> <p>Primary Logged By: Marr Corps of Engineers Fort Worth District</p> <p>Note 2:</p> <p>Installed 2" plastic pipe from 653.0 to 613.0 for ground water observations.</p>	

Mole No. 35-51	
DRILLING LOG	Southwestern
Aubrey Dam Site No. 1	
X-2, 137, 603, Y-2614, 466.	
Corps of Engineers	
35-51	
Bord Lane	
Trinity Engineering Testing Corporation	
See Note 2	
1-12-72	
587.66	
60.0	
Remarks	
<p>DRILLING:</p> <p>0.0'-13.0', 3" Shelby Tube</p> <p>13.0'-50.0', NX-Cora</p> <p>21.0'-41.0', Split-Spoon Samples at 5' Intervals.</p> <p>50.0'-55.0', 4" Core</p> <p>Drilling fluid was used below the 10.5' depth. Set casing to 50.0'</p> <p>WRAP SAMPLES:</p> <p>1. 0.0'-2.0'</p> <p>2. 3.0'-4.0'</p> <p>3. 4.0'-5.0'</p> <p>4. 5.0'-6.0'</p> <p>5. 7.0'-8.0'</p> <p>6. 8.0'-9.0'</p> <p>7. 9.0'-10.0'</p> <p>8. 43.2'-43.7'</p> <p>9. 43.7'-44.3'</p> <p>10. 45.0'-46.2'</p> <p>11. 46.2'-46.8'</p> <p>12. 46.8'-47.6'</p> <p>JAR SAMPLES:</p> <p>1. 2.0'-3.0'</p> <p>2. 6.0'-7.0'</p> <p>3. 10.0'-10.5'</p> <p>RAC SAMPLES:</p> <p>1. 10.5'-12.0'</p> <p>2. 12.0'-13.0'</p> <p>3. 16.0'-21.0'</p> <p>4. 25.0'-26.0'</p> <p>5. 30.0'-31.0'</p> <p>6. 35.0'-35.6'</p> <p>7. 40.0'-41.0'</p> <p>BOX 1: 5.0'-55.0'</p> <p>CARTON 1: 31.8'-52.7'</p> <p>Note 1:</p> <p>Soils Logged By: A. J. Simpson, Trinity Engineering Testing Corporation</p> <p>Primary Logged By: Marr Corps of Engineers Fort Worth District</p> <p>Note 2:</p> <p>Installed 2" plastic pipe from 653.0 to 613.0 for ground water observations.</p>	

RECORD DRAWING-WORK AS BUILT

DESIGNED BY	RAY ROBERTS LAKE		
DRAWN BY	ELM FORK, TRINITY RIVER, TEXAS		
REVIEWED BY	EMBANKMENT, SPILLWAY AND		
SUBMITTED BY	OUTLET WORKS		
ENGINEER	LOGS OF BORINGS		
	356D-40, 354C-41, 354C-42, 356DC-50 AND 35-51		
	INVITATION NO. DACW63-82-B-0025	DATE	MAR, 1982
	CONTRACT NO. DACW63-82-C-0083	SHEET NO.	22
	DRAWING NUMBER		

TO ACCOMPANY FOUNDATION REPORT

Hole No. 35-52

DRILLING: Division: Southwestern		INSTALLATION: Fort Worth		SHEET: 1 of 1 SHEETS	
PROJECT: Aubrey Dam Site No. 1		HOLE NO. AND TYPE OF BIT: 3" Shelby tube		DATE: 1-23-73	
LOCATION: Not Shown		M.S.L. (ELEVATION OF BENCH MARK OR OTHER POINT):		DATE FOR ELEVATION DATA: (YEAR AND MONTH)	
DRAWN BY: Corps of Engineers		FALLING MODEL: 44		CORRECTION FOR ELEVATION OF BENCH MARK OR OTHER POINT:	
HOLE NO. AS SHOWN ON DRAWING AND HOLE NUMBER: 35-52		TOTAL NUMBER OF CORE BORES: 0		ELEVATION GROUND WATER: See Note 2	
NAME OF DRILLER: Boyd Lane		ELEVATION TOP OF HOLE: 568.34		DATE HOLE STARTED: 1-23-73	
TRINITY ENGINEERING TESTING CORPORATION		TOTAL CORE RECOVERY FOR BORING: 17.5'		DATE HOLE COMPLETED: 1-23-73	
THICKNESS OF OVERBURDEN: 17.5'		DEPTH DRILLED INTO ROCK: 1.5'		TOTAL DEPTH OF HOLE: 19.0'	
SIGNATURE OF INSPECTOR:		REMARKS: See Note 1 under "Remarks"			

ELEVATION	DEPTH	LEGEND	CLASSIFICATION OF MATERIALS (Description)	SCORE RECOVERY (%)	BOX OR SAMPLE NO.	REMARKS (Drilling time, water level, depth of measuring, etc., if significant)
566.34	2		Brown Sandy Clay		W1	Boring was advanced to 15.0' prior to using drilling fluid. Water at 12.5'. All samples taken with 3" Shelby tube, except B2, which is a washed sample.
	4		Brown and Tan Sandy Clay w/Iron Ore		W2	
562.34	6		6.0'		W3	
	8		Brown and Light Gray Sandy Clay w/Iron Ore		W4	
560.04	10		Tan Clayey Silty Sand w/Gravel		W5	
	12				B1	WRAP SAMPLES 1. 0.0'-1.0' 2. 1.0'-2.0' 3. 3.0'-4.5' 4. 4.5'-6.0' 5. 7.0'-8.5' 6. 11.0'-12.5' 7. 12.5'-14.0'
	14				J3	
	16				W6	
	18				W7	
550.84	17.5'		Gray Shale		J4	
549.34	19.0'		Total Depth = 19.0 Feet		B2	
					J5	
						BAG SAMPLES 1. 8.5'-10.0' 2. 15.0'-18.0'
						JAR SAMPLES 1. 2.0'-3.0' 2. 6.0'-7.0' 3. 10.0'-11.0' 4. 14.0'-15.0' 5. 18.0'-19.0'

ENG FORM 1836 PREVIOUS EDITIONS ARE OBSOLETE
MAR 71 (MODIFIED) (TRANSLUCENT)

PROJECT: Aubrey Dam Site No. 1
HOLE NO.: 35-52

Hole No. 35-53

DRILLING: Division: Southwestern		INSTALLATION: Fort Worth		SHEET: 1 of 1 SHEETS	
PROJECT: Aubrey Dam Site No. 1		HOLE NO. AND TYPE OF BIT: 3" Shelby		DATE: 1-23-73	
LOCATION: X=2,138,455; Y=612,795		M.S.L. (ELEVATION OF BENCH MARK OR OTHER POINT):		DATE FOR ELEVATION DATA: (YEAR AND MONTH)	
DRAWN BY: Corps of Engineers		FALLING MODEL: 44		CORRECTION FOR ELEVATION OF BENCH MARK OR OTHER POINT:	
HOLE NO. AS SHOWN ON DRAWING AND HOLE NUMBER: 35-53		TOTAL NUMBER OF CORE BORES: 0		ELEVATION GROUND WATER: See Note 2	
NAME OF DRILLER: Boyd Lane		ELEVATION TOP OF HOLE: 562.37		DATE HOLE STARTED: 1-23-73	
TRINITY ENGINEERING TESTING CORPORATION		TOTAL CORE RECOVERY FOR BORING: 17.0'		DATE HOLE COMPLETED: 1-23-73	
THICKNESS OF OVERBURDEN: 12.5'		DEPTH DRILLED INTO ROCK: 4.5'		TOTAL DEPTH OF HOLE: 17.0'	
SIGNATURE OF INSPECTOR:		REMARKS: See Note 1 under "Remarks"			

ELEVATION	DEPTH	LEGEND	CLASSIFICATION OF MATERIALS (Description)	SCORE RECOVERY (%)	BOX OR SAMPLE NO.	REMARKS (Drilling time, water level, depth of measuring, etc., if significant)
	2		Brown Sandy Clay w/Gravel		W1	Used 3" Shelby tube for all samples.
	4				W2	
	6		7.0'		W3	
555.37	8		Brown and Light Gray Sandy Clay w/Scattered Gravel and Calcareous Particles		W4	
	10				W5	
	12				W6	WRAP SAMPLES 1. 0.0'-1.0' 2. 1.0'-2.0' 3. 3.0'-4.0' 4. 4.5'-6.0' 5. 7.0'-8.5' 6. 8.5'-10.0' 7. 11.0'-12.0' 8. 12.5'-14.0' 9. 15.0'-16.5'
549.87	12.5'		Light Gray and Yellow Weathered Shale w/Silt Layers		W7	
	14				W8	
546.37	16.0'		Gray Shale w/Sandstone Lenses		W9	
545.37	17.0'		Total Depth = 17.0 Feet		J4	
					J5	
						BAG SAMPLE 1. 16.5'-17.0'

ENG FORM 1836 PREVIOUS EDITIONS ARE OBSOLETE
MAR 71 (MODIFIED) (TRANSLUCENT)

PROJECT: Aubrey Dam Site No. 1
HOLE NO.: 35-53

Note 1:
Soils logged by:
A. J. Simpson,
Trinity Engineering
Testing Corporation.

Note 2:
Boring was advanced to 17.0 feet depth with out using drilling fluid and groundwater was not encountered some not depth.

Notes No. 35-54

PROJECT: Fort Worth
 AUBREY DAM SITE No. 1
 X = 2,139,350; Y = 612,635

CLIENT: Trinity Engineering Testing Corp.

DATE: 3-9-73

DEPTH OF HOLE: 562.37

INSPECTOR: A. J. Simpson

REMARKS:
 W1 Used 3" Shelby tube for all samples.
 W2 for all samples.
 W3 WRAP SAMPLES
 1. 0.0'-1.0'
 2. 1.0'-2.0'
 3. 3.0'-4.0'
 4. 4.5'-6.0'
 5. 7.0'-8.5'
 6. 8.5'-10.0'
 7. 11.0'-12.0'
 8. 12.5'-14.0'
 9. 15.0'-16.5'
 W4 JAR SAMPLES
 1. 2.0'-3.0'
 2. 6.0'-7.0'
 3. 10.0'-11.0'
 4. 14.0'-15.0'
 W5 BAG SAMPLE
 1. 16.5'-17.0'

Note 1:
 Soils logged by: A. J. Simpson, Trinity Engineering Testing Corporation.

Note 2:
 Boring was advanced to 20.0 feet depth without using drilling fluid and groundwater was encountered near that depth.

DEPTH (FEET)	CLASSIFICATION OF MATERIALS (Flowchart)	LABORATORY TESTS	REMARKS
0.0 - 22.0	Gray Clay	W1, J1	3" Shelby tube Samples from 0.0'-22.0'
22.0 - 26.0	Brown Clay w/Calcereous Particles	W2, J2, W3, J3, W4, J4	Drilling fluid was utilized from the ground surface down. Wrap Samples: 1. 0.0'-2.0', 2. 4.0'-6.0', 3. 8.0'-10.0', 4. 12.0'-14.0', 5. 16.0'-18.0', 6. 20.0'-22.0'
26.0 - 27.5	Tan Sandy Clay	W5, J5, W6, J6, W7, J7	Jar Samples: 1. 2.0'-4.0', 2. 6.0'-8.0', 3. 10.0'-12.0', 4. 14.0'-16.0', 5. 18.0'-20.0', 6. 22.0'-24.0', 7. 24.0'-26.0', 8. 26.0'-27.0', 9. 40.0'-40.5'
27.5 - 40.5	Tan Sand and Gravel	W8, J8	
40.5 - 46.5	Gray Shale	W9, J9	
Total Depth = 40.5 Feet			Note 1: Soils logged by: A. J. Simpson, Trinity Engineering Testing Corporation. Note 2: Drilling fluid was utilized in advancing the boring from the ground surface down.

1834-A (MODIFIED) Aubrey Dam Site No. 1 35-54

DEPTH (FEET)	CLASSIFICATION OF MATERIALS (Flowchart)	LABORATORY TESTS	REMARKS
0.0 - 5.5	Gray Clay	W1, J1	3" Shelby tube Samples from 0.0'-32.0'
5.5 - 25.0	Brown Clay w/Calcereous Particles and Scattered Gravel	W2, J2, W3, J3, W4, J4, W5, J5	Boring was advanced to 20.0' prior to using drilling fluid. Wrap Samples: 1. 0.0'-2.0', 2. 4.0'-6.0', 3. 8.0'-10.0', 4. 12.0'-14.0', 5. 16.0'-18.0', 6. 20.0'-22.0', 7. 24.0'-26.0', 8. 28.0'-30.0'
25.0 - 26.7	Tan Sandy Clay	W6, J6, W7, J7	Jar Samples: 1. 2.0'-4.0', 2. 6.0'-8.0', 3. 10.0'-12.0', 4. 14.0'-16.0', 5. 18.0'-20.0', 6. 22.0'-24.0', 7. 26.0'-28.0', 8. 30.0'-32.0'
26.7 - 31.0	Tan Sand	W8, J8	
31.0 - 46.0	Tan Sand and Gravel		
46.0 - 46.5	Gray Shale	W9, J9	
Total Depth = 46.5 Feet			Note 1: Soils logged by: A. J. Simpson, Trinity Engineering Testing Corporation. Note 2: Boring was advanced to 20.0 feet below the ground surface prior to using drilling fluid and groundwater was not encountered above that depth.

1834-A (MODIFIED) Aubrey Dam Site No. 1 35-55

DEPTH (FEET)	CLASSIFICATION OF MATERIALS (Flowchart)	LABORATORY TESTS	REMARKS
550.7 - 552.0	Gray Clay	W1, J1	3" Shelby tube Samples from 0.0'-32.0'
552.0 - 557.7	Brown Clay w/Calcereous Particles and Scattered Gravel	W2, J2, W3, J3, W4, J4, W5, J5	Boring was advanced to 20.0' prior to using drilling fluid. Wrap Samples: 1. 0.0'-2.0', 2. 4.0'-6.0', 3. 8.0'-10.0', 4. 12.0'-14.0', 5. 16.0'-18.0', 6. 20.0'-22.0', 7. 24.0'-26.0', 8. 28.0'-30.0'
557.7 - 562.3	Tan Sandy Clay	W6, J6, W7, J7	Jar Samples: 1. 2.0'-4.0', 2. 6.0'-8.0', 3. 10.0'-12.0', 4. 14.0'-16.0', 5. 18.0'-20.0', 6. 22.0'-24.0', 7. 26.0'-28.0', 8. 30.0'-32.0'
562.3 - 567.0	Tan Sand	W8, J8	
567.0 - 581.7	Tan Sand and Gravel		
581.7 - 587.0	Tan Sand and Gravel		
587.0 - 593.7	Tan Sand and Gravel		
593.7 - 598.0	Gray Shale	W9, J9	
Total Depth = 598.0 Feet			Note 1: Soils logged by: A. J. Simpson, Trinity Engineering Testing Corporation. Note 2: Boring was advanced to 20.0 feet below the ground surface prior to using drilling fluid and groundwater was not encountered above that depth.

DESIGNED BY: _____
 DRAWN BY: _____
 REVIEWED BY: _____
 SUBMITTED: _____
 ENGINEER: _____

Map No. 35-54	
Sheet 1	Sheet 2
PROJECT: Aubrey Dam Site No. 1	
LOCATION: X = 2,140,180; Y = 612,640	
DATE: FALLING 1950	
DRAWN BY: Corps of Engineers	
CHECKED BY: [Signature]	
SCALE: 1" = 20.0'	
ELEVATION OF GROUND SURFACE: 552.70	
ELEVATION OF BOTTOM: 0.5'	
TOTAL DEPTH OF BORE: 46.5'	
REMARKS: See Note 1 under "Remarks"	
DEPTH	DESCRIPTION
0.0'	3" Shelby tube
0.0'-32.0'	Samples from 0.0'-32.0'
	Drilling fluid was utilized from the ground surface down
	WEAR SAMPLES
1. 0.0'-2.0'	
2. 4.0'-6.0'	
3. 8.0'-10.0'	
4. 12.0'-14.0'	
5. 16.0'-18.0'	
6. 20.0'-22.0'	
	JAR SAMPLES
1. 2.0'-4.0'	
2. 4.0'-8.0'	
3. 10.0'-12.0'	
4. 14.0'-16.0'	
5. 18.0'-20.0'	
6. 22.0'-24.0'	
7. 24.0'-26.0'	
8. 26.0'-28.0'	
9. 40.0'-40.5'	
	Note 1: Soils logged by: A. J. Simpson, Trinity Engineering Testing Corporation
	Note 2: Drilling fluid was utilized in advancing the boring from the ground surface down.

Map No. 35-55	
Sheet 1	Sheet 2
PROJECT: Aubrey Dam Site No. 1	
LOCATION: X = 2,140,180; Y = 612,640	
DATE: FALLING 1950	
DRAWN BY: Corps of Engineers	
CHECKED BY: [Signature]	
SCALE: 1" = 20.0'	
ELEVATION OF GROUND SURFACE: 552.70	
ELEVATION OF BOTTOM: 0.5'	
TOTAL DEPTH OF BORE: 46.5'	
REMARKS: See Note 1 under "Remarks"	
DEPTH	DESCRIPTION
0.0'	3" Shelby tube
0.0'-32.0'	Samples from 0.0'-32.0'
	Boring was advanced to 20.0' prior to using drilling fluid
	WRAP SAMPLES
1. 0.0'-2.0'	
2. 4.0'-6.0'	
3. 8.0'-10.0'	
4. 12.0'-14.0'	
5. 16.0'-18.0'	
6. 20.0'-22.0'	
7. 24.0'-26.0'	
8. 28.0'-30.0'	
	JAR SAMPLES
1. 2.0'-4.0'	
2. 4.0'-8.0'	
3. 10.0'-12.0'	
4. 14.0'-16.0'	
5. 18.0'-20.0'	
6. 22.0'-24.0'	
7. 26.0'-28.0'	
8. 30.0'-32.0'	
	Note 1: Soils logged by: A. J. Simpson, Trinity Engineering Testing Corporation
	Note 2: Boring was advanced to 20.0 feet below the ground surface prior to using drilling fluid and ground-water was not encountered above that depth.

Map No. 35-56	
Sheet 1	Sheet 2
PROJECT: Aubrey Dam Site No. 1	
LOCATION: X = 2,141,190; Y = 612,640	
DATE: FALLING 1950	
DRAWN BY: Corps of Engineers	
CHECKED BY: [Signature]	
SCALE: 1" = 20.0'	
ELEVATION OF GROUND SURFACE: 552.70	
ELEVATION OF BOTTOM: 0.5'	
TOTAL DEPTH OF BORE: 43.0'	
REMARKS: See Note 1 under "Remarks"	
DEPTH	DESCRIPTION
0.0'	3" Shelby tube
0.0'-30.0'	Samples from 0.0'-30.0'
	Drilled out and took Shelby tube samples 10.0'-43.0'
	WRAP SAMPLES
1. 0.0'-2.0'	
2. 4.0'-6.0'	
3. 6.0'-8.0'	
4. 10.0'-12.0'	
5. 12.0'-14.0'	
6. 14.0'-16.0'	
7. 16.0'-18.0'	
8. 18.0'-20.0'	
9. 20.0'-22.0'	
10. 22.0'-24.0'	
11. 26.0'-28.0'	
12. 28.0'-30.0'	
	JAR SAMPLES
1. 2.0'-4.0'	
2. 4.0'-8.0'	
3. 8.0'-10.0'	
4. 12.0'-14.0'	
5. 16.0'-18.0'	
6. 20.0'-22.0'	
7. 24.0'-26.0'	
8. 28.0'-30.0'	
9. 34.0'-36.0'	
10. 38.0'-39.0'	
11. 41.0'-43.0'	
	Note 1: Soils logged by: A. J. Simpson, Trinity Engineering Testing Corporation
	STANDARD PENETRATION VALUES
	Blows
	Depth Per Foot
	10.0-31.5 15
	18.0-19.5 33
	Note 2: Boring was advanced to 30.0 feet below the ground surface prior to using drilling fluid and ground-water was not encountered above that depth.

RECORD DRAWING-WORK AS BUILT

REV	NO	ACTION	DATE	DESCRIPTION OF REVISION
U.S. ARMY ENGINEER DISTRICT, FORT WORTH CORPS OF ENGINEERS FORT WORTH, TEXAS				
DESIGNED BY:	RAY ROBERTS LAKE			
DRAWN BY:	ELM FORK, TRINITY RIVER, TEXAS			
REVIEWED BY:	EMBANKMENT, SPILLWAY AND			
	OUTLET WORKS			
	LOGS OF BORINGS			
	3S-52, 3S-53, 3S-54, 3S-55 AND 3S-56			
SUBMITTED BY:	INVITATION NO. DACW63-82B-0023	DATE:	MAR, 1982	
ENGINEER:	CONTRACT NO. DACW63-72-C-0073	SHEET NO.	23	
	DRAWING NUMBER			

TO ACCOMPANY FOUNDATION REPORT

DRILLING LOG		Southwestern		Fort Worth		No. 1	
Aubrey Dam Site No. 1		MSL		MSL		MSL	
X 2, 14, 31, Y 412, 449		Falling 1500		3-13-73		3-13-73	
Elevation of top of hole 549.5		Elevation of top of hole 549.5		Elevation of top of hole 549.5		Elevation of top of hole 549.5	
Elevation of bottom of hole 526.5		Elevation of bottom of hole 526.5		Elevation of bottom of hole 526.5		Elevation of bottom of hole 526.5	
Total depth of hole 30.0		Total depth of hole 30.0		Total depth of hole 30.0		Total depth of hole 30.0	
Classification of materials		Classification of materials		Classification of materials		Classification of materials	
1-2	Gray Clay	7.0'	W1	3" Shelby tube	1. 0.0'-2.0'	W1	3" Shelby tube
3-4	Gray Clay	2.0'	W2	Samples from 0.0'-22.0'	2. 2.0'-4.0'	W2	Samples from 0.0'-22.0'
5-6	Gray Clay	2.0'	W3	Standard Penetration Values	3. 4.0'-6.0'	W3	Standard Penetration Values
7-8	Brown Clay w/Calcareous Particles	16.5'	W4	No. Blows Per Foot	4. 6.0'-8.0'	W4	No. Blows Per Foot
9-10	Brown Clay w/Calcareous Particles	16.5'	W5	22.0-23.5	5. 8.0'-10.0'	W5	22.0-23.5
11-12	Tan Sandy Clay	20.0'	W6	Wrap Samples	6. 10.0'-12.0'	W6	Wrap Samples
13-14	Tan Sandy Clay	20.0'	W7	1. 0.0'-2.0'	7. 12.0'-14.0'	W7	1. 0.0'-2.0'
15-16	Tan Sandy Clay	20.0'	W8	2. 2.0'-4.0'	8. 14.0'-16.0'	W8	2. 2.0'-4.0'
17-18	Tan Sandy Clay	20.0'	W9	3. 4.0'-6.0'	9. 16.0'-18.0'	W9	3. 4.0'-6.0'
19-20	Tan Sandy Clay	20.0'	W10	4. 6.0'-8.0'	10. 18.0'-20.0'	W10	4. 6.0'-8.0'
21-22	Tan Sandy Clay	20.0'	W11	5. 8.0'-10.0'	11. 20.0'-22.0'	W11	5. 8.0'-10.0'
23-24	Tan Sand and Gravel	20.0'	W12	6. 10.0'-12.0'		W12	6. 10.0'-12.0'
25-26	Tan Sand and Gravel	20.0'	W13	7. 12.0'-14.0'		W13	7. 12.0'-14.0'
27-28	Gray Shale	30.0'	W14	8. 14.0'-16.0'		W14	8. 14.0'-16.0'
29-30	Gray Shale	30.0'	W15	9. 16.0'-18.0'		W15	9. 16.0'-18.0'
31-32	Gray Shale	30.0'	W16	10. 18.0'-20.0'		W16	10. 18.0'-20.0'
33-34	Gray Shale	30.0'	W17	11. 20.0'-22.0'		W17	11. 20.0'-22.0'
35-36	Gray Shale	30.0'	W18	12. 22.0'-24.0'		W18	12. 22.0'-24.0'
37-38	Gray Shale	30.0'	W19	13. 24.0'-26.0'		W19	13. 24.0'-26.0'
39-40	Gray Shale	30.0'	W20	14. 26.0'-28.0'		W20	14. 26.0'-28.0'
41-42	Gray Shale	30.0'	W21	15. 28.0'-30.0'		W21	15. 28.0'-30.0'
Total Depth = 30.0 Feet		Total Depth = 30.0 Feet		Total Depth = 30.0 Feet		Total Depth = 30.0 Feet	
Note 1: Soils Logged By: A. J. Simpson, Trinity Engineering Testing Corporation		Note 1: Soils Logged By: A. J. Simpson, Trinity Engineering Testing Corporation		Note 1: Soils Logged By: A. J. Simpson, Trinity Engineering Testing Corporation		Note 1: Soils Logged By: A. J. Simpson, Trinity Engineering Testing Corporation	
Note 2: Boring was advanced to 22.0 feet below the ground surface prior to using drilling fluid and groundwater was not encountered above that depth.		Note 2: Boring was advanced to 22.0 feet below the ground surface prior to using drilling fluid and groundwater was not encountered above that depth.		Note 2: Boring was advanced to 22.0 feet below the ground surface prior to using drilling fluid and groundwater was not encountered above that depth.		Note 2: Boring was advanced to 22.0 feet below the ground surface prior to using drilling fluid and groundwater was not encountered above that depth.	

DRILLING LOG		Southwestern		Fort Worth		No. 1	
Aubrey Dam Site No. 1		MSL		MSL		MSL	
X 2, 130, 371, Y 612, 721, Sta. 1825		DAMCO Model 1250		DAMCO Model 1250		DAMCO Model 1250	
Elevation of top of hole 627.0		Elevation of top of hole 627.0		Elevation of top of hole 627.0		Elevation of top of hole 627.0	
Elevation of bottom of hole 561.0		Elevation of bottom of hole 561.0		Elevation of bottom of hole 561.0		Elevation of bottom of hole 561.0	
Total depth of hole 70.0		Total depth of hole 70.0		Total depth of hole 70.0		Total depth of hole 70.0	
Classification of materials		Classification of materials		Classification of materials		Classification of materials	
1-2	Dark Brown Clay w/ Scattered Gravel	4.0'	100 W1	3" Shelby tube	1. 2.0'-3.0'	100 W1	3" Shelby tube
3-4	Dark Brown Clay w/ Scattered Gravel	4.0'	100 W2	Samples 0.0'-21.0'	2. 4.0'-7.0'	100 W2	Samples 0.0'-21.0'
5-6	Dark Brown Clay w/ Scattered Gravel	4.0'	100 W3	JAR SAMPLES	3. 6.0'-11.0'	100 W3	JAR SAMPLES
7-8	Dark Brown Clay w/ Scattered Gravel	4.0'	100 W4	1. 2.0'-3.0'	4. 14.0'-15.0'	100 W4	1. 2.0'-3.0'
9-10	Dark Brown Clay w/ Scattered Gravel	4.0'	100 W5	2. 4.0'-7.0'	5. 18.0'-19.0'	100 W5	2. 4.0'-7.0'
11-12	Dark Brown Clay w/ Scattered Gravel	4.0'	100 W6	3. 6.0'-11.0'		100 W6	3. 6.0'-11.0'
13-14	Dark Brown Clay w/ Scattered Gravel	4.0'	100 W7	4. 14.0'-15.0'		100 W7	4. 14.0'-15.0'
15-16	Dark Brown Clay w/ Scattered Gravel	4.0'	100 W8	5. 18.0'-19.0'		100 W8	5. 18.0'-19.0'
17-18	Dark Brown Clay w/ Scattered Gravel	4.0'	100 W9			100 W9	
19-20	Dark Brown Clay w/ Scattered Gravel	4.0'	100 W10			100 W10	
21-22	Dark Brown Clay w/ Scattered Gravel	4.0'	100 W11			100 W11	
23-24	Dark Brown Clay w/ Scattered Gravel	4.0'	100 W12			100 W12	
25-26	Dark Brown Clay w/ Scattered Gravel	4.0'	100 W13			100 W13	
27-28	Dark Brown Clay w/ Scattered Gravel	4.0'	100 W14			100 W14	
29-30	Dark Brown Clay w/ Scattered Gravel	4.0'	100 W15			100 W15	
31-32	Dark Brown Clay w/ Scattered Gravel	4.0'	100 W16			100 W16	
33-34	Dark Brown Clay w/ Scattered Gravel	4.0'	100 W17			100 W17	
35-36	Dark Brown Clay w/ Scattered Gravel	4.0'	100 W18			100 W18	
37-38	Dark Brown Clay w/ Scattered Gravel	4.0'	100 W19			100 W19	
39-40	Dark Brown Clay w/ Scattered Gravel	4.0'	100 W20			100 W20	
41-42	Dark Brown Clay w/ Scattered Gravel	4.0'	100 W21			100 W21	
43-44	Dark Brown Clay w/ Scattered Gravel	4.0'	100 W22			100 W22	
45-46	Dark Brown Clay w/ Scattered Gravel	4.0'	100 W23			100 W23	
47-48	Dark Brown Clay w/ Scattered Gravel	4.0'	100 W24			100 W24	
49-50	Dark Brown Clay w/ Scattered Gravel	4.0'	100 W25			100 W25	
51-52	Dark Brown Clay w/ Scattered Gravel	4.0'	100 W26			100 W26	
53-54	Dark Brown Clay w/ Scattered Gravel	4.0'	100 W27			100 W27	
55-56	Dark Brown Clay w/ Scattered Gravel	4.0'	100 W28			100 W28	
57-58	Dark Brown Clay w/ Scattered Gravel	4.0'	100 W29			100 W29	
59-60	Dark Brown Clay w/ Scattered Gravel	4.0'	100 W30			100 W30	
61-62	Dark Brown Clay w/ Scattered Gravel	4.0'	100 W31			100 W31	
63-64	Dark Brown Clay w/ Scattered Gravel	4.0'	100 W32			100 W32	
65-66	Dark Brown Clay w/ Scattered Gravel	4.0'	100 W33			100 W33	
67-68	Dark Brown Clay w/ Scattered Gravel	4.0'	100 W34			100 W34	
69-70	Dark Brown Clay w/ Scattered Gravel	4.0'	100 W35			100 W35	
Total Depth = 70.0 Feet		Total Depth = 70.0 Feet		Total Depth = 70.0 Feet		Total Depth = 70.0 Feet	
Note 1: Soils logged by: A. J. Simpson, Trinity Engineering Testing Corporation		Note 1: Soils logged by: A. J. Simpson, Trinity Engineering Testing Corporation		Note 1: Soils logged by: A. J. Simpson, Trinity Engineering Testing Corporation		Note 1: Soils logged by: A. J. Simpson, Trinity Engineering Testing Corporation	
Note 2: Boring was advanced to 22.0 feet below the ground surface prior to using drilling fluid and groundwater was not encountered above that depth.		Note 2: Boring was advanced to 22.0 feet below the ground surface prior to using drilling fluid and groundwater was not encountered above that depth.		Note 2: Boring was advanced to 22.0 feet below the ground surface prior to using drilling fluid and groundwater was not encountered above that depth.		Note 2: Boring was advanced to 22.0 feet below the ground surface prior to using drilling fluid and groundwater was not encountered above that depth.	
Note 3: Installed 2" plastic pipe from 631.8 to 610.5 for groundwater observations.		Note 3: Installed 2" plastic pipe from 631.8 to 610.5 for groundwater observations.		Note 3: Installed 2" plastic pipe from 631.8 to 610.5 for groundwater observations.		Note 3: Installed 2" plastic pipe from 631.8 to 610.5 for groundwater observations.	

DRILLING LOG		Southwestern		Fort Worth		No. 1	
Aubrey Dam Site No. 1		MSL		MSL		MSL	
X 2, 129, 243, Y 612, 721, Sta. 1825		DAMCO Model 1250		DAMCO Model 1250		DAMCO Model 1250	
Elevation of top of hole 646.51		Elevation of top of hole 646.51		Elevation of top of hole 646.51		Elevation of top of hole 646.51	
Elevation of bottom of hole 627.01		Elevation of bottom of hole 627.01		Elevation of bottom of hole 627.01		Elevation of bottom of hole 627.01	
Total depth of hole 19.50		Total depth of hole 19.50		Total depth of hole 19.50		Total depth of hole 19.50	
Classification of materials		Classification of materials		Classification of materials		Classification of materials	
1-2	Dark Brown Clay w/ Scattered Gravel	4.0'	100 W1	3" Shelby tube	1. 2.0'-3.0'	100 W1	3" Shelby tube
3-4	Dark Brown Clay w/ Scattered Gravel	4.0'	100 W2	Samples 0.0'-21.0'	2. 4.0'-7.0'	100 W2	Samples 0.0'-21.0'
5-6	Dark Brown Clay w/ Scattered Gravel	4.0'	100 W3	JAR SAMPLES	3. 6.0'-11.0'	100 W3	JAR SAMPLES
7-8	Dark Brown Clay w/ Scattered Gravel	4.0'	100 W4	1. 2.0'-3.0'	4. 14.0'-15.0'	100 W4	1. 2.0'-3.0'
9-10	Dark Brown Clay w/ Scattered Gravel	4.0'	100 W5	2. 4.0'-7.0'	5. 18.0'-19.0'	100 W5	2. 4.0'-7.0'
11-12	Dark Brown Clay w/ Scattered Gravel	4.0'	100 W6	3. 6.0'-11.0'		100 W6	3. 6.0'-11.0'
13-14	Dark Brown Clay w/ Scattered Gravel	4.0'	100 W7	4. 14.0'-15.0'		100 W7	4. 14.0'-15.0'
15-16	Dark Brown Clay w/ Scattered Gravel	4.0'	100 W8	5. 18.0'-19.0'		100 W8	5. 18.0'-19.0'
17-18	Dark Brown Clay w/ Scattered Gravel	4.0'	100 W9			100 W9	
19-20	Dark Brown Clay w/ Scattered Gravel	4.0'	100 W10			100 W10	
21-22	Dark Brown Clay w/ Scattered Gravel	4.0'	100 W11			100 W11	
23-24	Dark Brown Clay w/ Scattered Gravel	4.0'	100 W12			100 W12	
25-26	Dark Brown Clay w/ Scattered Gravel	4.0'	100 W13			100 W13	
27-28	Dark Brown Clay w/ Scattered Gravel	4.0'	100 W14			100 W14	
29-30	Dark Brown Clay w/ Scattered Gravel	4.0'	100 W15			100 W15	
31-32	Dark Brown Clay w/ Scattered Gravel	4.0'	100 W16			100 W16	
33-34	Dark Brown Clay w/ Scattered Gravel	4.0'	100 W17			100 W17	
35-36	Dark Brown Clay w/ Scattered Gravel	4.0'	100 W18			100 W18	
37-38	Dark Brown Clay w/ Scattered Gravel	4.0'	100 W19			100 W19	
39-40	Dark Brown Clay w/ Scattered Gravel	4.0'	100 W20			100 W20	
41-42	Dark Brown Clay w/ Scattered Gravel	4.0'	100 W21			100 W21	
43-44	Dark Brown Clay w/ Scattered Gravel	4.0'	100 W22			100 W22	
45-46	Dark Brown Clay w/ Scattered Gravel	4.0'	100 W23			100 W23	
47-48	Dark Brown Clay w/ Scattered Gravel	4.0'	100 W24			100 W24	
49-50	Dark Brown Clay w/ Scattered Gravel	4.0'	100 W25			100 W25	
51-52	Dark Brown Clay w/ Scattered Gravel	4.0'	100 W26			100 W26	
53-54	Dark Brown Clay w/ Scattered Gravel	4.0'	100 W27			100 W27	
55-56	Dark Brown Clay w/ Scattered Gravel	4.0'	100 W28			100 W28	
57-58	Dark Brown Clay w/ Scattered Gravel	4.0'	100 W29			100 W29	
59-60	Dark Brown Clay w/ Scattered Gravel	4.0'	100 W30			100 W30	
61-62	Dark Brown Clay w/ Scattered Gravel	4.0'	100 W31			100 W31	
63-64	Dark Brown Clay w/ Scattered Gravel	4.0'	100 W32			100 W32	
65-66	Dark Brown Clay w/ Scattered Gravel	4.0'	100 W33			100 W33	
67-68	Dark Brown Clay w/ Scattered Gravel	4.0'	100 W34			100 W34	
69-70	Dark Brown Clay w/ Scattered Gravel	4.0'	100 W35			100 W35	
Total Depth = 19.50 Feet		Total Depth = 19.50 Feet		Total Depth = 19.50 Feet		Total Depth = 19.50 Feet	
Note 1: Soils logged by: A. J. Simpson, Trinity Engineering Testing Corporation		Note 1: Soils logged by: A. J. Simpson, Trinity Engineering Testing Corporation		Note 1: Soils logged by: A. J. Simpson, Trinity Engineering Testing Corporation		Note 1: Soils logged by: A. J. Simpson, Trinity Engineering Testing Corporation	
Note 2: Boring was advanced to 22.0 feet below the ground surface prior to using drilling fluid and groundwater was not encountered above that depth.		Note 2: Boring was advanced to 22.0 feet below the ground surface prior to using drilling fluid and groundwater was not encountered above that depth.		Note 2: Boring was advanced to 22.0 feet below the ground surface prior to using drilling fluid and groundwater was not encountered above that depth.		Note 2: Boring was advanced to 22.0 feet below the ground surface prior to using drilling fluid and groundwater was not encountered above that depth.	

Well Worth		Notes	
DATE	NO.	DATE	NO.
11-15-73	334C-58		
PROJECT Aubrey Dam Site No. 1 LOCATION X-2, 132, 897, Y-612, 127, S-4374.71 CLIENT DAMCO Model 1150 ENGINEER Trinity Engineering Testing Corporation DATE 11-15-73 DEPTH 73.5 REMARKS See Note 1 under "Remarks"			
DEPTH	DIAGRAM	DESCRIPTION	REMARKS
100	WI	3" Shelby tube samples 0.0'-21.0'	
100	WI	JAR SAMPLES	
100	WI	1. 2.0'-3.0'	
100	WI	2. 6.0'-7.0'	
100	WI	3. 10.0'-11.0'	
100	WI	4. 14.0'-15.0'	
100	WI	5. 18.0'-19.0'	
100	WI	BAG SAMPLES	
100	WI	1. 4.0'-5.0'	
100	WI	2. 8.0'-9.0'	
100	WI	3. 16.0'-17.0'	
100	WI	WRAP SAMPLES	
100	WI	1. 0.0'-1.0'	
100	WI	2. 1.0'-2.0'	
100	WI	3. 3.0'-4.0'	
100	WI	4. 5.0'-6.0'	
100	WI	5. 7.0'-8.0'	
100	WI	6. 9.0'-10.0'	
100	WI	7. 11.0'-12.0'	
100	WI	8. 12.0'-13.0'	
100	WI	9. 13.0'-14.0'	
100	WI	10. 15.0'-16.0'	
100	WI	11. 17.0'-18.0'	
100	WI	12. 19.0'-20.0'	
100	WI	13. 20.0'-21.0'	
R-1	Box 1	Cleaned out hole at 21.0' and set casing to 21.0'.	
R-2	Box 2	Started coring with 4" core barrel at 21.0'.	
R-3	Box 3		
R-4	Box 4		
R-5	Box 5		
R-291	Box 291		
R-292			

File No 354C-62

DRILLING LOC. SOUTHWESTERN		INSTALLATION FT. WORTH DIST.		SHEET OF 3 SHEETS	
PROJECT AUBREY DAM SITE # 1		NO. SIZE AND TYPE OF BIT 2" CORE		NO. OF CORES 1X CORE	
LOCATION (Name of State) TX - 198-103		DATE OF TEST, ELEVATION TO WHICH TESTED M.S.L.			
DRILLING AGENCY USCE		MANUFACTURER'S DESIGNATION OF DRILL DAMCO 1250			
HOLE NO. (As shown on drawing sheet) 354C-62		TOTAL NO. OF OVER BURDEN SAMPLES TAKEN 15			
NAME OF DRILLER TRINITY ENGE TESTING CORP.		ELEVATION GROUND WATER			
DIRECTION OF HOLE <input checked="" type="checkbox"/> VERTICAL <input type="checkbox"/> INCLINED		DATE MOLE STARTED 9/27/73 COMPLETED 9/28/73			
THICKNESS OF OVERBURDEN 0		ELEVATION TOP OF HOLE 652.0 653.35			
DEPTH DRILLED INTO ROCK 120.0		TOTAL CORE RECOVERY FOR BORING 95%			
TOTAL DEPTH OF HOLE 120.0		SIGNATURE OF INSPECTOR Van Man			

ELEVATION	DEPTH	LEGEND	CLASSIFICATION OF MATERIALS (Description)	NO. OF CORE RECOVERED	REMARKS (During run, notes on loss, depth of weathering, etc., if significant)
0.0 - 35.5'			SAND & SANDSTONE POORLY CEMENTED BUT TIGHT, MED-COARSE GRN, RED, TAN, AND GRAY, SCATT GRAVELS		DRILLING 3" SHELBY TUBE 0.0 - 3.0' FISH-TAIL BIT 3.0 - 16.0' 1X-CORE BBL 16.0 - 19.0 (no rec'd) 2 1/2" ROCK BIT 19.0 - 24.0' 6" ROCK-BIT 24.0 - 30.0' 4" CORE-BBL 30.0 - 35.5' (no rec'd) 4" CORE-BBL 35.5 - 108' 1X CORE BBL 108 - 120'
35.5 - 50.0'			SAND & SANDSTONE MED.-COARSE GRN, SOFT, V. POORLY CEMENTED, GRAVELLY, TAN & GRAY		SAMPLES JAP 1: 2.0-2.5' 2: 3.0-3.5 3: 10.0-11.0 4: 29.0-30.0 5: 35.5-36.0
50.0 - 51.5'			SAND & GRAVEL 3" FINE TAN, MED-COARSE GRN SAND, LOOSELY CONS, TAN & COOL		SAMPLES (cont'd) CARTON 1: 46.5-47.5' 2: 52.5-53.5 3: 57.4-58.2 4: 62.8-63.7 5: 67.3-69.2 6: 72.3-73.2 7: 78.3-79.2 8: 81.9-82.8 9: 88.7-89.6 10: 93.1-95.0 11: 96.5-97.4 12: 112.4-113.5 13: 116.1-117.1
51.5 - 57.5'			SANDSTONE, HARD WEATH. CONCRETE, SOFT-MOD HARD TAN & BROWN		
57.5 - 58.0'			SHALE, HARD, SIL. SANDY, DK. GRAY		
58.0 - 57.5'			SANDSTONE, GRAY, MOD. HARD, FINE-MED. GRN.		
57.5 - 57.5'			SILTSTONE, HARD, TAN		
57.5 - 81.0'			SANDSTONE, SHALY, LIGHTING, GRAY TO DK. GRAY, SOFT-MOD. HARD, MASSIVE, FINE-MED. GRN, OCCAS SILTSTONE NOS.		WATER LEVEL AFTER 36 HOURS WAS 65.6' NOTE: HOLE WAS PRESSURE TESTED

ELEVATION	DEPTH	LEGEND	CLASSIFICATION OF MATERIALS (Description)	NO. OF CORE RECOVERED	NO. OF SAMPLES	REMARKS (During run, notes on loss, depth of weathering, etc., if significant)
70						
80			91.0-91.5 LIMESTONE NODULES HARD, GRAY 91.5-106.0' SHALE, MOD HARD, CALC, MASSIVE, GRAY			
90						
100						
110			111.0-120.0 SHALE, MOD HARD, DARK GRAY TO BLACK, MASSIVE, SCATT FOSS. ZONES			
120			119.5-120.0 VERY FOSSILIFEROUS			

ENG FORM 1836 MAR 71 PREVIOUS EDITIONS ARE OBSOLETE. PROJECT AUBREY DAM SITE # 1

CLASSIFICATION OF MATERIALS (Overburden)	1 CORE RECOVERY LAY	2 CORE SAMPLE NO.	REMARKS (Depth, core, water loss, depth of weathering, etc., if significant)
91.0-91.5 Limestonic nodules HARD, GRAY			
91.5-106.0 SHALE, MOD. HARD, CALD, MASSIVE, GRAY			
106.0-111.0 LIMESTONE, HARD, MASSIVE TO NODULAR, FOSSILIFEROUS, GRAY			
111.0-120.0 SHALE, MOD. HARD, DARK GRAY TO BLACK, MASSIVE, SCAT. FOSS. ZONES			
119.5-120.0 VERY FOSSILIFEROUS			
NOTES ARE OBSOLETE.			
PROJECT AUBREY DAM SITE #1		HOLE NO. 354C-62	

Hole No. 816D-64

DRILLING LOG		DIVISION	INSTALLATION	SHEET 1 OF 2 SHEETS		
PROJECT Aubrey Dam Site		Southwestern	Fort Worth			
LOCATION (Coordinates of Bureau)		10 SITE AND TYPE OF BIT 8" Siger, 6" d, 3" fishtail				
DRILLING AGENCY Corps of Engineers		11 MANUFACTURER'S DESIGNATION OF DRILL Falling 1500				
HOLE NO. (As shown on drawing title) 816D-64		12 TOTAL NO. OF OVERBURDEN SAMPLES TAKEN 5				
NAME OF DRILLER Newhouse		13 TOTAL NUMBER CORE BORES --				
DIRECTION OF HOLE <input checked="" type="checkbox"/> VERTICAL <input type="checkbox"/> INCLINED DEG. FROM VERT.		14 ELEVATION GROUND WATER				
THICKNESS OF OVERBURDEN 44.0		15 DATE HOLE STARTED 9 April 73 COMPLETED 11 April 73				
DEPTH DRILLED INTO ROCK 57.0		16 ELEVATION TOP OF HOLE				
TOTAL DEPTH OF HOLE 101.0		17 TOTAL CORE RECOVERY FOR SPRING				
SIGNATURE OF INSPECTOR		18 SIGNATURE OF INSPECTOR				
ELEVATION	DEPTH	LEGEND	CLASSIFICATION OF MATERIALS (Description)	1 CORE RECOVERY LAY	2 CORE SAMPLE NO.	REMARKS (Drilling time, water loss, depth of weathering, etc., if significant)
0.0'	to 24.0'		CLAY - 0.0 to 4.0 - calc., moist, stiff, brown. 4.0 to 14.0 - calc., sandy, moist, stiff, brown. 14.0 to 19.0 - calc., scattered gravel, moist, stiff, brown. 19.0 to 24.0 - calc., moist, stiff, gray and tan.			1. Water level not determined. 2. Jars: A. 26.0 B. 28.0 C. 36.0 D. 38.0 E. 38.6 NOTE: All jar samples taken from shoe and catcher of denison sampler. 3. Denison cans: 1. 24.0 to 26.0 2. 34.0 to 36.0 3. 36.0 to 38.0 4. Hole squeezing badly at 27.0'. 4" plastic pipe set to 45.0'. Another offset from 6DC-30, Hole 816D-64A, will be drilled to obtain denison samples from 26.0 to 34.0. Offset bearings and elevations will be furnished after completion.
24.0'	to 26.0'		CLAY, calc., moist, stiff, gray and tan.			5. Drilling: 0.0' to 24.0' - 8" siger - no sample taken. 24.0' to 38.6' - 6" d. bb'1. 38.6' to 101.0' - 3" fishtail.
26.0'	to 34.0'		NO RECOVERY -			6. Identification of materials from 38.6' to 101' based on cuttings and drill action.
34.0'	to 37.3'		CLAY, sandy, moist, med. stiff, gray and tan.		Can 1	
37.3'	to 38.6'		SAND, gravelly, clayey, saturated, med. dense, tan.		Can 2	
38.6'	to 44.0'		SAND and GRAVEL, med. dense. - Drilled into primary material at 44.0'		Can 3	
44.0'	to 101.0'		SHALE, soft to m. hard w/LIMESTONE from 86.5' to 89.6'.			7. 2" log from 45' to 101'
			T.D. - 101.0'		101.0	

DRILLING LOG
PROJECT Aubrey Dam Site
LOCATION (Coordinates of Bureau)
DRILLING AGENCY Corps of Eng
HOLE NO. (As shown on drawing title)
NAME OF DRILLER Newhouse
DIRECTION OF HOLE <input checked="" type="checkbox"/> VERTICAL <input type="checkbox"/> INCLIN
THICKNESS OF OVERBURDEN
DEPTH DRILLED INTO ROCK
TOTAL DEPTH OF HOLE
ELEVATION
DEPTH
LEGEND

ENG FORM 1836 PREVIOUS EDITIONS OBSOLETE

Hole No. 8A6D-64

Division Southwestern	INSTALLATION Fort Worth	SHEET 1 of 2 SHEETS
PROJECT Aubrey Dam Site	10 SIZE AND TYPE OF BIT 8" auger, 6" d. bb'l. 11 DATUM FOR ELEVATION INDUSTRIAL W.L.	11 MANUFACTURER'S DESIGNATION OF DRILL Falling 1500
ENGINEERS Corps of Engineers	12 TOTAL NO. OF OVER- BORDEN SAMPLES TAKEN 5	13 TOTAL NUMBER CORE BORES ---
DATE 8A6D-64	14 ELEVATION GROUND WATER ----	14 DATE MOLE STARTED 9 April 73 COMPLETED 11 April 73
DEPTH 57.0	15 SIGNATURE OF INSPECTOR <i>James A. Christie</i>	15 SIGNATURE OF INSPECTOR <i>James A. Christie</i>

ELEVATION	DEPTH	LEGEND	CLASSIFICATION OF MATERIALS (Description)	REMARKS (Overlying soil, water table, depth of underlying, etc., if significant)
0.0' to 24.0'			CLAY - - - 0.0 to 4.0 - calc., moist, stiff, brown. 4.0 to 14.0 - calc., sandy, moist, stiff, brown. 14.0 to 19.0 - calc., scattered gravel, moist, stiff, brown. 19.0 to 24.0 - calc., moist, stiff, gray and tan. -- Start 6" d. bb'l. at 24.0'	1. Water level not determined. 2. Jars: A. 26.0 B. 28.0 C. 36.0 D. 38.0 E. 38.6 NOTE: All jar samples taken from shoe and catcher of denison sampler. 3. Denison cans: 1. 24.0 to 26.0 2. 34.0 to 36.0 3. 36.0 to 38.0 4. Hole squeezing badly at 27.0'. 4" plastic pipe set to 45.0'. Another offset from 60-30, Hole 8A6D-64A, will be drilled to obtain denison samples from 26.0 to 34.0. Offset bearings and elevations will be furnished after completion.
24.0' to 26.0'			CLAY, calc., moist, stiff, gray and tan.	
26.0' to 34.0'			NO RECOVERY -	
34.0' to 37.3'			CLAY, sandy, moist, med. stiff, gray and tan.	
37.3' to 38.6'		Can 1	SAND, gravelly, clayey, saturated, med. dense, tan. -- Refusal w/d. bb'l. at 38.6' - Start 3" fish- tail at 38.6' - - -	5. Drilling: 0.0' to 24.0' - 8" auger - no sample taken. 24.0' to 38.6' - 6" d. bb'l. 38.6' to 101.0' - fishtail.
38.6' to 44.0'		Can 2 Can 3	SAND and GRAVEL, med. dense. -- Drilled into primary material at 44.0'	6. Identification of materials from 38. to 101' based on cuttings and drill action.
44.0' to 101.0'			SHALE, soft to m. hard w/LIMESTONE from 86.5' to 89.6'. T.D. - 101.0'	7. 7" log from 45' to 101'

Hole No. 8A6D-64A

Division Southwestern	INSTALLATION Fort Worth	SHEET 1 of 1 SHEETS
PROJECT Aubrey Dam Site	10 SIZE AND TYPE OF BIT 8" auger, 6" d. bb'l. 11 DATUM FOR ELEVATION INDUSTRIAL W.L.	11 MANUFACTURER'S DESIGNATION OF DRILL Falling 1500
ENGINEERS Corps of Engineers	12 TOTAL NO. OF OVER- BORDEN SAMPLES TAKEN 6	13 TOTAL NUMBER CORE BORES ---
DATE 8A6D-64A	14 ELEVATION GROUND WATER ----	14 DATE MOLE STARTED 11 Apr 73 COMPLETED 11 Apr 73
DEPTH 36.0	15 SIGNATURE OF INSPECTOR <i>James A. Christie</i>	15 SIGNATURE OF INSPECTOR <i>James A. Christie</i>

ELEVATION	DEPTH	LEGEND	CLASSIFICATION OF MATERIALS (Description)	REMARKS (Overlying soil, water table, depth of underlying, etc., if significant)
0.0' to 24.0'			CLAY, calc., moist, stiff, brown to gray and tan. -- Start 6" d. bb'l. at 24.0'	1. Water table not determined. 2. Jars: A. 26.0 B. 28.0 C. 30.0 D. 32.0 E. 34.0 F. 36.0 NOTE: Jar samples take from shoe of denison bb'l. 3. Denison Cans: 1. 24.0 to 26.0 2. 26.0 to 28.0 3. 28.0 to 30.0 4. 30.0 to 32.0 5. 32.0 to 34.0 6. 34.0 to 36.0 4. Drilling: 1. 0.0' to 24.0' - 8" auger 2. 24.0' to 36.0' - 6" d. bb'l.
24.0' to 34.0'			CLAY, calc., moist, med. stiff to stiff, sandy to 32.0' with sand increase at 32.0', tan and gray.	
34.0' to 36.0'			SAND, sil. clayey, med. dense, saturated, medium to coarse grained, tan. T.D. - 36.0'	

RECORD DRAWING-WORK AS BUILT

SYMBOL NO.	ACTION	DATE	DESCRIPTION OF REVISION
U.S. ARMY ENGINEER DISTRICT, FORT WORTH CORPS OF ENGINEERS FORT WORTH, TEXAS			
DESIGNED BY	RAY ROBERTS LAKE ELM FORK, TRINITY RIVER, TEXAS EMBANKMENT, SPILLWAY AND OUTLET WORKS LOGS OF BORINGS 3S4C-62, 3A6D-64, AND 8A6D-64A		
DRAWN BY			
REVIEWED BY			
SUBMITTED BY			
ENGINEER	INVITATION NO. DACW63-02-B-0025	DATE MAR. 1962	SEQUENCE NO. 25
	CONTRACT NO. DACW63-52-C-0093	DRAWING NUMBER	SHEET NO. OF

TO ACCOMPANY FOUNDATION REPORT

UNIFORM NO. DACW63-52-C-0093

ELEVATION	DEPTH	LEGEND	CLASSIFICATION OF MATERIALS (See Appendix)	COLE RECOVERY	BOX OR SAMPLE NO.	REMARKS (Drilling time, water level, depth of weathering, etc., if significant)
35.5	30.2		SAND dk. gray, gravelly, mod to coarse gr, mod dense, calc			
19.2	27.0		SHALE dk. gray, mod hard (rock classification unvec, non-jointed, sl. calc 43.2 - 50.0 signific- antly higher to fis- tall.			
87.0 - 87.1			SILTSTONE hard, cemented, massive			
87.1 - 90.2			LIMESTONE lt. gray, soft (rock classification), massive			
87.1 - 88.9			SHALE dk. gray, mod hard, non-jointed	05.0		
90.2 - 97.1			SHALE	L18		
97.1 - 97.5			SILTSTONE hard, cemented, massive	05.5		
			TD @ 97.5	L11		

Hole No. 8A6D-66

DRILLING LOG		Division southwest TN	INSTALLATION Port North	SHEET of 1 sheets	
PROJECT Aubrey D.S.		10 HOLE NO. AND TYPE OF BIT 8" 2" COP, 6" d. bb'l.	11 DATE FOR TELEVISION-CORRECTED LOGS Falling 1900	12 MANUFACTURER'S IDENTIFICATION OF DRILL Falling 1900	
LOCATION (Community or Station)		13 DRILLING AGENCY Cooper of Engineers	14 TOTAL NO. OF OVER- BURDEN SAMPLES TAKEN 6	15 TOTAL NUMBER CORE BOXES 6	
HOLE NO. (See Appendix for marking rules and box number)		8A6D-66	16 DATE HOLE 2 April 73	17 ELEVATION TOP OF HOLE 3 April 73	
NAME OF DRILLER Newhouse		18 DIRECTION OF HOLE <input checked="" type="checkbox"/> VERTICAL <input type="checkbox"/> INCLINED	19 THICKNESS OF OVERBURDEN -	20 DEPTH DRILLED INTO ROCK -	
DIRECTION OF HOLE		21 TOTAL CORE RECOVERY FOR BORING 35.7	A CORE RECON- STRUCTION (Drilling time, water level, depth of weathering, etc., if significant)		
THICKNESS OF OVERBURDEN		22 ELEVATION OF GROUND WATER 23 DENISON CANS 24 POCKET PENETROMETER TESTS 25 NO. OF JAR SAMPLES TAKEN FROM 0.0 TO 22.0 26 CORRECTION TO DENISON CANS 27 TONNAGE OF DRILL MUD USED FROM 22.0			
TOTAL DEPTH OF HOLE 35.7		28 DENISON CANS 29 POCKET PENETROMETER TESTS 30 NO. OF JAR SAMPLES TAKEN FROM 0.0 TO 22.0 31 CORRECTION TO DENISON CANS 32 TONNAGE OF DRILL MUD USED FROM 22.0		33 DENISON CANS 34 POCKET PENETROMETER TESTS 35 NO. OF JAR SAMPLES TAKEN FROM 0.0 TO 22.0 36 CORRECTION TO DENISON CANS 37 TONNAGE OF DRILL MUD USED FROM 22.0	

ELEVATION	DEPTH	LEGEND	CLASSIFICATION OF MATERIALS (See Appendix)	COLE RECOVERY	BOX OR SAMPLE NO.	REMARKS (Drilling time, water level, depth of weathering, etc., if significant)
0.0	19.0		CLAY - 0.0 to 3.0 - sli. sandy medium to stiff, moist, brown. 3.0 to 16.0 - sandy to 16.0, very sandy from 16.0 to 19.0, stiff, moist, tan.			1. Elevation of ground water was not determined. 2. Jars: A. 24.0 B. 26.0 C. 28.0 D. 30.0 E. 32.0 F. 34.0 NOTE: All jar samples taken from Denison bb'l shoe.
19.0	21.0		SAND, sli. clayey, medium to coarse-grained, medium dense, moist, tan.			3. Denison Cans: 1. 22.0 to 24.0 2. 24.0 to 26.0 3. 26.0 to 28.0 4. 28.0 to 30.0 5. 30.0 to 32.0 6. 32.0 to 34.0
21.0	22.0		CLAY, sandy, medium stiff moist, tan.			4. Pocket penetrometer tests as follows: cm no. test 2. 2.75 3. 2.0 4. 1.5 5. 1.5
22.0	24.0		SAND, clayey, medium dense, moist, tan.			5. No jar samples taken from 0.0 to 22.0
24.0	30.0		CLAY, sandy, stiff, moist tan.			6. 0.0 to 22.0 - 24.0 22.0 to 35.7 - 6' d.r.
30.0	32.0		BORDERLINE - sandy clay or clayey sand, moist, tan.			7. Bentonite drill mud used from 22.0
32.0	35.7		SAND, medium to coarse- grained, gravelly with gravel increase at 33.2' REFUGAL w/ d.b. @ 35.7'			

ENG FORM 1836 PREVIOUS EDITIONS ARE OBSOLETE PROJECT
Aubrey, D.S. HOLE NO.
8A6D-66

Note No. 867/6

DRILLING LOG		DIVISION Southwest TN		INSTALLATION Fort Worth		SHEET of 1 sheets	
PROJECT Aubrey D.S.		NO. AND TYPE OF BIT 6" Auger, 6" C. B'b'l.		DATE OF ELEVATION INDICATION (if any)			
LOCATION (Coordinate or Station)		MANUFACTURER'S DESIGNATION OF DRILL Falling 1500		TOTAL NO. OF OVER-BORE SAMPLES TAKEN 6		TOTAL NUMBER CORE BOXES 6	
DRILLING AGENCY Corps of Engineers		NAME OF DRILLER Newhouse		DATE HOLE STARTED 2 April 73		DATE HOLE COMPLETED 3 April 73	
HOLE NO. (As shown on drawing title and here recorded) 8A6D-66		DIRECTION OF HOLE <input checked="" type="checkbox"/> VERTICAL <input type="checkbox"/> INCLINED		THICKNESS OF OVERBURDEN		TOTAL CORE RECOVERY FOR BORING	
TOTAL DEPTH OF HOLE 35.7		CLASSIFICATION OF MATERIALS (Description)		CORRECTION (If any)		REMARKS (Including name, weight, size, number of samples, etc., if significant)	
ELEVATION	DEPTH	LEGEND		LOG NO.	TEST NO.		
	0.0		0.0' to 19.0' CLAY - - 0.0 to 3.0 - sil. sandy medium to stiff, moist, brown. 3.0 to 16.0 - sandy to 16.0, very sandy from 16.0 to 19.0, stiff, moist, tan.				1. Elevation of ground water was not determined. 2. Jars: A. 24.0 B. 26.0 C. 28.0 D. 30.0 E. 32.0 F. 34.0 NOTE: All jar samples taken from Denison bb'l shoe.
	19.0		19.0' to 21.0' SAND, sil. clayey, medium to coarse-grained, medium dense, moist, tan.				3. Denison Cans: 1. 22.0 to 24.0 2. 24.0 to 26.0 3. 26.0 to 28.0 4. 28.0 to 30.0 5. 30.0 to 32.0 6. 32.0 to 34.0
	20.0		21.0' to 22.0' CLAY, sandy, medium stiff moist, tan.				4. Pocket penetrometer tests as follows: cm no. test 2. 2.75 3. 2.0 4. 1.5 5. 1.5
	20.0		-- Start 6" d. b'l. at 20.0		22.0		5. No jar samples taken from 0.0 to 22.0
	22.0		22.0' to 24.0' SAND, clayey, medium dense, moist, tan.	L.	1		6. 0.0 to 22.0 - auger 22.0 to 35.7 - 6" d.
	24.0		24.0' to 30.0' CLAY, sandy, stiff, moist tan.	L.	2		7. Bentonite drill mud used from 22.0
	30.0		30.0' to 32.0' BORDELING - sandy clay or clayey sand, moist, tan.	L.	3		
	32.0		32.0' to 35.7' SAND, medium to coarse-grained, gravelly with gravel increase at 33.2'. REVEAL w/ d.b. to 35.7'	L.	4		
				L.	5		
				L.	6		
				No Rec.			

ENG FORM 1836 MAR 73 PREVIOUS EDITIONS ARE OBSOLETE

PROJECT: Aubrey D.S. HOLE NO: 8A6D-66

RECORD DRAWING-WORK AS BUILT

SYM	LOG NO.	ACTION	DATE	DESCRIPTION OF REVISION
U.S. ARMY ENGINEER DISTRICT, FORT WORTH CORPS OF ENGINEERS FORT WORTH, TEXAS				
DESIGNED BY	RAY ROBERTS LAKE ELM FORK, TRINITY RIVER, TEXAS EMBANKMENT, SPILLWAY AND OUTLET WORKS LOGS OF BORINGS 8A6D-65 AND 8A6D-66			
DRAWN BY				
REVIEWED BY				
SUBMITTED BY				
ENGINEER	INVITATION NO. DACW63-82B-0025	DATE	MAR, 1982	
	CONTRACT NO. DACW63-82 C 0013			SEQUENCE NO.
	DRAWING NUMBER		SHEET NO.	26

TO ACCOMPANY FOUNDATION REPORT

Note No. 8162-67

DRILLING LOG		Division	INSTALLATION	SHEET		
PROJECT		City Department	Post-Tank, Wash. D.C.	1 of 2 SHEETS		
1. PROJECT Audrey D. S.		10. SITE AND TYPE OF SITE 11. DATE FOR ELEVATION (FROM 1929) 1951				
2. LOCATION (Continent or Island)		12. HORIZONTAL OR ELEVATION OF DRILL				
3. DRILLING AGENCY Corps of Engineers		13. TOTAL NO. OF OVERBURDEN SAMPLES TAKEN				
4. HOLE NO. (As shown on drawing here) and file number		14. TOTAL NUMBER CORE BOIES				
5. NAME OF DRILLER Mullins		15. ELEVATION GROUND WATER				
6. DIRECTION OF HOLE <input checked="" type="checkbox"/> VERTICAL <input type="checkbox"/> INCLINED		16. DATE MOLE 18. DATE MOLE				
7. THICKNESS OF OVERBURDEN		19. ELEVATION TOP OF MOLE				
8. DEPTH DRILLED INTO ROCK		20. TOTAL CORE RECOVERY FOR SPONGE				
9. TOTAL DEPTH OF HOLE		21. SIGNATURE OF DRILLER				
ELEVATION	DEPTH	LEGEND	CLASSIFICATION OF MATERIALS (Description)	CORE RECOVERY	BOX OR SAMPLE NO.	REMARKS (Including tool, water flow, depth of penetration, etc., if significant)
			0.0 to 33.3 CLAY - 0.0 to 3.0 medium plasticity, dark brown, medium stiff, moist 3.0 to 9.4 low to medium plasticity, brown, very moist, stiff, slightly sandy 9.4 to 16.5 medium plasticity, dark brown, stiff, moist 16.5 to 26.5 low plasticity, dark brown, stiff to very stiff, moist, slightly sandy 26.5 to 30.5 medium plasticity, dark brown, stiff, moist 30.5 to 33.3 medium plasticity, gray and tan, very stiff, moist 33.3 to 35.3 GRAVEL -		Jar A Jar B Jar C Jar D Can 1 Can 2 Can 3 Can 4 Can 5 Can 6 Can 7 Can 8	Drilling 0.0 to 15.0 10" auger 15.0 to 33.3 6" D Bbl 33.3 to 35.3 77/8" rock bit Denison samples 1. 15.8 to 17.8 2. 19.8 to 21.8 3. 21.8 to 23.8 4. 23.8 to 25.8 5. 25.8 to 27.8 6. 27.8 to 29.8 7. 29.8 to 31.8 8. 31.8 to 33.3 Denison sample 1. 18.1 to 19.0 Note: sample came from denison can. Jar samples A. 0.0 to 3.0 B. 3.0 to 9.4 C. 8.0 to 9.4 D. 9.4 to 15.8 E. 17.8 F. 19.8 G. 21.8 H. 23.8 I. 25.8 J. 27.8 K. 29.8 L. 31.8 Note: samples E through L from shoe of Denison Bbl. Location Hole offset 20.7' S35°W from staked location (X= 2,141.445; Y= 615,594). New elevation is 559.6 as determined by hand level. T. D. @ 35.3
						Hand penetrometer test depth tons/sq. ft. 17.8 1.30 19.8 1.50 21.8 2.25 23.8 2.25 25.8 2.25 27.8 1.75 29.8 1.75 31.8 3.30 Note All samples are calcareous. Water table Hole was not bailed. 4" slotted, plastic pipe set to 36.0'. Daily measurements reported on supplemental sheet.

DRILLING LOG		Division	
PROJECT		Southwestern	
1. PROJECT Audrey D. S.		10. LOCATION (Continent or Island) X= 2,141,610 Y= 615,020	
2. DRILLING AGENCY Corps of Engineers		11. DATE FOR ELEVATION (FROM 1929)	
3. HOLE NO. (As shown on drawing here) and file number		12. HORIZONTAL OR ELEVATION OF DRILL	
4. NAME OF DRILLER Mullins		13. TOTAL NUMBER CORE BOIES	
5. DIRECTION OF HOLE <input checked="" type="checkbox"/> VERTICAL <input type="checkbox"/> INCLINED		14. ELEVATION GROUND WATER	
6. THICKNESS OF OVERBURDEN		15. DATE MOLE	
7. DEPTH DRILLED INTO ROCK		16. DATE MOLE	
8. TOTAL DEPTH OF HOLE		17. ELEVATION TOP OF MOLE	
9. TOTAL DEPTH OF HOLE		18. TOTAL CORE RECOVERY FOR SPONGE	
9. TOTAL DEPTH OF HOLE		19. SIGNATURE OF DRILLER	
ELEVATION	DEPTH	LEGEND	CLASSIFICATION OF MATERIALS (Description)
			0.0 to 29.2 CLAY - 0.0 to 6.0 medium pl dark brown, medium at stiff, moist, calcareous 6.0 to 14.6 medium pl brown, hard, moist (very stiff at 12.5) 14.6 to 18.0 medium plasticity, light brown, stiff, moist 18.0 to 22.0 high pl brown, very stiff, ve 22.0 to 28.2 medium plasticity, light brown a very n stiff to stiff moist, slightly sandy 28.2 to 29.2 low pla gray and tan, very at moist 29.2 to 32.6 SAND - tan, loose to medium saturated, non calcareous 32.6 to 36.0 CLAY - 32.6 to 34.5 medium plasticity, moist, stiff, and gray 34.0 to 36.0 low plastic and gray, soft to stiff, saturated, sandy 36.0 to 38.5 SAND - tan, medium dense, slightly clayey 38.5 to 45.5 GRAVEL - tan, loose, saturated, sandy, becomes coarse 40.5 T. D. @ 45.5

Hole No. 1150-69

DRILLING LOG PROJECT: Aubrey D. S. LOCATION: Xr 2, 141, 610 Yr 615, 020 DRILLING AGENCY: Corps of Engineers HOLE NO. (as shown on drawing sheet and site number): 0A6D-69 NAME OF DRILLER: Mullins DIRECTION OF HOLE: <input checked="" type="checkbox"/> VERTICAL <input type="checkbox"/> INCLINED THICKNESS OF OVERBURDEN: 47.5' DEPTH DRILLED INTO ROCK: 0 TOTAL DEPTH OF HOLE: 45.5'	DIVISION: Southwestern INSTALLATION: Fort Worth District H. SIZE AND TYPE OF BIT: 6" D Bit I. DATE AND TIME OF START: 9 Aug 73 II. DATE AND TIME OF STOP: 10 Aug 73 III. MANUFACTURER'S DESIGNATION OF DRILL: Falling 1500 IV. TOTAL NO. OF OVERBURDEN SAMPLES TAKEN: 20 V. TOTAL NUMBER CORE BOXES: 16 VI. ELEVATION GROUND WATER: 560.81 VII. SIGNATURE OF INSPECTOR: [Signature]	SHEET 1 OF 2 SHEETS II. DATE AND TIME OF STOP: 10 Aug 73 III. MANUFACTURER'S DESIGNATION OF DRILL: Falling 1500 IV. TOTAL NO. OF OVERBURDEN SAMPLES TAKEN: 20 V. TOTAL NUMBER CORE BOXES: 16 VI. ELEVATION GROUND WATER: 560.81 VII. SIGNATURE OF INSPECTOR: [Signature]
---	--	--

ELEVATION	DEPTH	LEGEND	CLASSIFICATION OF MATERIAL (Description)	CORE RECOVERY (%)	BOX OR SAMPLE NO.	REMARKS (Depth from top of hole, depth of overburden, etc., if significant)
0.0 to 29.2			CLAY --		Jar A	Drilling
0.0 to 6.0			sedium plasticity, dark brown, sedium stiff to stiff, moist, calcareous		Jar B	0.0 to 5.0 8" sugar 5.0 to 41.0 6" D Bit 41.0 to 45.5 7 7/8" rock bit no casing
6.0 to 14.6			sedium plasticity, brown, hard, moist (becomes very stiff at 12.5)		Can 1	Denison samples
14.6 to 18.0			sedium plasticity, light brown, very stiff, moist		Can 2	1. 5.0 to 7.0 2. 7.0 to 9.0 3. 9.0 to 11.0 4. 11.0 to 13.0 5. 13.0 to 15.0 6. 15.0 to 17.0 7. 17.0 to 19.0 8. 19.0 to 21.0 9. 21.0 to 23.0 10. 23.0 to 25.0 11. 25.0 to 27.0 12. 27.0 to 29.0 13. 31.0 to 33.0 14. 33.0 to 35.0 15. 35.0 to 37.0 16. 37.0 to 39.0
18.0 to 22.0			high plasticity, brown, very stiff, very moist		Can 3	Notes: sand sample from 29.0 to 31.0 and gravel sample from 39.0 to 41.0 were disturbed.
22.0 to 26.2			sedium plasticity, light brown and gray, very stiff to stiff, moist, slightly sandy		Can 4	Sand samples
26.2 to 29.2			low plasticity, gray and tan, very stiff, moist		Can 5	A. 0.0 to 3.0 B. 3.0 to 5.0 C. 7.0 D. 9.0 E. 11.0 F. 13.0 G. 15.0 H. 17.0 I. 19.0 J. 21.0 K. 23.0 L. 25.0 M. 27.0 N. 29.0 O. 31.0 P. 33.0 Q. 35.0 R. 37.0 S. 39.0 T. 41.0
29.2 to 32.6			SAND --		Can 6	Notes: samples C through T obtained from shoe of Denison barrel.
32.6 to 36.0			tan, loose to medium dense, saturated, non calcareous		Can 7	
36.0 to 38.5			CLAY --		Can 8	
38.5 to 45.5			tan, loose, saturated, sandy, because coarse at 40.5'		Can 9	
					Can 10	
					Can 11	
					Can 12	
					Can 13	
					Can 14	
					Can 15	
					Can 16	
					Can 17	
					Can 18	
					Can 19	
					Can 20	

Hole No. 1150-69

DRILLING LOG PROJECT: Aubrey D. S. LOCATION: Xr 2, 140, 155 Yr 614, 685 DRILLING AGENCY: Corps of Engineers HOLE NO. (as shown on drawing sheet and site number): 0A6D-69 NAME OF DRILLER: Mullins DIRECTION OF HOLE: <input checked="" type="checkbox"/> VERTICAL <input type="checkbox"/> INCLINED THICKNESS OF OVERBURDEN: 43.0 DEPTH DRILLED INTO ROCK: 1.0 TOTAL DEPTH OF HOLE: 44.0	DIVISION: Southwestern INSTALLATION: Fort Worth District H. SIZE AND TYPE OF BIT: 6" D Bit I. DATE AND TIME OF START: 15 Aug 73 II. DATE AND TIME OF STOP: 15 Aug 73 III. MANUFACTURER'S DESIGNATION OF DRILL: Falling 1500 IV. TOTAL NO. OF OVERBURDEN SAMPLES TAKEN: 16 V. TOTAL NUMBER CORE BOXES: 16 VI. ELEVATION GROUND WATER: 557.5 VII. SIGNATURE OF INSPECTOR: [Signature]	SHEET 1 OF 2 SHEETS II. DATE AND TIME OF STOP: 15 Aug 73 III. MANUFACTURER'S DESIGNATION OF DRILL: Falling 1500 IV. TOTAL NO. OF OVERBURDEN SAMPLES TAKEN: 16 V. TOTAL NUMBER CORE BOXES: 16 VI. ELEVATION GROUND WATER: 557.5 VII. SIGNATURE OF INSPECTOR: [Signature]
---	--	---

ELEVATION	DEPTH	LEGEND	CLASSIFICATION OF MATERIAL (Description)	CORE RECOVERY (%)	BOX OR SAMPLE NO.	REMARKS (Depth from top of hole, depth of overburden, etc., if significant)
0.0 to 32.0			CLAY --		Jar A	Drilling
0.0 to 4.5			medium plasticity, brownish-gray, stiff, slightly moist		Jar B	0.0 to 15.0 15.0 to 37.0 37.0 to 44.0 no casing rockbit
4.5 to 11.0			low to medium plasticity, brown, stiff to very stiff, moist, with some calcareous particles 5.2 to 11.0		Jar C	Denison samples
11.0 to 20.0			high plasticity, light brown, moist to very moist, stiff		Jar D	A. 0.0 to 4.5 B. 4.5 to 11.0 C. 5.2 to 11.0 D. 10.2 to 11.0 E. 11.0 to 17.0 F. 17.0 to 19.0 G. 19.0 to 21.0 H. 21.0 to 23.0 I. 23.0 to 25.0 J. 25.0 to 27.0 K. 27.0 to 29.0 L. 29.0 to 31.0 M. 31.0 to 33.0 N. 33.0 to 35.0 O. 35.0 to 37.0 P. 37.0 to 39.0
20.0 to 22.0			high plasticity, light brown, medium stiff, very moist to saturated		Can 1	Notes: sample P taken from Denison barrel.
22.0 to 28.0			medium plasticity, brown, stiff to very stiff, moist, with some calcareous particles and a few small shells		Can 2	
28.0 to 30.0			medium plasticity, tan, stiff, very moist, slightly sandy		Can 3	
30.0 to 32.0			low plasticity, tan, saturated, stiff, sandy		Can 4	Denison.
32.0 to 43.0			SAND --		Can 5	1. 15.0 to 17.0 2. 17.0 to 21.0 3. 21.0 to 23.0 4. 23.0 to 25.0 5. 25.0 to 27.0 6. 27.0 to 29.0 7. 29.0 to 31.0 8. 31.0 to 33.0 9. 33.0 to 35.0
32.0 to 34.0			tan, medium dense, clayey, saturated		Can 6	
34.0 to 36.5			tan, loose, saturated, gravelly		Can 7	Notes: no sample 21.0 due to no sample 21.0 due to pre-
36.5 to 43.0			with coarse gravel		Can 8	
43.0 to 44.0			SHALE --		Can 9	Hand Remot depth 17.0 19.0 23.0 25.0 27.0 29.0 31.0 33.0 35.0
			dark gray, medium hard (rock classification), unweathered, non-jointed, moist		Can 10	**Water Hole bailed initially X water vary After com- bailing, 1 9.8". Addi- table info ported on sheet. 4" plastic p 35.0'

DRILLING LOG		INSTALLATION		
PROJECT: Southwestern		Hole No. 8167-00		
LOCATION: Abbey D. S.		Sheet 1 of 2		
X-2-140,155 Y-614,685		M.S.L.		
CORPS OF ENGINEERS		FALLING 1500		
HOLE NO. (As shown on drawing sheet) 816D-69		TOTAL NO. OF OVERBURDEN SAMPLES TAKEN 16		
NAME OF DRILLER WILLIAMS		TOTAL NUMBER CORE BOXES 9		
DIRECTION OF HOLE: <input checked="" type="checkbox"/> VERTICAL <input type="checkbox"/> INCLINED DES. FROM VERT.		ELEVATION GROUND WATER 80		
THICKNESS OF OVERBURDEN 43.0		DATE HOLE STARTED 15 AUG 73 COMPLETED 16 AUG 73		
DEPTH DRILLED INTO ROCK 1.0		ELEVATION TOP OF HOLE 557.5'		
TOTAL DEPTH OF HOLE 44.0		TOTAL CORE RECOVERY FOR BORING		
CLASSIFICATION OF WATER (Observed)		REMARKS (Drilling time, water level, depth of overburden, etc., if significant)		
ELEVATION	DEPTH	LEGEND	CLASSIFICATION OF WATER	REMARKS
0.0 to 32.0			CLAY --	*Drilling
0.0 to 4.5			medium plasticity, brownish-gray, stiff, slightly moist	0.0 to 15.0 10" auger
4.5 to 11.0			low to medium plasticity, brown, stiff to very stiff, moist, with some calcareous particles 5.2 to 11.0	15.0 to 37.0 6" D Ebl
11.0 to 20.0			high plasticity, light brown, moist to very moist, stiff	37.0 to 44.0 7 7/8" rockbit
20.0 to 22.0			high plasticity, light brown, medium stiff, very moist to saturated	no casing
22.0 to 28.0			medium plasticity, brown, stiff to very stiff, moist, with some calcareous particles and a few small chells	Jar samples
28.0 to 30.0			medium plasticity, tan, stiff, very moist, slightly sandy	A. 0.0 to 4.5
30.0 to 32.0			low plasticity, tan, saturated, stiff, sandy	B. 4.5 to 5.2
32.0 to 43.0			SAND --	C. 5.2 to 10.2
32.0 to 34.0			tan, medium dense, clayey, saturated	D. 10.2 to 11.0
34.0 to 36.5			tan, loose, saturated, gravelly	E. 11.0 to 15.0
36.5 to 43.0			with coarse gravel	F. 17.0 to 19.0
				G. 19.0
				H. 21.0
				I. 23.0
				J. 25.0
				K. 27.0
				L. 29.0
				M. 31.0
				N. 33.0
				O. 35.0
				P. 37.0
				Note: samples F through P taken from shoe of Denison barrel.
				Denison samples
				1. 15.0 to 17.0
				2. 17.0 to 19.0
				3. 21.0 to 23.0
				4. 23.0 to 25.0
				5. 25.0 to 27.0
				6. 27.0 to 29.0
				7. 29.0 to 31.0
				8. 31.0 to 33.0
				9. 33.0 to 35.0
				Note: no sample 19.0 to 21.0 due to catcher; no sample 35.0 to 37.0 due to presence of gravel
				Note
				All overburden material are calcareous.
				Hand penetrometer test
				depth tons/sq. ft.
				17.0 3.20
				19.0 2.75
				23.0 2.65
				25.0 2.65
				27.0 1.75
				29.0 1.50
				31.0 1.20
				**Water table
				Hole bailed to approximately 30.0' but making water very rapidly. After completion of bailing, water level at 9.8'. Additional water table information reported on supplemental sheet. 4" slotted plastic pipe set to 35.0'
43.0 to 44.0			SHALE --	
			dark gray, medium hard (rock classification), un-weathered, non-jointed, moist	

RECORD DRAWING-WORK AS BUILT

SYM	NO.	ACTION	DATE	DESCRIPTION OF REVISION
U.S. ARMY ENGINEER DISTRICT, FORT WORTH CORPS OF ENGINEERS FORT WORTH, TEXAS				
DESIGNED BY:	RAY ROBERTS LAKE			
DRAWN BY:	ELM FORK, TRINITY RIVER, TEXAS			
REVIEWED BY:	EMBANKMENT, SPILLWAY AND			
	OUTLET WORKS			
	LOGS OF BORINGS			
	8A6D-67, 8A6D-68, AND 8A6D-69			
SUBMITTED BY:	INITIATION NO. DACW 63-82-C-0025		DATE: MAR 1982	
ENGINEER:	CONTRACT NO. DACW 63-82-C-0023		SEQUENCE NO. 27	
	DRAWING NUMBER		SHEET NO.	

DRILLING LOG		Installation		Hole No. 81-70		SHEET 1 of 2 SHEETS	
PROJECT: Southwestern		NAME: Southwestern		DATE: 14 AUG 73		SHEET: 1 of 2	
SUBJECT: Drilling		NO. AND TYPE OF BIT: 8" auger		DATE OF TEST: 14 AUG 73		SHEET: 1 of 2	
LOCATION: Y 2 132.87 X 615.945		ELEVATION: 561.0'		DATE OF TEST: 14 AUG 73		SHEET: 1 of 2	
DRILLING AGENCY: Corps of Engineers		MANUFACTURER: Palmer 1500		DATE OF TEST: 14 AUG 73		SHEET: 1 of 2	
HOLE NO. (as shown on drawing sheet and log number): 81-70		TOTAL NUMBER CORE BOSS: 14		DATE OF TEST: 14 AUG 73		SHEET: 1 of 2	
NAME OF DRILLER: Mullins		ELEVATION GROUND WATER: 0		DATE OF TEST: 14 AUG 73		SHEET: 1 of 2	
DIRECTION OF HOLE: VERTICAL		ELEVATION TOP OF HOLE: 561.0'		DATE OF TEST: 14 AUG 73		SHEET: 1 of 2	
THICKNESS OF OVERBURDEN: 39.2'		TOTAL CORE RECOVERY PERCENTAGE: 0.8		DATE OF TEST: 14 AUG 73		SHEET: 1 of 2	
DEPTH DRILLED INTO ROCK: 0.8		TOTAL DEPTH OF HOLE: 40.0		DATE OF TEST: 14 AUG 73		SHEET: 1 of 2	
ELEVATION		LEGEND		CLASSIFICATION OF MATERIALS (See notes)		CORRECTION	
0.0 to 29.0		CLAY --		0.0 to 5.0 medium plasticity, dark brown, medium stiff, slightly moist		Jar A	
5.0 to 10.8		CLAY --		5.0 to 10.8 medium plasticity, brown, stiff, moist, with some calcareous particles		Jar B	
10.8 to 27.0		CLAY --		10.8 to 27.0 high plasticity, brown, stiff to very stiff moist		Jar C	
27.0 to 28.0		CLAY --		27.0 to 28.0 medium plasticity, tan, medium stiff to stiff, very moist, slightly sandy		Jar D	
28.0 to 29.0		CLAY --		28.0 to 29.0 low plasticity, tan, medium stiff, saturated, sandy		Jar E	
29.0 to 33.0		SAND --		tan, loose, saturated, becomes slightly gravelly 31.0 to 33.0		Jar F	
33.0 to 34.0		SAND --		tan, loose, saturated, becomes slightly gravelly 31.0 to 33.0		Jar G	
34.0 to 35.0		GRAVEL --		tan, loose, saturated, poorly graded		Jar H	
35.0 to 39.2		CLAY --		35.0 to 39.2 medium plasticity, brown and gray, stiff, moist		Jar I	
39.2 to 40.0		SHALE --		dark gray medium hard (rock classification), unweathered, non-jointed, non- to slightly calcareous		Jar J	
						T. D. @ 40.0	

DRILLING LOG		Installation		Hole No. 81-70		SHEET 1 of 2 SHEETS	
PROJECT: Southwestern		NAME: Southwestern		DATE: 14 AUG 73		SHEET: 1 of 2	
SUBJECT: Drilling		NO. AND TYPE OF BIT: 8" auger		DATE OF TEST: 14 AUG 73		SHEET: 1 of 2	
LOCATION: Y 2 132.87 X 615.945		ELEVATION: 561.0'		DATE OF TEST: 14 AUG 73		SHEET: 1 of 2	
DRILLING AGENCY: Corps of Engineers		MANUFACTURER: Palmer 1500		DATE OF TEST: 14 AUG 73		SHEET: 1 of 2	
HOLE NO. (as shown on drawing sheet and log number): 81-70		TOTAL NUMBER CORE BOSS: 14		DATE OF TEST: 14 AUG 73		SHEET: 1 of 2	
NAME OF DRILLER: Mullins		ELEVATION GROUND WATER: 0		DATE OF TEST: 14 AUG 73		SHEET: 1 of 2	
DIRECTION OF HOLE: VERTICAL		ELEVATION TOP OF HOLE: 561.0'		DATE OF TEST: 14 AUG 73		SHEET: 1 of 2	
THICKNESS OF OVERBURDEN: 45.5'		TOTAL CORE RECOVERY PERCENTAGE: 0.5		DATE OF TEST: 14 AUG 73		SHEET: 1 of 2	
DEPTH DRILLED INTO ROCK: 0.5		TOTAL DEPTH OF HOLE: 46.0'		DATE OF TEST: 14 AUG 73		SHEET: 1 of 2	
ELEVATION		LEGEND		CLASSIFICATION OF MATERIALS (See notes)		CORRECTION	
0.0 to 30.5		CLAY --		0.0 to 6.5 medium plasticity, brown, medium stiff (becomes stiff at 4.0), slightly moist		Jar A	
6.5 to 11.5		CLAY --		6.5 to 11.5 low plasticity, light brown, very stiff, slightly sandy		Jar B	
11.5 to 16.5		CLAY --		11.5 to 16.5 medium plasticity, light brown, stiff, moist		Jar C	
16.5 to 29.6		CLAY --		16.5 to 29.6 medium to high plasticity, brown, stiff, moist		Jar D	
29.6 to 30.5		CLAY --		29.6 to 30.5 low plasticity, tan, stiff, saturated, sandy, very slightly gravelly		Jar E	
30.5 to 31.7		SAND --		tan, loose, saturated, coarse, gravelly		Jar F	
31.7 to 37.0		CLAY --		31.7 to 37.0 high plasticity, gray and tan mottled, medium stiff, very moist, calcareous		Jar G	
37.0 to 45.5		GRAVEL --		37.0 to 45.5 high plasticity, grayish-brown, soft to medium stiff, very moist to saturated. Becomes slightly sandy at 35.0		Jar H	
						T. D. @ 40.0	

DRILLING LOG		Division	INSTALLATION	Sheet 1 of 2 SHEETS	
PROJECT Abrey D. S.		Southwestern	Port North District		
I. LOCATION (Continuation of Form)					
Xt 2-140,700 Yt 615,945					
II. DRILLING AGENCY Corps of Engineers					
III. HOLE NO. 722 (shown on casing data) and site number		DA-71			
IV. NAME OF DRILLER Hullins					
V. DIRECTION OF HOLE <input checked="" type="checkbox"/> VERTICAL <input type="checkbox"/> INCLINED DES. FROM TEST.					
VI. THICKNESS OF OVERBURDEN 45.5'					
VII. DEPTH DRILLED INTO ROCK 0.5'					
VIII. TOTAL DEPTH OF HOLE 46.0'					
IX. DATE HOLE STARTED 13 Aug 73 COMPLETED 14 Aug 73					
X. ELEVATION TOP OF HOLE 560.0'					
XI. TOTAL CORE RECOVERY FOR SOILS 60%					
REMARKS <i>Joseph H. Shanks</i>					
ELEVATION	DEPTH	LEGEND	CLASSIFICATION OF MATERIALS (Description)	SOIL NO. OR SAMPLE NO.	REMARKS (Drilling time, water loss, depth of penetration, etc., if significant)
0.0 to 30.5			CLAY --	Jar A	Drilling 0.0 to 43.0 8" auger 43.0 to 46.0 7 7/8 rockbit
0.0 to 6.5			medium plasticity, brown, medium stiff (becomes stiff at 4.0), slightly moist	Jar B	Var samples
6.5 to 11.5			low plasticity, light brown, very stiff, slightly sandy	Jar C	A. 0.0 to 4.0 B. 4.0 to 6.5 C. 6.5 to 11.5 D. 11.5 to 16.5 E. 16.5 to 20.5 F. 20.5 to 25.5 G. 25.5 to 29.6 H. 29.6 to 30.5 I. 30.5 to 31.7 J. 31.7 to 32.5 K. 32.5 to 37.0 L. 37.0 to 42.0 M. 42.0 to 45.5
11.5 to 16.5			medium plasticity, light brown, stiff, moist	Jar D	Moist
16.5 to 29.6			medium to high plasticity, brown, stiff, moist	Jar E	All materials are calcareous.
29.6 to 30.5			low plasticity, tan, stiff, saturated, sandy, very slightly gravelly	Jar F	*Water table Because of squeezing, hole was bailed only to 16.0' slotted, plastic set to 39.2'. See measurements reported on supplemental sheet.
30.5 to 31.7			low plasticity, tan, stiff, saturated, sandy, very slightly gravelly	Jar G	
31.7 to 37.0			SAND --	Jar H	
37.0 to 42.0			tan, loose, saturated, coarse, gravelly	Jar I	
42.0 to 45.5			CLAY --	Jar J	
45.5 to 46.0			tan, loose, saturated, clayey, with some shells and small cobbles. Becomes very clayey at 42.0'.	Jar K	
46.0 to 46.0			GRAVEL --	Jar L	
46.0 to 46.0			tan, loose, saturated, clayey, with some shells and small cobbles. Becomes very clayey at 42.0'.	Jar M	T. D. @ 46.0

DRILLING LOG		Division	INSTALLATION	Sheet 1 of 1 SHEETS	
PROJECT Abrey D. S.		Southwestern	Port North District		
I. LOCATION (Continuation of Form)					
Xt 2-140,700 Yt 615,945					
II. DRILLING AGENCY Corps of Engineers					
III. HOLE NO. 722 (shown on casing data) and site number		BA6C-72			
IV. NAME OF DRILLER Kerby					
V. DIRECTION OF HOLE <input checked="" type="checkbox"/> VERTICAL <input type="checkbox"/> INCLINED DES. FROM TEST.					
VI. THICKNESS OF OVERBURDEN 31.0					
VII. DEPTH DRILLED INTO ROCK 7.0					
VIII. TOTAL DEPTH OF HOLE 28.0					
IX. DATE HOLE STARTED 17 Aug 73 COMPLETED 21 Aug 73					
X. ELEVATION TOP OF HOLE 570.4					
XI. TOTAL CORE RECOVERY FOR SOILS 60%					
REMARKS <i>Joseph H. Shanks</i>					
ELEVATION	DEPTH	LEGEND	CLASSIFICATION OF MATERIALS (Description)	SOIL NO. OR SAMPLE NO.	REMARKS (Drilling time, water loss, depth of penetration, etc., if significant)
0.0 to 4.0			CLAY --	Jar A	location Hole offset 16.0' 340° from staked location of X-2-138,510 and Y-614,460
4.0 to 20.0			medium plasticity, brown, very stiff, slightly moist, slightly sandy	Jar B	*Water table
20.0 to 21.0			SAND --	Jar C	4" slotted plastic pipe installed to 18.5' - hole bailed to 23.0'. Readings report on supplemental sheet.
21.0 to 21.2			4.0 to 11.0 tan, medium dense, moist, fine, clayey; becomes silty at 10.0	Jar D	Drilling
21.2 to 28.0			11.0 to 12.5 tan, medium dense, moist, silty, with small ironstone nodules	Jar E	0.0 to 24.0 8" auger 24.0 to 28.0 6" core
28.0 to 28.0			12.5 to 15.0 tan and gray, loose, saturated, with ironstone	Jar F	Var samples
28.0 to 28.0			15.0 to 17.0 gray, loose, saturated, silty	Jar G	A. 0.0 to 4.0 B. 4.0 to 10.0 C. 10.0 to 11.0 D. 11.0 to 12.5 E. 12.5 to 15.0 F. 15.0 to 17.0 G. 17.0 to 20.0 H. 20.0 to 21.0
28.0 to 28.0			17.0 to 20.0 tan, loose, saturated, silty	Jar H	
28.0 to 28.0			20.0 to 21.0	Jar I	
28.0 to 28.0			GRAVEL --	Jar J	Carton sample
28.0 to 28.0			tan, loose, saturated, sandy, with cobbles up to 4" diameter	Jar K	1. 26.7 to 27.6
28.0 to 28.0			21.0 to 21.2	Jar L	Moist
28.0 to 28.0			SILTSTONE --	Jar M	Overburden is non-calcareous. No elevation is 571.0' 8" casing to 24.0'
28.0 to 28.0			light gray, hard (rock classification), massive	Jar N	
28.0 to 28.0			21.2 to 28.0	Jar O	
28.0 to 28.0			SHALE --	Jar P	
28.0 to 28.0			light gray, non-weathered, moderately hard (rock classification), laminated, non-jointed	Jar Q	
28.0 to 28.0			T. D. @ 28.0	Jar R	

ENG FORM 1836 PREVIOUS EDITIONS ARE OBSOLETE.
MAR 71

PROJECT
Abrey D. S.

HOLE NO.
BA6C-72

Hole No. D160-75

DRILLING LOG		DIVISION	INSTALLATION	SHEET		
1. PROJECT		Southwestern	Fort Worth District	1 of 1 SHEETS		
2. LOCATION (County, State or Station)		Aubrey D. S.				
3. DRILLING AGENCY		Cops of Engineers				
4. HOLE NO. (As shown on drawing sheet and site marked)		B160-75				
5. NAME OF DRILLER		Newhouse				
6. DIRECTION OF HOLE		<input checked="" type="checkbox"/> VERTICAL <input type="checkbox"/> INCLINED <input type="checkbox"/> SEE FROM VIEW				
7. THICKNESS OF OVERBURDEN		3.5				
8. DEPTH DRILLED INTO ROCK		5.6				
9. TOTAL DEPTH OF HOLE		9.1				
10. MANUFACTURER'S DESIGNATION OF DRILL		Palling 1500				
11. TOTAL NO. OF OVERBURDEN SAMPLES TAKEN		0				
12. TOTAL NUMBER CORE BOXES		1				
13. ELEVATION GROUND WATER						
14. DATE HOLE STARTED		21 Aug 73				
15. ELEVATION TOP OF HOLE		22 Aug 73				
16. TOTAL CORE RECOVERY FOR BORING		75%				
17. SIGNATURE OF INSPECTOR		<i>Joseph A. ...</i>				
ELEVATION	DEPTH	LEGEND	CLASSIFICATION OF MATERIALS (Description)	A CORE RECOVERY %	BOX OR SAMPLE NO.	REMARKS (Drilling time, water loss, depth of overburden, etc., if significant)
			0.0 to 3.5 CLAY --			Drilling 0.0 to 3.5 8" auger 3.5 to 9.1 6" core (short barrel) 0.0 to 3.5 8" casing Cotton swab 5.4 to 6.0 Note
			0.0 to 2.5 medium plasticity, dark brown, stiff to very stiff, slightly moist	L.O.F	Box 1	
			2.5 to 3.5 low plasticity, brown, stiff, moist, slightly sandy; gravelly from 3.3 to 3.5	L.O.F		
			3.5 to 7.9 LIMESTONE --			Water measurements not taken. Overburden non-calcareous.
			hard (rock classification), well cemented, light gray, massive			
			7.9 to 9.1 SHALS --			
			gray and tan, moderately hard, non-jointed, non-calcareous			
			T. D. @ 9.1			

Hole No. B160-75

DRILLING LOG		DIVISION	INSTALLATION	SHEET		
1. PROJECT		SWD	Fort Worth District	1 of 1 SHEETS		
2. LOCATION (County, State or Station)		Aubrey Dam				
3. DRILLING AGENCY		TUNNEL OUTLET CORP				
4. HOLE NO. (As shown on drawing sheet and site marked)		B160-75				
5. NAME OF DRILLER		Newhouse				
6. DIRECTION OF HOLE		<input checked="" type="checkbox"/> VERTICAL <input type="checkbox"/> INCLINED <input type="checkbox"/> SEE FROM VIEW				
7. THICKNESS OF OVERBURDEN		12.0'				
8. DEPTH DRILLED INTO ROCK		80.8'				
9. TOTAL DEPTH OF HOLE		92.8'				
10. MANUFACTURER'S DESIGNATION OF DRILL		Palling 1500				
11. TOTAL NO. OF OVERBURDEN SAMPLES TAKEN		0				
12. TOTAL NUMBER CORE BOXES		0				
13. ELEVATION GROUND WATER						
14. DATE HOLE STARTED		22 Aug 73				
15. ELEVATION TOP OF HOLE		22 Aug 73				
16. TOTAL CORE RECOVERY FOR BORING						
17. SIGNATURE OF INSPECTOR		<i>Joseph A. ...</i>				
ELEVATION	DEPTH	LEGEND	CLASSIFICATION OF MATERIALS (Description)	A CORE RECOVERY %	BOX OR SAMPLE NO.	REMARKS (Drilling time, water loss, depth of overburden, etc., if significant)
			0.0' to 39.5'			NO SAMPLES TAKEN

ENG FORM 18-36 MAR 51 PREVIOUS EDITIONS ARE OBSOLETE. (TRANSILUCENT)

Hole No. B160-75

DRILLING LOG		DIVISION	INSTALLATION	SHEET		
1. PROJECT		Southwestern	Fort Worth District	1 of 1 SHEETS		
2. LOCATION (County, State or Station)		Aubrey D. S.				
3. DRILLING AGENCY		Cops of Engineers				
4. HOLE NO. (As shown on drawing sheet and site marked)		B160-75				
5. NAME OF DRILLER		Newhouse				
6. DIRECTION OF HOLE		<input checked="" type="checkbox"/> VERTICAL <input type="checkbox"/> INCLINED <input type="checkbox"/> SEE FROM VIEW				
7. THICKNESS OF OVERBURDEN		5.5				
8. DEPTH DRILLED INTO ROCK		0				
9. TOTAL DEPTH OF HOLE		5.5				
10. MANUFACTURER'S DESIGNATION OF DRILL		Palling 1500				
11. TOTAL NO. OF OVERBURDEN SAMPLES TAKEN		0				
12. TOTAL NUMBER CORE BOXES		0				
13. ELEVATION GROUND WATER						
14. DATE HOLE STARTED		22 Aug 73				
15. ELEVATION TOP OF HOLE		22 Aug 73				
16. TOTAL CORE RECOVERY FOR BORING						
17. SIGNATURE OF INSPECTOR		<i>Joseph A. ...</i>				
ELEVATION	DEPTH	LEGEND	CLASSIFICATION OF MATERIALS (Description)	A CORE RECOVERY %	BOX OR SAMPLE NO.	REMARKS (Drilling time, water loss, depth of overburden, etc., if significant)
			0.0 to 5.5 CLAY --			Drilling 0.0 to 5.5 8" auger Note Water measurements not taken. Overburden non-calcareous. Auger refusal at 5.5'
			0.0 to 4.0 medium plasticity, dark brown, stiff to very stiff, slightly moist			
			4.0 to 5.5 becomes light brown, moist			
			5.5 LIMESTONE --			
			hard (rock classification), well cemented, light gray, massive			
			T. D. @ 5.5			

DRILLING LOG		VISION	INSTALLATION	WELL No. 8165-01	SHEET 1 OF 3 SHEETS	
PROJECT: Southwestern		SITE: Fort Worth District		DATE: 7 Jan 75		
PROJECT: Aubrey Lyle		WELL NO. 8165-01		ELEVATION GROUND WATER: 86.0'		
LOCATION: (Coordinates or Station)		MANUFACTURER'S DESIGNATION OF DRILL: Fallin-1500		TOTAL CORE RECOVERY FOR BORING: 905'		
DIRECTION OF HOLE: VERTICAL		DATE HOLE STARTED: 7 Jan 75		DATE HOLE COMPLETED: 16 Jan 75		
THICKNESS OF OVERBURDEN: 4.0'		ELEVATION TOP OF HOLE: 620.0'		ELEVATION TOP OF HOLE: 621.3'		
DEPTH DRILLED INTO ROCK: 82.0'		SIGNATURE OF INSPECTOR: [Signature]		SIGNATURE OF INSPECTOR: [Signature]		
TOTAL DEPTH OF HOLE: 86.0'		REMARKS: (Drilling time, water loss, depth of weathering, etc., if significant)		REMARKS: (Drilling time, water loss, depth of weathering, etc., if significant)		
ELEVATION	DEPTH	LEGEND	CLASSIFICATION OF MATERIALS (Description)	SCORE RECORD	BOX OR SAMPLE NO.	REMARKS
0.0'	4.0'		SAND -- brown, loose, very moist, medium-grained, non-calcareous		Jar A	Drilling 0.0' to 9.0' 8" auger 9.0' to 26.0' 6" core 9.0' to 17.0' 8" casing
4.0'	33.5'		SAND (primary) -- red, massive, weathered, fine-grained, with some ironstone concretions and zones slightly clayey		Jar sample A. 0.0' to 4.0'	
4.0'	16.3'		non-cemented		Carbon samples	
16.3'	24.5'		poorly cemented		1. 16.3' to 17.0'	
24.5'	27.3'		non-cemented		2. 20.1' to 21.0'	
27.3'	29.0'		poorly cemented		3. 36.1' to 37.0'	
29.0'	33.5'		non-cemented, slightly clayey, becoming very clayey at base		4. 42.0' to 43.0'	
33.5'	43.8'		SHALE -- light gray, moderately weathered, massive, non-calcareous, easy to drill, 4.25' to 4.5' on hand penetrometer down to 35.0' and 24.5' below 35.0' sandy to very sandy, with		5. 51.7' to 52.6'	
					6. 56.4' to 57.3'	
					7. 61.6' to 62.6'	
					8. 65.4' to 66.3'	
					9. 69.0' to 69.9'	
					10. 69.0' to 69.9'	
					11. 72.7' to 73.6'	
					12. 76.9' to 77.8'	
					13. 79.9' to 80.9'	
					14. 81.8' to 82.6'	
					15. 85.1' to 86.0'	
						Note: Depth of weathering at 55.0'. Hole was electrilogged. NOT
						*Water level
						Four inch slotted plastic pipe was set to 49.

DRILLING LOG		VISION	INSTALLATION	WELL No. 8165-01	SHEET 2 OF 3 SHEETS	
PROJECT: Southwestern		SITE: Fort Worth District		DATE: 7 Jan 75		
PROJECT: Aubrey Lyle		WELL NO. 8165-01		ELEVATION GROUND WATER: 86.0'		
LOCATION: (Coordinates or Station)		MANUFACTURER'S DESIGNATION OF DRILL: Fallin-1500		TOTAL CORE RECOVERY FOR BORING: 905'		
DIRECTION OF HOLE: VERTICAL		DATE HOLE STARTED: 7 Jan 75		DATE HOLE COMPLETED: 16 Jan 75		
THICKNESS OF OVERBURDEN: 4.0'		ELEVATION TOP OF HOLE: 620.0'		ELEVATION TOP OF HOLE: 621.3'		
DEPTH DRILLED INTO ROCK: 82.0'		SIGNATURE OF INSPECTOR: [Signature]		SIGNATURE OF INSPECTOR: [Signature]		
TOTAL DEPTH OF HOLE: 86.0'		REMARKS: (Drilling time, water loss, depth of weathering, etc., if significant)		REMARKS: (Drilling time, water loss, depth of weathering, etc., if significant)		
ELEVATION	DEPTH	LEGEND	CLASSIFICATION OF MATERIALS (Description)	SCORE RECORD	BOX OR SAMPLE NO.	REMARKS
0.0'	4.0'		SAND -- brown, loose, very moist, medium-grained, non-calcareous		Jar A	Drilling 0.0' to 9.0' 8" auger 9.0' to 26.0' 6" core 9.0' to 17.0' 8" casing
4.0'	33.5'		SAND (primary) -- red, massive, weathered, fine-grained, with some ironstone concretions and zones slightly clayey		Jar sample A. 0.0' to 4.0'	
4.0'	16.3'		non-cemented		Carbon samples	
16.3'	24.5'		poorly cemented		1. 16.3' to 17.0'	
24.5'	27.3'		non-cemented		2. 20.1' to 21.0'	
27.3'	29.0'		poorly cemented		3. 36.1' to 37.0'	
29.0'	33.5'		non-cemented, slightly clayey, becoming very clayey at base		4. 42.0' to 43.0'	
33.5'	43.8'		SHALE -- light gray, moderately weathered, massive, non-calcareous, easy to drill, 4.25' to 4.5' on hand penetrometer down to 35.0' and 24.5' below 35.0' sandy to very sandy, with		5. 51.7' to 52.6'	
					6. 56.4' to 57.3'	
					7. 61.6' to 62.6'	
					8. 65.4' to 66.3'	
					9. 69.0' to 69.9'	
					10. 69.0' to 69.9'	
					11. 72.7' to 73.6'	
					12. 76.9' to 77.8'	
					13. 79.9' to 80.9'	
					14. 81.8' to 82.6'	
					15. 85.1' to 86.0'	
						Note: Depth of weathering at 55.0'. Hole was electrilogged. NOT
						*Water level
						Four inch slotted plastic pipe was set to 49.

INSTALLATION		SHEET 2 OF 3 SHEETS	
10 SITE AND TYPE OF BIT		11 DATE FOR ELEVATION INFORMATION (BY M)	
12 MANUFACTURER'S DESIGNATION OF DRILL		13 TOTAL NO. OF OVERBURDEN SAMPLES TAKEN	
14 TOTAL NUMBER CORE BOXES		15 ELEVATION GROUND WATER	
16 DATE HOLE		17 ELEVATION TOP OF HOLE	
18 TOTAL CORE RECOVERY FOR BORING		19 SIGNATURE OF INSPECTOR	
10	41.0	11	7
12	L 0.6	13	7
14	45.0	15	8
16	0.0	17	8
18	49.0	19	8
10	G 0.2	11	9
12	L 5.9	13	9
14	53.0	15	9
16	L 0.2	17	10
18	57.0	19	10
10	L 0.1	11	11
12	G 4.3	13	11
14	L 1.1	15	11
16	60.3	17	11
18	61.0	19	11
10	L 0.1	11	12
12	G 4.3	13	12
14	L 1.1	15	12
16	66.3	17	12
18	60.7	19	12
10	G 0.6	11	13
12	L 0.3	13	13
14	70.3	15	13
16	70.3	17	13
18	74.3	19	13
10	L 0.1	11	14
12	G 0.5	13	14
14	74.3	15	14
16	74.3	17	14
18	78.6	19	14
10	L 0.1	11	15
12	G 0.5	13	15
14	83.3	15	15
16	83.3	17	15
18	86.0	19	15
10	L 0.1	11	16
12	G 0.5	13	16
14	86.0	15	16
16	86.0	17	16
18	86.0	19	16

INSTALLATION		SHEET 1 OF 2 SHEETS	
10 SITE AND TYPE OF BIT		11 DATE FOR ELEVATION INFORMATION (BY M)	
12 MANUFACTURER'S DESIGNATION OF DRILL		13 TOTAL NO. OF OVERBURDEN SAMPLES TAKEN	
14 TOTAL NUMBER CORE BOXES		15 ELEVATION GROUND WATER	
16 DATE HOLE		17 ELEVATION TOP OF HOLE	
18 TOTAL CORE RECOVERY FOR BORING		19 SIGNATURE OF INSPECTOR	
10	41.0	11	7
12	L 0.6	13	7
14	45.0	15	8
16	0.0	17	8
18	49.0	19	8
10	G 0.2	11	9
12	L 5.9	13	9
14	53.0	15	9
16	L 0.2	17	10
18	57.0	19	10
10	L 0.1	11	11
12	G 4.3	13	11
14	L 1.1	15	11
16	60.3	17	11
18	61.0	19	11
10	L 0.1	11	12
12	G 4.3	13	12
14	L 1.1	15	12
16	66.3	17	12
18	60.7	19	12
10	G 0.6	11	13
12	L 0.3	13	13
14	70.3	15	13
16	70.3	17	13
18	74.3	19	13
10	L 0.1	11	14
12	G 0.5	13	14
14	83.3	15	14
16	83.3	17	14
18	86.0	19	14
10	L 0.1	11	15
12	G 0.5	13	15
14	86.0	15	15
16	86.0	17	15
18	86.0	19	15

ELEVATION	DEPTH	LEGEND	CLASSIFICATION
41.0	0.0'		penetr...
45.0	4.0'		28.6'...
49.0	8.0'		33.7'...
53.0	12.0'		38.8'...
57.0	16.0'		43.9'...
60.3	19.3'		49.0'...
61.0	20.0'		54.1'...
66.3	25.3'		59.2'...
60.7	19.7'		64.3'...
70.3	29.3'		69.4'...
74.3	33.3'		74.5'...
78.6	37.6'		79.6'...
83.3	42.3'		84.7'...
86.0	45.0'		89.8'...

Hole No. 8A6C-85

DIVISION So. Western	INSTALLATION Fort Worth District	SHEET 1 OF 2 SHEETS
10 SIZE AND TYPE OF BIT OR AUGER FOR CORE 11 DEPTH FOR ELEVATION INDICATED IN HOLE		
12 MANUFACTURER'S DESIGNATION OF DRILL Palline 1500		
13 TOTAL NO. OF OVER-BOURDEN SAMPLES TAKEN 0		
14 TOTAL NUMBER CORE BOXES 12		
15 ELEVATION GROUND WATER 0		
16 DATE HOLE STARTED 3 Dec 74		
17 ELEVATION TOP OF HOLE 66.5		
18 TOTAL CORE RECOVERY FOR BORING 100%		
19 SIGNATURE OF INSPECTOR [Signature]		

TH LEGEND	CLASSIFICATION OF MATERIALS (Description)	A CORE RECOVERY PERCENT	BOX OR SAMPLE NO.	REMARKS (Depth from, water level, etc.)
	0.0' to 3.5'		Jar A	Drilling
	SAND -- tan, loose, moist, fine to medium, silty, non-calcareous		B	0.0' to 7.0' 8" auger 7.0' to 67.0' 6" core 0.0' to 6.0' 8" casing
	3.5' to 25.6'		Jar samples	
	SAND (primary) -- 3.5' to 6.0' brown, non-cemented, non-calcareous, fine to medium, slightly clayey, very moist, with numerous ironstone concretions (to 6"), easy to auger		7.0	A. 0.0' to 3.5' B. 3.5' to 6.0'
	6.0' to 8.6' reddish-brown, poorly cemented, with concretions, very difficult to auger		10.0	Carton samples
	8.6' to 14.2' reddish-brown, non-cemented, massive, very moist, non-calcareous, with scattered small ironstone concretions, carbonaceous inclusions, and decayed roots		11.6	1. 7.0' to 7.9' 2. 12.3' to 13.2' 3. 16.0' to 16.8' 4. 18.0' to 18.9' 5. 27.7' to 28.6' 6. 32.1' to 33.0' 7. 34.7' to 35.6' 8. 41.4' to 42.3' 9. 48.1' to 49.0' 10. 54.0' to 54.9' 11. 58.3' to 59.2' 12. 65.6' to 66.5'
	14.2' to 25.6' becomes light gray with reddish-brown and yellowish-brown clayey, with some carbonaceous matter and occasional thin veins of selenite		17.7	Note Depth of weathering at 33.7'
	18.0' to 19.8' CLAY, predominantly gray, sandy, with pockets of yellowish-brown clayey sand		23.1	*Water level Hole was not bailed but left open for water level check.
	19.8' to 25.6' borderlime clay, gray, massive with lenses of clayey sand and sandy clay		26.0	
	25.6' to 45.0'		28.6	
	SHALE -- 25.6' to 26.7' dark purple, sandy, massive, with ironstone nodules		34.3	
	26.7' to 28.6' light gray and gray, slightly weathered, approximately 4.0 on hand		37.0	

ELEVATION	DEPTH	LEGEND	CLASSIFICATION OF MATERIALS (Description)	A CORE RECOVERY PERCENT	REMARKS (Depth from, water level, etc.)
			penetrator, thin-bedded, non-calcareous, non-fractured, and non-jointed	41.0	
			28.6' to 33.7' becomes calcareous, 74.5 on hand penetrator	7	
			33.7' to 45.0' non-weathered, gray, very calcareous, silty, cemented, breccia along bedding planes, but bedding is not clearly apparent	10	
			34.0' to 34.2' rust-stained	17	50.3
			42.8' to 45.0' with scattered fossils	9	
			45.0' to 57.6'	11	
			SHALE --	10	
			45.0' to 51.3' transitional with above unit, very argillaceous, with numerous lenses and partings of shale, gray, moderately well cemented, with numerous fossils from 50.8' to 51.2'	10	
			51.3' to 57.6' becomes light gray, well cemented, with numerous lenses of gray, argillaceous limestone	11	
			57.6' to 60.5'	11	
			SHALE --	11	
			dark gray, thin-bedded, non-fractured, non-jointed, calcareous on bedding planes to 59.0', non-calcareous from 59.0' to 70', scattered pockets of thin, thin bedded sand	11	
			60.5' to 60.9' SAND, thin-bedded, very fine	11	
			60.9' to 61.0' SILTSTONE	11	
			61.6' fossils on bedding plane	11	
			62.1' to 62.3' fossiliferous	11	

ENG FORM 1836 MAR 73 PREVIOUS EDITIONS ARE OBSOLETE
 ITRAVEL 'EXT'
 AUTHORITY: L30
 HOLE NO. 8A6C-85

RECORD DRAWING - WORK AS PULIT

DESIGNED BY	RAY ROBERTS LAKE
DRAWN BY	ELM FORK, TRINITY RIVER, TEXAS
REVIEWED BY	EMBANKMENT, SPILLWAY AND OUTLET WORKS
APPROVED BY	LOGS OF BORINGS 8A6C-84 AND 8A6C-85
CONTRACT NO.	INVITATION NO. DAC#63-B2-E 0025 DATE MAR, 1962
DATE	CONTRACT NO. DAC#63-92 C 0010
DESCRIPTION OF REVISION	DATE

DRILLING LOG		INSTALLATION	
PROJECT: Southwestern		Port Worth District	
LOCATION: Aubre Lake		SHEET: 004 of 00023	
SUBJECT: Left Abutment		NO. AND TYPE OF BIT: 3 1/8" fishtail	
SPONSORING AGENCY: Corps of Engineers		DATE: 15 Dec 74	
HOLE NO. (As shown on drawing and site number): SP-06		COMPLETED: 6 Jan 75	
NAME OF DRILLER: Willians		11. MANUFACTURER'S IDENTIFICATION OF DRILL: Falling 1500	
DIRECTION OF HOLE: <input checked="" type="checkbox"/> VERTICAL <input type="checkbox"/> INCLINED _____ deg. from vert.		12. TOTAL NO. OF OVERBURDEN SAMPLES TAKEN: 0	
THICKNESS OF OVERBURDEN: 0.0'		13. TOTAL NUMBER CORE BOXES: 0	
DEPTH DRILLED INTO ROCK: 140.0'		14. ELEVATION ABOVE WATER: 00	
TOTAL DEPTH OF HOLE: 140.0'		15. DATE MOLE STARTED: 15 Dec 74	
		16. DATE MOLE COMPLETED: 6 Jan 75	
		17. ELEVATION TOP OF HOLE: 0	
		18. TOTAL CORE RECOVERY FOR BORING: 0	
		19. SIGNATURE OF INSPECTOR: Joseph A. Cherkov	

ELEVATION	DEPTH	LEGEND	CLASSIFICATION OF MATERIALS (Description)	CORE SECTION NO.	BOX OR SAMPLE NO.	REMARKS (Drilling time, water loss, depth of penetration, etc., if significant)
0.0'	0.0'		0.0' to 68.5'			Drilling 0.0' to 140.0' 3 1/8" fishtail Jar sample A. 45.0' (from split spoon; may be fall-in) *Offset Due to inaccessibility, hole was offset approximately 50' ESW from elevation 690.26' to elevation 674.8' (as measured by hand level). Packer lost in hole at 95.0', and hole was re-drilled 4.5' S at same elevation. Note Attempted unsuccessfully to obtain sand samples with shaly tube, split spoon, and BX core barrel. Hole was pressure tested and electric logged. Logging is by drilling action and cuttings.
			SAND - red, fine-grained			
			8.0' becomes firmer, possibly clayey			
			14.5' ironstone concretion			
			20.0' to 21.5' fairly hard, poorly cemented			

ELEVATION	DEPTH	LEGEND	CLASSIFICATION OF MATERIALS (Description)	CORE SECTION NO.	BOX OR SAMPLE NO.	REMARKS
68.5'	68.5'		68.5' to 101.3'			
			SHALE - - gray, non-calcareous			
			73.8' to 74.1' harder			
			77.2' very hard			
			79.5' to 81.5' very hard			
			91.5' to 101.0' sandy, cuts very easily			
			101.0' to 101.3' very hard			
			101.3' to 115.0'			
			SHALE - - gray, calcareous, cuts easily to 105.0'			
			108.8' very hard			
			115.0' to 132.8'			
			LDGESTONE - -			
			121.0' to 121.2' soft			
			121.0' to 132.8' becomes very hard			
			132.8' to 140.0'			
			SHALE - - dark gray, non-calcareous			
			T. D. in shale @ 140.0'			

ELEVATION	DEPTH	LEGEND	CLASSIFICATION OF MATERIALS (Description)	1 CORE NO.	2 BOX OR SAMPLE NO.	REMARKS (Drilling time, water flow, depth of cuttings, etc., if significant)
70	68.5' to 101.3'	SHALE --	gray, non-calcareous			
	73.8' to 74.1'		harder			
	77.2'		very hard			
80	79.5' to 81.5'		very hard			
	91.5' to 101.0'		sandy, cuts very easily			
90						
100	101.0' to 101.3'		very hard			
	101.3' to 115.0'	SHALE --	gray, calcareous, cuts easily to 106.0'			
	108.8'		very hard			
110						
	115.0' to 132.8'	LIMESTONE --				
120	121.0' to 121.2'		soft			
	127.0' to 132.8'		becomes very hard			
130	132.8' to 140.0'	SHALE --	dark gray, non-calcareous			
140						
			D. in shale @ 140.0'			

PROJECT		INSTALLATION		Hole No.		
Drilling Log		Southwestern		calyx hole		
Subvey Lake		Fort Worth District		Sheet 1 of 2 sheets		
1. LOCATION (Coordinates or Station)		10. SIZE AND TYPE OF BIT		11. DATE FOR ELEVATION MEASUREMENT		
2. DRILLING AGENCY		11. MANUFACTURER'S DESIGNATION OF DRILL		12. TOTAL NO. OF CORE SAMPLES TAKEN		
3. HOLE NO. (As shown on drawing title and file number)		12. TOTAL NO. OF CORE SAMPLES TAKEN		13. RETURNED		
4. NAME OF DRILLER		13. ELEVATION GROUND WATER		14. DATE HOLE		
5. DIRECTION OF HOLE		14. DATE HOLE		15. DATE HOLE		
6. THICKNESS OF OVERBURDEN		15. ELEVATION TOP OF HOLE		16. TOTAL CORE RECOVERY FOR BORING		
7. DEPTH DRILLED INTO ROCK		16. TOTAL CORE RECOVERY FOR BORING		17. SIGNATURE OF INSPECTOR		
8. TOTAL DEPTH OF HOLE		17. SIGNATURE OF INSPECTOR		18. SIGNATURE OF INSPECTOR		
ELEVATION	DEPTH	LEGEND	CLASSIFICATION OF MATERIALS (Description)	1 CORE NO.	2 BOX OR SAMPLE NO.	REMARKS (Drilling time, water flow, depth of cuttings, etc., if significant)
	0.0' to 45.0'		CLAY --			Drilling
	0.0' to 6.0'		low to medium plasticity, dark brownish- gray, very stiff, moist, silty			0.0' to 16.5' 42" auger 0.0' to 29.6' 43" casing Water level Boring was making water from between 20.0' and 21.0' to 45.0'. Hole tended to cave from 21.0' to 20'
10	6.0' to 8.0'		with small, irregular lime nodules			
	8.0' to 12.0'		becomes brown, hard			
	12.0' to 14.5'		low plasticity, brown, very stiff, moist, slightly sandy			Cylinder samples
	14.5' to 16.0'		becomes stiff, sandy			1. 19.6' to 20.2' 2. 21.6' to 22.2'
	16.0' to 19.6'		low-plasticity, brown, medium stiff, very moist, sandy			
20	19.6' to 35.0'		becomes saturated, soft, very easy to auger	1		
				2		
30						
	35.0' to 45.0'		becomes very sandy with gravel and small boulders in lower 1.5'			
40						
	45.0' to 46.5'		SHALE --			D. @ 46.5' in shale

DRILLING LOG		DIVISION		INSTALLATION		SHEET	
Southwestern		Fort Worth District		Fort Worth		1 of 2 SHEETS	
PROJECT		PROJECT		PROJECT		PROJECT	
Ambrey Lake		Ambrey Dam		Ambrey Dam		Ambrey Dam	
LOCATION (Coordinate or Station)		LOCATION (Coordinate or Station)		LOCATION (Coordinate or Station)		LOCATION (Coordinate or Station)	
Tunnel Outlet Works		Tunnel Outlet Works		Tunnel Outlet Works		Tunnel Outlet Works	
DRILLING AGENCY		DRILLING AGENCY		DRILLING AGENCY		DRILLING AGENCY	
Corps of Engineers		Corps of Engineers		Corps of Engineers		Corps of Engineers	
DATE NO. (As shown on drawing title of the number)		DATE NO. (As shown on drawing title of the number)		DATE NO. (As shown on drawing title of the number)		DATE NO. (As shown on drawing title of the number)	
calyx hole		calyx hole		calyx hole		calyx hole	
NAME OF DRILLER		NAME OF DRILLER		NAME OF DRILLER		NAME OF DRILLER	
Preyer		Preyer		Preyer		Preyer	
SECTION OF HOLE		SECTION OF HOLE		SECTION OF HOLE		SECTION OF HOLE	
VERTICAL <input type="checkbox"/> INCLINED <input type="checkbox"/>		VERTICAL <input type="checkbox"/> INCLINED <input type="checkbox"/>		VERTICAL <input type="checkbox"/> INCLINED <input type="checkbox"/>		VERTICAL <input type="checkbox"/> INCLINED <input type="checkbox"/>	
DEG FROM VERT.		DEG FROM VERT.		DEG FROM VERT.		DEG FROM VERT.	
THICKNESS OF OVERBURDEN		THICKNESS OF OVERBURDEN		THICKNESS OF OVERBURDEN		THICKNESS OF OVERBURDEN	
45.0'		45.0'		45.0'		45.0'	
DEPTH DRILLED INTO ROCK		DEPTH DRILLED INTO ROCK		DEPTH DRILLED INTO ROCK		DEPTH DRILLED INTO ROCK	
1.5'		1.5'		1.5'		1.5'	
TOTAL CORE RECOVERY FOR BORING		TOTAL CORE RECOVERY FOR BORING		TOTAL CORE RECOVERY FOR BORING		TOTAL CORE RECOVERY FOR BORING	
26.5'		26.5'		26.5'		26.5'	
TOTAL DEPTH OF HOLE		TOTAL DEPTH OF HOLE		TOTAL DEPTH OF HOLE		TOTAL DEPTH OF HOLE	
46.5'		46.5'		46.5'		46.5'	
CLASSIFICATION OF MATERIALS		CLASSIFICATION OF MATERIALS		CLASSIFICATION OF MATERIALS		CLASSIFICATION OF MATERIALS	
CLAY		CLAY		CLAY		CLAY	
0.0' to 6.0' low to medium plasticity, dark brownish-gray, very stiff, moist, silty		0.0' to 6.0' low to medium plasticity, dark brownish-gray, very stiff, moist, silty		0.0' to 6.0' low to medium plasticity, dark brownish-gray, very stiff, moist, silty		0.0' to 6.0' low to medium plasticity, dark brownish-gray, very stiff, moist, silty	
6.0' to 8.0' with small, irregular lime nodules		6.0' to 8.0' with small, irregular lime nodules		6.0' to 8.0' with small, irregular lime nodules		6.0' to 8.0' with small, irregular lime nodules	
8.0' to 12.0' becomes brown, hard		8.0' to 12.0' becomes brown, hard		8.0' to 12.0' becomes brown, hard		8.0' to 12.0' becomes brown, hard	
12.0' to 14.5' low plasticity, brown, very stiff, moist, slightly sandy		12.0' to 14.5' low plasticity, brown, very stiff, moist, slightly sandy		12.0' to 14.5' low plasticity, brown, very stiff, moist, slightly sandy		12.0' to 14.5' low plasticity, brown, very stiff, moist, slightly sandy	
14.5' to 16.0' becomes stiff, sandy		14.5' to 16.0' becomes stiff, sandy		14.5' to 16.0' becomes stiff, sandy		14.5' to 16.0' becomes stiff, sandy	
16.0' to 19.6' low plasticity, brown, medium stiff, very moist, sandy		16.0' to 19.6' low plasticity, brown, medium stiff, very moist, sandy		16.0' to 19.6' low plasticity, brown, medium stiff, very moist, sandy		16.0' to 19.6' low plasticity, brown, medium stiff, very moist, sandy	
1.5' to 9.2'		1.5' to 9.2'		1.5' to 9.2'		1.5' to 9.2'	
LIMESTONE - fine to medium grained, tan to rust brown, highly weathered, medium hard.		LIMESTONE - fine to medium grained, tan to rust brown, highly weathered, medium hard.		LIMESTONE - fine to medium grained, tan to rust brown, highly weathered, medium hard.		LIMESTONE - fine to medium grained, tan to rust brown, highly weathered, medium hard.	
9.2' to 30.0'		9.2' to 30.0'		9.2' to 30.0'		9.2' to 30.0'	
SHALE		SHALE		SHALE		SHALE	
9.2' to 13.5' - tan to gray, silty, soft, weathered.		9.2' to 13.5' - tan to gray, silty, soft, weathered.		9.2' to 13.5' - tan to gray, silty, soft, weathered.		9.2' to 13.5' - tan to gray, silty, soft, weathered.	
13.5' to 30.0' - dark gray, silty, horizontal bedding definition, soft, fossiliferous, non-calcareous except for fossils and fossil fragments. Light gray siltstone noted from 25.2' to 26.0'.		13.5' to 30.0' - dark gray, silty, horizontal bedding definition, soft, fossiliferous, non-calcareous except for fossils and fossil fragments. Light gray siltstone noted from 25.2' to 26.0'.		13.5' to 30.0' - dark gray, silty, horizontal bedding definition, soft, fossiliferous, non-calcareous except for fossils and fossil fragments. Light gray siltstone noted from 25.2' to 26.0'.		13.5' to 30.0' - dark gray, silty, horizontal bedding definition, soft, fossiliferous, non-calcareous except for fossils and fossil fragments. Light gray siltstone noted from 25.2' to 26.0'.	
T. D. 30.0'		T. D. 30.0'		T. D. 30.0'		T. D. 30.0'	

DRILLING LOG		DIVISION		INSTALLATION		SHEET	
Southwestern		Fort Worth		Fort Worth		1 of 1 SHEETS	
PROJECT		PROJECT		PROJECT		PROJECT	
Ambrey Dam		Ambrey Dam		Ambrey Dam		Ambrey Dam	
LOCATION (Coordinate or Station)		LOCATION (Coordinate or Station)		LOCATION (Coordinate or Station)		LOCATION (Coordinate or Station)	
Tunnel Outlet Works		Tunnel Outlet Works		Tunnel Outlet Works		Tunnel Outlet Works	
DRILLING AGENCY		DRILLING AGENCY		DRILLING AGENCY		DRILLING AGENCY	
Corps of Engineers		Corps of Engineers		Corps of Engineers		Corps of Engineers	
DATE NO. (As shown on drawing title of the number)		DATE NO. (As shown on drawing title of the number)		DATE NO. (As shown on drawing title of the number)		DATE NO. (As shown on drawing title of the number)	
8A6DC-90		8A6DC-90		8A6DC-90		8A6DC-90	
NAME OF DRILLER		NAME OF DRILLER		NAME OF DRILLER		NAME OF DRILLER	
Warehouse		Warehouse		Warehouse		Warehouse	
SECTION OF HOLE		SECTION OF HOLE		SECTION OF HOLE		SECTION OF HOLE	
VERTICAL <input checked="" type="checkbox"/> INCLINED <input type="checkbox"/>		VERTICAL <input checked="" type="checkbox"/> INCLINED <input type="checkbox"/>		VERTICAL <input checked="" type="checkbox"/> INCLINED <input type="checkbox"/>		VERTICAL <input checked="" type="checkbox"/> INCLINED <input type="checkbox"/>	
DEG FROM VERT.		DEG FROM VERT.		DEG FROM VERT.		DEG FROM VERT.	
THICKNESS OF OVERBURDEN		THICKNESS OF OVERBURDEN		THICKNESS OF OVERBURDEN		THICKNESS OF OVERBURDEN	
1.5'		1.5'		1.5'		1.5'	
DEPTH DRILLED INTO ROCK		DEPTH DRILLED INTO ROCK		DEPTH DRILLED INTO ROCK		DEPTH DRILLED INTO ROCK	
26.5'		26.5'		26.5'		26.5'	
TOTAL CORE RECOVERY FOR BORING		TOTAL CORE RECOVERY FOR BORING		TOTAL CORE RECOVERY FOR BORING		TOTAL CORE RECOVERY FOR BORING	
100		100		100		100	
TOTAL DEPTH OF HOLE		TOTAL DEPTH OF HOLE		TOTAL DEPTH OF HOLE		TOTAL DEPTH OF HOLE	
30.0'		30.0'		30.0'		30.0'	
CLASSIFICATION OF MATERIALS		CLASSIFICATION OF MATERIALS		CLASSIFICATION OF MATERIALS		CLASSIFICATION OF MATERIALS	
0.0' to 1.5'		0.0' to 1.5'		0.0' to 1.5'		0.0' to 1.5'	
SAND - fine to medium grained, brown, dry, clayey and limy.		SAND - fine to medium grained, brown, dry, clayey and limy.		SAND - fine to medium grained, brown, dry, clayey and limy.		SAND - fine to medium grained, brown, dry, clayey and limy.	
1.5' to 9.2'		1.5' to 9.2'		1.5' to 9.2'		1.5' to 9.2'	
LIMESTONE - fine to medium grained, tan to rust brown, highly weathered, medium hard.		LIMESTONE - fine to medium grained, tan to rust brown, highly weathered, medium hard.		LIMESTONE - fine to medium grained, tan to rust brown, highly weathered, medium hard.		LIMESTONE - fine to medium grained, tan to rust brown, highly weathered, medium hard.	
9.2' to 30.0'		9.2' to 30.0'		9.2' to 30.0'		9.2' to 30.0'	
SHALE		SHALE		SHALE		SHALE	
9.2' to 13.5' - tan to gray, silty, soft, weathered.		9.2' to 13.5' - tan to gray, silty, soft, weathered.		9.2' to 13.5' - tan to gray, silty, soft, weathered.		9.2' to 13.5' - tan to gray, silty, soft, weathered.	
13.5' to 30.0' - dark gray, silty, horizontal bedding definition, soft, fossiliferous, non-calcareous except for fossils and fossil fragments. Light gray siltstone noted from 25.2' to 26.0'.		13.5' to 30.0' - dark gray, silty, horizontal bedding definition, soft, fossiliferous, non-calcareous except for fossils and fossil fragments. Light gray siltstone noted from 25.2' to 26.0'.		13.5' to 30.0' - dark gray, silty, horizontal bedding definition, soft, fossiliferous, non-calcareous except for fossils and fossil fragments. Light gray siltstone noted from 25.2' to 26.0'.		13.5' to 30.0' - dark gray, silty, horizontal bedding definition, soft, fossiliferous, non-calcareous except for fossils and fossil fragments. Light gray siltstone noted from 25.2' to 26.0'.	
T. D. 30.0'		T. D. 30.0'		T. D. 30.0'		T. D. 30.0'	

RECORD DRAWING-WORK AS BUILT

SYMBOL NO.	ACTION	DATE	DESCRIPTION OF REVISION
<p align="center">U.S. ARMY ENGINEER DISTRICT, FORT WORTH CORPS OF ENGINEERS FORT WORTH, TEXAS</p>			
DESIGNED BY:	RAY ROBERTS LAKE		
DRAWN BY:	ELM FORK, TRINITY RIVER, TEXAS		
REVIEWED BY:	EMBANKMENT, SPILLWAY AND		
	OUTLET WORKS		
	LOGS OF BORINGS		
	3SF-86, CALYX HOLE AND 8A6DC-90		
SUBMITTED BY:	INVITATION NO. DACW63-82-C-0025	DATE	MAR, 1982
ENGINEER:	CONTRACT NO. DACW63-82-C-0083	SHEET NO.	31

CONTRACT NO. DACW63-82-C-0083

DRILLING LOG PROJECT: Aubrey Dam LOCATION: Tunnel Outlet Boring CHILLING AGENT: Corps of Engineers HOLE NO. (AS SHOWN ON DRILLING TITLE SHEET): 8460-91 NAME OF OPERATOR: Sotogrover and Mullins DIRECTION OF HOLE: <input checked="" type="checkbox"/> VERTICAL <input type="checkbox"/> INCLINED THICKNESS OF OVERBURDEN: 15.2' DEPTH DRILLED INTO ROCK: 46.1' TOTAL DEPTH OF HOLE: 62.1'		INSTALLATION: Southwanton HOLE SIZE AND TYPE OF BIT: 4 1/2" DIA. FOR 10" DIA. CORE MANUFACTURER'S DESIGNATION OF BIT: Fulling 1500 TOTAL NO. OF QUARTZ SAMPLES TAKEN: 6 DATE HOLE STARTED: 11 Dec. 1975 DATE HOLE COMPLETED: 16 Dec. 1975 TOTAL CORE RECOVERY FOR SPRING: 99% SIGNATURE OF INSPECTOR: <i>John J. [Signature]</i>	
---	--	---	--

ELEVATION	DEPTH	LEGEND	CLASSIFICATION OF MATERIALS (Description)	CORE RECOVERY %	BOX OR SAMPLE NO.	REMARKS
0.0'	0.0'		0.0' to 14.0'			Hole bailed to near T.D. upon completion with 27.0' of slotted plastic pipe installed for water level observation. Water level after: 20 hours = 29.0', 48 hours = 17.2'. Drilling: Augered to 19.5'; 6" core to total depth of 64.1'. Offset core hole 7 1/2" east and drilled final hole 3" in diameter to total depth of 67.0' for electric logging. Electric log was made for this boring. Jars: A. 0.0' to 4.0' B. 4.0' to 7.0' C. 7.0' to 9.0' D. 9.0' to 14.0' E. 14.0' to 15.5' F. 15.5' to 18.0' G. 18.0' to 19.5' Cartons: 1. 20.6' to 21.5' 2. 25.6' to 26.6' 3. 31.7' to 32.7' 4. 37.5' to 39.5' 5. 44.8' to 45.8' 6. 51.6' to 52.6' 7. 55.9' to 56.9' 8. 62.9' to 63.9' Core Boxes: 1. 19.5' to 24.9' 2. 24.9' to 30.2' 3. 30.2' to 35.9' 4. 35.9' to 41.6' 5. 41.6' to 46.9' 6. 46.9' to 52.6' 7. 52.6' to 57.6' 8. 58.6' to 63.9'
			SAND			
			0.0' to 4.0' - very fine grained, light brown, unconsolidated, dry, non-calcareous.			
			4.0' to 7.0' - as above interval, light tan color, slightly damp, non-calcareous.			
			7.0' to 9.0' - very fine grained, rust brown, moist, becoming clayey (cohesive), non-calcareous.			
			9.0' to 14.0' - as above interval, more clayey, more moist, non-calcareous.			
			14.0' to 18.0'			
			GRAVEL - borders on gravelly clay, dark brown, poorly graded up to 1 1/2", becoming wet from 15.5' to 18.0', non-calcareous.			
			18.0' to 24.0'			
			SHALE - light tan, soft, intermittently limy and gray below 20.0'. Very calcareous.			
			24.0' to 36.9'			
			LIMESTONE - light gray, fine to medium grained, medium hard, argillaceous, fossiliferous (less argillaceous, lighter in color from 29.5' to 34.5').			
			36.9' to 63.9'			
			SHALE - dark gray, silty, soft, intermittently fossiliferous, slightly calcareous. Light gray very fine grained sandstone noted from 54.5' to 54.8'. Gray, dense, micaceous siltstone noted from 57.2' to 59.0' with irregular (approximately 10° from horizontal) contact with shale below.			
			T. D. 64.1'			

DRILLING LOG PROJECT: Aubrey Dam LOCATION: Tunnel Outlet Boring CHILLING AGENT: Corps of Engineers HOLE NO. (AS SHOWN ON DRILLING TITLE SHEET): 8460-92 NAME OF OPERATOR: Sotogrover and Mullins DIRECTION OF HOLE: <input checked="" type="checkbox"/> VERTICAL <input type="checkbox"/> INCLINED THICKNESS OF OVERBURDEN: 15.2' DEPTH DRILLED INTO ROCK: 10.5' TOTAL DEPTH OF HOLE: 25.5'		INSTALLATION: Southwanton HOLE SIZE AND TYPE OF BIT: 4 1/2" DIA. FOR 10" DIA. CORE MANUFACTURER'S DESIGNATION OF BIT: Fulling 1500 TOTAL NO. OF QUARTZ SAMPLES TAKEN: 6 DATE HOLE STARTED: 11 Dec. 1975 DATE HOLE COMPLETED: 16 Dec. 1975 TOTAL CORE RECOVERY FOR SPRING: 99% SIGNATURE OF INSPECTOR: <i>John J. [Signature]</i>	
---	--	---	--

ELEVATION	DEPTH	LEGEND	CLASSIFICATION OF MATERIALS (Description)	CORE RECOVERY %	BOX OR SAMPLE NO.	REMARKS
0.0'	0.0'		0.0' to 15.2'			CLAY AND SAND - clay dominates overburden with sand noted only at 6.0'. Clay from 0.0' to 2.0' light reddish brown, stiff, silty, sandy, medium to low plasticity, slightly moist; becoming dry, finely sandy, light rust brown at 4.0'. Sand at 6.0' fine grained, brown, clayey with scattered fine gravel. Clay was noted below and to 15.2'; reddish brown, some gray, silty, slightly sandy, medium to low plasticity, medium to stiff, moist, non-calcareous. 15.2' to 17.2' SHALE - tan soft, silty, calcareous. 17.2' to 25.5' LIMESTONE - gray, soft to medium hard to hard, fine to medium grained, argillaceous, fossiliferous. T. D. 25.5'

Hole No. 8167C-02

Sheet 1 of 1 sheets

DRILLING LOG	Southwestern	INSTALLATION	Port North
PROJECT	Aubrey Dam	NO. SIZE AND TYPE OF BIT	8" Auger
LOCATION (Continent or Island)	Manuel Outlet Works	DATE OF INSTALLATION (MONTH - YEAR)	1976
DRILLING AGENCY	Corps of Engineers	NO. MANUFACTURER'S DESIGNATION OF DRILL	Falling 1500
NAME OF DRILLER	Neponoag	NO. TOTAL NO. OF CORES	2
DIRECTION OF HOLE	Vertical	NO. ELEVATION GROUND WATER	00
THICKNESS OF OVERBURDEN	15.2'	NO. DATE HOLE STARTED	19 Jan 1976
DEPTH DRILLED INTO ROCK	10.3'	NO. DATE HOLE COMPLETED	20 Jan 1976
TOTAL DEPTH OF HOLE	25.5'	NO. TOTAL CORE RECOVERY FOR BOXES	100%

ELEVATION	DEPTH	LEGEND	CLASSIFICATION OF MATERIALS (Description)	NO. CORE RECOVERY	NO. OF SAMPLES	REMARKS (Drilling time, water flow, depth of penetration, etc., if significant)
0.0'	15.2'		CLAY AND SAND - clay dominates overburden with sand noted only at 6.0'. Clay from 0.0' to 2.0' light reddish brown, stiff, silty, sandy, medium to low plasticity, slightly moist; becoming dry, finely sandy, light rust brown at 4.0'. Sand at 6.0' fine grained, brown, clayey with scattered fine gravel. Clay was noted below and to 15.2'; reddish brown, some gray, medium to low plasticity, medium to stiff, moist, non-calcareous.		A	1. Hole was bailed upon completion and perforated plastic pipe installed for water level observation.
15.2'	17.2'		SHALE - tan soft, silty, calcareous.		B	2. Drilling: 8" auger to 2.0'; Denison barrel to 17.0'; 6" core to 25.5'.
17.2'	25.5'		LIMESTONE - gray, soft to medium hard to hard, fine to medium grained, argillaceous, fossiliferous.		C	3. Jars: A. 0.0' to 2.0' B. At 4.0' C. At 6.0' D. At 8.0' E. At 11.0' F. At 13.0' G. At 15.0' H. At 17.0'
				L 0.0'	Box 1	4. Denison Cans: 1. 2.0' to 4.0' 2. 4.0' to 6.0' 3. 6.0' to 8.0' 4. 9.0' to 11.0' 5. 11.0' to 13.0' 6. 13.0' to 15.0' 7. 15.0' to 17.0'
				L 0.0'	Box 2	5. Cartons: 1. 18.7' to 19.7' 2. 23.3' to 24.2'
						6. Core Boxes: 1. 17.0' to 21.5' 2. 21.5' to 25.5'

Hole No. 816C-01

Sheet 1 of 1 sheets

DRILLING LOG	Southwestern	INSTALLATION	Port North
PROJECT	Aubrey Lake	NO. SIZE AND TYPE OF BIT	8" Auger; 6" Core
LOCATION (Continent or Island)	Soilway Site #2	DATE OF INSTALLATION (MONTH - YEAR)	1975
DRILLING AGENCY	Corps of Engineers	NO. MANUFACTURER'S DESIGNATION OF DRILL	Falling 1500
NAME OF DRILLER	Schooner	NO. TOTAL NO. OF CORES	2
DIRECTION OF HOLE	Vertical	NO. ELEVATION GROUND WATER	00
THICKNESS OF OVERBURDEN	7.0'	NO. DATE HOLE STARTED	21 Nov. 1975
DEPTH DRILLED INTO ROCK	13.0'	NO. DATE HOLE COMPLETED	21 Nov. 1975
TOTAL DEPTH OF HOLE	20.0'	NO. TOTAL CORE RECOVERY FOR BOXES	100%

ELEVATION	DEPTH	LEGEND	CLASSIFICATION OF MATERIALS (Description)	NO. CORE RECOVERY	NO. OF SAMPLES	REMARKS (Drilling time, water flow, depth of penetration, etc., if significant)
0.0'	2.0'		CLAY - as described in interval below.		A3	1. Hole was bailed to near total depth upon completion. 4" plastic pipe, slotted, was installed in boring for future water level observations.
2.0'	7.0'		CLAY		A	2. Drilling: 8" auger to 7.0'; 6" core to total depth of 20.0'.
7.0'	13.9'		2.0' to 5.0' - medium plasticity, brown, hard, silty to finely sandy, slightly moist, non-calcareous. 5.0' to 7.0' - as above interval, slightly lighter in color, some very fine gravel widely scattered throughout.		B	3. Jars: A. 2.0' to 5.0' B. 5.0' to 7.0'
13.9'	20.0'		CLAY-SHALE - soft, rust brown and gray, silty, highly weathered, non-calcareous, occasional very fine gravel scattered throughout recovery.	L 0.1'	Box 1	4. Cartons: 1. 7.5' to 8.5' 2. 11.5' to 12.5' 3. 16.7' to 17.6' 4. 19.0' to 20.0'
			SHALE - tan with some gray marbling, soft, occasional soft white lily inclusions. Shale is non-calcareous and weathered to total depth. Sand lenses noted from 13.5' to 13.9'; fine grained, rust brown. Iron concretionary zone noted from 14.9' to 15.1'.	L 0.4'	Box 2	5. Core Boxes: 1. 7.0' to 13.4' 2. 13.4' to 20.0'
				C 0.6'		

Hole No. 8A6C-301
 SHEET 1 of 1 SHEETS
DRILLING LOG *Southwestern* **INSTALLATION** *Fort Worth*
PROJECT *Aubrey Lake*
LOCATION *Spillway Site #2*
DRILLING AGENCY *Corps of Engineers*
DATE *8A6C-301*
NAME OF DRILLER *Schoonover*
SECTION OF HOLE *Vertical*
THICKNESS OF OVERBURDEN *7.0'*
DEPTH DRILLED INTO ROCK *13.0'*
TOTAL DEPTH OF HOLE *20.0'*

DEPTH	LEGEND	CLASSIFICATION OF MATERIALS	REMARKS
0.0' to 2.0'		CLAY - as described in interval below.	1. Hole was bailed to near total depth upon completion. 4" plastic pipe, slotted, was installed in boring for future water level observations.
2.0' to 7.0'		CLAY 2.0' to 5.0' - medium plasticity, brown, hard, silty to finely sandy, slightly moist, non-calcareous.	
5.0' to 7.0'		5.0' to 7.0' - as above interval, slightly lighter in color, some very fine gravel widely scattered throughout.	2. Drilling: 8" auger to 7.0'; 6" core to total depth of 20.0'.
7.0' to 13.9'		CLAY-SHALE - soft, rust brown and gray, silty, highly weathered, non-calcareous, occasional very fine gravel scattered throughout recovery.	3. JARS: A. 2.0' to 5.0' B. 5.0' to 7.0'
13.9' to 20.0'		SHALE - tan with some gray marbling, soft, occasional soft white clay inclusions. Shale is non-calcareous and weathered to total depth. Sand lense noted from 13.5' to 13.9'; fine grained, rust brown. Iron concretionary zone noted from 14.9' to 15.1'.	4. CARBONS: 1. 7.5' to 8.5' 2. 11.5' to 12.5' 3. 16.7' to 17.6' 4. 19.0' to 20.0'
7.0' to 20.0'			5. Core Boxes: 1. 7.0' to 13.4' 2. 13.4' to 20.0'

Hole No. 8A6C-302
 SHEET 1 of 1 SHEETS
DRILLING LOG *Southwestern* **INSTALLATION** *Fort Worth*
PROJECT *Aubrey Lake*
LOCATION *Spillway Site #2*
DRILLING AGENCY *Corps of Engineers*
DATE *8A6C-302*
NAME OF DRILLER *Schoonover*
SECTION OF HOLE *Vertical*
THICKNESS OF OVERBURDEN *6.5'*
DEPTH DRILLED INTO ROCK *19.5'*
TOTAL DEPTH OF HOLE *26.0'*

DEPTH	LEGEND	CLASSIFICATION OF MATERIALS	REMARKS
0.0' to 2.0'		CLAY - as described in interval below.	1. Installed slotted plastic pipe after bailing to near T.
2.0' to 6.5'		CLAY 2.0' to 4.0' - medium plasticity, brown, hard, silty to finely sandy, slightly moist, non-calcareous.	2. Drilling: 6" auger to 8.0'; 6" core to total depth of 25.0'.
4.0' to 6.5'		4.0' to 6.5' - as above interval; light brown.	3. JARS: A. 2.0' to 4.0' B. 4.0' to 6.5' C. 6.5' to 8.0' D. 13.0' to 14.0'
6.5' to 13.0'		CLAY-SHALE - soft, rust brown and gray, silty, highly weathered, non-calcareous, occasional fine gravel scattered throughout recovery; appears to be reworked shale. Core becoming calcareous at 12.0'.	4. CARBONS: 1. 8.0' to 9.0' 2. 14.0' to 15.0' 3. 20.1' to 21.1' 4. 24.7' to 25.5'
13.0' to 14.0'		CLAY - purpl, grad'd up to 2", clay to shaly matrix, angular to sub-angular, calcareous, easy to penetrate with core bit. (Labels in Jar D).	5. Core Box 2: 1. 8.0' to 15.0' 2. 15.3' to 15.0' 3. 19.8' to 25.5'
14.0' to 25.5'		SHALES - tan with some gray marbling, soft, occasional soft white clay inclusions. Occasional mill pockets of rust brown silt. Shale is non-calcareous and weathered to total depth.	6. Actual bottom of 0.9' from 13.1' to 14.0' - 20 po. r.v. gravel 17.7' to 19.5' to 20.0'. Corals sample D.

RECORD DRAWING - WORK AS FULL

DESIGNED BY	RAY ROBERTS LAKE
DRAWN BY	ELM FORK, TRINITY RIVER, TEXAS
CHECKED BY	EMBANKMENT, SPILLWAY AND
DATE	OUTLET WORKS
	LOGS OF BORINGS
	8A6C-91, 8A6DC-92, 8A6C-301, AND 8A6C-302
INVESTIGATED BY	INVITATION NO. DACR 63-82 B. 0010 DATE MAR, 1962
ISSUED	CONTRACT NO. DACR 63-54
	DRAWING NUMBER

Male No. 816C-303

PROJECT: Southwest Term		SHEET: 1 of 2	
LOCATION: Aubrey Lake Spillway Site #2		DATE: 21 Nov. 1975	
DRILLING AGENCY: Corps of Engineers		HOLE NO. (SEE SPECIFICATIONS): 816C-303	
NAME OF DRILLER: Schoonover		STARTED: 21 Nov. 1975	
DIRECTION OF HOLE: <input checked="" type="checkbox"/> VERTICAL		COMPLETED: 25 Nov. 1975	
THICKNESS OF OVERBURDEN: 11.0'		TOTAL CORE RECOVERY FOR SOILS: 00.3'	
DEPTH DRILLED INTO ROCK: 40.0'		SIGNATURE OF INSPECTOR: <i>Howard D. Logan</i>	
TOTAL DEPTH OF HOLE: 51.0'			

ELEVATION	DEPTH	LEGEND	CLASSIFICATION OF MATERIALS (Description)	SCORE RECOVERY	BOX OR SAMPLE NO.	REMARKS
0.0'	11.0'		CLAY		No Sample	1. Hole was bailed to near total depth upon completion. Unable to determine where hole is making water, but making water slowly. Installed slotted plastic pipe for water level observations. Water Levels: 26 Nov. '75 - 17.0' 1 Dec. '75 - 16.5'
0.0'	7.0'		CLAY - medium plasticity, brown, hard, silty to finely sandy, slightly moist, non-calcareous.		A	
11.0'	22.0'		CLAY-SHALE - rust brown, marbled gray, soft, non-calcareous; appears to be reworked shale; scattered ferrous nodules; very gravelly and calcareous from 18.3' to 19.3' with very fine grained light rust brown sand from 19.3' to 19.6'.		B	2. Drilling: 8" auger to 11.0'; 6" core to total depth of 51.0'. Set 3.0' of 8" casing due to fluid loss near surface.
11.0'	50.7'		SHALE		L 1.0 Bx 1	
22.0'	50.7'		SHALE		G 0.8	3. Jars: A. 2.0' to 7.0' B. 7.0' to 11.0'
22.0'	40.7'		SHALE - light tan to grayish tan, soft, non-calcareous, bedding angle approximately 5° from horizontal, occasional ferrous nodule with distinct iron concretionary zone from 26.3' to 26.8'; very fine grained light rust brown sandstone from 35.8' to 36.0' and from 37.4' to 37.7'; approaching base of extensive weathering from 38.0' to 40.7' as evidenced by intermittent short intervals of light bluish-gray shale.		L 0.8 Bx 2	
40.7'	50.7'		SHALE - light bluish-gray, soft, slightly silty, very fossiliferous (numerous fossils along parting at 44.3' and in Carton No. 8 at 49.7'); bedding is near horizontal; shale is calcareous from 40.7' to recovery depth of 50.7'.		L 0.0 Bx 3	4. Cartons: 1. 11.3' to 12.2' 2. 16.0' to 17.0' 3. 22.1' to 23.1' 4. 28.5' to 29.5' 5. 35.1' to 35.8' 6. 39.7' to 40.7' 7. 45.3' to 46.2' 8. 49.7' to 50.7'
40.7'	50.7'		SHALE - as described above.		L 0.0 Bx 4	
50.7'	50.7'		SHALE - as described above, approaching base of extensive weathering from 26.7' to 32.7' as evidenced by intermittent thin beds of bluish gray		L 0.0 Bx 5	5. Core Boxes: 1. 11.0' to 17.5' 2. 17.5' to 23.5' 3. 23.5' to 28.3' 4. 28.3' to 33.9' 5. 33.9' to 39.0' 6. 39.0' to 44.3' 7. 44.3' to 50.7'
50.7'	50.7'		SHALE - as described above, approaching base of extensive weathering from 26.7' to 32.7' as evidenced by intermittent thin beds of bluish gray		L 0.0 Bx 6	
50.7'	50.7'		SHALE - as described above, approaching base of extensive weathering from 26.7' to 32.7' as evidenced by intermittent thin beds of bluish gray		L 0.7 Bx 7	6. Distinct iron concretionary zone was noted from 26.7' to 29.2'. Shale becoming calcareous below 24.7'
50.7'	50.7'		SHALE - as described above, approaching base of extensive weathering from 26.7' to 32.7' as evidenced by intermittent thin beds of bluish gray		L 0.4 Bx 8	
50.7'	50.7'		SHALE - as described above, approaching base of extensive weathering from 26.7' to 32.7' as evidenced by intermittent thin beds of bluish gray		G 0.4 Bx 9	7. SHALE - unweathered, soft, bluish gray, varies from waxy to silty to very finely sandy, fossiliferous, calcareous.
						T. D. 51.0'

PROJECT: Southwestern		SHEET: 1 of 2	
LOCATION: Aubrey Lake Spillway Site #2		DATE: 21 Nov. 1975	
DRILLING AGENCY: Corps of Engineers		HOLE NO. (SEE SPECIFICATIONS): 816C-304	
NAME OF DRILLER: Schoonover		STARTED: 21 Nov. 1975	
DIRECTION OF HOLE: <input checked="" type="checkbox"/> VERTICAL		COMPLETED: 25 Nov. 1975	
THICKNESS OF OVERBURDEN: 2.0'		TOTAL CORE RECOVERY FOR SOILS: 49.0'	
DEPTH DRILLED INTO ROCK: 49.0'		SIGNATURE OF INSPECTOR: <i>Howard D. Logan</i>	
TOTAL DEPTH OF HOLE: 51.0'			

ELEVATION	DEPTH	LEGEND	CLASSIFICATION OF MATERIALS (Description)	SCORE RECOVERY	BOX OR SAMPLE NO.	REMARKS
0.0'	2.0'		CLAY - medium plasticity, brown, hard, silty to finely sandy, slightly moist, non-calcareous.			1. Hole was bailed to near total depth upon completion. Unable to determine where hole is making water, but making water slowly. Installed slotted plastic pipe for water level observations. Water Levels: 26 Nov. '75 - 17.0' 1 Dec. '75 - 16.5'
0.0'	15.7'		CLAY-SHALE			
2.0'	7.0'		CLAY-SHALE - rust brown, soft, non-calcareous; appears to be reworked shale; more moist from 4.0' to 7.0'.			2. Drilling: 8" auger to 11.0'; 6" core to total depth of 51.0'. Set 3.0' of 8" casing due to fluid loss near surface.
2.0'	50.7'		CLAY-SHALE - rust brown, soft, non-calcareous; appears to be reworked shale; more moist from 4.0' to 7.0'.		L 0.6' B	
7.0'	15.7'		CLAY-SHALE - rust brown, soft, non-calcareous; appears to be reworked shale; more moist from 4.0' to 7.0'.		G 0.2'	3. Jars: A. 2.0' to 7.0' B. 7.0' to 11.0'
7.0'	15.7'		CLAY-SHALE - rust brown, soft, non-calcareous; appears to be reworked shale; more moist from 4.0' to 7.0'.		L 0.0' B	
15.7'	14.0'		SANDSTONE - very fine grained, light rust brown, soft, well consolidated, non-calcareous.			4. Cartons: 1. 11.3' to 12.2' 2. 16.0' to 17.0' 3. 22.1' to 23.1' 4. 28.5' to 29.5' 5. 35.1' to 35.8' 6. 39.7' to 40.7' 7. 45.3' to 46.2' 8. 49.7' to 50.7'
15.7'	14.0'		SANDSTONE - very fine grained, light rust brown, soft, well consolidated, non-calcareous.		L 0.0' B	
14.0'	17.0'		SHALE - light tan to grayish tan, soft, silty, non-calcareous.			5. Core Boxes: 1. 11.0' to 17.5' 2. 17.5' to 23.5' 3. 23.5' to 28.3' 4. 28.3' to 33.9' 5. 33.9' to 39.0' 6. 39.0' to 44.3' 7. 44.3' to 50.7'
14.0'	17.0'		SHALE - light tan to grayish tan, soft, silty, non-calcareous.		L 0.0' B	
17.0'	17.6'		SANDSTONE - as described in interval 15.7' to 14.0'.			6. Distinct iron concretionary zone was noted from 26.7' to 29.2'. Shale becoming calcareous below 24.7'
17.0'	17.6'		SANDSTONE - as described in interval 15.7' to 14.0'.		L 0.0' B	
17.6'	19.8'		SHALE - as described above.			7. SHALE - unweathered, soft, bluish gray, varies from waxy to silty to very finely sandy, fossiliferous, calcareous.
17.6'	19.8'		SHALE - as described above.		L 0.1' B	
19.8'	20.2'		SANDSTONE - as described above.			8. Distinct iron concretionary zone was noted from 26.7' to 29.2'. Shale becoming calcareous below 24.7'
19.8'	20.2'		SANDSTONE - as described above.		L 0.1' B	
20.2'	20.6'		SHALE - as described above.			9. SHALE - unweathered, soft, bluish gray, varies from waxy to silty to very finely sandy, fossiliferous, calcareous.
20.2'	20.6'		SHALE - as described above.		C 0.5' B	
20.6'	22.8'		SANDSTONE - as described above with approximately 5° from horizontal bedding angle.			10. SHALE - unweathered, soft, bluish gray, varies from waxy to silty to very finely sandy, fossiliferous, calcareous.
20.6'	22.8'		SANDSTONE - as described above with approximately 5° from horizontal bedding angle.		L 0.0' B	
22.8'	32.7'		SHALE - as described above, approaching base of extensive weathering from 26.7' to 32.7' as evidenced by intermittent thin beds of bluish gray			11. SHALE - unweathered, soft, bluish gray, varies from waxy to silty to very finely sandy, fossiliferous, calcareous.
22.8'	32.7'		SHALE - as described above, approaching base of extensive weathering from 26.7' to 32.7' as evidenced by intermittent thin beds of bluish gray		L 0.9' B	
32.7'	51.0'		SHALE - as described above, approaching base of extensive weathering from 26.7' to 32.7' as evidenced by intermittent thin beds of bluish gray			12. SHALE - unweathered, soft, bluish gray, varies from waxy to silty to very finely sandy, fossiliferous, calcareous.
32.7'	51.0'		SHALE - as described above, approaching base of extensive weathering from 26.7' to 32.7' as evidenced by intermittent thin beds of bluish gray		C 0.5' B	
51.0'	51.0'		SHALE - as described above, approaching base of extensive weathering from 26.7' to 32.7' as evidenced by intermittent thin beds of bluish gray			T. D. 51.0'

Southwestern	INSTALLATION	SHEET 1 OF 2 SHEETS
10 SITE AND TYPE OF BIT	Port Worth	8" Auger; 6" Core
11 DATE OF ELEVATION PROJECTIONS	11/15/75	
12 MANUFACTURER'S DESIGNATION OF DRILL	Palling 1500	
13 TOTAL NO. OF OVERBURDEN SAMPLES TAKEN	0	0
14 TOTAL NUMBER CORE BOXES	8	
15 ELEVATION GROUND WATER	8'	
16 DATE MOLE	1 Dec. 1975	3 Dec. 1975
17 ELEVATION TOP OF MOLE	2.0'	
18 TOTAL CORE RECOVERY FOR BORING	49.0'	
19 SIGNATURE OF INSPECTOR	<i>James T. Logan</i>	

CLASSIFICATION OF MATERIALS (Description)	ELEVATION	DEPTH	LEGEND	REMARKS (Disturbance, water level, etc.)
CLAY - medium plasticity, brown, hard, silty to finely sandy, slightly moist, non-calcareous.	0.0' to 2.0'	0.0'	1	1. Hole was bailed to near total depth upon completion. Water level 24 hours after completion at 16.0'. Hole was backfilled.
CLAY-SHALE	2.0' to 7.0'	2.0'	2	2. Drilling: 8" auger to 7.0'; 6" core to total depth of 51.0'. Jars: A. 2.0' to 4.0' B. 4.0' to 7.0'
CLAY-SHALE - as described above with some gray marbling and scattered ferrous nodules.	7.0' to 13.7'	7.0'	3	4. Cartons: 1. 7.5' to 8.5' 2. 12.5' to 15.5' 3. 17.8' to 24.4' 4. 25.4' to 28.7' 5. 27.6' to 32.0' 6. 31.0' to 32.0' 7. 39.5' to 45.5' 8. 45.5' to 46.5' 9. 50.0' to 51.0'
SANDSTONE - very fine grained, light rust brown, soft, well consolidated, non-calcareous.	13.7' to 14.0'	13.7'	4	5. Core Boxes: 1. 7.0' to 12.5' 2. 12.5' to 18.9' 3. 18.9' to 24.7' 4. 24.7' to 30.3' 5. 30.3' to 36.0' 6. 36.0' to 41.7' 7. 41.7' to 47.5' 8. 47.5' to 51.0'
SHALE - light tan to grayish tan, soft, silty, non-calcareous.	14.0' to 17.6'	14.0'	5	
SANDSTONE - as described in interval 13.7' to 14.0'.	17.6' to 19.8'	17.6'	6	
SHALE - as described above.	19.8' to 20.2'	19.8'	7	
SANDSTONE - as described above.	20.2' to 20.6'	20.2'	8	
SHALE - as described above.	20.6' to 22.8'	20.6'	9	
SANDSTONE - as described above with approximately 9° from horizontal bedding angle.	22.8' to 32.7'	22.8'	10	
SHALE - as described above, approaching base of extensive weathering from 26.7' to 32.7' as evidenced by intermittent thin beds of bluish gray distinct iron concretionary zones was noted from 7' to 29.2'. Shale coarsening calcareous below 7'.	32.7' to 51.0'	32.7'	11	

Southwestern	INSTALLATION	SHEET 1 OF 2 SHEETS
10 SITE AND TYPE OF BIT	Port Worth	8" Auger; 6" Core
11 DATE OF ELEVATION PROJECTIONS	11/15/75	
12 MANUFACTURER'S DESIGNATION OF DRILL	Palling 1500	
13 TOTAL NO. OF OVERBURDEN SAMPLES TAKEN	0	0
14 TOTAL NUMBER CORE BOXES	4	
15 ELEVATION GROUND WATER	4'	
16 DATE MOLE	3 Dec. 1975	4 Dec. 1975
17 ELEVATION TOP OF MOLE	2.0'	
18 TOTAL CORE RECOVERY FOR BORING	30.0'	
19 SIGNATURE OF INSPECTOR	<i>James T. Logan</i>	

CLASSIFICATION OF MATERIALS (Description)	ELEVATION	DEPTH	LEGEND	REMARKS (Disturbance, water level, etc.)
CLAY	0.0' to 6.0'	0.0'	1	1. Hole was bailed to near total depth upon completion and slotted plastic pipe installed for water level observation. Water level after 24 hours at 10.9'.
CLAY	6.0' to 12.0'	6.0'	2	2. Drilling: 8" auger to 7.0'; 6" core to total depth of 30.0'. Jars: A. 2.0' to 4.0' B. 4.0' to 6.0' C. 6.0' to 7.0'
CLAY-SHALE - rust brown, soft, some gray mixed, scattered gravel and ferrous nodules, non-calcareous.	12.0' to 21.0'	12.0'	3	4. Cartons: 1. 7.5' to 8.5' 2. 12.9' to 13.9' 3. 14.5' to 15.5' 4. 21.0' to 22.0' 5. 29.0' to 30.0'
SHALE AND SANDSTONE - shale is dominant; light tan to grayish tan, silty, non-calcareous. Shale is interrupted with occasional thin beds of sandstones, notably from 14.5' to 17.3'; sandstone is light rust brown, very fine grained, soft and non-calcareous. Maximum thickness without shale interruption was 1.0' (Carton No. 3 from 14.5' to 15.5'). Shale was dominant from 17.3' to 20.7'. Last sandstone in this boring was logged from 20.7' to 21.0'.	21.0' to 30.0'	21.0'	4	5. Core Boxes: 1. 7.0' to 12.6' 2. 12.6' to 19.2' 3. 19.2' to 24.8' 4. 24.8' to 30.0'
SHALE - soft, light tan to grayish tan, silty, some very widely scattered calcite; iron concretionary zones, very calcareous noted from 27.4' to 29.9'. Shale is silty calcareous from this point to total depth and is weathered throughout.	30.0' to 51.0'	30.0'	5	

Southwestern	INSTALLATION	SHEET 1 OF 2 SHEETS
10 SITE AND TYPE OF BIT	Port Worth	8" Auger; 6" Core
11 DATE OF ELEVATION PROJECTIONS	11/15/75	
12 MANUFACTURER'S DESIGNATION OF DRILL	Palling 1500	
13 TOTAL NO. OF OVERBURDEN SAMPLES TAKEN	0	0
14 TOTAL NUMBER CORE BOXES	4	
15 ELEVATION GROUND WATER	4'	
16 DATE MOLE	3 Dec. 1975	4 Dec. 1975
17 ELEVATION TOP OF MOLE	2.0'	
18 TOTAL CORE RECOVERY FOR BORING	30.0'	
19 SIGNATURE OF INSPECTOR	<i>James T. Logan</i>	

CLASSIFICATION OF MATERIALS (Description)	ELEVATION	DEPTH	LEGEND	REMARKS (Disturbance, water level, etc.)
CLAY	0.0' to 6.0'	0.0'	1	1. Hole was bailed to near total depth upon completion and slotted plastic pipe installed for water level observation. Water level after 24 hours at 10.9'.
CLAY	6.0' to 12.0'	6.0'	2	2. Drilling: 8" auger to 7.0'; 6" core to total depth of 30.0'. Jars: A. 2.0' to 4.0' B. 4.0' to 6.0' C. 6.0' to 7.0'
CLAY-SHALE - rust brown, soft, some gray mixed, scattered gravel and ferrous nodules, non-calcareous.	12.0' to 21.0'	12.0'	3	4. Cartons: 1. 7.5' to 8.5' 2. 12.9' to 13.9' 3. 14.5' to 15.5' 4. 21.0' to 22.0' 5. 29.0' to 30.0'
SHALE AND SANDSTONE - shale is dominant; light tan to grayish tan, silty, non-calcareous. Shale is interrupted with occasional thin beds of sandstones, notably from 14.5' to 17.3'; sandstone is light rust brown, very fine grained, soft and non-calcareous. Maximum thickness without shale interruption was 1.0' (Carton No. 3 from 14.5' to 15.5'). Shale was dominant from 17.3' to 20.7'. Last sandstone in this boring was logged from 20.7' to 21.0'.	21.0' to 30.0'	21.0'	4	5. Core Boxes: 1. 7.0' to 12.6' 2. 12.6' to 19.2' 3. 19.2' to 24.8' 4. 24.8' to 30.0'
SHALE - soft, light tan to grayish tan, silty, some very widely scattered calcite; iron concretionary zones, very calcareous noted from 27.4' to 29.9'. Shale is silty calcareous from this point to total depth and is weathered throughout.	30.0' to 51.0'	30.0'	5	

Male No. 8A6C-305

INSTALLATION Port Worth SHEET 1 OF 1 SHEETS

10 SIZE AND TYPE OF BIT 8" AUGER 6" CORE

11 LOCATION (COUNTY AND CITY OR TOWNSHIP AND ELEVATION) Spillway Site "K"

12 MANUFACTURER'S DESIGNATION OF DRILL PAULING 1500

13 TOTAL NO. OF OVERBURDEN SAMPLES TAKEN 2 0

14 TOTAL NUMBER CORE BOXES 5

15 ELEVATION GROUND WATER

16 DATE MOLE STARTED 3 Dec. 1975 COMPLETED 4 Dec. 1975

17 ELEVATION TOP OF MOLE

18 TOTAL CORE RECOVERY FOR BORING 100

19 DEPTH DRILLED INTO ROCK 25.2'

20 SIGNATURE OF INSPECTOR *James H. Logan*

21 TOTAL DEPTH OF MOLE 30.0'

CLASSIFICATION OF MATERIALS (Description)

1. Hole was bailed to near total depth upon completion and slotted plastic pipe installed for water level observation. Water level after 24 hours at 10.9'.

2. Drilling: 8" auger to 7.0'; 6" core to total depth of 30.0'.

3. Jars:
A. 2.0' to 4.0'
B. 4.0' to 6.0'
C. 6.0' to 7.0'

4. Cartons:
1. 7.5' to 8.5'
2. 12.9' to 13.9'
3. 14.5' to 15.5'
4. 21.0' to 22.0'
5. 29.0' to 30.0'

5. Core Boxes:
1. 7.0' to 12.6'
2. 12.6' to 19.2'
3. 19.2' to 24.8'
4. 24.8' to 30.0'

SHALE - rust brown, soft, some gray mixed, scattered gravel and ferruginous nodules, non-calcareous.

SHALE AND SANDSTONE - shale is dominant; light tan to grayish tan, silty, non-calcareous. Shale is interrupted with occasional thin beds of sandstone, notably from 14.5' to 17.3'; sandstone is light rust brown, very fine grained, soft and non-calcareous. Maximum thickness without shale interruption was 4.0' (Carton No. 3 from 14.5' to 15.5'). Shale was dominant from 17.3' to 20.7'. Last sandstone in this boring was logged from 20.7' to 21.0'.

SHALE - light tan to gray, (predominantly gray below 25.0'), silty, scattered small crystals of selenite, slightly calcareous; iron concretionary zone, very calcareous, noted from 21.9' to 22.4'. Some very fine-grained gray sand interbedded with shale below 29.0'. Shale is weathered to total depth.

T. D. 30.0'

PROJECT Aubrey Lake HOLE NO. 8A6C-305

Male No. 8A6C-306

DRILLING LOCATION Southwestern INSTALLATION Port Worth SHEET 1 OF 1 SHEETS

1 PROJECT Aubrey Lake

2 LOCATION (COUNTY AND CITY OR TOWNSHIP AND ELEVATION) Spillway Site "K"

3 DRILLING AGENCY Corps of Engineers

4 HOLE NO. (As shown on drawings and site number) 8A6C-306

5 NAME OF DRILLER Schoonover

6 DIRECTION OF MOLE VERTICAL

7 THICKNESS OF OVERBURDEN 5.0'

8 DEPTH DRILLED INTO ROCK 25.2'

9 TOTAL DEPTH OF MOLE 30.2'

10 SIZE AND TYPE OF BIT 8" AUGER 6" CORE

11 LOCATION (COUNTY AND CITY OR TOWNSHIP AND ELEVATION) Spillway Site "K"

12 MANUFACTURER'S DESIGNATION OF DRILL PAULING 1500

13 TOTAL NO. OF OVERBURDEN SAMPLES TAKEN 1 0

14 TOTAL NUMBER CORE BOXES 4

15 ELEVATION GROUND WATER

16 DATE MOLE STARTED 14 Dec. 1975 COMPLETED 15 Dec. 1975

17 ELEVATION TOP OF MOLE

18 TOTAL CORE RECOVERY FOR BORING 100

19 SIGNATURE OF INSPECTOR *James H. Logan*

20 SIGNATURE OF INSPECTOR *James H. Logan*

21 TOTAL DEPTH OF MOLE 30.2'

CLASSIFICATION OF MATERIALS (Description)

0.0' to 5.0'

CLAY

0.0' to 2.0' - medium plasticity, light brown, hard, silty, sandy, slightly moist, non-calcareous.

2.0' to 5.0' - medium plasticity, light brown, very stiff, silty, slightly moist, non-calcareous.

5.0' to 7.0'

CLAY-SHALE - rust brown and gray, soft, silty, appears to be unworked shale, non-calcareous.

7.0' to 19.5'

SHALE AND SANDSTONE - shale is dominant; light tan to grayish tan, silty, non-calcareous. Shale is interrupted with occasional beds of sandstone, notably from 12.4' to 19.5' with maximum thickness of 1.5' from 14.2' to 15.7' (see carton No. 2). Sandstone is light rust brown, very fine grained, well consolidated, soft, and non-calcareous. Shale as described above is dominant below this point with last sandstone in this interval logged from 19.3' to 19.5'.

19.5' to 30.2'

SHALE - light tan to gray, (predominantly gray below 25.0'), silty, scattered small crystals of selenite, slightly calcareous; iron concretionary zone, very calcareous, noted from 21.9' to 22.4'. Some very fine-grained gray sand interbedded with shale below 29.0'. Shale is weathered to total depth.

T. D. 30.2'

PROJECT Aubrey Lake HOLE NO. 8A6C-306

RECORD DRAWING-WORK AS BUILT

SYN	DC	NO	ACTION	DATE	DESCRIPTION OF REVISION
U.S. ARMY ENGINEER DISTRICT, FORT WORTH CORPS OF ENGINEERS FORT WORTH, TEXAS					
DESIGNED BY:	RAY ROBERTS LAKE				
DRAWN BY:	ELM FORK, TRINITY RIVER, TEXAS				
CHECKED BY:	EMBANKMENT, SPILLWAY AND				
REVIEWED BY:	OUTLET WORKS				
SUBMITTED BY:	LOGS OF BORINGS				
ENGINEER	8A6C-303, 8A6C-304, 8A6C-305, AND 8A6C-306				
INVITATION NO. DACW63-82-B-0025			DATE: MAR. 1982		
CONTRACT NO. DACW63-82-C-0093			SEQUENCE NO.		
DRAWING NUMBER			33		

TO ACCOMPANY FOUNDATION REPORT

CONTRACT NO. DACW63-82-C-0093

DRILLING LOG	Division Southwestern	INSTALLATION	Port 7	SHEET 1 OF 1 SHEETS
PROJECT	Aubrey Lake	NO. RECORD TYPE OF BIT	6" Auger	6" Core
LOCATION (Continent, State, County, Township, Range, Section)	Railway Site #2			
DRILLING AGENCY	Corps of Engineers	DATE OF LOG	Falling 1900	
HOLE NO. (As shown on drawing sheet and file number)	816C-308	TOTAL NO. OF CORE BOXES	1	
NAME OF DRILLER	Seboonover	TOTAL NUMBER CORE BOXES	1	
DIRECTION OF HOLE	VERTICAL	DATE MOLE	18 Dec. 1975	
THICKNESS OF OVERBURDEN	3.5'	ELEVATION TOP OF MOLE	17.1'	
DEPTH DRILLED INTO ROCK	17.1'	TOTAL CORE RECOVERY FOR BORING	20.6'	
TOTAL DEPTH OF HOLE	20.6'	SIGNATURE OF INSPECTOR	<i>Thomas H. Logan</i>	

ELEVATION	DEPTH	LEGEND	CLASSIFICATION OF MATERIALS (Description)	REMARKS (Logging time, water level, etc., if appropriate)
0.0'	4.5'		CLAY - medium plasticity, brown, hard, silty, sandy, slightly moist, non-calcareous.	No Sample
4.5'	10.0'		CLAY-SHALE - rust brown, some gray mottled, soft, appears to be reworked shale, scattered small ferrous nodules, non-calcareous.	1. Hole bailed to near total depth upon completion and slotted plastic pipe installed for water level observation.
10.0'	24.7'		SHALE, SILTSTONE AND SANDSTONE - shale is light tan, some gray marbling, soft, variously grades into thin beds of siltstone and very fine grained sandstones; light rust brown and non-calcareous. Maximum thickness of sandstone is 0.8' from 18.3' to 19.1'. Last sandstone logged this interval from 22.0' to 22.3', brown, fine grained and calcareous. Shale as previously described becoming gray, slightly calcareous below 22.3'. Iron concretionary zone, very calcareous, noted from 24.5' to 24.7'.	2. Drilling: 6" auger to 7.0'; 6" core to total depth of 25.0'. 3. Jars: A. 2.0' to 4.5' B. 4.5' to 7.0' 4. Cartons: 1. 7.7' to 8.7' 2. 12.7' to 13.5' 3. 19.2' to 20.0' 4. 23.0' to 24.0' 5. Core Boxes: 1. 7.0' to 12.7' 2. 12.7' to 18.3' 3. 18.3' to 24.7'
20.0'	25.0'			

DRILLING LOG	Division Southwestern	INSTALLATION	Port 7	SHEET 1 OF 1 SHEETS
PROJECT	Aubrey Lake	NO. RECORD TYPE OF BIT	6" Auger	6" Core
LOCATION (Continent, State, County, Township, Range, Section)	Railway Site #2			
DRILLING AGENCY	Corps of Engineers	DATE OF LOG	Falling 1900	
HOLE NO. (As shown on drawing sheet and file number)	816C-308	TOTAL NO. OF CORE BOXES	1	
NAME OF DRILLER	Seboonover	TOTAL NUMBER CORE BOXES	1	
DIRECTION OF HOLE	VERTICAL	DATE MOLE	9 Dec. 1975	
THICKNESS OF OVERBURDEN	3.5'	ELEVATION TOP OF MOLE	17.1'	
DEPTH DRILLED INTO ROCK	17.1'	TOTAL CORE RECOVERY FOR BORING	20.6'	
TOTAL DEPTH OF HOLE	20.6'	SIGNATURE OF INSPECTOR	<i>Thomas H. Logan</i>	

ELEVATION	DEPTH	LEGEND	CLASSIFICATION OF MATERIALS (Description)	REMARKS (Logging time, water level, etc., if appropriate)
0.0'	3.5'		CLAY - medium plasticity, brown, hard, silty to finely sandy, slightly moist, non-calcareous.	No Sample
3.5'	4.5'		CLAY-SHALE - rust brown to reddish brown, some gray, soft, gravelly (composed mostly of small ferrous nodules), some calcareous granules.	1. Hole bailed total depth upon completion and plastic pipe installed for water level observation.
10.0'	20.6'		SHALE AND SANDSTONE - predominantly shale, light tan to grayish tan, soft, non-calcareous with interruptions of light rust brown, fine grained sandstone noted at the following intervals: 10.5' to 11.0'; 11.5' to 12.3'; 12.8' to 14.9'; 16.9' to 17.2'. Shale becoming slightly calcareous from 17.2' to total depth. Iron concretionary zone, very calcareous from 20.0' to 20.4'.	2. Drilling: 6" auger to 7.0'; 6" core to total depth. 3. Jars: A. 2.0' to 3.5' B. 3.5' to 4.5' 4. Cartons: 1. 8.4' to 12.7' 2. 14.4' to 19.0' 5. Core Boxes: 1. 7.0' to 12.8' 2. 12.8' to 20.0' 3. 20.0' to 20.6'
20.0'	20.6'			

Hole No. 816C-309

DIVISION Southwestern		INSTALLATION Fort Worth		SHEET 1 of 1 SHEETS	
PROJECT Aubrey Lake		HOLE NO. AND TYPE OF BIT 6" AUGER 6" CORE		DATE AND TIME OF ELEVATION 10 Dec 1975	
LOCATION (County or Station) Spillway Site #F		MANUFACTURER'S DESIGNATION OF DRILL Falling 1500		TOTAL NO. OF OVERBURDEN SAMPLES TAKEN 1	
DRILLING AGENCY Corps of Engineers		TOTAL NO. OF OVERBURDEN SAMPLES TAKEN 1		UNDISTURBED 0	
DRILLER Schoonover		TOTAL NUMBER CORE BOXES 3		ELEVATION GROUND WATER 00	
DIRECTION OF HOLE <input type="checkbox"/> VERTICAL <input type="checkbox"/> INCLINED		DATE HOLE STARTED 9 Dec 1975		DATE HOLE COMPLETED 9 Dec 1975	
THICKNESS OF OVERBURDEN 3.5'		ELEVATION TOP OF HOLE 17.1'		TOTAL CORE RECOVERY FOR BORING 100	
DEPTH DRILLED INTO ROCK 17.1'		SIGNATURE OF INSPECTOR <i>James H. Logan</i>			
DEPTH OF HOLE 20.6'					

DEPTH	LEGEND	CLASSIFICATION OF MATERIALS (Description)	NO. OF CORE RECOVERY BOX OR SAMPLE NO.	REMARKS (Drilling time, water flow, depth of overburden, etc., if significant)
0.0' to 3.5'		CLAY - medium plasticity, brown, hard, silty to finely sandy, slightly moist, non-calcareous.	No Sample	1. Hole bailed to near total depth upon completion and slotted plastic pipe installed for water level observation.
3.5' to 4.5'		CLAY-SHALE - rust brown to reddish brown, some gray, soft, gravelly (composed mostly of small ferrous nodules), some calcareous greenish.	A	2. Drilling: 8" auger to 7.0'; 6" core to total depth of 20.6'.
4.5' to 20.6'		SHALE AND SANDSTONE - predominantly shale, light tan to grayish tan, soft, non-calcareous with interruptions of light rust brown, fine grained sandstone noted at the following intervals: 10.5' to 11.0'; 11.5' to 12.3'; 12.8' to 14.9'; 16.9' to 17.2'. Shale becoming slightly calcareous from 17.2' to total depth. Iron concretionary zone, very calcareous from 20.0' to 20.4'.	L 0.4' Bx 1 L 0.5' Bx 2 O 0.9' Bx 3	3. Jars: A. 2.0' to 3.5' B. 3.5' to 4.5' C. 4.5' to 7.0' 4. Cartons: 1. 8.4' to 9.4' 2. 14.4' to 15.4' 3. 19.0' to 20.0' 5. Core Boxes: 1. 7.0' to 12.8' 2. 12.8' to 20.0' 3. 20.0' to 20.6'
T. D. 20.6'				

Hole No. 816C-309

DIVISION Southwestern		INSTALLATION Fort Worth		SHEET 1 of 1 SHEETS	
PROJECT Aubrey Lake		HOLE NO. AND TYPE OF BIT 6" AUGER 6" CORE		DATE AND TIME OF ELEVATION 10 Dec 1975	
LOCATION (County or Station) Spillway Site #F		MANUFACTURER'S DESIGNATION OF DRILL Falling 1500		TOTAL NO. OF OVERBURDEN SAMPLES TAKEN 1	
DRILLING AGENCY Corps of Engineers		TOTAL NO. OF OVERBURDEN SAMPLES TAKEN 1		UNDISTURBED 0	
DRILLER Schoonover		TOTAL NUMBER CORE BOXES 3		ELEVATION GROUND WATER 00	
DIRECTION OF HOLE <input type="checkbox"/> VERTICAL <input type="checkbox"/> INCLINED		DATE HOLE STARTED 10 Dec 1975		DATE HOLE COMPLETED 10 Dec 1975	
THICKNESS OF OVERBURDEN 4.5'		ELEVATION TOP OF HOLE 10.0'		TOTAL CORE RECOVERY FOR BORING 100	
DEPTH DRILLED INTO ROCK 10.5'		SIGNATURE OF INSPECTOR <i>James H. Logan</i>			
TOTAL DEPTH OF HOLE 15.0'					

ELEVATION	DEPTH	LEGEND	CLASSIFICATION OF MATERIALS (Description)	NO. OF CORE RECOVERY BOX OR SAMPLE NO.	REMARKS (Drilling time, water flow, depth of overburden, etc., if significant)
0.0' to 4.5'			CLAY - medium plasticity, brown, hard, silty to finely sandy, slightly moist, becoming more moist from 2.0' to 4.5', slightly calcareous.	No Sample	1. Hole was bailed to near total depth upon completion and slotted plastic pipe installed for water level observation.
4.5' to 9.9'			CLAY-SHALE - appears to be reworked shale, rust brown, marbled gray, soft, abundant calcareous nodules throughout, moist. Clay-shale is gravelly (mostly ferrous nodules) throughout this interval. Calcareous from 9.3' to 9.9'.	Actual Loss 1.4' L 0.6' Bx 1 G 0.6'	2. Drilling: 8" auger to 7.0'; 6" core to total depth of 15.0'. 3. Jars: A. 2.0' to 4.5' B. 4.5' to 7.0' 4. Cartons: 1. 7.5' to 8.5' 2. 14.0' to 15.0'
9.9' to 11.3'			Core lost due to grinding.		5. Core Box: 1. 7.0' to 15.0'
11.3' to 15.0'			SHALE AND SANDSTONE - shale is tan, to grayish tan, soft, silty, finely sandy and is interrupted by tan very fine grained sandstone at the following intervals: 11.8' to 12.0'; 12.5' to 13.3'. Ironstone noted from 13.3' to 13.4'. Shale and sandstone is non-calcareous.		
T. D. 15.0'					

36 PREVIOUS EDITIONS ARE OBSOLETE. PROJECT Aubrey Lake HOLE NO. 816C-309

ENG FORM 18 36 PREVIOUS EDITIONS ARE OBSOLETE. PROJECT Aubrey Lake HOLE NO. 816C-309

Map No. **8A-311**

DRILLING LOG		DIVISION Southwestern		INSTALLATION Fort Worth		SHEET of 4 SHEETS	
1. PROJECT Aubrey Dam				16. SIZE AND TYPE OF BIT BUGER			
2. LOCATION (Name of Dam or Structure) Outlet Works				17. DATE FOR ELEVATION TOOK (T.M. or M.D.)			
3. DRILLING AGENCY USCE				18. MANUFACTURER'S DESIGNATION OF DRILL Falling 1500			
4. HOLE NO. (As shown on drawing title and file number) 8A-311				19. TOTAL NO. OF OVERBURDEN SAMPLES TAKEN		20. UNDISTURBED	
5. NAME OF DRILLER Mullina				19. TOTAL NUMBER CORE BOXES		19. ELEVATION GROUND WATER	
6. DIRECTION OF HOLE <input type="checkbox"/> VERTICAL <input type="checkbox"/> INCLINED _____ DEG. FROM VERT.				14. DATE HOLE 5		15. DATE HOLE 19 Sep 80	
7. THICKNESS OF OVERBURDEN 13.8				17. ELEVATION TOP OF HOLE 573.6 (offset elev)			
8. DEPTH DRILLED INTO ROCK 2.2				18. TOTAL CORE RECOVERY FOR BORING			
9. TOTAL DEPTH OF HOLE 16.0				19. SIGNATURE OF INSPECTOR <i>J.P. [Signature]</i>			
ELEVATION	DEPTH	LEGEND	CLASSIFICATION OF MATERIALS (Description)	% CORE RECOVERY	BOX OR SAMPLE NO.	REMARKS (Disturb from water level, depth of weathering, etc., if significant)	DRILLING IN-DEPTH
			0.0' to 1.0' SILT , medium stiff, dry, low plasticity, dark brown.		A	**** 1. Hole was dry after completion. 16 hour check, level was 15.4' 2. Jars: A. 0.0 to 1.0 B. 1.0 to 6.7 C. 6.7 to 12.0 D. 12.0 to 13.8 E. 13.8 to 16.0 3. Hole offset 30 ft. on a bearing of N 90° E.	
			1.0' to 6.7' CLAY , low plasticity, medium stiff, silty, sandy, slightly moist, red and tan.		B		
			6.7' to 12.0' CLAY , low plasticity, medium stiff, sandy, moist, tan and gray.		C		
			12.0' to 13.8' SAND , gravelly, medium dense, clayey, tan and brown.		D		
			13.8' to 16.0' SHALE , reworked in upper 0.3', unweathered dark gray.		E		
			T.D. - 16.0' -				

ENG FORM 1836 MAR 71 PREVIOUS EDITIONS ARE OBSOLETE. PROJECT **Aubrey Dam** HOLE NO. **8A-311**

Map No. **8A-311**

DRILLING LOG		DIVISION Southwestern		INSTALLATION Fort Worth		SHEET of 4 SHEETS	
1. PROJECT Aubrey Dam				16. SIZE AND TYPE OF BIT BUGER			
2. LOCATION (Name of Dam or Structure) Outlet Works				17. DATE FOR ELEVATION TOOK (T.M. or M.D.)			
3. DRILLING AGENCY USCE				18. MANUFACTURER'S DESIGNATION OF DRILL Falling 1500			
4. HOLE NO. (As shown on drawing title and file number) 8A-312				19. TOTAL NO. OF OVERBURDEN SAMPLES TAKEN		20. UNDISTURBED	
5. NAME OF DRILLER Mullina				19. TOTAL NUMBER CORE BOXES		19. ELEVATION GROUND WATER	
6. DIRECTION OF HOLE <input checked="" type="checkbox"/> VERTICAL <input type="checkbox"/> INCLINED _____ DEG. FROM VERT.				14. DATE HOLE 5		15. DATE HOLE 19 Sep 80	
7. THICKNESS OF OVERBURDEN 15.0				17. ELEVATION TOP OF HOLE 573.6 (offset elev)			
8. DEPTH DRILLED INTO ROCK 0.5				18. TOTAL CORE RECOVERY FOR BORING			
9. TOTAL DEPTH OF HOLE 15.5				19. SIGNATURE OF INSPECTOR <i>J.P. [Signature]</i>			
ELEVATION	DEPTH	LEGEND	CLASSIFICATION OF MATERIALS (Description)	% CORE RECOVERY	BOX OR SAMPLE NO.	REMARKS (Disturb from water level, depth of weathering, etc., if significant)	DRILLING IN-DEPTH
			0.0' to 2.0' SAND , fine grained, medium dense, dry, brown.		A	**** 1. Aug rated 24 hours 2. Jars: A. 0. B. 2. C. 5. D. 7. E. 12. F. 15. 3. Ho. on : N80° Ina: Ele: tail	
			2.0' to 12.0' GRAVEL , coarse to fine grained, medium dense, moist from 2' to 3', damp from 5' to 7', becomes saturated at 7'.		B		
			12.0' to 15.0' CLAY , medium plasticity, very stiff, moist, gravelly, brown.		C		
			15.0' to 15.5' SHALE , unweathered, soft, dark gray.		D		
			T.D. - 15.5' -		E		

ENG FORM 1836 MAR 71 PREVIOUS EDITIONS ARE OBSOLETE. PROJECT **Aubrey Lake** HOLE NO. **8A-312**

Hole No. BA-312

INSTALLATION Fort Worth		SHEET 1 of 1 SHEETS	
1. PROJECT Aubrey Dam			
2. LOCATION (Company or Station) Outlet			
3. DRILLING AGENCY USCE-C			
10. SIZE AND TYPE OF BIT Falling 1500		11. DATE AND TIME OF ELEVATION MEASUREMENT 19 Sep 80	
12. MANUFACTURER'S DESIGNATION OF DRILL Falling 1500		13. TOTAL NO. OF OVERBURDEN SAMPLES TAKEN 6	
14. TOTAL NUMBER CORE BORES		15. ELEVATION GROUND WATER	
16. DATE HOLE STARTED 19 Sep 80		17. DATE HOLE COMPLETED 19 Sep 80	
18. ELEVATION TOP OF HOLE 567.9		19. THICKNESS OF OVERBURDEN 29.5	
20. TOTAL CORE RECOVERY FOR BORING 15.5		21. SIGNATURE OF INSPECTOR J.P. [Signature]	
REMARKS (Listing time, time from, depth of overburden, etc., if significant)			
1. Augered into saturated gravel at 7'. 24 hour check - level was same.			
2. Jars: A. 0.0 to 2.0 B. 2.0 to 3.0 C. 3.0 to 7.0 D. 7.0 to 12.0 E. 1. ? to 15.0 F. 15.0 to 15.5			
3. Hole offset 80. ft. on a bearing of N80°E due to inaccessible terrain. Elevation was obtained with level.			

CLASSIFICATION OF MATERIALS (Description)	1. CORE RECOVERY	2. CORE SAMPLE NO.	3. ELEVATION	4. DEPTH
0.0' to 2.0' SAND, fine grained, medium dense, dry, brown.	A			
2.0' to 12.0' GRAVEL, coarse to fine grained, medium dense, moist from 2' to 5', damp from 5' to 7', becomes saturated at 7'.	B			
12.0' to 15.0' CLAY, medium plasticity, very stiff, moist, gravelly, brown.	C			
15.0' to 15.5' SLATE, unweathered, soft, dark gray.	D			
T.D. - 15.5'	E			

NOTES ARE OBSOLETE. PROJECT: Aubrey Lake HOLE NO.: BA-312

Hole No. GDC-313

INSTALLATION FWD		SHEET 1 of 3 SHEETS	
1. PROJECT Aubrey Dam			
2. LOCATION (Company or Station) Outlet			
3. DRILLING AGENCY USCE-C			
10. SIZE AND TYPE OF BIT Falling 1500		11. DATE AND TIME OF ELEVATION MEASUREMENT 29 Aug	
12. MANUFACTURER'S DESIGNATION OF DRILL Falling 1500		13. TOTAL NO. OF OVERBURDEN SAMPLES TAKEN 14	
14. TOTAL NUMBER CORE BORES		15. ELEVATION GROUND WATER	
16. DATE HOLE STARTED 29 Aug		17. DATE HOLE COMPLETED 10 Sep 80	
18. ELEVATION TOP OF HOLE		19. THICKNESS OF OVERBURDEN 99	
20. TOTAL CORE RECOVERY FOR BORING 83.2		21. SIGNATURE OF INSPECTOR McVern to 39'. Cole to T.D.	
REMARKS (Listing time, time from, depth of overburden, etc., if significant)			
1. Bailed hole to near T.D., 24 hr. check, water @ 23.5'.			
2. Jars: A. 0.0 to 4.0 B. 4.0 to 5.0 C. 5.0 to 5.5 D. 7.0 E. 9.0 F. 11.0 G. 11.0 to 13.0 H. 15.0 I. 17.0 J. 18.0 K. 20.0 L. 20.0 to 21.5 M. 21.5 to 26.5 N. 26.5 to 29.5 O. 29.5 to 32.0			
3. Denison cans: 1. 5.5 to 7.0 2. 7.0 to 9.0 3. 9.0 to 11.0 4. 13.0 to 15.0 5. 15.0 to 17.0 6. 18.0 to 20.0			
4. Cartons: 1-35.3 to 36.3 2-41.9 to 42.9 3-45.6 to 46.5 4-50.5 to 51.3 5-57.3 to 58.3 6-65.8 to 66.8 7-69.9 to 70.6 8-75.3 to 76.3 9-81.9 to 82.9			
5. Drillings: 0.0' to 5.0', 8" auger, Set 5.0' casing 5.0' to 21.5', 6" denison casing as drill progressed 21.5' to 32.0', 8" auger			

CLASSIFICATION OF MATERIALS (Description)	1. CORE RECOVERY	2. CORE SAMPLE NO.	3. ELEVATION	4. DEPTH
0.0' to 16.0' CLAY	A			
0.0' to 4.0', low plasticity, hard, dry, brown, silty.	B			
4.0' to 6.5', med. plast., v. stiff, dry, strong brown, sl. sandy.	C			
6.5' to 16.0', med./low plast., stiff, dry, yellowish brown, silty, lime nodules and sand below 15.0'.	D			
16.0' to 21.5' SAND, fine grained, clayey & silty seams within, sl. gravelly, dry, strong brown, & yellow brown w/ light gray.	E			
21.5' to 29.5' GRAVEL, coarse to fine & round, damp to moist? (drill fluid still in hole), strong brn. clayey, sandy.	F			
29.5' to 82.9' CLAYSHALE, unweath., dk, gray, soft to mod. soft (R. classif) massive, silty w/ interbeds of thin silty & sandy seams @ 10-12 degrees. Several med. hard SANDSTONE seams as indicated below: 45.6-45.9 49.6-50.9 50.4-52.1 57.0-57.3 61.2-61.4 64.1-64.4 64.9-65.0 66.7-66.8	G			
Highly fossilif. zone from 69.9 to 70.4 (ctn. #7).	H			
Structural features as follows: 43.4 open fract 47.1 " " 51.5 " " 64.2 " "	I			

NOTES ARE OBSOLETE. PROJECT: GDC-313

INSTALLATION FWD		SHEET 1 of 3 SHEETS	
1. PROJECT AUB			
2. LOCATION (Company or Station)			
3. DRILLING AGENCY			
10. SIZE AND TYPE OF BIT		11. DATE AND TIME OF ELEVATION MEASUREMENT	
12. MANUFACTURER'S DESIGNATION OF DRILL		13. TOTAL NO. OF OVERBURDEN SAMPLES TAKEN	
14. TOTAL NUMBER CORE BORES		15. ELEVATION GROUND WATER	
16. DATE HOLE STARTED		17. DATE HOLE COMPLETED	
18. ELEVATION TOP OF HOLE		19. THICKNESS OF OVERBURDEN	
20. TOTAL CORE RECOVERY FOR BORING		21. SIGNATURE OF INSPECTOR	
REMARKS (Listing time, time from, depth of overburden, etc., if significant)			

RECORD DRAWING-WORK AS BUILT

Male No. 6DC-313

LOG DIVISION SWD

INSTALLATION FWD

PROJECT ry Dam

1. SITE AND TYPE OF BIT

2. LOCATION (Coordinates or System)

3. MANUFACTURER'S DESIGNATION OF DRILL

4. TOTAL NUMBER CORE BOXES

5. ELEVATION GROUND WATER

6. DATE HOLE

7. ELEVATION TOP OF HOLE

8. TOTAL CORE RECOVERY FOR BORING

9. SIGNATURE OF INSPECTOR

LEGEND	CLASSIFICATION OF MATERIALS (Description)	DEPTH (ft)	REMARKS (Drilling time, water loss, depth of casing, etc., if significant)
0.0' to 16.0'	CLAY		
0.0' to 4.0'	low plasticity, hard, dry, brown, silty.		
4.0' to 6.3'	med. plast., v. stiff, dry, strong brown, sl. sandy.		
6.3' to 16.0'	med./low plast., stiff, dry, yellowish brown, silty, lime nodules and sand below 15.0'.		
16.0' to 21.3'	SAND, fine grained, clayey & silty seams within, sl. gravelly, dry, strong brown, & yellow brown w/ light grey.		
21.3' to 29.5'	GRAVEL, coarse to fine & rounded, clasp to matrix? (drill fluid still in hole), strong brn. clayey, sandy.		
29.5' to 62.9'	CLAYSHALE, unweath. dk. grey, soft to mod. soft (Rz. classif) massive, silty w/ interbeds of thin silty & sandy seams @ 10-12 degrees.		
	Several med. hard SANDSTONE seams as indicated below:		
	45.6-45.9		
	49.6-50.9		
	50.4-52.1		
	57.0-57.3		
	61.2-61.4		
	64.1-64.4		
	64.9-65.0		
	66.7-66.8		
	Highly fossilif. zone from 69.9 to 70.4 (ctn. #1).		
	Structural features as follows:		
	43.4 open fract.		
	47.1 "		
	51.3 "		
	64.2 "		

Male No. 6DC-313

PROJECT AUBREY DAM

OUTLET

6DC-313

29 Aug

10 Sep 80

99

McVern to 39', Cole to T.D.

ELEVATION	DEPTH	LEGEND	CLASSIFICATION OF MATERIALS (Description)	SCORE RECOVERY %	SDS OR SAMPLE NO	REMARKS (Drilling time, water loss, depth of casing, etc., if significant)
			1. Bailed hole to near T.D., 24 hr. check, water @ 23.5'.			
			2. Jars:			
			A. 0.0 to 4.0			
			B. 4.0 to 5.0			
			C. 5.0 to 5.5			
			D. 7.0			
			E. 9.0			
			F. 11.0			
			G. 11.0 to 13.0			
			H. 15.0			
			I. 17.0			
			J. 18.0			
			K. 20.0			
			L. 20.0 to 21.3			
			M. 21.3 to 26.3			
			N. 26.3 to 29.5			
			O. 29.5 to 32.9			
			3. Denison cans:			
			1. 5.5 to 7.0			
			2. 7.0 to 9.0			
			3. 9.0 to 11.0			
			4. 13.0 to 15.0			
			5. 15.0 to 17.0			
			6. 18.0 to 20.0			
			4. Cartons:			
			1-35.3 to 36.3			
			2-41.9 to 42.9			
			3-45.6 to 46.3			
			4-50.5 to 51.3			
			5-57.3 to 58.3			
			6-65.8 to 66.8			
			7-69.9 to 70.6			
			8-75.3 to 76.3			
			9-81.9 to 82.9			
			5. Drilling:			
			0.0' to 5.0', 8" auger, Set 5.0' casing			
			5.0' to 21.5', 6" denison casing as drill progressed			
			21.5' to 32.0', 8" auger			

Male No. 6DC-313

PROJECT AUBREY DAM

OUTLET

6DC-313

29 Aug

10 Sep 80

99

McVern to 39', Cole to T.D.

ELEVATION	DEPTH	LEGEND	CLASSIFICATION OF MATERIALS (Description)	SCORE RECOVERY %	SDS OR SAMPLE NO	REMARKS (Drilling time, water loss, depth of casing, etc., if significant)
			Drilling cont.			
			Set 31.5' casing, clearout to 33.5'			
			33.5' to 83.1'			
			6" core			

PREVIOUS EDITIONS ARE OBSOLETE.

PROJECT 6DC-313

Male No. 6DC-313

U.S. ARMY ENGINEER DISTRICT, FORT WORTH
CORPS OF ENGINEERS
FORT WORTH, TEXAS

RAY ROBERTS LAKE
ELM FORK, TRINITY RIVER, TEXAS
EMBANKMENT, SPILLWAY AND
OUTLET WORKS
LOGS OF BORINGS
8A-311, 8A-312, 6DC-313

INVITATION NO. DACW63-82B-0085 DATE MAR. 1982
CONTRACT NO. DACW63-82-C-0093
DRAWING NUMBER SHEET NO. 35

RECORD DRAWING-WORK AS BUILT

TO ACCOMPANY FOUNDATION REPORT

Mile No 50r 31r

DRILLING LOG		PROJECT		SHEET	
Aubrey Dam		Outlet Works		1 of 3	
60C-314		Mullins		Falling 1500	
18.5		70.5		89.0	
10 Sep 80		15 Sep 80			

ELEVATION	DEPTH	LEGEND	CLASSIFICATION OF MATERIALS	SCORE	FOR ON	NO	CD
40			0.0' to 2.5'	A	1	5	
			2.5' to 3.5'	1	2	6	
			3.5' to 13.5'	2	3	7	
			13.5' to 15.0'	3	4	8	
			15.0' to 18.5'	4	5	9	
			18.5' to 24.5'	5	6	10	
			24.5' to 89.0'	6	7	11	
						12	
						13	
						14	
						15	

ENG FORM 1836 PREVIOUS EDITIONS ARE OBSOLETE
 PROJECT: Aubrey Dam HOLE NO: 60C 314

ELEVATION	DEPTH	LEGEND	CLASSIFICATION OF MATERIALS	SCORE	FOR ON	NO	CD
40			44.3' to 44.5' - SANDSTONE	G1		5	
			44.7' to 44.9' - SANDSTONE	G03		6	
			54.3' to 54.9' - SANDSTONE	G05		7	
			60.6' to 60.8' - SANDSTONE	G01		8	
			62.1' to 62.4' - SANDSTONE	G04		9	
			62.7' to 62.9' - SANDSTONE	G05		10	
			65.0' to 65.3' - SANDSTONE	L00		11	
			65.0' to 70.0' - SANDSTONE	L07		12	
			72.3' to 75.5' - very fossiliferous, numerous claystone lenses	G01		13	
				G02		14	
				G03		15	
				G04			
				G05			
				G06			
				G100			

T.D. - 89.0'


ELEVATION	DEPTH	LEGEND	CLASSIFICATION OF MATERIALS (Description)	SCORE RECOVERY	BOX OR SAMPLE NO	REMARKS (Drilling time, water loss, depth of weathering, etc., if significant)
90.0					A10	
					5	
			44.3' to 44.5' - SANDSTONE	G	03	
			44.7' to 44.9' - SANDSTONE			
					6	
					495	
					7	
					600	
					535	
			54.3' to 54.9' - SANDSTONE	L	05	
					8	
					570	
					9	
			60.6' to 60.8' - SANDSTONE	G	01	
					10	
					615	
			62.1' to 62.4' - SANDSTONE	G	04	
			62.7' to 62.9' - SANDSTONE			
					11	
			65.0' to 65.5' - SANDSTONE	L	00	
			65.0' to 70.0' - SANDSTONE			
					12	
			72.3' to 72.5' - very fossiliferous, numerous claystone lenses	L	07	
					13	
					780	
					14	
					810	
					15	
					G 01	
					780	
					810	
					G 02	
					860	
					G 03	
					890	
90.0			T.D. - 89.0' -			

DRILLING LOG		Southwestern		INSTRUMENTATION		Fort Worth		Hole No. 60C-315	
PROJECT		LOCATION (Community or Bureau)		MANUFACTURER & REGISTRATION OF GRILL		TOTAL NO. OF OVERBURDEN SAMPLES TAKEN		TOTAL NUMBER CORE BORES	
Aubrey Dam		Outlet Works		Falling 1500		8		14	
USCE						2		ELEVATION GROUND WATER	
60C-315								DATE MOLE	
								13 Sept 80	
								18 Sept 80	
18.5		76.3		94.8		98.4		SIGNATURE	
								J.P. [Signature]	
ELEVATION	DEPTH	LEGEND	CLASSIFICATION OF MATERIALS (Description)	SCORE RECOVERY	BOX OR SAMPLE NO	REMARKS (Drilling time, water loss, depth of weathering, etc., if significant)			
	0.0'		CLAY, low plasticity, hard, dry, brown.		A	1. After completion, hole was bailed to T.D. 24 hr check, water level was 31.5'			
	2.5'		CLAY, medium plasticity, very stiff, slightly moist, brown.		B	2. Jars:			
	6.5'		CLAY, medium plasticity, hard, moist, gravelly except from 17.5' to 18.5', calcareous nodules.		C	A. 0.0 to 2.5			
	18.5'		SHALE, moderately soft, weathered as shown below:		D	* B. 4.5			
	30.0'		SPALC, moderately soft, unweathered, unjointed, unfractured, massive, gray.		E	* C. 6.5			
	42.0'		Interbeds of hard SANDSTONE at the following depths:		F	D. 6.5 to 11.5			
	54.0'				G	E. 11.5 to 12.5			
	66.0'				H	F. 12.5 to 17.5			
	78.0'				I	G. 17.5 to 18.5			
	90.0'				J	H. 18.5 to 20.5			
					K	* taken from Denison shoe.			
					L	3. Denison cans:			
					M	1. 2.5 to 4.5			
					N	2. 4.5 to 6.5			
					O	4. Castons:			
					P	1. 22.5 to 23.6			
					Q	2. 25.7 to 27.7			
					R	3. 30.0 to 31.0			
					S	4. 35.4 to 36.4			
					T	5. 38.9 to 39.9			
					U	6. 44.5 to 45.5			
					V	7. 51.2 to 52.2			
					W	8. 56.0 to 57.0			
					X	9. 59.8 to 60.6			
					Y	11. 65.4 to 66.4			
					Z	12. 70.6 to 71.6			
					aa	13. 80.8 to 81.8			
					ab	14. 85.8 to 86.8			
					ac	15. 90.0 to 90.9			
					ad	16. 93.8 to 94.8			
					ae	5. Drilling methods:			
					af	0.0 to 2.5 - auger			
					ag	2.5 to 6.5 - denison bb'1			
					ah	6.5 to 20.5 - auger			
					ai	20.5 to 94.8 - core bb'1			
					aj	6. Base of weathering at 30'			
					ak				
					al				
					am				
					an				
					ao				
					ap				
					aq				
					ar				
					as				
					at				
					au				
					av				
					aw				
					ax				
					ay				
					az				
					ba				
					bb				
					bc				
					bd				
					be				
					bf				
					bg				
					bh				
					bi				
					bj				
					bk				
					bl				
					bm				
					bn				
					bo				
					bp				
					bq				
					br				
					bs				
					bt				
					bu				
					bv				
					bw				
					bx				
					by				
					bz				
					ca				
					cb				
					cc				
					cd				
					ce				
					cf				
					cg				
					ch				
					ci				
					cj				
					ck				
					cl				
					cm				
					cn				
					co				
					cp				
					cq				
					cr				
					cs				
					ct				
					cu				
					cv				
					cw				
					cx				
					cy				
					cz				
					da				
					db				
					dc				
					dd				
					de				
					df				
					dg				
					dh				
					di				
					dj				
					dk				
					dl				
					dm				
					dn				
					do				
					dp				
					dq				
					dr				
					ds				
					dt				
					du				
					dv				
					dw				
					dx				
					dy				
					dz				
					ea				
					eb				
					ec				
					ed				
					ee				
					ef				
					eg				
					eh				
					ei				
					ej				
					ek				
					el				
					em				
					en				
					eo				
					ep				
					eq				
					er				
					es				
					et				
					eu				
					ev				
					ew				
					ex				
					ey				
					ez				
					fa				
					fb				
					fc				
					fd				
					fe				
					ff				
					fg				
					fh				
					fi				
					fj				
					fk				
					fl				
					fm				
					fn				
					fo				
					fp				
					fq				
					fr				
					fs				
					ft				
					fu				
					fv				
					fw				
					fx				
					fy				
					fz				
					ga				
					gb				
					gc				
					gd				
					ge				
					gf				
					gg				
					gh				
					gi				
					gj				
					gk				
					gl				

Hole No. 6DC 315

DRILLING LOG PROJECT Aubrey Dam LOCATION (Name of Section) Outlet Works DRILLING AGENCY USCE NO. AND SHEET ON DRAWING THIS Hole No. 6DC-315 NO. OF SHEETS Mullins LOCATION OF HOLE CRITICAL () INCLINED () BEG FROM VENT THICKNESS OF OVERBURDEN 18.5 IN DRILLED INTO ROCK 76.3 TOTAL DEPTH OF HOLE 94.8	INSTALLATION Fort Worth	SHEET of 3 SHEETS
	10 SIZE AND TYPE OF BIT auger, d bb'1, core bb'1	11 DATE FOR ELEVATION 12 MANUFACTURER'S DESIGNATION OF BIT Falling 1500
13 TOTAL NO. OF OVER- BURDEN SAMPLES TAKEN 8	14 TOTAL NUMBER CORE SOLES 16	15 ELEVATION GROUND WATER **
16 DATE HOLE STARTED 13 Sept 80 TERMINATED 18 Sept 80	17 ELEVATION TOP OF HOLE	18 TOTAL CORE RECOVERY FOR BORING 98.4
19 1'S CREATING DIRECTOR D.P. Cole, Jr.		

DEPTH ft	LEGEND a	CLASSIFICATION OF MATERIALS (Description) d	SCORE RECORD NO. e	BOX OR SAMPLE NO. f	REMARKS (Drilling time, water loss, depth of weathering, etc., if significant)
0.0' to 2.5'		CLAY, low plasticity, hard, dry, brown.		A	** 1. After completion, hole was bailed to T.D. 24 hr check, water level was 31.5'
2.5' to 6.5'		CLAY, medium plasticity, very stiff, slightly moist, brown.		1 2 C	2. Jars: A. 0.0 to 2.5 * B. 4.5 * C. 6.5 D. 6.5 to 11.5 E. 11.5 to 12.5 F. 12.5 to 17.5 G. 17.5 to 18.5 * H. 18.5 to 20.5 * taken from denison shoe.
6.5' to 18.5'		CLAY, medium plasticity, hard, moist, gravelly except from 17.5' to 18.5', calcareous nodu- les.		D E	3. Denison cons: 1. 2.5 to 4.5 2. 4.5 to 6.5
18.5' to 30.0'		SHALE, moderately soft, weathered as shown be- low: 18.5' to 20.5' - unwea- thered. 20.5' to 25.4' - highly weathered, soft, tan. 25.4' to 30.0' - slight weathered, gray and tan		F G H 20.5 20.5	4. Cartons: 1. 22.5 to 23.6 2. 25.7 to 27.7 3. 30.0 to 31.0 4. 35.4 to 36.4 5. 38.9 to 39.9 6. 44.5 to 45.5 7. 51.2 to 52.2 8. 56.0 to 57.0 9. 59.8 to 60.6 11. 65.4 to 65.4 11. 70.6 to 71.6 12. 77.0 to 77.8 13. 80.8 to 81.8 14. 85.8 to 86.8 15. 90.0 to 90.9 16. 93.8 to 94.8
30.0' to 94.8'		SHALE, moderately soft, unweathered, unjointed, unfractured, massive, gray Interbeds of hard SAND- STONE at the following depths: 21.0' to 21.4' 38.9' to 40.2' 42.7' to 43.0' 45.7' to 45.9' 49.3' to 50.0' 57.3' to 58.3' 58.4' - very fossilif- ferous.		I L 0.3 24.5 L 0.6 21.5 L 0.0 32.5 G 0.8 36.5 L 0.6 40.5 G 0.4 44.5 L 0.0 49.0 G 0.2 53.5 L 0.5 58.0	5. Drilling methods: 0.0 to 2.5 - auger 2.5 to 6.5 - denison bb'1 6.5 to 20.5 - auger 20.5 to 94.8 - core bb'1 6. Base of weathering at 30'

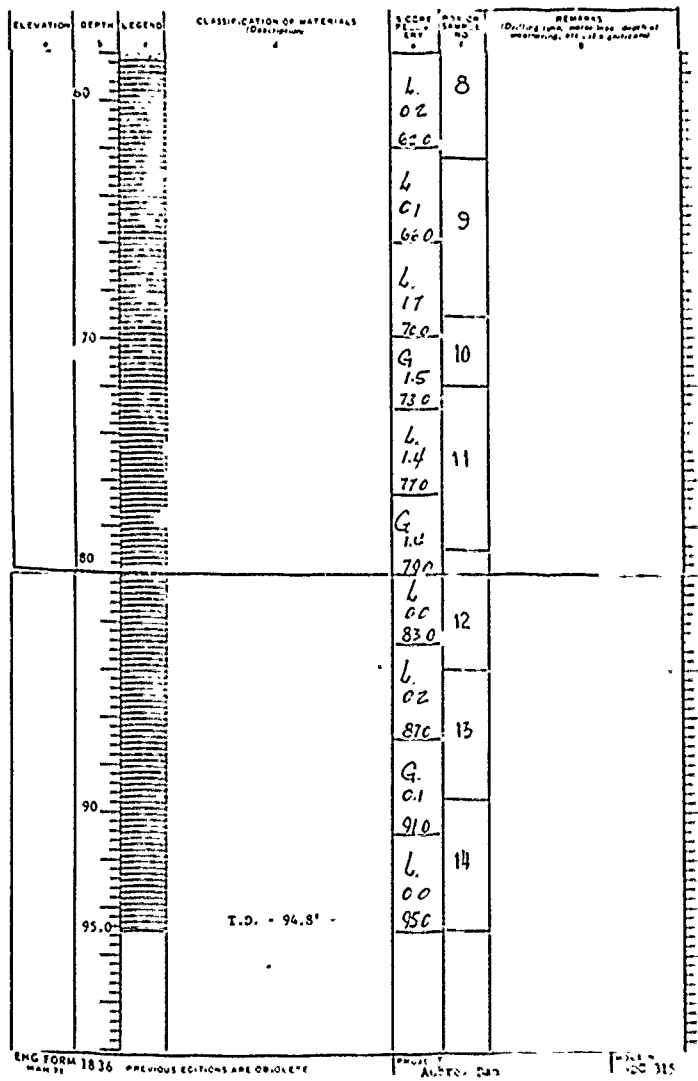

RECORD DRAWING WORK AS FULLY

DESIGNED BY	RAY ROBERTS LAKE
DRAWN BY	ELM FORK, TRINITY RIVER, TEXAS
REVIEWED BY	EMBANKMENT, SPILLWAY AND
	OUTLET WORKS
	LOGS OF BORINGS
	6 DC-314 AND 6DC-315
SUBMITTED BY	INVITATION NO. SACAES-82 B-0023 DATE MAR. 11 1982
APPROVED BY	CONTRACT NO. SACAES-82 C-1083
	DRAWN BY W.F. LEE
	SHEET NO. 36

TO ACCOMPANY FOUNDATION REPORT

Hole No. BA-315

DRILLING LOG		Southwestern		Installation		Fort Worth		SHEET	
PROJECT		Aubrey Dam		NO. AND TYPE OF BIT		11		OF SHEETS	
LOCATION		Outlet Works		DATE FOR ELEVATION INDENTIFICATION		12			
DRILLING AGENCY		USCE		MANUFACTURER'S DESIGNATION OF DRILL		Pallins 1500			
HOLE NO. TAG AND HOLE NUMBER		BA-315		TOTAL NO. OF OVERBURDEN SAMPLES TAKEN		7		UNDISTURBED	
NAME OF DRILLER		Mullins		TOTAL NUMBER CORE BORES		-			
DIRECTION OF HOLE		VERTICAL		ELEVATION GROUND WATER		99.6			
THICKNESS OF OVERBURDEN		27.7'		DATE HOLE STARTED		19 Sep 80		COMPLETED	
DEPTH DRILLED INTO ROCK		74.8'		ELEVATION TOP OF HOLE		19 Sep 80			
TOTAL DEPTH OF HOLE		104.5'		TOTAL CORE RECOVERY FOR BORING		3			
				SIGNATURE OF DIRECTOR		[Signature]			

ELEVATION	DEPTH	LEGEND	CLASSIFICATION OF MATERIALS (Description)	SCORE RECOVERY	BOX OR TAG NO.	REMARKS (Drying time, water loss, depth of penetration, etc., if significant)
0.0'	11.0'		CLAY, medium to high plasticity, stiff, moist black and white.	A		1. After completion, water level in hole was 12.4'. 16 hour check - level was 12.4'
11.0'	23.0'		CLAY, high plasticity, medium stiff, moist to 16', very moist from 16' to 23', scattered gravel, tan and gray.	B		2. Jars:
23.0'	29.0'		CLAY, medium plasticity, soft, wet, sandy, gray-green.	C		A. 0.0 to 5.0
29.0'	35.0'		CLAY, medium plasticity, soft, wet, sandy, gray-green.	D		B. 5.0 to 11.0
				E		C. 11.0 to 16.0
				F		D. 16.0 to 21.0
				G		E. 21.0 to 23.0
						F. 23.0 to 29.0
						G. 29.0 to 35.0
			T.D. - 35.0'			

ENG FORM 1836 PREVIOUS EDITIONS ARE OBSOLETE. MAR 71 PROJECT Aubrey Dam HOLE NO. BA 316

DRILLING LOG		SWO		Installation		Fort Worth		SHEET	
PROJECT		AUBREY DAM - OULET WORKS		NO. AND TYPE OF BIT		11		OF SHEETS	
LOCATION		STA 2 +10		DATE FOR ELEVATION INDENTIFICATION		12			
DRILLING AGENCY		USCE		MANUFACTURER'S DESIGNATION OF DRILL		Pallins 1500			
HOLE NO. TAG AND HOLE NUMBER		BA-315		TOTAL NO. OF OVERBURDEN SAMPLES TAKEN		7		UNDISTURBED	
NAME OF DRILLER		Mullins		TOTAL NUMBER CORE BORES		-			
DIRECTION OF HOLE		VERTICAL		ELEVATION GROUND WATER		99.6			
THICKNESS OF OVERBURDEN		27.7'		DATE HOLE STARTED		19 Sep 80		COMPLETED	
DEPTH DRILLED INTO ROCK		74.8'		ELEVATION TOP OF HOLE		19 Sep 80			
TOTAL DEPTH OF HOLE		104.5'		TOTAL CORE RECOVERY FOR BORING		3			
				SIGNATURE OF DIRECTOR		[Signature]			

ELEVATION	DEPTH	LEGEND	CLASSIFICATION OF MATERIALS (Description)	SCORE RECOVERY	BOX OR TAG NO.	REMARKS (Drying time, water loss, depth of penetration, etc., if significant)
0.0'	13.5'		CLAY, medium to high plasticity, stiff, moist black and white.	A		1. After completion, water level in hole was 12.4'. 16 hour check - level was 12.4'
13.5'	16.1'		GRAVEL COARSE TO FINE, DRY; STRONG BEN VERY SANDY, CLAYEY	B		
16.1'	20.2'		SAND, FINE-GRAINED; DRY REDDISH YELLOW; SLT. GRAVELLY	C		
20.2'	27.7'		GRAVEL COARSE TO FINE; DAMP; VERY SANDY STRONG BEN TO BEN BY 24.2'	D		
27.7'	43.1'		SHALE: GRAY; MASSIVE; SAND IS OLIVE, VERY FRAGILE E WICKLY CEMENTED	E		
43.1'	43.1'		UNWEATHERED; DK GRAY, MOD. SOFT, MASSIVE; SILTY; NUMEROUS THIN (<0.1" THICK) SAND-STONE SEAMS SCATTERED EXCEPT WHERE NOTED:	F		
				G		
				H		
				I		
				J		
				K		
				L		
				M		
				N		
				O		
				P		
				Box 1		
				Box 2		

ENG FORM 1836 PREVIOUS EDITIONS ARE OBSOLETE. MAR 71 PROJECT AUBREY

DRILLING LOG		SWD	INSTALLATION	FWD	SHEET 1 OF 3 SHEETS
PROJECT: AUBREY DAM - OUTLET WORKS		NO. AND TYPE OF BIT: AUGER 6" CORE		DATE OF ELEVATION: 13 FEB 81	
1. LOCATION (Compass or Triangulation): STA 25+10		2. MANUFACTURER'S DESIGNATION OF BIT: F/WING 1500		3. DRILLING AGENCY: USCE-C	
4. HOLE NO. (As shown on drawing sheet and log number): BANC-358		13. TOTAL NO. OF OVERBURDEN SAMPLES TAKEN: 8		14. TOTAL NUMBER CORE BORES: 16	
5. NAME OF DRILLER: MULLINS		15. ELEVATION GROUND WATER: SEE REMARKS		16. DATE HOLE STARTED: 9 FEB 81	
6. DIRECTION OF HOLE: <input type="checkbox"/> VERTICAL <input type="checkbox"/> INCLINED		17. ELEVATION TOP OF HOLE: 27.7'		18. TOTAL CORE RECOVERY FOR BORING: 99.3'	
7. THICKNESS OF OVERBURDEN: 27.7'		19. ELEVATION GROUND WATER: SEE REMARKS		20. SIGNATURE OF INSPECTOR: M. VEY	
8. DEPTH DRILLED INTO ROCK: 74.6'		21. ELEVATION TOP OF HOLE: 27.7'		22. SIGNATURE OF DRILLER: MULLINS	
9. TOTAL DEPTH OF HOLE: 104.3'		23. ELEVATION TOP OF HOLE: 27.7'		24. SIGNATURE OF INSPECTOR: M. VEY	


ELEVATION	DEPTH	LEGEND	CLASSIFICATION OF MATERIALS (Description)	REMARKS (Depth from base of hole, depth of overburden, etc., if significant)
0.0'	0.0'		0.0' to 13.5'	1. WATER LEVEL: 4 INCH AFTER BAILING WATER LEVEL WAS @ 27.1'
			CLAY	
			0.0' - 1.3' MED/HIGH PLASTICITY, STIFF, MOIST, DK. BRN, SANDY LIME	
			1.3' - 5.6' AS ABOVE, COLORED GRADES TO BEN	
			5.6' - 13.5' LOW PLASTICITY, HARD, DRY, REDDISH YELLOW, SANDY & SILTY, VERY SANDY AFTER	
			13.5' to 16.1'	
			GRAVEL COARSE TO FINE, DRY; STRONG BRN, VERY SANDY, CLAYEY	
			16.1' to 20.2'	
			SAND FINE-GRAINED; DRY, REDDISH YELLOW; SLI GRAVELLY	
			20.2' to 27.7'	
			GRAVEL COARSE TO FINE; DAMP; VERY SANDY, STRONG BRN TO BEN BY 24.2'	
			27.7' to 43.1'	
			SHALE:	
			27.7' - 28.3' WEATHERED; GRAY, MASSIVE; SAND IS OLIVE, VERY FRAGILE & WEAKLY CEMENTED	
			28.3' - 43.1' UNWEATHERED; DK GRAY; MOD SOFT; MASSIVE; SILTY; NUMEROUS THIN (< 0.1" THICK) SANDSTONE SEAMS SCATTERED EXCEPT WHERE NOTED:	
			@ 30.0'	
			@ 30.3' - 32.2'	
			@ 31.5'	
			33.3' - 34.2' VERY SILTY	

DRILLING LOG		SWD	INSTALLATION	FWD	SHEET 2 OF 3 SHEETS
PROJECT: AUBREY DAM - OUTLET WORKS		NO. AND TYPE OF BIT: AUGER 6" CORE		DATE OF ELEVATION: 13 FEB 81	
1. LOCATION (Compass or Triangulation): STA 25+10		2. MANUFACTURER'S DESIGNATION OF BIT: F/WING 1500		3. DRILLING AGENCY: USCE-C	
4. HOLE NO. (As shown on drawing sheet and log number): BANC-358		13. TOTAL NO. OF OVERBURDEN SAMPLES TAKEN: 8		14. TOTAL NUMBER CORE BORES: 16	
5. NAME OF DRILLER: MULLINS		15. ELEVATION GROUND WATER: SEE REMARKS		16. DATE HOLE STARTED: 9 FEB 81	
6. DIRECTION OF HOLE: <input type="checkbox"/> VERTICAL <input type="checkbox"/> INCLINED		17. ELEVATION TOP OF HOLE: 27.7'		18. TOTAL CORE RECOVERY FOR BORING: 99.3'	
7. THICKNESS OF OVERBURDEN: 27.7'		19. ELEVATION GROUND WATER: SEE REMARKS		20. SIGNATURE OF INSPECTOR: M. VEY	
8. DEPTH DRILLED INTO ROCK: 74.6'		21. ELEVATION TOP OF HOLE: 27.7'		22. SIGNATURE OF DRILLER: MULLINS	
9. TOTAL DEPTH OF HOLE: 104.3'		23. ELEVATION TOP OF HOLE: 27.7'		24. SIGNATURE OF INSPECTOR: M. VEY	

ELEVATION	DEPTH	LEGEND	CLASSIFICATION OF MATERIALS (Description)	REMARKS (Depth from base of hole, depth of overburden, etc., if significant)
			@ 31.2' HARD DK GRAY BRN CO ₃	Box 3
			37.2' - 37.8' VERY SILTY	
			@ 40.4' HARD DK GRAY BRN CO ₃	Box 4
			43.1' to 66.9'	
			SHALE & SANDSTONE:	
			43.1' - 66.3' INTERLAYERED, UNWEATHERED; DK GRAY TO LT GRAY, MOD. SOFT TO MOD HARD; MOD. CEMENTED SANDSTONE ZONES AS FOLLOWS:	
			43.1' - 43.4'	
			45.7' - 46.0'	
			46.9' - 48.0' SHALEY	
			48.5' - 50.1' SHALEY	
			50.8' - 51.0'	
			52.3' - 54.5' SHALEY	
			58.5' - 59.0'	
			62.1' to 65'	
			@ 61.3' HARD BRN CO ₃	Box 7
			61.5' - 61.9' SANDSTONE IS HARD A WELL CEMENTED	
			66.3' - 66.9' SHALE AS ABOVE; SANDSTONE IS GREEN GRAY WITH NUMEROUS OYSTER SHELLS (< 1/2" IN SIZE)	
			66.9' to 99.9'	
			SHALE:	
			66.9' - 91.0' UNWEATHERED; DK GRAY TO LT GRAY, MOD. SOFT TO MOD. HARD; ARENACEOUS; NUMEROUS THIN & SCAT. SAND & SILT SEAMS; NUMEROUS HARD BRN CONCENTRATIONS & LENSES	
			@ 68.0' FOSSILIFEROUS & VERY SILTY FOR 40.5'	

Hole No. BA6C-358


DRILLING LOG	SWD	INSTALLATION	FWD	SHEET 2 OF 3 SHEETS
PROJECT	AUBREY DAM - OUTLET WORKS			
LOCATION (County or Station)	STA 25+10			
DRILLING AGENCY	USOE-C			
HOLE NO. (As shown on drawing title or number)	BA6C-358			
NAME OF DRILLER	HULLINS			
DIRECTION OF HOLE	VERTICAL			
THICKNESS OF OVERBURDEN	27.7'			
DEPTH DRILLED INTO ROCK	76.8'			
TOTAL DEPTH OF HOLE	104.5'			
DATE MOLE STARTED	9 FEB 81			
DATE MOLE COMPLETED	13 FEB 81			
ELEVATION TOP OF HOLE	99.1'			
TOTAL CORE RECOVERY FOR BORING	99.1'			
SIGNATURE OF INSPECTOR	M. VEY			

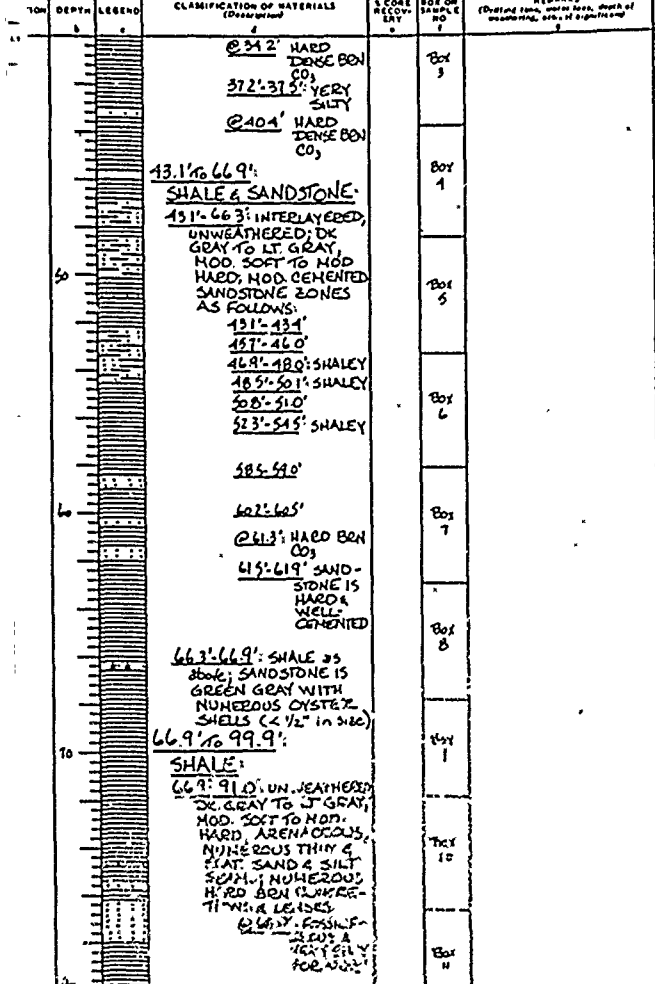

1836 PREVIOUS EDITIONS ARE OBSOLETE. AUBREY DAM HOLE NO. BA6C-358

Hole No. BA6C-358

DRILLING LOG	SWD	INSTALLATION	FWD	SHEET 3 OF 3 SHEETS
PROJECT	AUBREY DAM - OUTLET WORKS			
LOCATION (County or Station)	STA 25+10			
DRILLING AGENCY	USOE-C			
HOLE NO. (As shown on drawing title or number)	BA6C-358			
NAME OF DRILLER	BEEWEB			
DIRECTION OF HOLE	VERTICAL			
THICKNESS OF OVERBURDEN	27.7'			
DEPTH DRILLED INTO ROCK	76.8'			
TOTAL DEPTH OF HOLE	104.5'			
DATE MOLE STARTED	9 FEB 81			
DATE MOLE COMPLETED	13 FEB 81			
ELEVATION TOP OF HOLE	99.1'			
TOTAL CORE RECOVERY FOR BORING	99.1'			
SIGNATURE OF INSPECTOR	M. VEY			

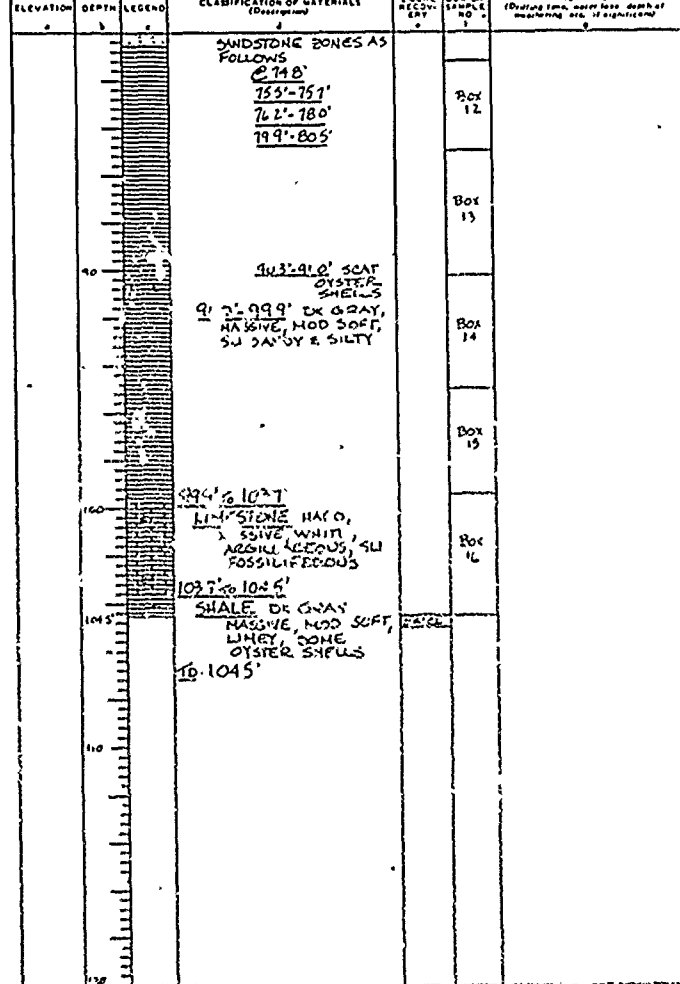

1836 PREVIOUS EDITIONS ARE OBSOLETE. AUBREY DAM HOLE NO. BA6C-358

RECORD DRAWING WORK AS BUILT

U.S. ARMY ENGINEER DISTRICT, FORT WORTH	
NAME OF ENGINEER	
DATE	
RAY ROBERTS LAKE	
SLM FORK, TRINITY RIVER, TEXAS	
EMBANKMENT, SPILLWAY AND	
OUTLET WORKS	
LOGS OF BORINGS	
BA-310 AND BA6C-358	
DATE	27

TO ACCOMPANY FOUNDATION REPORT

H-1 No. **BAGC-359**

DRILLING LOG		INSTALLATION	
PROJECT AUBREY DAM - OUTLET WORKS		FWD	
LOCATION (Compass or Station) STA 27+20		NO. AND TYPE OF BIT AUGER; 6" CORE	
DRILLING AGENCY USCE-C		FALLING 1500	
HOLE NO. (As shown on drawing sheet and site number) BAGC-359		TOTAL NO. OF OVERBURDEN SAMPLES TAKEN INSTALLED 5 UNINSTALLED 0	
NAME OF DRILLER MULLINS		TOTAL NUMBER CORE BOXES 3	
DIRECTION OF HOLE <input checked="" type="checkbox"/> VERTICAL <input type="checkbox"/> INCLINED DEG FROM VERT		ELEVATION GROUND WATER * SEE REMARKS	
THICKNESS OF OVERBURDEN 17.0'		DATE HOLE STARTED 18 FEB 61 COMPLETED 19 FEB 61	
DEPTH DRILLED INTO ROCK 5.5'		ELEVATION TOP OF HOLE	
TOTAL DEPTH OF HOLE 22.5'		TOTAL CORE RECOVERY FOR BORING 100%	
		SIGNATURE OF INSPECTOR MCVEY	

ELEVATION	DEPTH	LEGEND	CLASSIFICATION OF MATERIALS (Description)	SCORE RECON-TEXT	BOX OR SAMPLE NO	REMARKS (Detail top, water level, depth of penetration, etc., if significant)
00'	00'		00' to 17.0' CLAY: 00'-3.0' MED/HIGH PLASTICITY; HARD; DRY; BRN; SANDY & SILTY 3.0'-4.9' as above; VERY STIFF; DAMP; BRN 4.9'-8.0' MED/HIGH PLASTICITY; HARD; DRY; YELLOW BRN & BRN; LIMY; SILTY & SANDY 8.0'-14.1' MED/LOW PLASTICITY; VER. STIFF; DRY; RED YELLOW; SILTY & SANDY 14.1'-17.0' as above; STIFF; DAMP		A	WATER LEVEL: 24 HRS AFTER BAILING WATER LEVEL WAS @ 27.4'
					B	
					C	JAR SAMPLES A: 00'-3.0' B: 3.0'-4.9' C: 4.9'-8.0' D: 8.0'-14.1' E: 14.1'-17.0'
					D	
					E	
			17.0' to 18.7' LIMESTONE HARD; MASSIVE, WEATHER-STAINED, WHITE & YELLOW-BRN; FOSSILIF. ERAS; 0.1" THICK LIMONITE SEAM @ BASE		Box 1	DEILLING: AUGERED 0.0'-17.5'. AUGER REFUSAL @ 17.5'. 6" CORE 17.5'-32.5' LEFT 10' OF CORE IN BORING (31.5'-32.5') ON LAST RUN. BAILED BORING.
			18.7' to 31.5' SHALE: 18.7'-28.9' WEATHERED; YELLOW BRN & GRAY; SOFT TO MOD. SOFT MASSIVE, SCAT. THIN SILT & SAND SEAMS, SLT TO NON-CALC 18.8'-19.1' MOD. HARD & MOD. CEMENTED SANDSTONE SEAMS 25.7'-27.2' VERY SANDY ZONE 27.2'-27.7' HARD LIMONITE SEAM 27.7'-28.9' THIN VERY SHELLY & SANDY 28.9'-31.5' UNWEATHERED DK GRAY; FOSSILIF. ERAS; 3" AMMONITE @ 31.0'		Box 2 Box 3	1. BASE OF WEATHERING @ 28.7'
					10' LWT IN HOLE	

ENG FORM 1836 PREVIOUS EDITIONS ARE OBSOLETE
MAR 71 PROJECT **AUBREY DAM** HOLE NO. **BAGC-359**

Hole No. **3**

DRILLING LOG		INSTALLATION	
PROJECT AUBREY DAM - OUTLET WORKS		FWD	
LOCATION (Compass or Station) STA 28+20		NO. AND TYPE OF BIT AUGER; 6" CORE	
DRILLING AGENCY USCE-C		FALLING 15	
HOLE NO. (As shown on drawing sheet and site number) BAGC-360		TOTAL NO. OF OVERBURDEN SAMPLES TAKEN INSTALLED 1 UNINSTALLED 0	
NAME OF DRILLER MULLINS		TOTAL NUMBER CORE BOXES 3	
DIRECTION OF HOLE <input checked="" type="checkbox"/> VERTICAL <input type="checkbox"/> INCLINED DEG FROM VERT		ELEVATION GROUND WATER * SEE R	
THICKNESS OF OVERBURDEN 15.3'		DATE HOLE STARTED 19 FEB 61 COMPLETED	
DEPTH DRILLED INTO ROCK 14.7'		ELEVATION TOP OF HOLE	
TOTAL DEPTH OF HOLE 30.0'		TOTAL CORE RECOVERY FOR BORING	
		SIGNATURE OF INSPECTOR MCVEY	

ELEVATION	DEPTH	LEGEND	CLASSIFICATION OF MATERIALS (Description)	SCORE RECON-TEXT	BOX OR SAMPLE NO	REMARKS (Detail top, water level, depth of penetration, etc., if significant)
00'	00'		00' to 15.3' CLAY: 00'-2.4' MED/HIGH PLASTICITY; STIFF; DAMP; DK. BRN; SANDY & SILTY 2.4'-7.2' HIGH/MED PLASTICITY; STIFF; DAMP TO MOIST; RED YELLOW; SILTY & SANDY; LIME NODULES 7.2'-12.7' as above; MED/LOW PLASTICITY; MED STIFF; SANDIER		A	WATER LEVEL: 18 HRS 21 WATER @ 23.1'
					B	JAR SA A: 0.0'-2' B: 2.4'-7' C: 7.2'-11' D: 12.7'-
					C	DEILLING AUGERED 6" CORE BAILED @
					D	
					Box 1	E-LOGG C. OG HC 27' NORTH BAGC-360
					Box 2	5. BASE OF @ 29.2'
					Box 3	
			12.7'-15.3' MED/HIGH PLASTICITY; HARD; DRY; YELLOW BRN; SANDY & SILTY; LIMY 15.3' to 17.3' LIMESTONE WHITE & YELLOW BRN STAINS; HARD; MASSIVE; FOSSILIFEROUS 17.3' to 29.7' SHALE WEATHERED TO YELLOW BRN & LT. GRAY TO 29.2'; THEN UNWEATHERED DK GRAY; MASSIVE, MOD. SOFT; SILTY & SANDY; NUMEROUS SCAT. THIN SAND SEAMS; FEW LIMONITE CONCRETIONS 26.3'-26.7' MOD. CEMENTED SANDSTONE 27.8'-28.1' MOD. CEMENTED SANDSTONE 10: 29.7'			

ENG FORM 1836 PREVIOUS EDITIONS ARE OBSOLETE
MAR 71 PROJECT **AUBREY DAM**

LOG NO.	SWD	INSTALLATION	FWD	SHEET 1 OF 3 SHEETS
PROJECT: AUBREY DAM - OUTLET WORKS				
1. HOLE NO. (As shown on drawing title and site map)				
2. LOCATION (Township or Station)				
3. DRILLING AGENCY				
4. HOLE NO. (As shown on drawing title and site map)				
5. NAME OF DRILLER				
6. DIRECTION OF HOLE				
7. THICKNESS OF OVERBURDEN				
8. DEPTH DRILLED INTO ROCK				
9. TOTAL DEPTH OF HOLE				
10. DATE HOLE STARTED				
11. DATE HOLE COMPLETED				
12. ELEVATION TOP OF HOLE				
13. TOTAL CORE RECOVERY FOR BORING				
14. SIGNATURE OF INSPECTOR				

DEPTH	LEGEND	CLASSIFICATION OF MATERIALS (Description)	SOIL NO. RECON. SAT.	SOIL OR SAMPLE NO.	REMARKS (Drilling time, water level, depth of weathering, etc., if significant)
0.0'		0.0' to 15.3'		A	1. WATER LEVEL: 18 HRS. AFTER BAUNG WATER LEVEL WAS @ 23.1'
0.0'		CLAY: 0.0'-2.4': MED/HIGH PLASTICITY, STIFF, DAMP, DK. BRN; SANDY & SILTY 2.4'-7.4': HIGH/MED PLASTICITY, STIFF, DAMP TO MOIST; RED YELLOW; SILTY & SANDY; LIME NODULES 7.4'-12.7': as above, MED/LOW PLASTICITY; MED. STIFF; SANDIER		B	2. JAR SAMPLES: A: 0.0'-2.4' B: 2.4'-7.4' C: 7.4'-12.7' D: 12.7'-15.3'
12.7'		12.7'-15.3': MED/HIGH PLASTICITY, HARD; DRY, YELLOW BRN, SANDY & SILTY; LIMEY		C	3. DRILLING: AUGERED 0.0'-15.0', 6" CORE 15.0'-30.0', BAILED BORING.
15.3'		15.3' to 17.3'		D	4. E-LOGGING c. on hole drilled 21' north of BACC-360.
17.3'		LIMESTONE: WHITE & YELLOW BRN STAINS; JARD; MASSIVE; FOSSILIFEROUS		Box 1	5. BASE OF WEATHERING @ 29.2'
17.3'		17.3' to 29.7'		Box 2	
26.3'		SHALE WEATHERED TO YELLOW BRN & LT. GRAY TO 29.2'; THEN UNWEATHERED DK GRAY; MASSIVE; MOD. SOFT; SILTY & SANDY; NUMEROUS SCALY THIN SAND SEAMS; FEW LIMONITE CONCRETIONS		Box 3	
26.3'		26.3'-26.7': MOD. CEMENTED SANDSTONE			
27.8'		27.8'-28.1': MOD. CEMENTED SANDSTONE			
28.1'		28.1'-29.7'			

LOG NO.	SWD	INSTALLATION	FWD	SHEET 1 OF 1 SHEETS
PROJECT: AUBREY DAM - OUTLET WORKS				
1. HOLE NO. (As shown on drawing title and site map)				
2. LOCATION (Township or Station)				
3. DRILLING AGENCY				
4. HOLE NO. (As shown on drawing title and site map)				
5. NAME OF DRILLER				
6. DIRECTION OF HOLE				
7. THICKNESS OF OVERBURDEN				
8. DEPTH DRILLED INTO ROCK				
9. TOTAL DEPTH OF HOLE				
10. DATE HOLE STARTED				
11. DATE HOLE COMPLETED				
12. ELEVATION TOP OF HOLE				
13. TOTAL CORE RECOVERY FOR BORING				
14. SIGNATURE OF INSPECTOR				

ELEVATION	DEPTH	LEGEND	CLASSIFICATION OF MATERIALS (Description)	SCORE RECON. SAT.	BOX OR SAMPLE NO.	REMARKS (Drilling time, water level, depth of weathering, etc., if significant)
0.0'			0.0' to 13.0'		A	1. WATER LEVEL: ENCOUNTERED NO WATER WHILE AUGERING. 24 HRS. AFTER BAUNG WATER LEVEL WAS @ 17.5'
0.0'			CLAY: 0.0'-5.0': MED. TO HIGH PLASTICITY; STIFF TO VERY STIFF; MOIST; RED-BRN WITH YELLOW-BRN & STEAKY BRN; SILTY, SLI. CALC 5.0'-8.1': HIGH PLASTICITY, VERY STIFF; SLI. MOIST; YELLOW-BRN; SANDY & SILTY; LIMEY; CALC 8.1'-13.0': MED-LOW PLASTICITY; VERY STIFF; SLI. MOIST; YELLOW-BRN; SANDY & SILTY; SL. GRAVELLY @ 8.5'		B	2. JAR SAMPLES: A: 0.0'-5.0' B: 5.0'-8.1' C: 8.1'-13.0'
13.0'			13.0' to 19.2'		C	3. DRILLING 8" AUGER 0.0'-13.0' AUGER REFUSAL @ 13.0'. SET CASING TO 13.0'. 6" CORING 13.0'-24.0'. BAILED HOLE.
19.2'			LIMESTONE: ARGILLA-CEOUS, WEATHER-STAINED YELLOW-BRN & WHITE, MASSIVE; HARD; OYSTER SHELLS; IRREGULAR THIN JOFT SHALE SEAMS; LIMONITE CONCRETIONS 188' M.L. HARD RED LIMONITE SEAM		Box 1	
19.2'			19.2' to 23.8'		Box 2	
23.8'			SHALE: DK. GRAY WITH YELLOW-BRN WEATHERED JOINTS; MOD. SOFT; MASSIVE; LIMONITE CONCRETIONS; MOD HARD, MOD. CEMENTED PALE BRN OR GRAY THIN SANDSTONE SEAMS @ 22.0', 22.3', 22.8', & 23.5'		Box 3	
23.8'			23.8'-20.5': WEATHERED YELLOW-BRN & LT. GRAY			4. E-LOGGING BORING DRILLED 5' WEST OF BACC-361 TO DEPTH OF 12.0' & WAS C-LOGGED

Male No. 8A6C-361

SYMBOL	SWD	INSTALLATION	FWD	SHEET 1 OF 2 SHEETS
PROJECT	OUTLET WORKS	NO. SIZE AND TYPE OF BIT	8" AUGER 1 1/2" CARBIDE	
DATE	8A6C-361	DATE FOR ELEVATION	12/29/51	
DRILLING AGENCY	USOEC	MANUFACTURER'S DESIGNATION OF DRILL	FALLING 1500	
THICKNESS OF OVERBURDEN	6.7'	TOTAL NO. OF OVERBURDEN SAMPLES TAKEN	3	
DEPTH DRILLED INTO ROCK	21.9'	TOTAL NUMBER CORE BOXES	3	
TOTAL DEPTH OF HOLE	28.6'	ELEVATION GROUND WATER	SEE REMARKS	
		DATE MOLE	30 JAN 51	
		DATE SIGNATURE OF INSPECTOR	2 FEB 51	

CLASSIFICATION OF MATERIALS (Description)	SCORE RECOVERY %	BOX OR SAMPLE NO.	REMARKS (Drilling time, water used, depth of overburden, etc., if significant)
0.0' to 13.0' CLAY 0.0'-5.0' MED. TO HIGH PLASTICITY; STIFF TO VERY STIFF; MOIST; RED-BRN WITH YELLOW-BRN & STRONG BEN; SILTY; SLI. CALC. 5.0'-8.1' HIGH PLASTICITY; VERY STIFF; SLI. MOIST; YELLOW-BRN; SANDY & SILTY; LIMY; CALC. 8.1'-13.0' MED. LOW PLASTICITY; VERY STIFF; SLI. MOIST; YELLOW-BRN; SANDY & SILTY; SH. GRAVELLY @ 8.5'		A	1. WATER LEVEL ENCOUNTERED NO WATER WHILE AUGERING. 24 HRS. AFTER BAILING WATER LEVEL WAS @ 17.5'
13.0' to 19.2' LIMESTONE ARGILLA - OCEANUS, WEATHER-STAINED YELLOW-BRN & WHITE, MASSIVE; HARD; OYSTER SHELLS, IRREGULAR THIN SOFT SHALE SEAMS, LIMONITE CONCRETIONS 188'-19.2' HARD RED LIMONITE SEAM		Box 1	3. DRILLING 8" AUGER 0.0'-13.0' AUGER REFUSAL @ 13.0'. SET CASING TO 13.0'. 6" CORING 13.0'-24.0'. BAILED HOLE
19.2' to 23.8' SHALE DK. GRAY WITH YELLOW-BRN WEATHERED JOINTS; MOD. SOFT; MASSIVE; LIMONITE CONCRETIONS; MOD. HARD; MOD. CEMENTED PALE BRN OR GRAY THIN SANDSTONE SEAMS @ 22.0'; 22.3'; 22.8'; & 23.5' 19.2'-20.5' WEATHERED YELLOW-BRN & LT. GRAY		Box 2 Box 3	4. E-LOGGING BORING DRILLED 5' WEST OF 8A6C-361 TO DEPTH OF 120.0' & WAS C-LOGGED

1. EDITIONS ARE OBSOLETE PROJECT AUBREY DAM HOLE NO. 8A6C-361

Male No. 8A6C-362

SYMBOL	SWD	INSTALLATION	FWD	SHEET 1 OF 2 SHEETS
PROJECT	AUBREY DAM-OUTLET WORKS	NO. SIZE AND TYPE OF BIT	8" AUGER 1 1/2" CARBIDE	
DATE	8A6C-362	DATE FOR ELEVATION	12/29/51	
DRILLING AGENCY	USOEC	MANUFACTURER'S DESIGNATION OF DRILL	FALLING 1500	
THICKNESS OF OVERBURDEN	6.7'	TOTAL NO. OF OVERBURDEN SAMPLES TAKEN	3	
DEPTH DRILLED INTO ROCK	21.9'	TOTAL NUMBER CORE BOXES	3	
TOTAL DEPTH OF HOLE	28.6'	ELEVATION GROUND WATER	SEE REMARKS	
		DATE MOLE	30 JAN 51	
		DATE SIGNATURE OF INSPECTOR	2 FEB 51	

ELEVATION	DEPTH	LEGEND	CLASSIFICATION OF MATERIALS (Description)	SCORE RECOVERY %	BOX OR SAMPLE NO.	REMARKS (Drilling time, water used, depth of overburden, etc., if significant)
0.0'	0.0'		0.0' to 6.7' CLAY 0.0'-1.3' MED. PLASTICITY; STIFF; DRY, DK. BEN, SANDY & SILTY 1.3'-2.2' HIGH PLASTICITY; STIFF, SLI. MOIST, STRONG BEN 2.2'-6.7' MED. LOW PLASTICITY, VERY STIFF, DRY, RED-DISH, YELLOW; SANDY & SILTY; LIMY		A	1. WATER LEVEL BAILED BORING 2 FEB 51 3 FEB 51 WL = 21.0' 4 FEB 51 WL = 20.2' 6 FEB 51 WL = 19.1' 9 FEB 51 WL = 18.9'
6.7'	6.7'		6.7' to 12.6' LIMESTONE ARGILLA - OCEANUS, WEATHER-STAINED YELLOW-BRN & WHITE; MASSIVE; HARD; OYSTER SHELLS 12.3'-12.6' HARD RED LIMONITE SEAM		Box 1 Box 2	2. JAR SAMPLES A 0.0'-1.3' B 1.3'-2.2' C 2.2'-6.7'
12.6'	12.6'		12.6' to 24.1' SHALE WEATHERED YELLOW-BRN & GRAY TO UNWEATHERED DK. GRAY @ 24.3'. SOFT TO MOD. SOFT; MASSIVE; LIMONITE CONCRETIONS; SOFT THIN SANDY SEAMS; MOD. HARD; MOD. CEMENTED PALE BRN SANDSTONE SEAMS @ 15.6'-16.0' & @ 16.9'		Box 3 Box 4 Box 5	3. DRILLING 8" AUGER 6' CORE
24.1'	24.1'		24.1' to 28.3' SANDSTONE & SHALE INTERBEDDED DK. GRAY SOFT TO MOD. SOFT UNWEATHERED SHALE & PALE BRN MOD. HARD MOD. CEMENTED SANDSTONE 24.1'-24.2' HARD, WELL-CEMENTED SANDSTONE 28.1'-28.3' HARD, WELL-CEMENTED SANDSTONE			4. E-LOGGING BORING DRILLED 7' EAST OF 8A6C-362 TO DEPTH OF 110.0' & WAS C-LOGGED

ENG FORM 1836 MAR 51 PREVIOUS EDITIONS ARE OBSOLETE PROJECT AUBREY DAM HOLE NO. 8A6C-362

RECORD DRAWING-WORK AS BUILT

SYMBOL	LOG NO.	ACTION	DATE	DESCRIPTION OF REVISION
U.S. ARMY ENGINEER DISTRICT, FORT WORTH CORPS OF ENGINEERS FORT WORTH, TEXAS				
DESIGNED BY	RAY ROBERTS LAKE ELM FORK, TRINITY RIVER, TEXAS EMBANKMENT, SPILLWAY AND OUTLET WORKS LOGS OF BORINGS 8A6C-359, 8A6C-360, 8A6C-361 AND 8A6C-362			
REVIEWED BY				
SUBMITTED BY	INVITATION NO. DACW63-82-0-0025 DATE MAR 1982			
ENGINEER	DRAWING NUMBER		SHEET NO.	SEQUENCE NO.
			30	30

TO ACCOMPANY FOUNDATION REPORT

CONTRACT NO. DACW63-82-0-0025

Hole No. BA-363

DRILLING LOG	DIVISION	SWD	INSTALLATION	FWD	SHEET 1 OF 1 SHEETS	
1. PROJECT AUBREY DAM - OUTLET WORKS			10. SIZE AND TYPE OF BIT & AUGER 1 1/2" DIA. FOR ELEVATION 1300 (TYPE B) (R)			
2. LOCATION (Company or Station) STA. 12+50			11. MANUFACTURER'S DESIGNATION OF DRILL FAILING 1500			
3. DRILLING AGENCY USCE-C			12. TOTAL NO. OF OVERBURDEN SAMPLES TAKEN 0 (DISTURBED) 0 (UNDISTURBED)			
4. HOLE NO. (As shown on drawing title and No. marked) BA-363			13. TOTAL NUMBER CORE BOSES N/A			
5. NAME OF DRILLER MULLINS			14. ELEVATION GROUND WATER & SEE REMARKS			
6. DIRECTION OF HOLE <input checked="" type="checkbox"/> VERTICAL <input type="checkbox"/> INCLINED SEE FROM VERT.			15. DATE HOLE STARTED 1 JAN 81 COMPLETED 1 JAN 81			
7. THICKNESS OF OVERBURDEN 24.6'			16. ELEVATION TOP OF HOLE			
8. DEPTH DRILLED INTO ROCK 1.4'			17. TOTAL CORE RECOVERY FOR BORING N/A			
9. TOTAL DEPTH OF HOLE 26.0'			18. SIGNATURE OF INSPECTOR MEVEY			
ELEVATION	DEPTH	LEGEND	CLASSIFICATION OF MATERIALS (Description)	% CORE RECOVERY	BOX OR SAMPLE NO.	REMARKS (Drilling time, total hole, depth of overburden, etc., if significant)
00'	00'		00' to 24.6' CLAY 00'-4.3' LOW PLASTICITY @ SURFACE, GRADING TO HIGH PLASTICITY BY 1.0'; SOFT TO MED. STIFF, MOIST; DK BEN; SILTY 4.3'-16.0' HIGH-MED. PLASTICITY; STIFF BECOMING SOFT BY 1.0'; MOIST; YELLOW BEN & LT GRAY; SANDY & SILTY; SOME FINE GRAVELS			1. WATER LEVEL: BORING MAKING WATER @ 13.0'. WATER LEVEL IMMEDIATELY AFTER DRILLING WAS @ 7.0'. 24 HRS AFTER DRILLING WATER LEVEL WAS @ 4.8'. 6 FEB 81: WL @ 4.6' 9 FEB 81: WL @ 4.6'
			16.0' to 23.0' GRAY & STRONG BEN; AS ABOVE; THIN YELLOW SAND SEAM AFTER 20.0'			2. NO SAMPLES TAKEN.
			23.0' to 24.6' DK. GRAY, AS ABOVE, STIFF 24.6' to 26.0' SHALE DK. GRAY; DRY; MOD SOFT; BLOCKY CLEAVAGE.			3. DRILLING NOTE BORING OFFSET 17' NE.
			ID: 26.0'			

ENG FORM 1836 MAR 71 PREVIOUS EDITIONS ARE OBSOLETE. PROJECT AUBREY DAM HOLE NO. BA-363

Hole No. BA-364

DRILLING LOG	DIVISION	SWD	INSTALLATION	FWD	SHEET 1 OF 1 SHEETS	
1. PROJECT AUBREY DAM - OUTLET WORKS			10. SIZE AND TYPE OF BIT & AUGER 1 1/2" DIA. FOR ELEVATION 1300 (TYPE B) (R)			
2. LOCATION (Company or Station) STA. 12+50			11. MANUFACTURER'S DESIGNATION OF DRILL FAILING 1500			
3. DRILLING AGENCY USCE-C			12. TOTAL NO. OF OVERBURDEN SAMPLES TAKEN 1 (DISTURBED) 1 (UNDISTURBED)			
4. HOLE NO. (As shown on drawing title and No. marked) BA6C-364			13. TOTAL NUMBER CORE BOSES 4			
5. NAME OF DRILLER MULLINS			14. ELEVATION GROUND WATER & SEE REMARKS			
6. DIRECTION OF HOLE <input checked="" type="checkbox"/> VERTICAL <input type="checkbox"/> INCLINED SEE FROM VERT.			15. DATE HOLE STARTED 23 FEB 81 COMPLETED 23 FEB 81			
7. THICKNESS OF OVERBURDEN 12.0'			16. ELEVATION TOP OF HOLE			
8. DEPTH DRILLED INTO ROCK 23.0'			17. TOTAL CORE RECOVERY FOR BORING N/A			
9. TOTAL DEPTH OF HOLE 35.0'			18. SIGNATURE OF INSPECTOR MEVEY			
ELEVATION	DEPTH	LEGEND	CLASSIFICATION OF MATERIALS (Description)	% CORE RECOVERY	BOX OR SAMPLE NO.	REMARKS (Drilling time, total hole, depth of overburden, etc., if significant)
00'	00'		00' to 8.0' CLAY 0.0'-2.1' LOW PLASTICITY, STIFF, MOIST, BLACK, SILTY & SANDY 2.1'-5.1' HIGH PLASTICITY, STIFF, MOIST; DK. BEN, SILTY 5.1'-8.0' HIGH PLASTICITY, HARD, SL DAMP, YELLOW BEN & LT GRAY, LIMY; SANDY & SILTY 8.0' to 12.0' GRAVEL : WELL-GRADED, MED. DENSE; SUB-ROUNDED; SANDY; CLAYEY; BRN			1. WATER LEVEL: 24 HRS. AFTER WATER LEVEL 8.5'
			12.0' to 16.0' SHALE & SANDSTONE SLI. WEATHERED; YELLOW BEN & LT. TO DK. GRAY; SOFT TO MOD SOFT MASSIVE; SOME SAND & GRAVEL TO 14.0' (REWORKED OR DUE TO AUGER)			2. JAR SAMPLING A: 0.0' - 2.0' B: 2.1' - 5.1' C: 5.1' - 8.0' D: 8.0' - 12.0' E: 12.0' - 16.0'
			16.0' to 35.0' SHALE : UNWEATHERED; DK GRAY; MOD SOFT; MASSIVE; SILTY & SANDY; SLI. FOSSILIFEROUS WITH PLANT REMAINS & CARBON; ABUNDANT MOD. HARD MOD CEMENTED SANDSTONE SEAMS 16.9'-17.4' SANDSTONE 18.1'-18.8' SANDSTONE 20.8'-21.0' SANDSTONE 21.1'-21.4' SANDSTONE 21.7'-21.9' SANDSTONE 22.2'-22.5' SANDSTONE 23.8'-24.0' SANDSTONE 24.3'-24.8' SANDSTONE 24.9'-25.5' SANDSTONE 26.6'-32.4' SANDSTONE 32.5'-34.7' SHALEY SANDSTONE 34.7' HARD BRN CONCRETION			3. DRILLING AUGERED & SET CASIN CLEANED & CORED 16.0' BAILED TO 1. BASE OF WEA @ 16.0'
			ID: 35.0'			

ENG FORM 1836 MAR 71 PREVIOUS EDITIONS ARE OBSOLETE. PROJECT AUBREY DAM HOLE NO. BA-364

Hole No. **816C-365** SHEET 1 OF 1 SHEETS

PROJECT USCEC	INSTALLATION FWD	HOLE NO. 816C-365	
1. NAME AND TYPE OF BIT ANGLED L-CORE		11. DATE FOR ELEVATION INFORMATION = WD	
2. DATE OF ELEVATION INFORMATION = WD		12. MANUFACTURER'S DESIGNATION OF DRILL FALING 1500	
3. TOTAL NO. OF OVER-BURDEN SAMPLES TAKEN 6		13. TOTAL NO. OF OVER-BURDEN SAMPLES TAKEN 6	
4. TOTAL NUMBER CORE BOXES 3		14. TOTAL NUMBER CORE BOXES 3	
5. ELEVATION GROUND WATER & SEE REMARKS			
6. DATE HOLE STARTED 6 FEB 81		7. DATE HOLE COMPLETED 6 FEB 81	
8. ELEVATION TOP OF HOLE		9. TOTAL CORE RECOVERY FOR BORING 98.5	
10. SIGNATURE OF INSPECTOR MCVEY		11. SIGNATURE OF INSPECTOR MCVEY	

DEPTH	LEGEND	CLASSIFICATION OF MATERIALS (Description)	SCORE RECOVERY %	BOX OR SAMPLE NO.	REMARKS (Drifted logs, water level, depth of casing, etc., if significant)
00' to 12.2'	A	CLAY: 00'-2.4' LOW PLASTICITY, MED STIFF, MOIST, YELLOW BRN, VERY SANDY, GRAVELLY			1. WATER LEVEL: 12 HRS. AFTER BAILING WATER LEVEL WAS @ 14.0'
2.4'-3.5'	B	MED/HIGH PLASTICITY, MED STIFF, MOIST, BROWNISH-GRAY, SANDY, SILT. GRAVELLY			2. JAR SAMPLES: A: 00'-2.4' B: 2.4'-3.5' C: 3.5'-8.3' D: 8.3'-12.2' E: 12.2'-13.1' F: 13.1'-16.0' G: 16.0'-20.0'
3.5'-8.3'	C	MED/HIGH PLASTICITY, HARD, DRY, BRN GRAY, SANDY & SILTY			
8.3'-12.2'	D	MED/HIGH PLASTICITY, HARD, DRY, YELLOW BRN & LT. GRAY, SANDY & SILTY			
12.2' to 16.0'	E	GRAVEL: 12.2'-13.1' COARSE TO FINE, ROUND, DRY, STRONG BRN, SANDY & CLAYEY			3. DRILLING: NOTE: BORING OFFSET 50' WEST. AUGER 00'-16.0' SET 19' OF CASING, CLEANED OUT TO 20.0'. L-CORE 20.0'-35.0'.
13.1'-16.0'	F	OS 200K, MOIST, YELLOW BRN & LT. GRAY			
16.0' to 34.7'	G	SHALE & SANDSTONE: INTERLAYERED, UNWEATHERED, OK GRAY TO LT. GRAY, MOD. SOFT TO MOD. HARD, MOD. CEMENTED, MASSIVE		Box 1	
		23.5'-24.6' SANDSTONE SEAM		Box 2	
				Box 3	
10:34.7'					

16 PREVIOUS EDITIONS ARE OBSOLETE PROJECT **USCEC DAM** HOLE NO. **816C-365**

Hole No. **816C-365** SHEET 1 OF 1 SHEETS

PROJECT USCEC	INSTALLATION FWD	HOLE NO. 816C-365	
1. NAME AND TYPE OF BIT ANGLED L-CORE		11. DATE FOR ELEVATION INFORMATION = WD	
2. DATE OF ELEVATION INFORMATION = WD		12. MANUFACTURER'S DESIGNATION OF DRILL FALING 1500	
3. TOTAL NO. OF OVER-BURDEN SAMPLES TAKEN 6		13. TOTAL NO. OF OVER-BURDEN SAMPLES TAKEN 6	
4. TOTAL NUMBER CORE BOXES 3		14. TOTAL NUMBER CORE BOXES 3	
5. ELEVATION GROUND WATER & SEE REMARKS			
6. DATE HOLE STARTED 6 FEB 81		7. DATE HOLE COMPLETED 6 FEB 81	
8. ELEVATION TOP OF HOLE		9. TOTAL CORE RECOVERY FOR BORING 98.5	
10. SIGNATURE OF INSPECTOR MCVEY		11. SIGNATURE OF INSPECTOR MCVEY	

DEPTH	LEGEND	CLASSIFICATION OF MATERIALS (Description)	SCORE RECOVERY %	BOX OR SAMPLE NO.	REMARKS (Drifted logs, water level, depth of casing, etc., if significant)
00' to 12.2'	A	CLAY: 00'-2.4' LOW PLASTICITY, MED STIFF, MOIST, YELLOW BRN, VERY SANDY, GRAVELLY			1. WATER LEVEL: 12 HRS. AFTER BAILING WATER LEVEL WAS @ 14.0'
2.4'-3.5'	B	MED/HIGH PLASTICITY, MED STIFF, MOIST, BROWNISH-GRAY, SANDY, SILT. GRAVELLY			2. JAR SAMPLES: A: 00'-2.4' B: 2.4'-3.5' C: 3.5'-8.3' D: 8.3'-12.2' E: 12.2'-13.1' F: 13.1'-16.0' G: 16.0'-20.0'
3.5'-8.3'	C	MED/HIGH PLASTICITY, HARD, DRY, BRN GRAY, SANDY & SILTY			
8.3'-12.2'	D	MED/HIGH PLASTICITY, HARD, DRY, YELLOW BRN & LT. GRAY, SANDY & SILTY			
12.2' to 16.0'	E	GRAVEL: 12.2'-13.1' COARSE TO FINE, ROUND, DRY, STRONG BRN, SANDY & CLAYEY			3. DRILLING: NOTE: BORING OFFSET 50' WEST. AUGER 00'-16.0' SET 19' OF CASING, CLEANED OUT TO 20.0'. L-CORE 20.0'-35.0'.
13.1'-16.0'	F	OS 200K, MOIST, YELLOW BRN & LT. GRAY			
16.0' to 34.7'	G	SHALE & SANDSTONE: INTERLAYERED, UNWEATHERED, OK GRAY TO LT. GRAY, MOD. SOFT TO MOD. HARD, MOD. CEMENTED, MASSIVE		Box 1	
		23.5'-24.6' SANDSTONE SEAM		Box 2	
				Box 3	
10:34.7'					

16 PREVIOUS EDITIONS ARE OBSOLETE PROJECT **USCEC DAM** HOLE NO. **816C-365**

RECORD DRAWING-WORK AS BUILT

RECORD DRAWING-WORK AS BUILT

Hole No. BA6C-365

SWD	INSTALLATION	FWD
1. OUTLET WORKS	10. SIZE AND TYPE OF BIT AUGER, L-CORE	11. DATE FOR ELEVATION INFORMATION - HWS
USCC-C	12. MANUFACTURER DESIGNATION OF DRILL	FALLING 1500
8A6C-365	13. TOTAL NO. OF OVER BURDEN SAMPLES TAKEN	0
MULLINS	14. TOTAL NUMBER CORE BOXES	3
	15. ELEVATION GROUND WATER # SEE REMARKS	
	16. DATE HOLE STARTED	6 FEB 81
	17. ELEVATION TOP OF HOLE	
	18. TOTAL CORE RECOVERY FOR BORING	98.9
	19. SIGNATURE OF INSPECTOR	MCVEY

ELEVATION	DEPTH	LEGEND	CLASSIFICATION OF MATERIALS (Description)	SCORE RECOVERY %	BOX OR SAMPLE NO.	REMARKS (Drilling time, water level, depth of overburden, etc., if significant)
00' to 12.2'			CLAY: 00'-24' LOW PLASTICITY, MED. STIFF, MOIST, YELLOW-BRN, VERY SANDY, GRAVELLY 24'-35' MED/HIGH PLASTICITY, MED. STIFF, MOIST, BROWNISH-GRAY, SANDY, SILTY, GRAVELLY 35'-83' MED/HIGH PLASTICITY, HARD; DRY; BRN GRAY, SANDY & SILTY 83'-12.2' MED/HIGH PLASTICITY, HARD; DRY, YELLOW-BRN & LT. GRAY, SANDY & SILTY 12.2' to 16.0' GRAVEL: 12.2'-13.1' COARSE TO FINE, ROUND, DRY, STRONG BRN, SANDY & CLAYEY 13.1'-16.0' as above, MOIST, YELLOW-BRN & LT. GRAY 16.0' to 34.7'			1. WATER LEVEL: 72 HRS. AFTER BAILING WATER LEVEL WAS @ 14.0'. 2. JAR SAMPLES: A: 00'-24' B: 24'-35' C: 35'-83' D: 83'-12.2' E: 12.2'-13.1' F: 13.1'-16.0' G: 16.0'-20.0' 3. DRILLING: NOTE: BORING OFFSET 50" WEST AUGER 00'-16.0' SET 19" OF CASING. CLEANED OUT TO 20.0'. L-CORE 20.0'-35.0'
TO: 34.7'			SHALE & SANDSTONE: INTERLAYERED; UNWEATHERED; DK. GRAY TO LT. GRAY; MOD. SOFT TO MOD. HARD; MOD. CEMENTED; MASSIVE 23.5'-24.6' SANDSTONE SEAM		Box 1 Box 2 Box 3	

THIS EDITION IS OBSOLETE. PROJECT: AUBREY DAM. HOLE NO.: BA6C-365

Hole No. BA6C-366

SWD	INSTALLATION	FWD
1. PROJECT	10. SIZE AND TYPE OF BIT AUGER, L-CORE	11. DATE FOR ELEVATION INFORMATION - HWS
AU' 2BY DAM - OUTLET WORKS	12. MANUFACTURER DESIGNATION OF DRILL	FALLING 1500
USCC-C	13. TOTAL NO. OF OVER BURDEN SAMPLES TAKEN	0
8A6C-366	14. TOTAL NUMBER CORE BOXES	2
	15. ELEVATION GROUND WATER # SEE REMARKS	
	16. DATE HOLE STARTED	4 FEB 81
	17. ELEVATION TOP OF HOLE	
	18. TOTAL CORE RECOVERY FOR BORING	96.9
	19. SIGNATURE OF INSPECTOR	MCVEY

ELEVATION	DEPTH	LEGEND	CLASSIFICATION OF MATERIALS (Description)	SCORE RECOVERY %	BOX OR SAMPLE NO.	REMARKS (Drilling time, water level, depth of overburden, etc., if significant)
00' to 17.0'			CLAY: 00'-31' HIGH PLASTICITY, STIFF, MOIST, RED & REDDISH-BRN, SANDY & SILTY 31'-12.3' MED-HIGH PLASTICITY, HARD; DRY, YELLOW-BRN & LT. GRAY, SANDY & SILTY 12.3'-17.0' LOW-MED PLASTICITY, MED STIFF TO SOFT, MOIST, PALE BRN & YELLOW-BRN, VERY SANDY, SAND SEAMS 17.0' to 25.0' GRAVEL: 17.0'-19.8' FINE TO COARSE, ROUND, VERY MOIST TO WET, STRONG BRN; SANDY & CLAYEY 19.8'-25.0' as above, YELLOW-BRN & LT. GRAY, VERY MOIST 25.0' to 34.6'			1. WATER LEVEL: 18 HRS. AFTER BAILING WATER LEVEL WAS @ 17.0'. 72 HRS. AFTER BAILING WATER LEVEL WAS @ 17.5'. 2. JAR SAMPLES: A: 00'-31' B: 31'-81' C: 81'-12.3' D: 12.3'-17.0' E: 17.0'-19.8' F: 19.8'-25.0' 3. DRILLING: NOTE GRAVEL ON SURFACE @ BORING LOCATION 8" AUGER 00'-25.0' AUGER REFUSAL @ 25.0' SET CASING TO 25.0' 6" COBBING 25.0'-35.0'
TO: 34.6'			SHALE ARENACEOUS, SOFT TO MOD. SOFT, UNWEATHERED, MASSIVE; BENTONITE-LOOKING @ 25.4' SOFT SANDSTONE SEAMS; SOFT DOLOMITE SEAMS; MANY THIN SCAT. SAND SEAMS, MOD. SOFT TO MOD. HARD, MOD. CEMENTED, & LT. GRAY 25.0'-25.4' VERY HARD BRN DOLOMITE SEAM 26.1'-26.3' SANDSTONE 27.8' HARD DOLOMITE 28.5'-29.2' SHALEY SANDSTONE 31.3'-31.6' SANDSTONE 31.9'-32.0' SANDSTONE 32.0'-32.1' DOLOMITE 32.8'-34.6' SHALEY SANDSTONE		Box 1 Box 2	


ENG FORM 1236 PREVIOUS EDITIONS ARE OBSOLETE. PROJECT: AUBREY DAM. HOLE NO.: BA6C-366


RECORD DRAWING-WORK AS BUILT

SYN	DC	NO	ACTION	DATE	DESCRIPTION OF REVISION
U.S. ARMY ENGINEER DISTRICT, FORT WORTH CORPS OF ENGINEERS FORT WORTH, TEXAS					
8A RAY ROBERTS LAKE ELM FORK, TRINITY RIVER, TEXAS EMBANKMENT, SPILLWAY AND OUTLET WORKS LOGS OF BORINGS 8A-363, 8A6C-364, 8A6C-365 AND 8A6C-366					
DESIGNED BY:			INVESTIGATION NO. DACW63-82-0-0025 DATE: MAR, 1982		
DRAWN BY:			CONTRACT NO. DACW63-82-C-0089		
REVIEWED BY:			DRAWING NUMBER		
SUBMITTED BY:			SHEET NO. 30		
ENGINEER:			SEQUENCE NO.		

CONTRACT NO. DACW63-82-C-0089

G
F
E
D
C
B
A

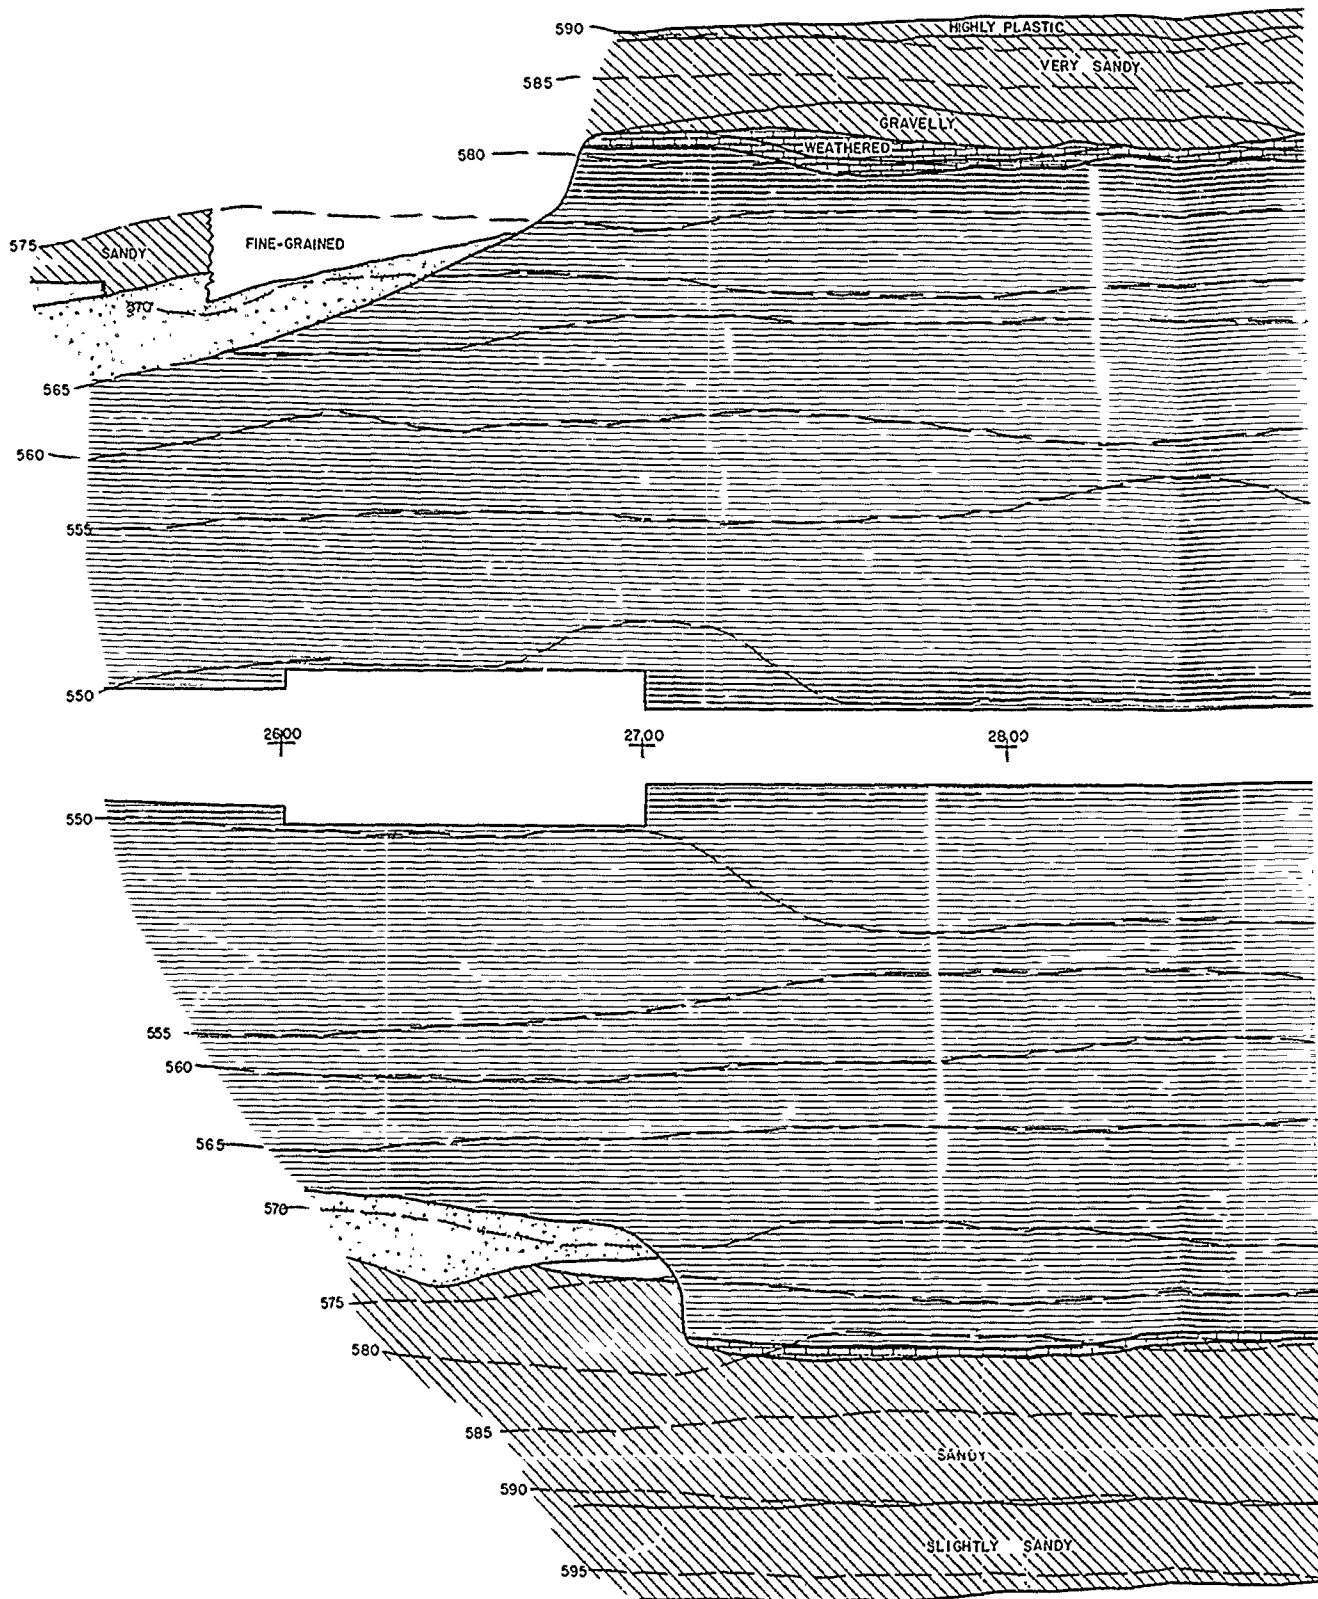


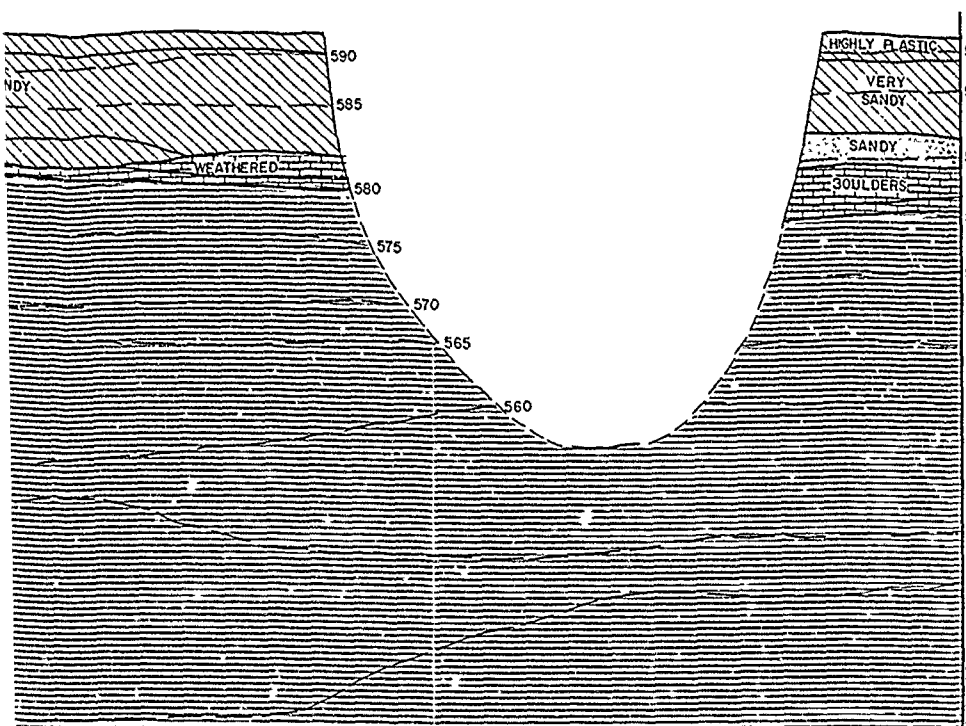

29+00

30+00



 


 
MATCH LINE STA 31+00

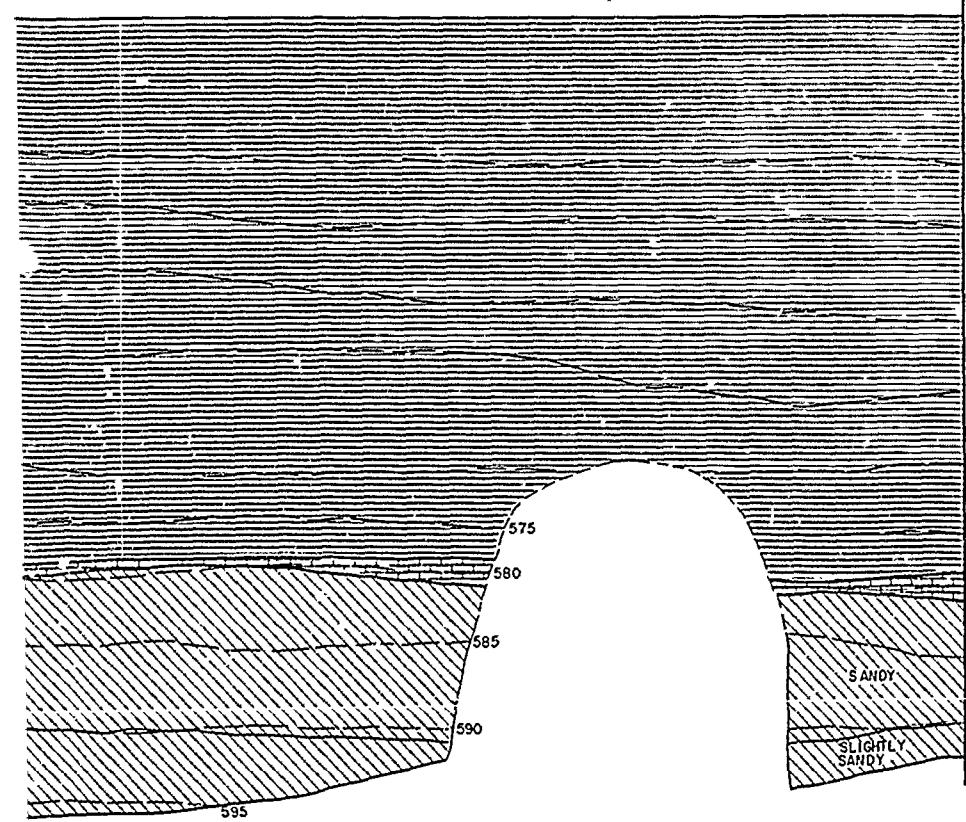


29+00


30+00

LEGEND

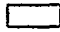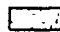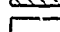-  SAND
-  GRAVEL
-  CLAY
-  SANDSTONE
-  LIMESTONE
-  SHALE






DESIGNED BY: H. BARNETT		RAY ROBERTS LAKE ELM FORK, TRINITY RIVER, TEXAS	
DRAWN BY: C. KIRBY		FOUNDATION REPORT	
REVIEWED BY: R. BEHM		OUTLET WORKS STA. 25+50 TO 31+00	
SUBMITTED BY: ROBERT C. BEHM ENGINEER		SOL. NO.	DATE:
		CONTR. NO.	SEQUENCE NO.
		DRAWING NUMBER	SHEET NO. 40



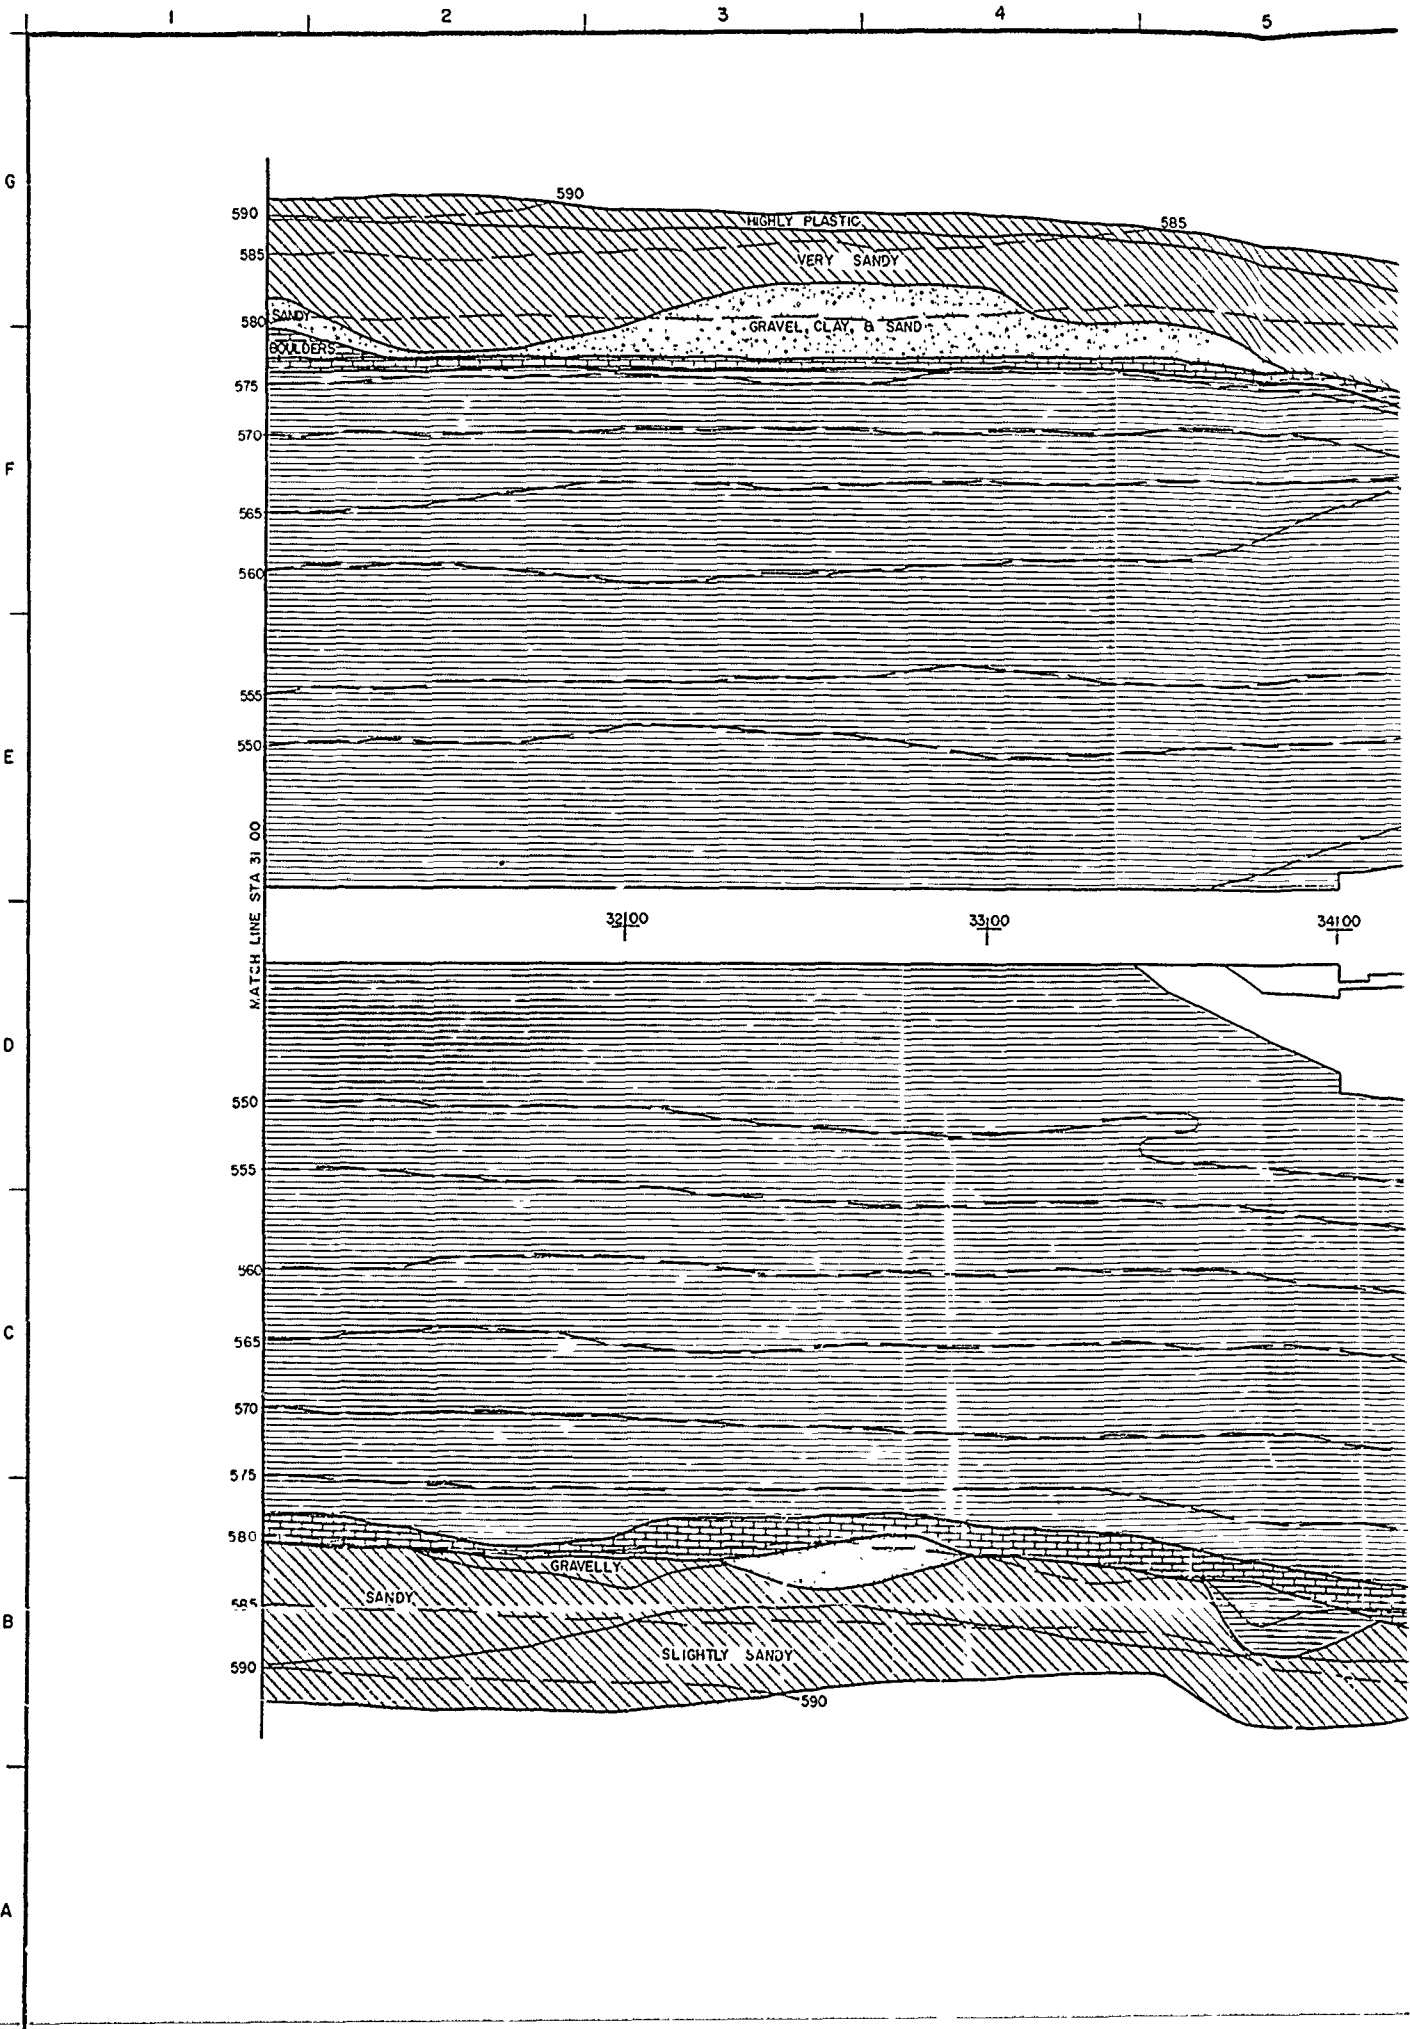


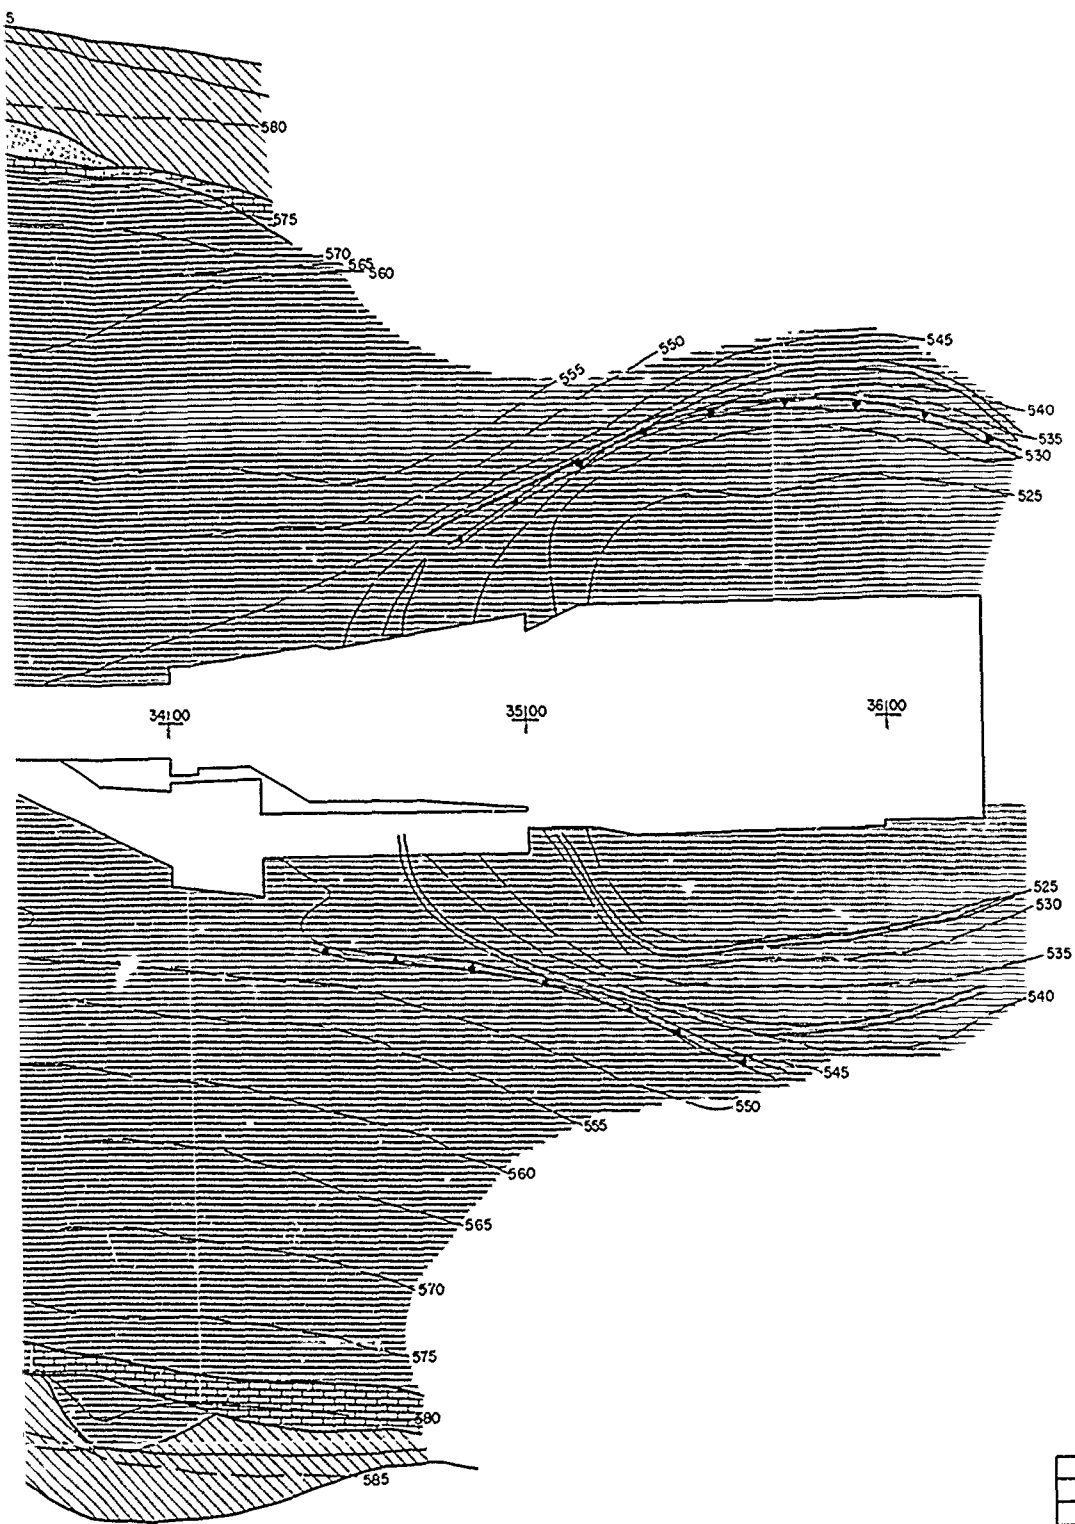
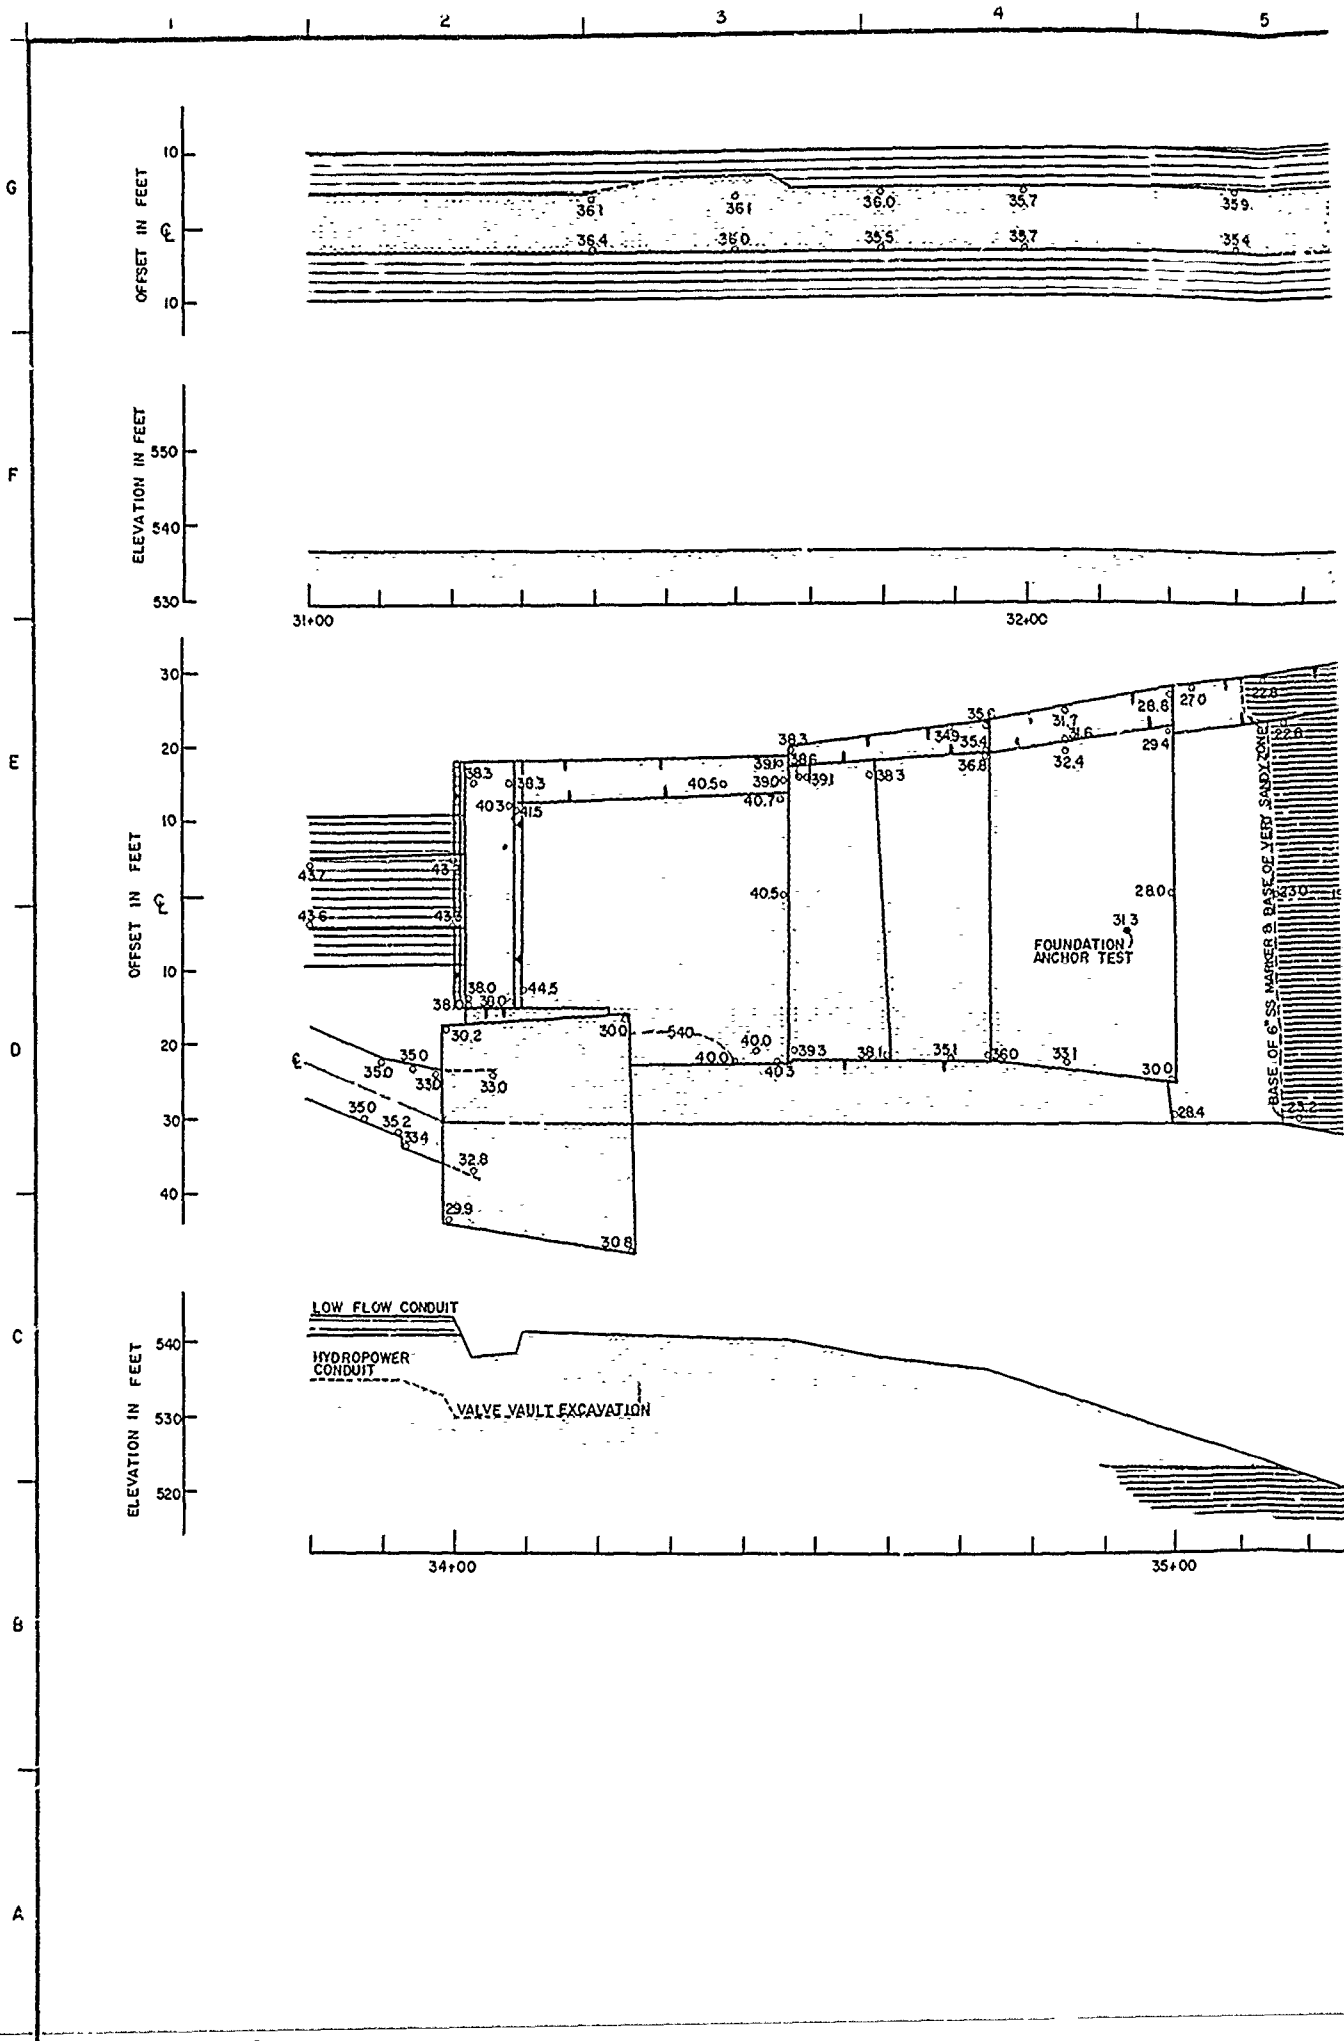







DESIGNED BY: H. BARNETT		RAY ROBERTS LAKE ELM FORK, TRINITY RIVER, TEXAS	
DRAWN BY: C. KIRBY		FOUNDATION REPORT OUTLET WORKS STA. 31+00 TO 36+28	
REVIEWED BY: R. BEHM			
SUBMITTED BY: ROBERT C. BEHM		SOL. NO.	DATED:
ENGINEER:		CONTR. NO.	SEQUENCE NO.
		DRAWING NUMBER	SHEET NO. OF
			41

G
F
E
D
C
B

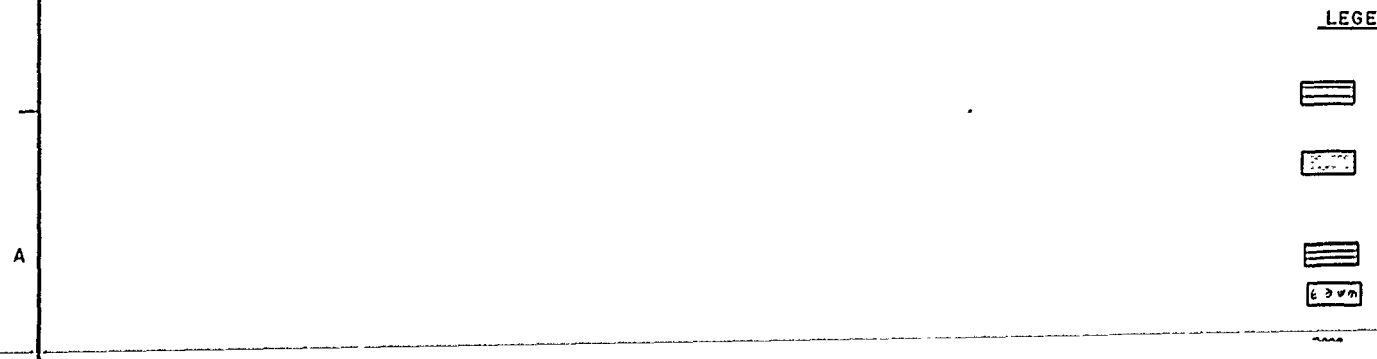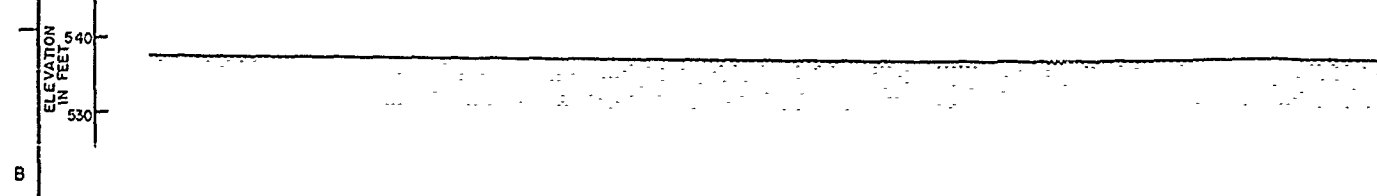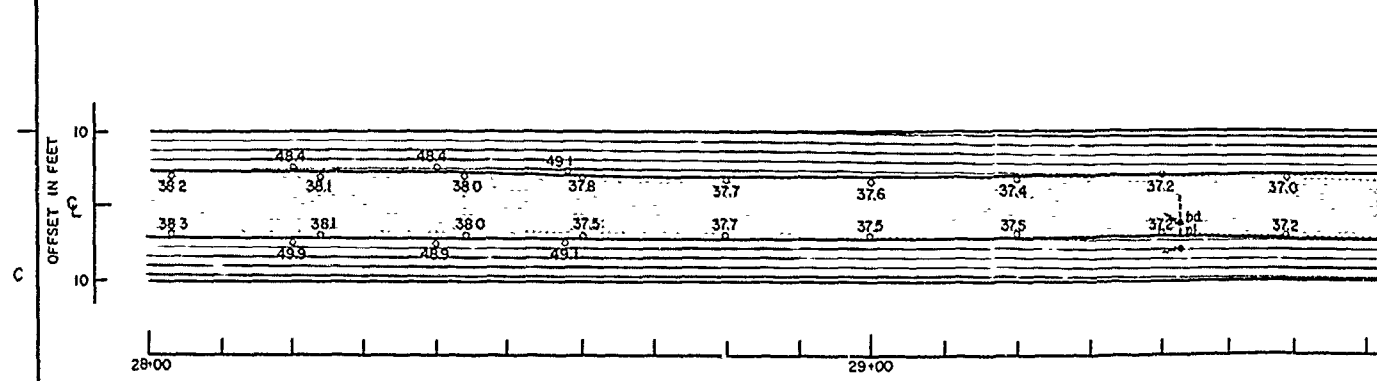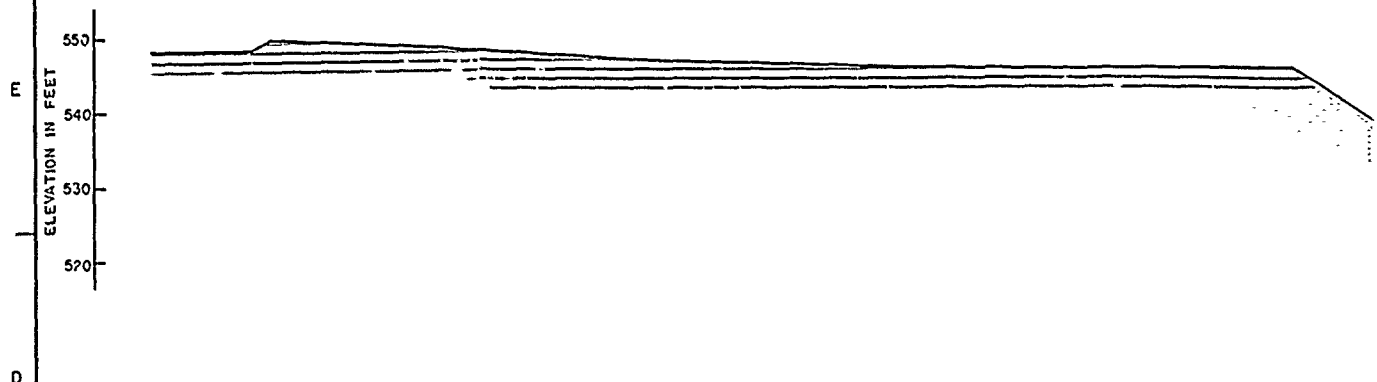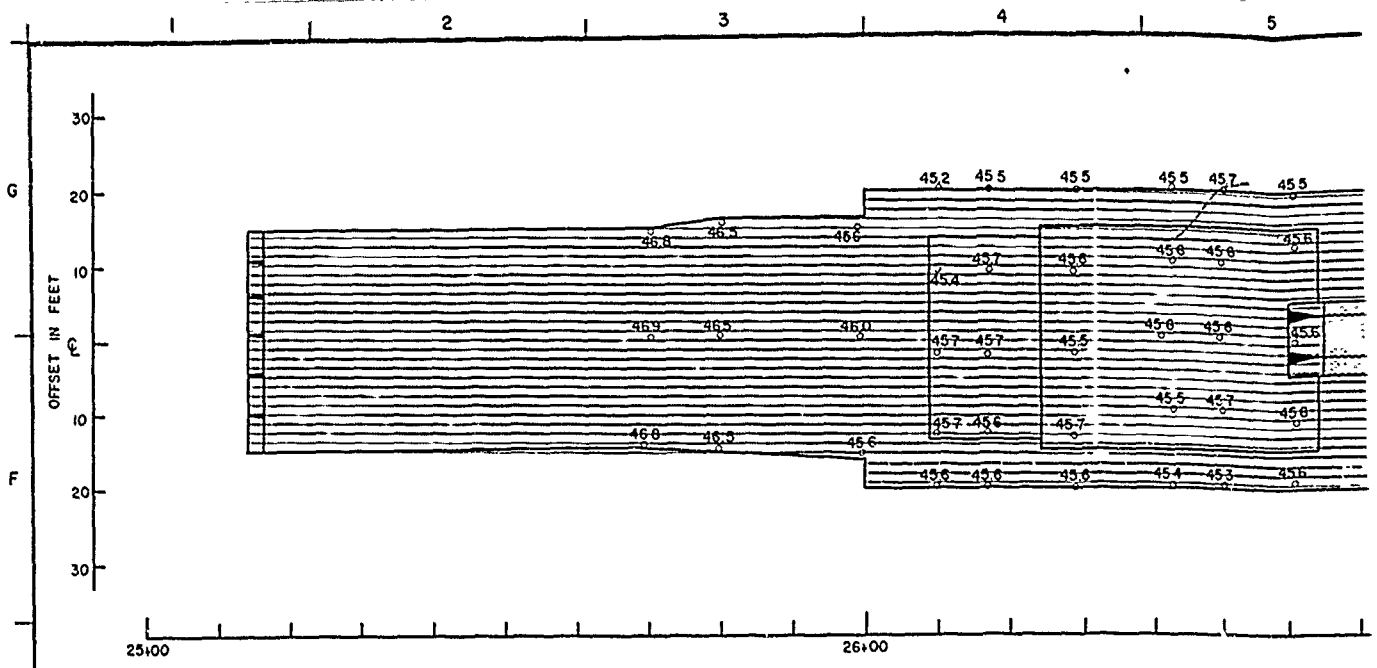

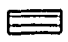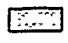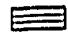
- LEGEN**
- 
 - 
 - 
 - 



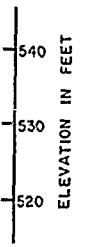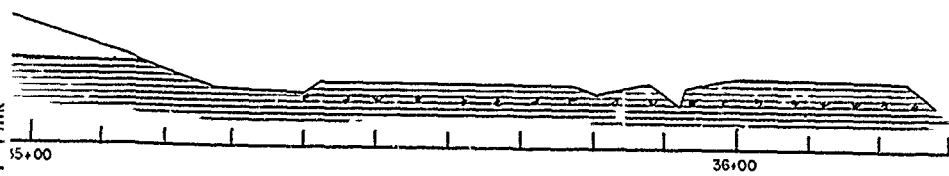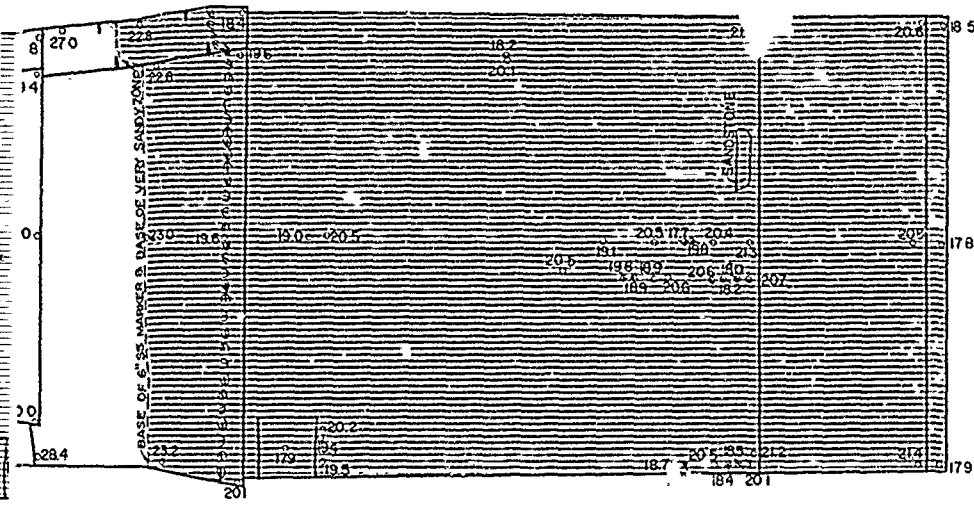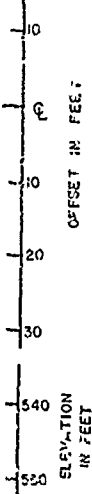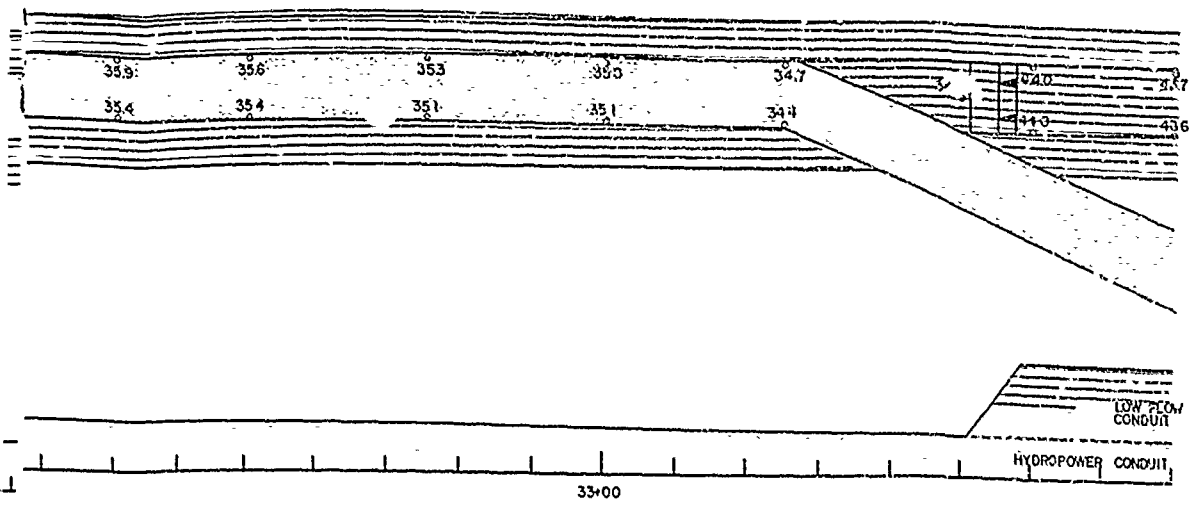





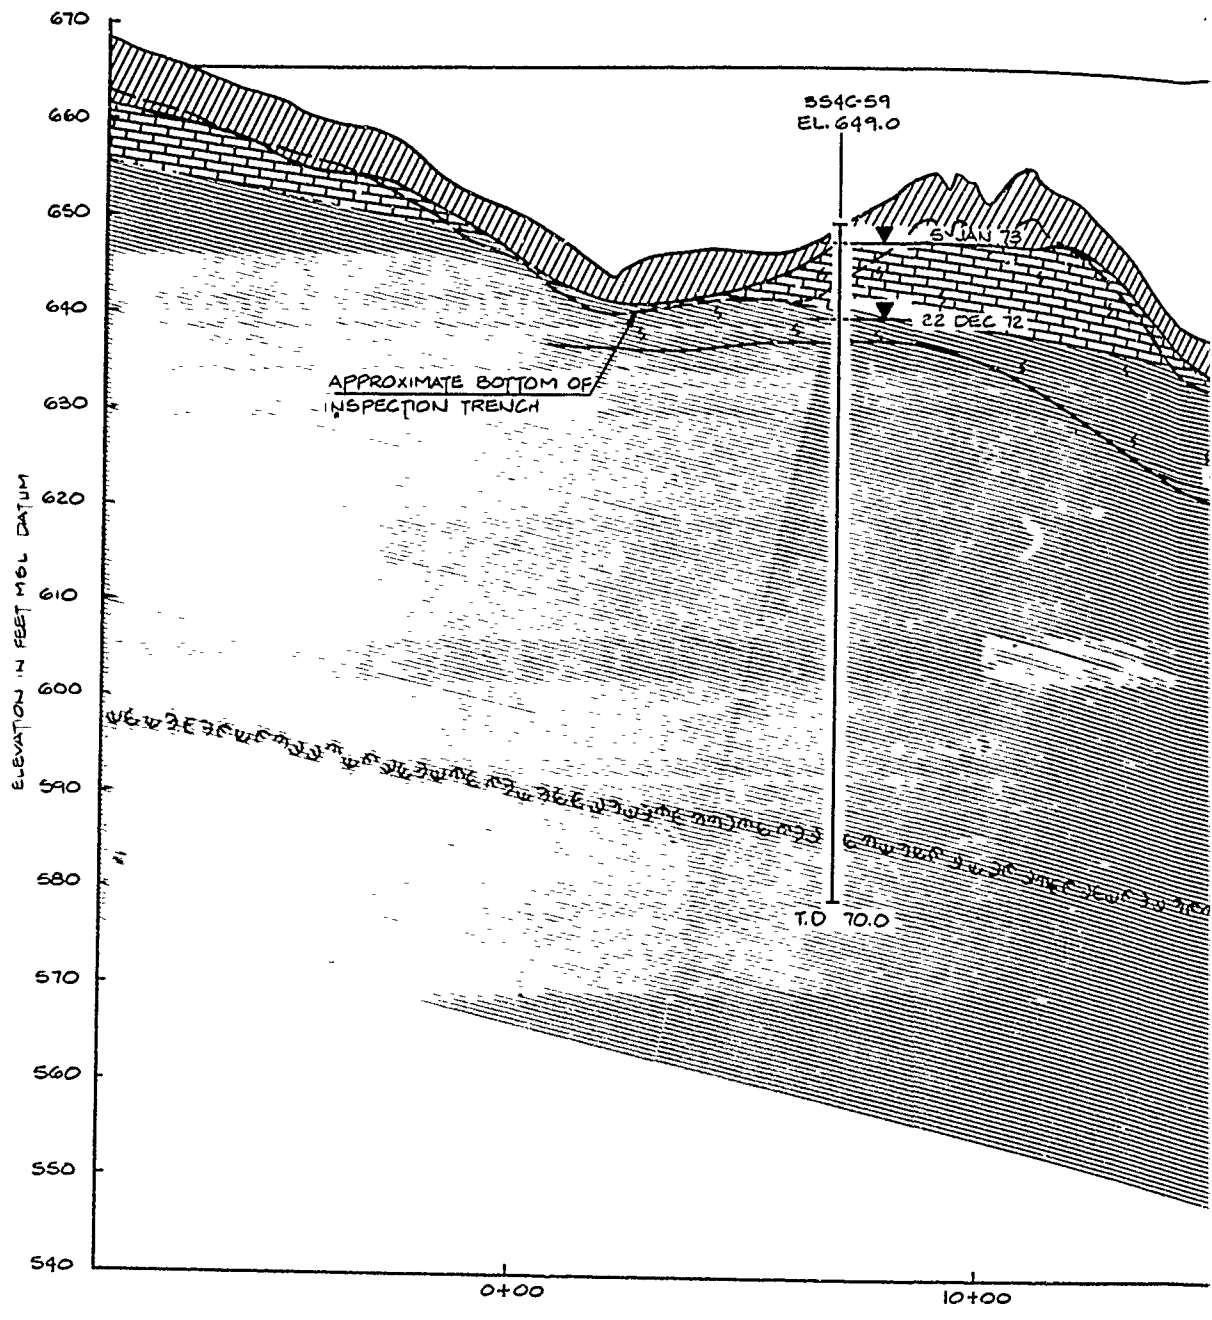


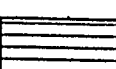


NOTE:
FOR LEGEND, SEE PLATE NO. 42.

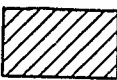
DESIGNED BY: H. BARNETT	RAY ROBERTS LAKE E.L.M. FORK, TRINITY RIVER, TEXAS	
DRAWN BY: C. KIRBY	FOUNDATION REPORT	
REVIEWED BY: R. BEHM	OUTLET WORKS	
ENGINEER:	STA. 31+00 TO 36+25	
APPROVED BY: ROBERT C. BEHM	CONTR. NO.	DATED:
ENGINEER:	DRAWING NUMBER	SHEET NO. 43

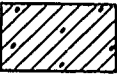




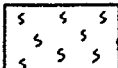
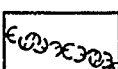

LEGEND

- | | | | | | |
|---|--|---|--|---|----------------------------|
|  | CLAY, VARIABLY SILTY AND SANDY |  | SHALE & SANDY SHALE |  | SANDSTONE, VARIAB |
|  | CLAY, GRAVELLY |  | SHALE CALCAREOUS |  | LIMESTONE, MODERAT TO HARD |
|  | SAND, VARIABLY CLAYEY SANDY & GRAVELLY |  | SHALE, SANDY W/ NUMEROUS LENSES OF MODERATELY TO WELL CEMENTED SANDSTONE | | |
|  | GRAVEL, VARIABLY SANDY & CLAYEY |  | SHALE, NON-SANDY | | |

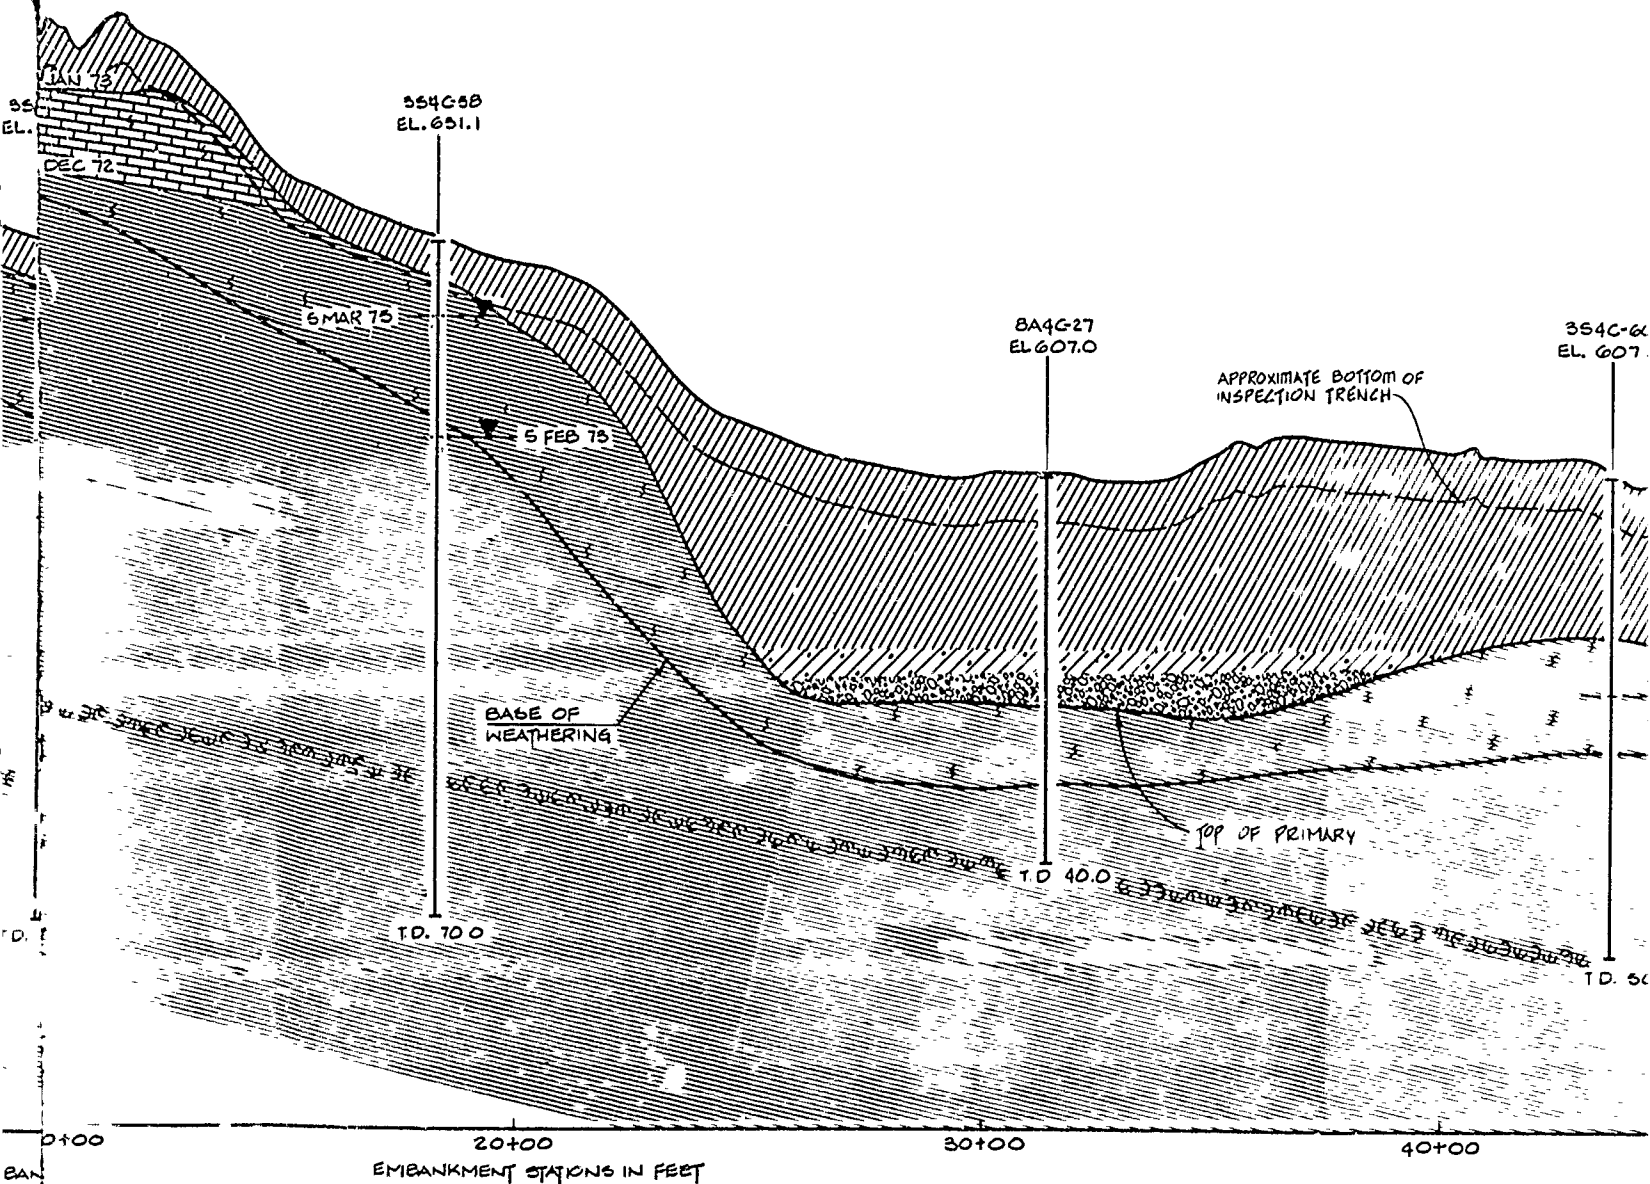TOP OF DAM EL. 665.0




LEGEND

-  WATER LEVEL ON DATE INDICATED
-  SANDSTONE, VARIABLY CEMENTED
-  LIMESTONE, MODERATELY HARD TO HARD
-  WEATHERED ZONE
-  FOSSILIFEROUS ZONE
-  100 OHM RESISTIVITY LOG
- BA 8-INCH AUGER BORING
- 6D 6-INCH DENISON BORING
- 6C 6-INCH CORE BORING
- 4C 4-INCH CORE BORING
- 3S 3-INCH SHGLBY TUBE
- 2C 2-INCH CORE BORING
- F FISHTAIL WASH BORING
- C CORE BORING
- T.D. TOTAL DEPTH

GENERAL NOTES

1. OVERBURDEN AND PRIMARY STRATA DESCRIPTIONS ARE GENERALIZED SEE SEQUENCES 205 THROUGH 236 FOR DETAILED LOGS OF BORINGS.
2. ABSENCE OF GROUND WATER LEVELS OPPOSITE BORING LOGS DOES NOT NECESSARILY MEAN THAT GROUND WATER WILL NOT BE ENCOUNTERED AT THE LOCATION OR WITHIN THE VERTICAL REACHES OF THE BORINGS. WATER LEVELS WILL FLUCTUATE DEPENDING ON SEASON AND RAINFALL.
3. FOR DETAIL OF CUTOFF AND INSPECTION TRENCH SEE SEQ. 171 AND 172.

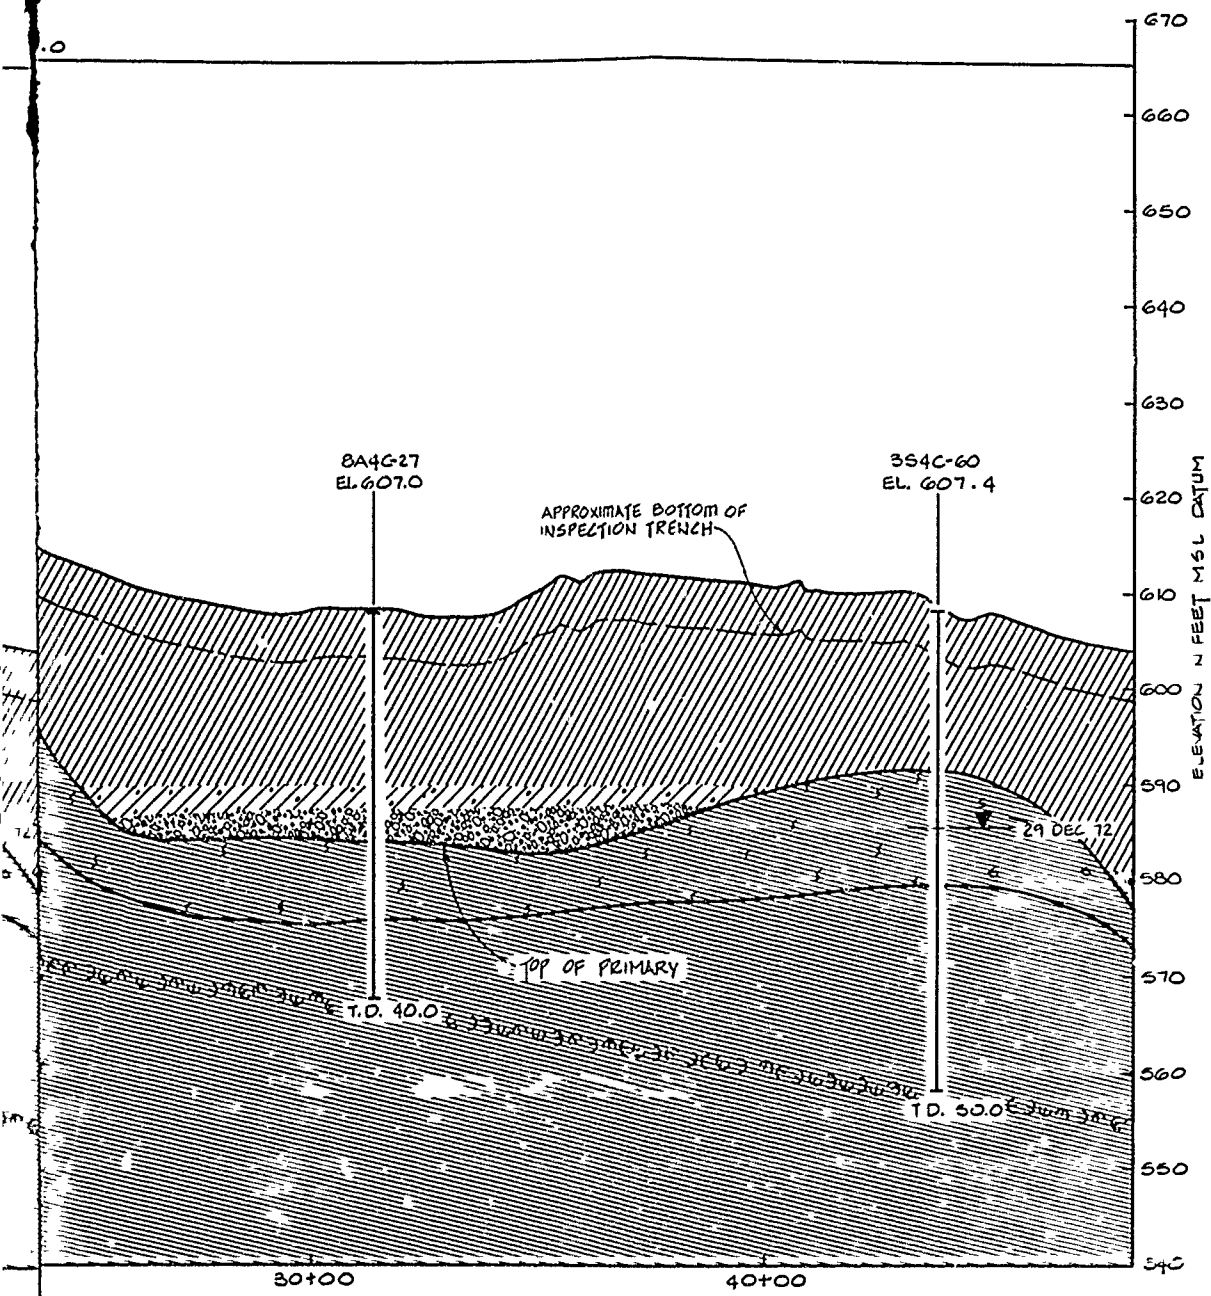

GENERAL NOTES


1. OVERBURDEN AND PRIMARY STRATA DESCRIPTIONS ARE GENERALIZED SEE SEQUENCES 225 THROUGH 236 FOR DETAILED LOGS OF BORINGS.
2. ABSENCE OF GROUND WATER LEVELS OPPOSITE BORING LOGS DOES NOT NECESSARILY MEAN THAT GROUND WATER WILL NOT BE ENCOUNTERED AT THE LOCATION OR WITHIN THE VERTICAL REACHES OF THE BORINGS. WATER LEVELS WILL FLUCTUATE DEPENDING ON SEASON AND RAINFALL.
3. FOR DETAIL OF CUTOFF AND INSPECTION TRENCH SEE SEC. 171 AND 172.

RECORD DRAWING-WORK AS BUILT

- LEVEL ON INDICATED
- 8A 8-INCH AUGER BORING
 - 6D 6-INCH DENISON BORING
 - 6C 6-INCH CORE BORING
 - 4C 4-INCH CORE BORING
 - 3S 3-INCH SHELBY TUBE
 - 2C 2-INCH CORE BORING
 - F FISHTAIL WASH BORING
 - C CORE BORING
 - T.D. TOTAL DEPTH

REVISION NO.	ACTION	DATE	DESCRIPTION OF REVISION
U.S. ARMY ENGINEER DISTRICT, FORT WORTH CORPS OF ENGINEERS FORT WORTH, TEXAS			
RAY ROBERTS LAKE ELM FORK TRINITY RIVER, TEXAS EMBANKMENT GEOLOGIC PROFILE EMBANKMENT CENTERLINE (STA. 0+00 TO STA. 48+00)			
DESIGNED BY: R. HAGEN	INVITATION NO. DACW 63-82-B-0025 DATE: MAR 1982 CONTRACT NO. DACW 63-82-C-0083 DRAWING NUMBER _____ SHEET NO. OF 44		
DRAWN BY: H. RUTHERFORD			
REVIEWED BY: R. HAGEN			
SUBMITTED BY: M. GREEN ENGINEER			

TO ACCOMPANY FOUNDATION REPORT

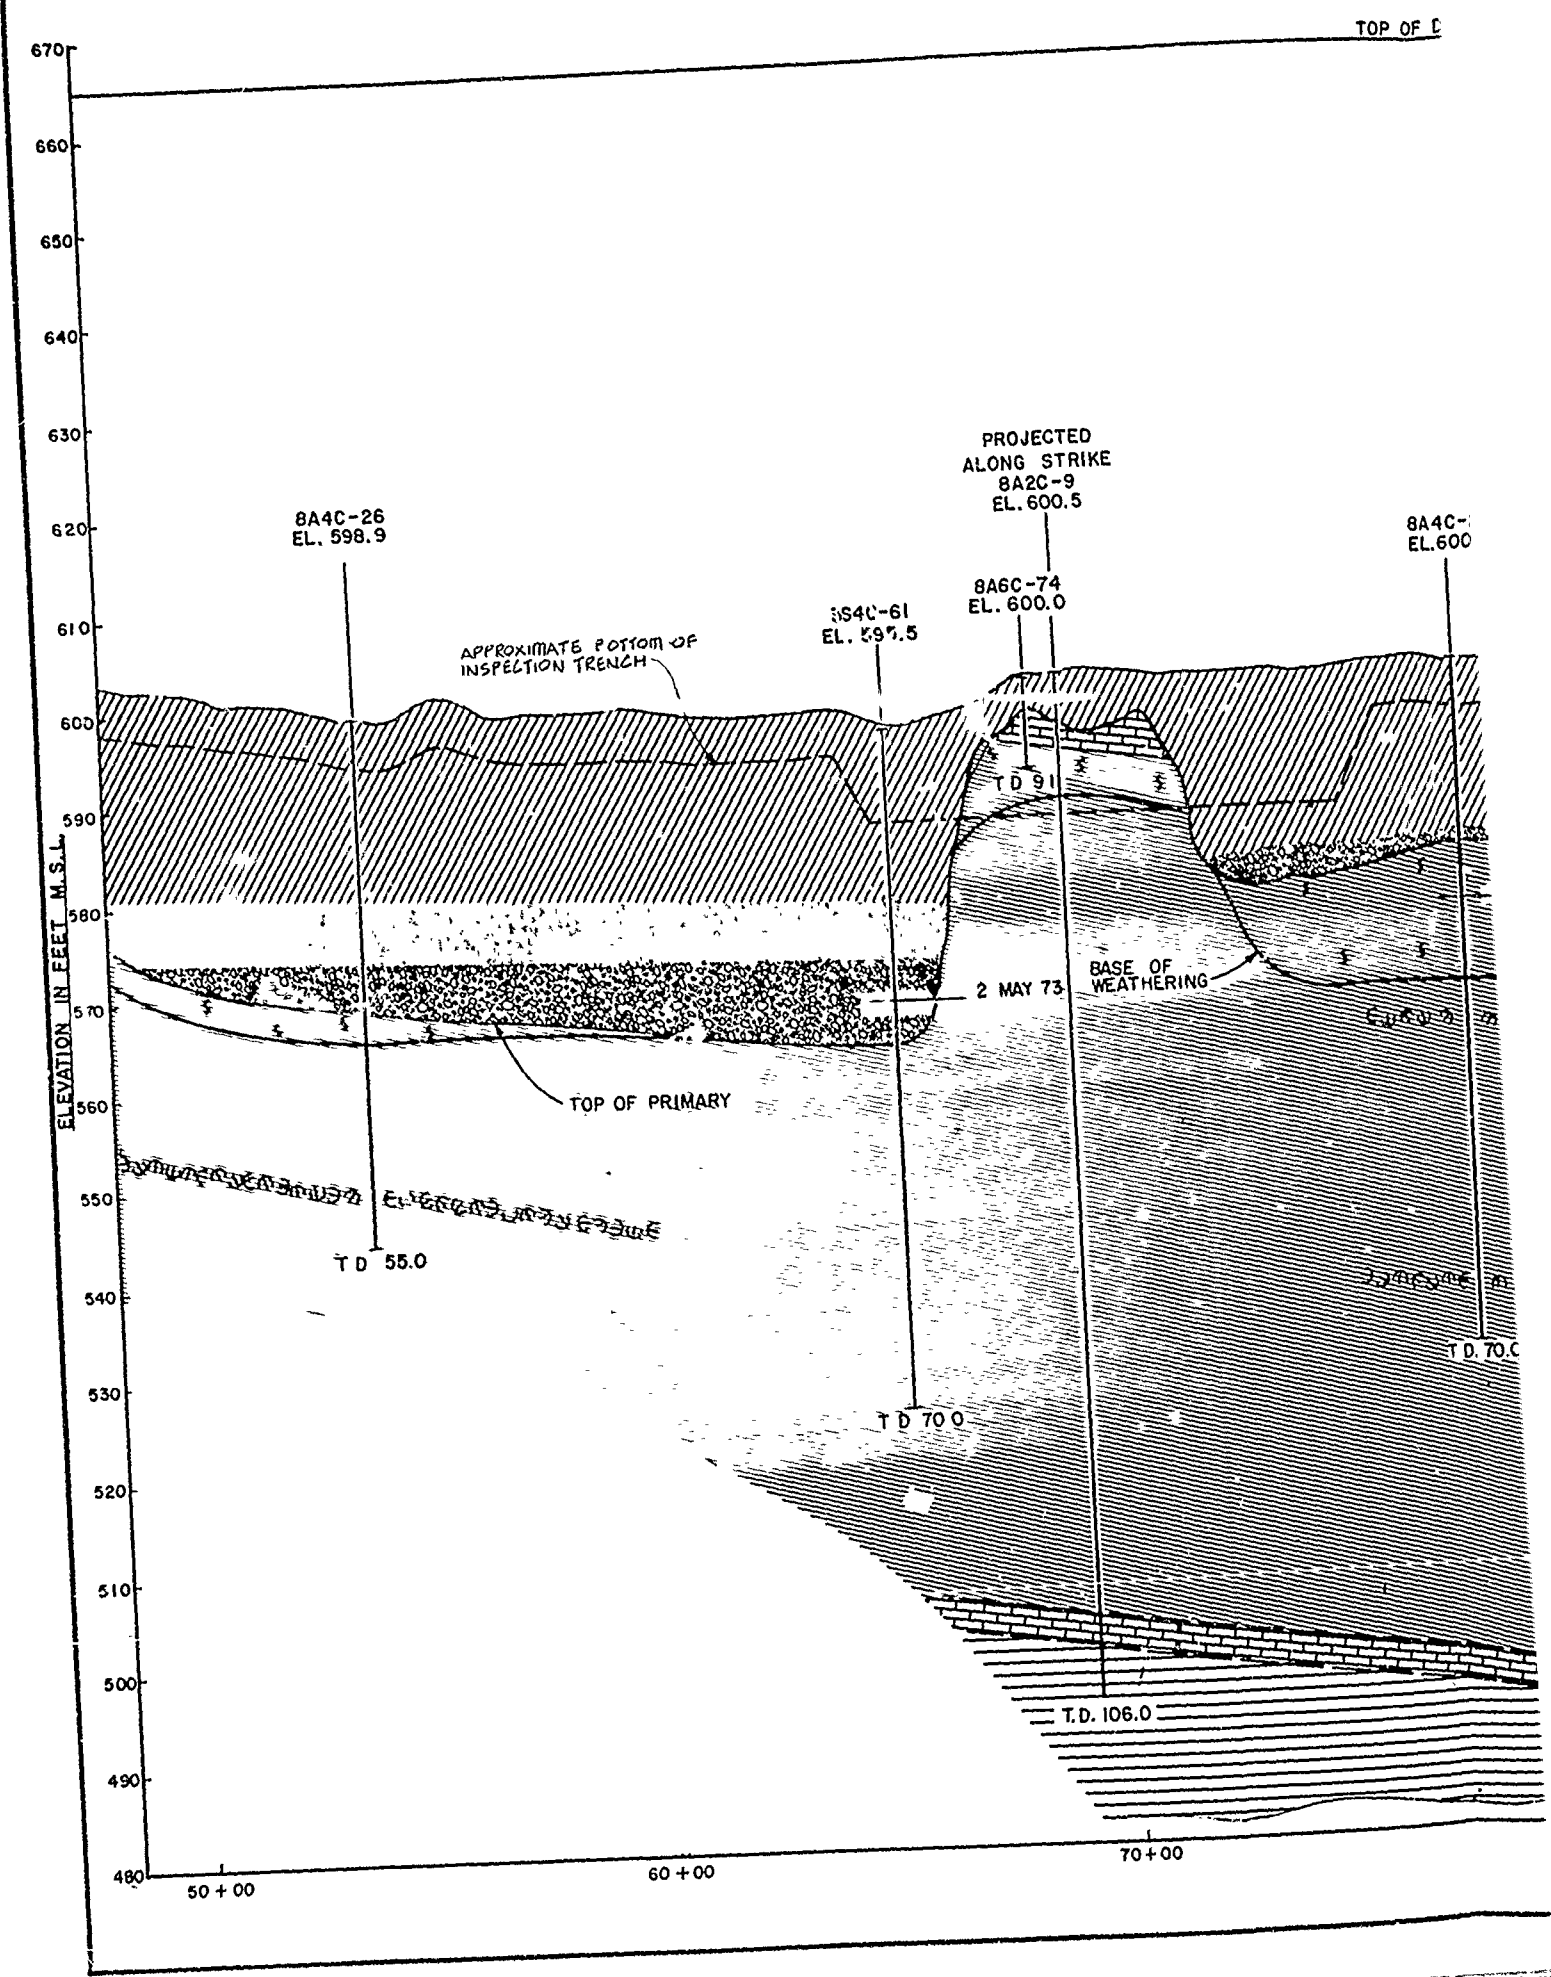

TOP OF DAM EL. 665.0

ELEVATION IN FEET M.S.L.
670
660
650
8A4C-25
EL. 600.4

6DC-18
EL. 595.1

C-1
EL. 597.2

6A4C-20
EL. 597.0

6DC-17
EL. 578.2

PROJ
8A6C-72
EL. 571.1

8A6C-73
EL. 560.4

7 AUG 72

9 SEPT 71

5 MAR 75

4 MAR 75

22 AUG 73

START OF CUTOFF TRENCH
STATION 86+00

APPROXIMATE BOTTOM OF
CUTOFF TRENCH

APPROXIMATE OUTLET
WORKS EXCAVATION

OUTLET
WORKS

END OF CUTOFF TRENCH
STATION 102+50

TOP OF PRIMARY
STRATA

T.D. 700

T.D. 300

T.D. 470

T.D. 280

T.D. 190

T.D. 500


T.D. 970


80+00

90+00

100+00

EXISTING GROUND SURFACE

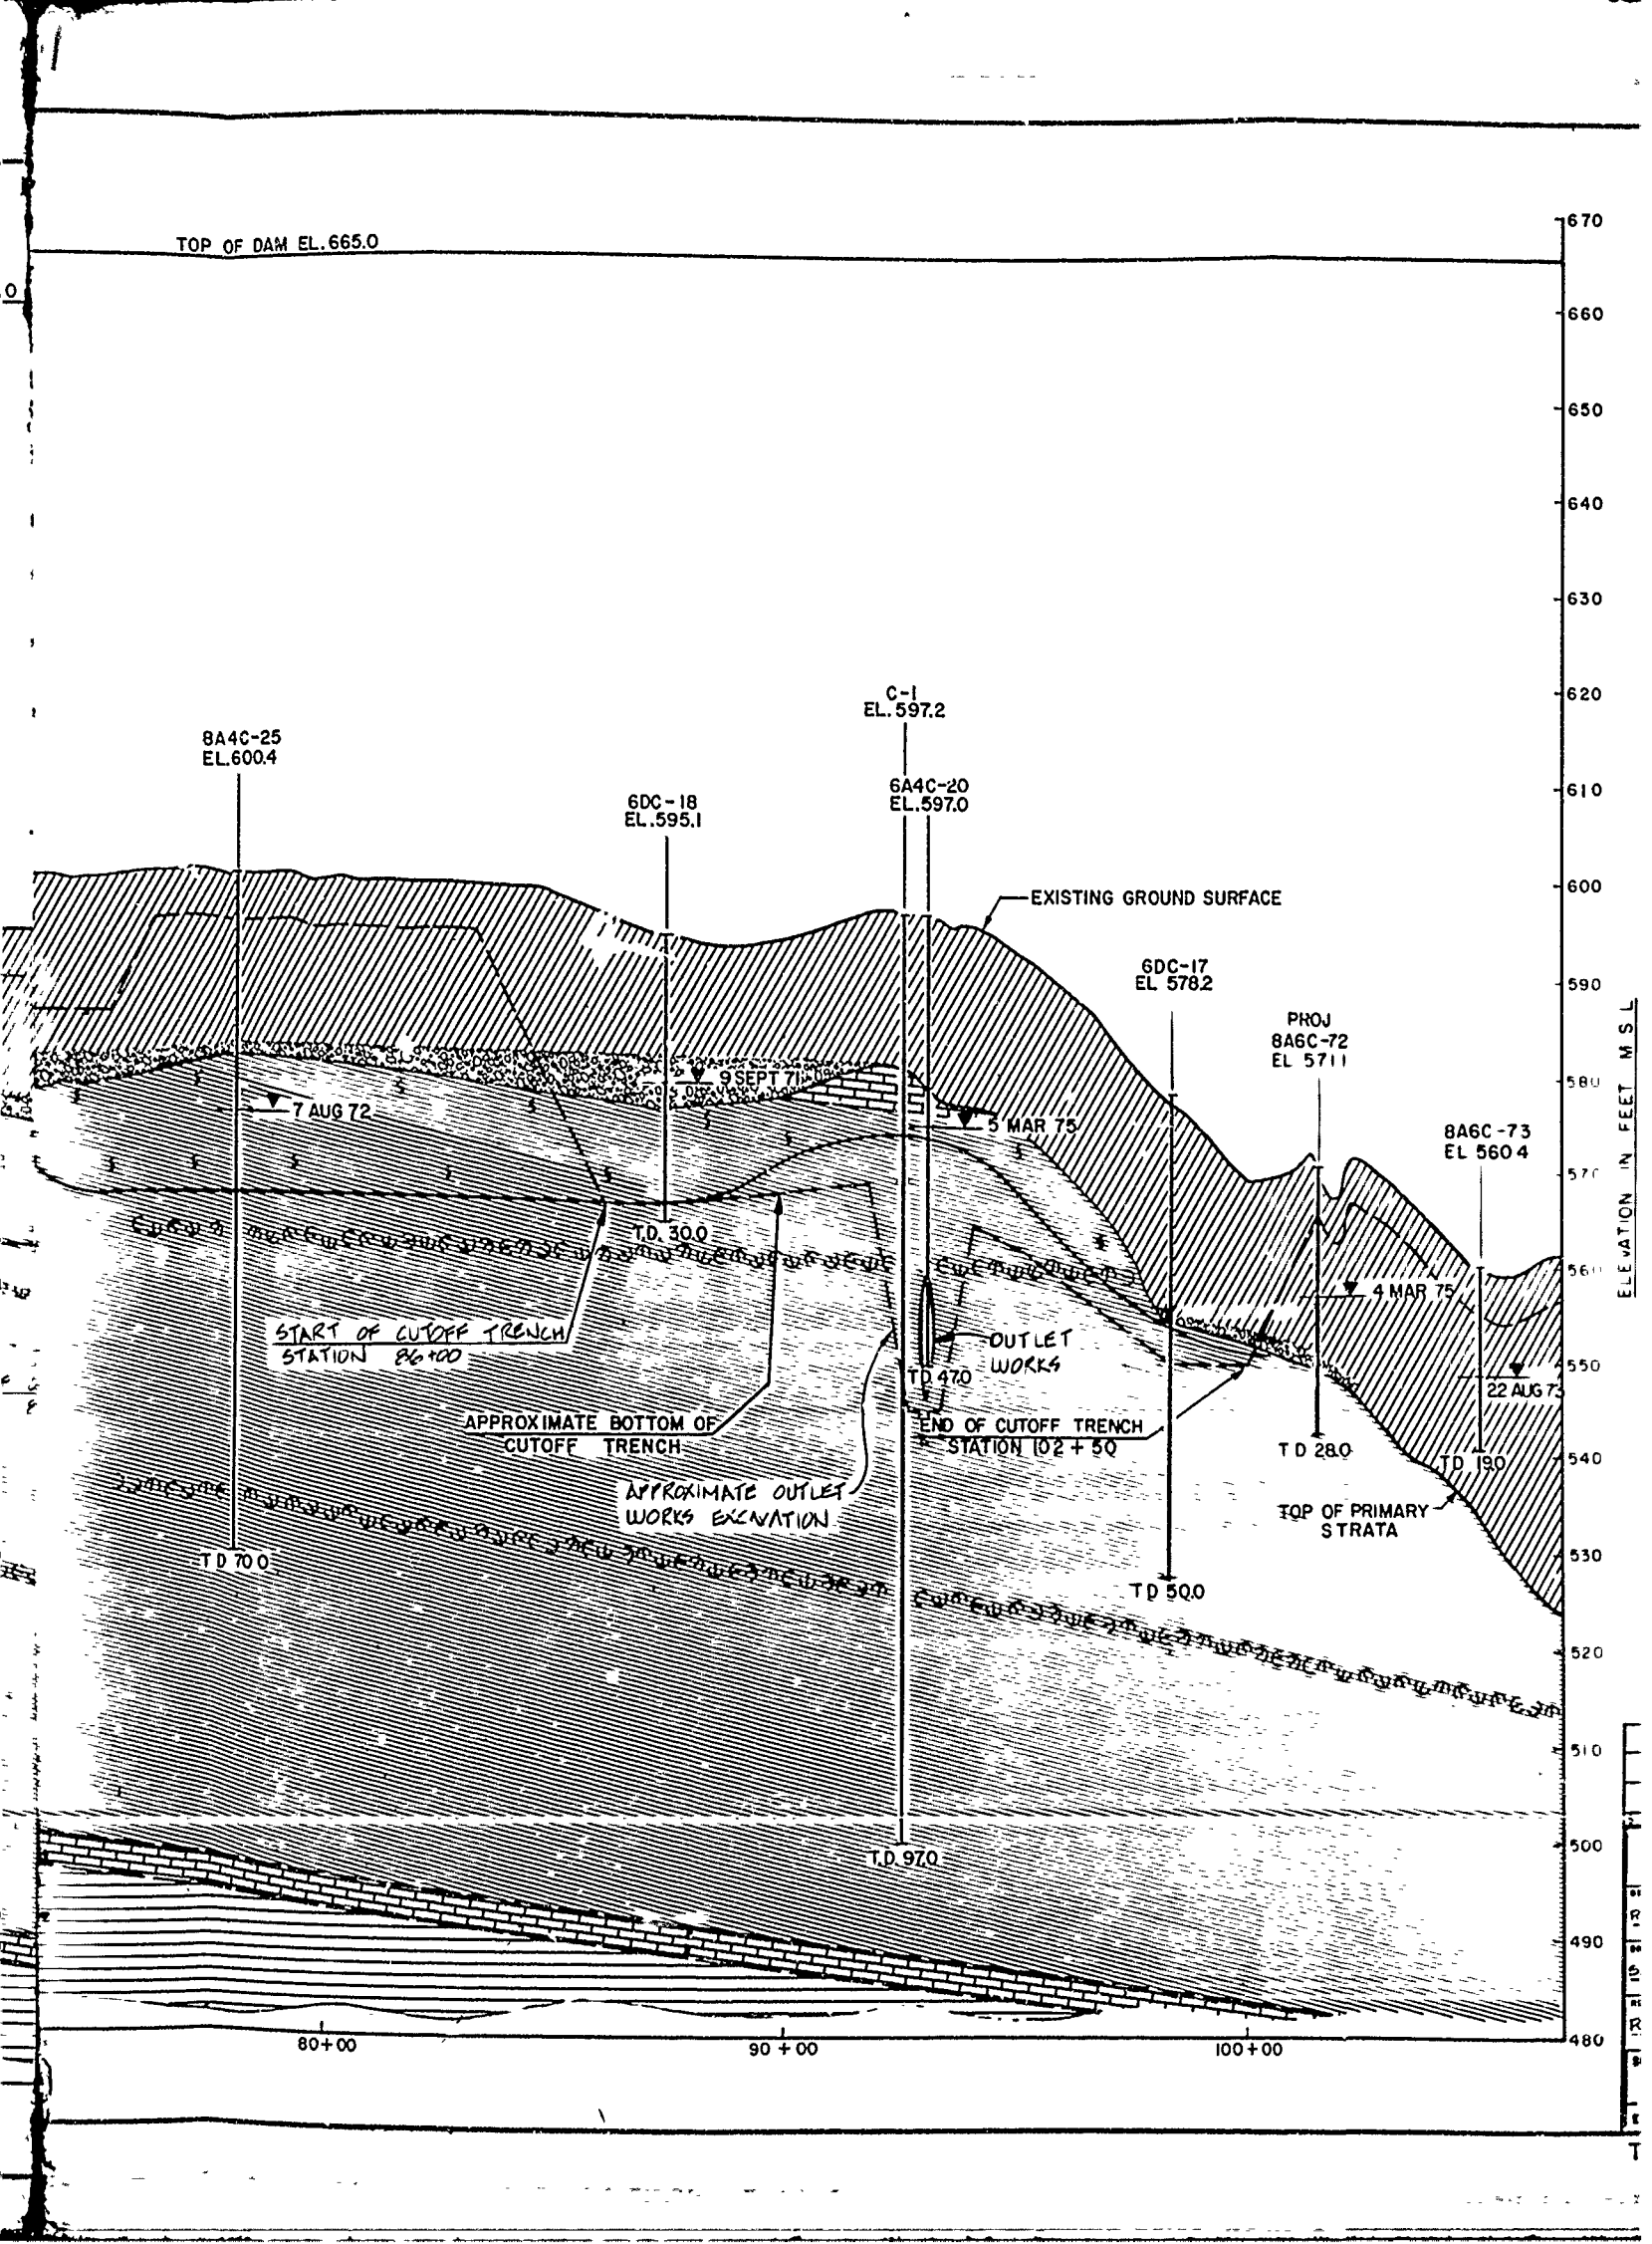

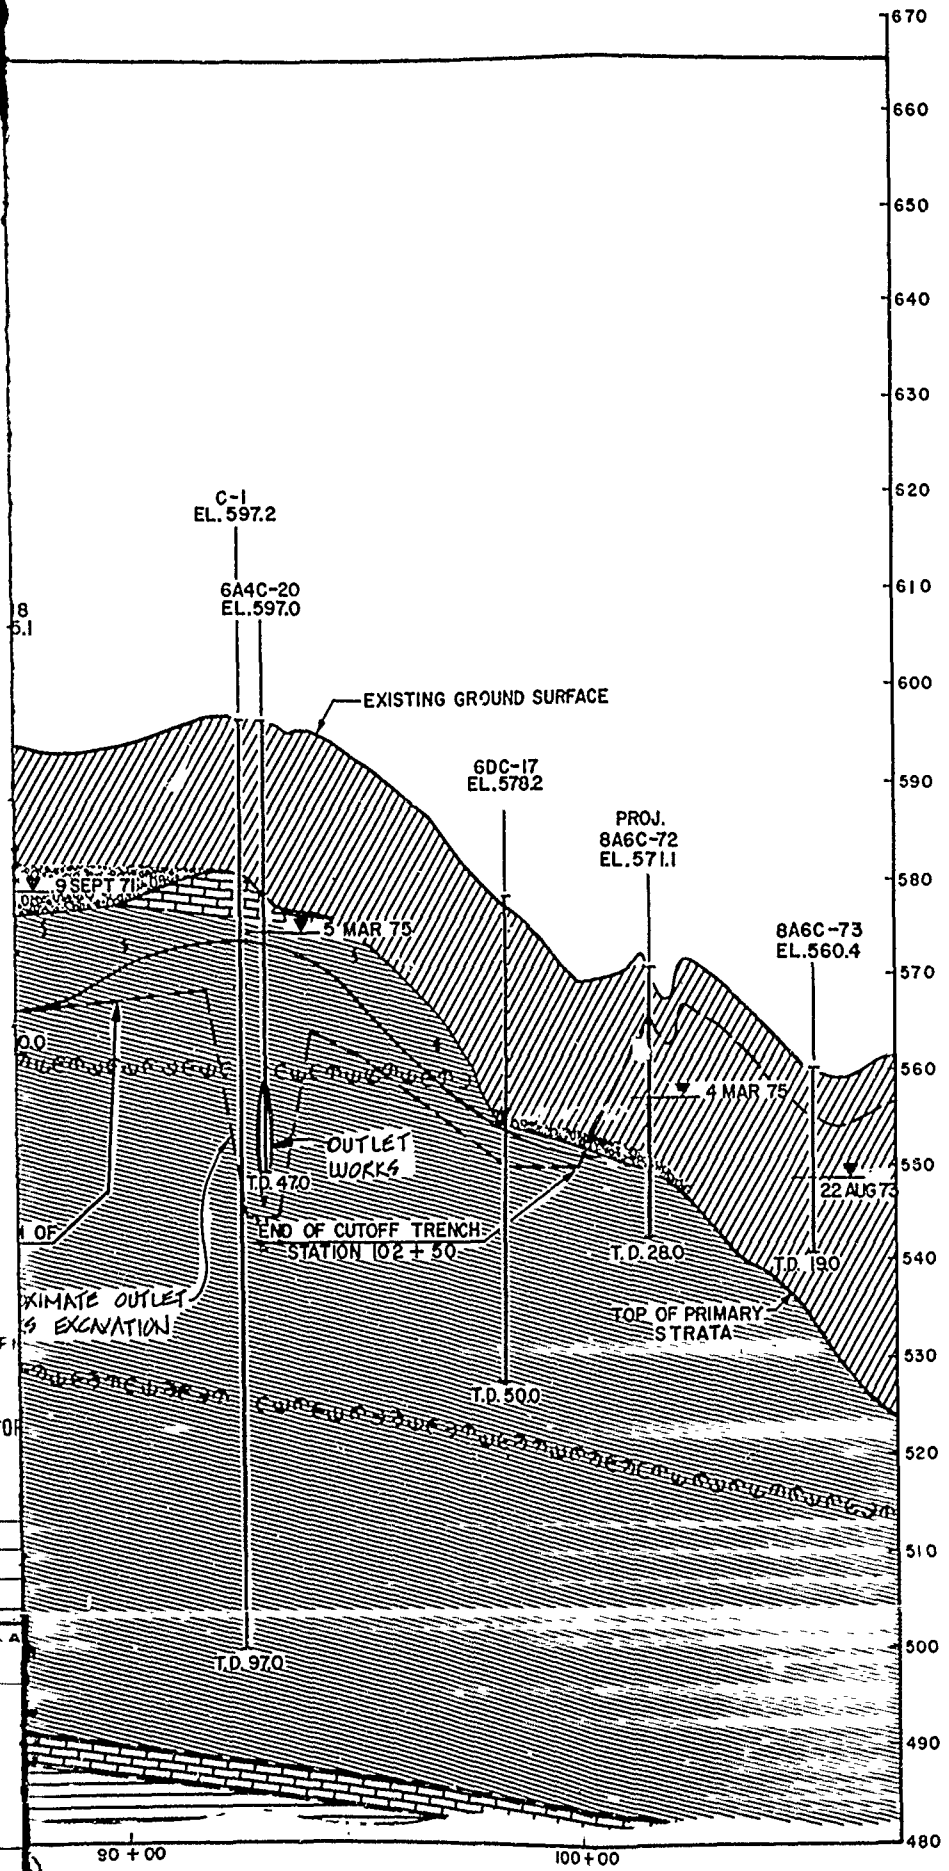


FOR LEGEND AND GENERAL NOTES, SEE SEQ 199


RECORD DRAWING-WORK AS BUILT

SYM	NO	ACTION	DATE	DESCRIPTION OF REVISION
U.S. ARMY ENGINEER DISTRICT, FORT WORTH CORPS OF ENGINEERS FORT WORTH, TEXAS				
RAY ROBERTS LAKE ELM FORK, TRINITY RIVER, TEXAS				
EMBANKMENT GEOLOGIC PROFILE EMBANKMENT CENTERLINE (STATION 48+00 TO 107+00)				
DESIGNED BY R. HAGEN	INVITATION NO. DACW 63-82-B-0025 DATE: MAR, 1982 CONTRACT NO. DACW 63-82-C-0083 DRAWING NUMBER			
DRAWN BY S. KOMACK				
REVIEWED BY R. HAGEN				
SUBMITTED BY A. Green	ENGINEER	SHEET NO. OF	SEQUENCE NO. OF	45

TO ACCOMPANY FOUNDATION REPORT

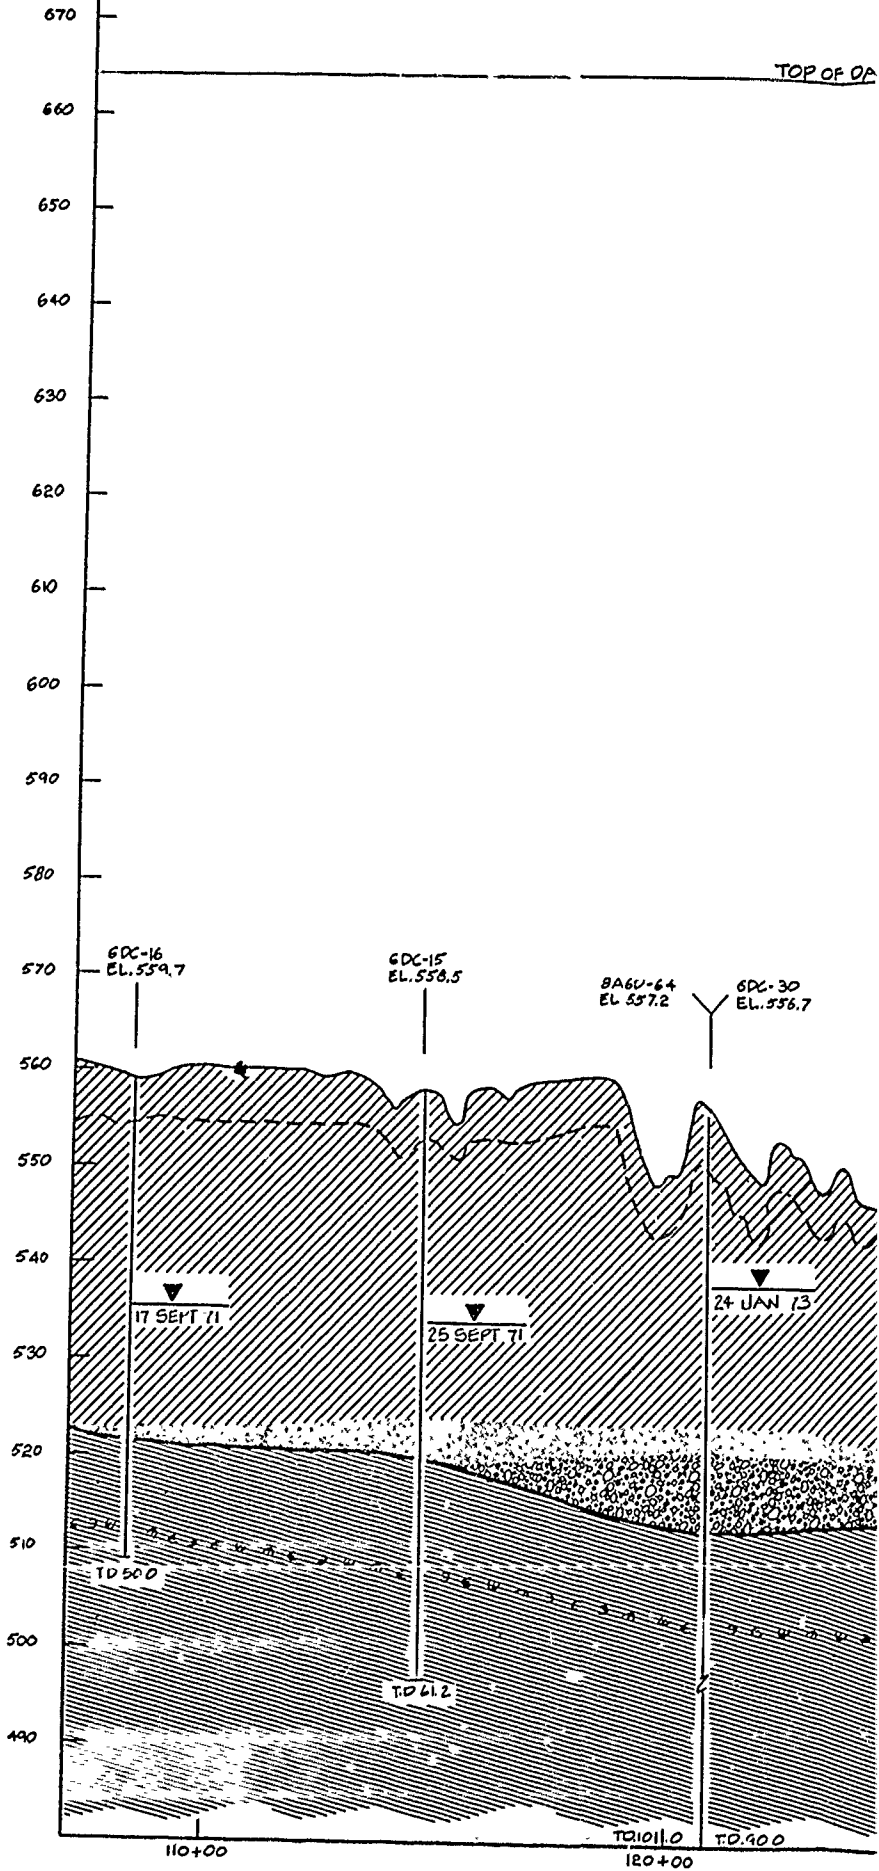

AP 10102A

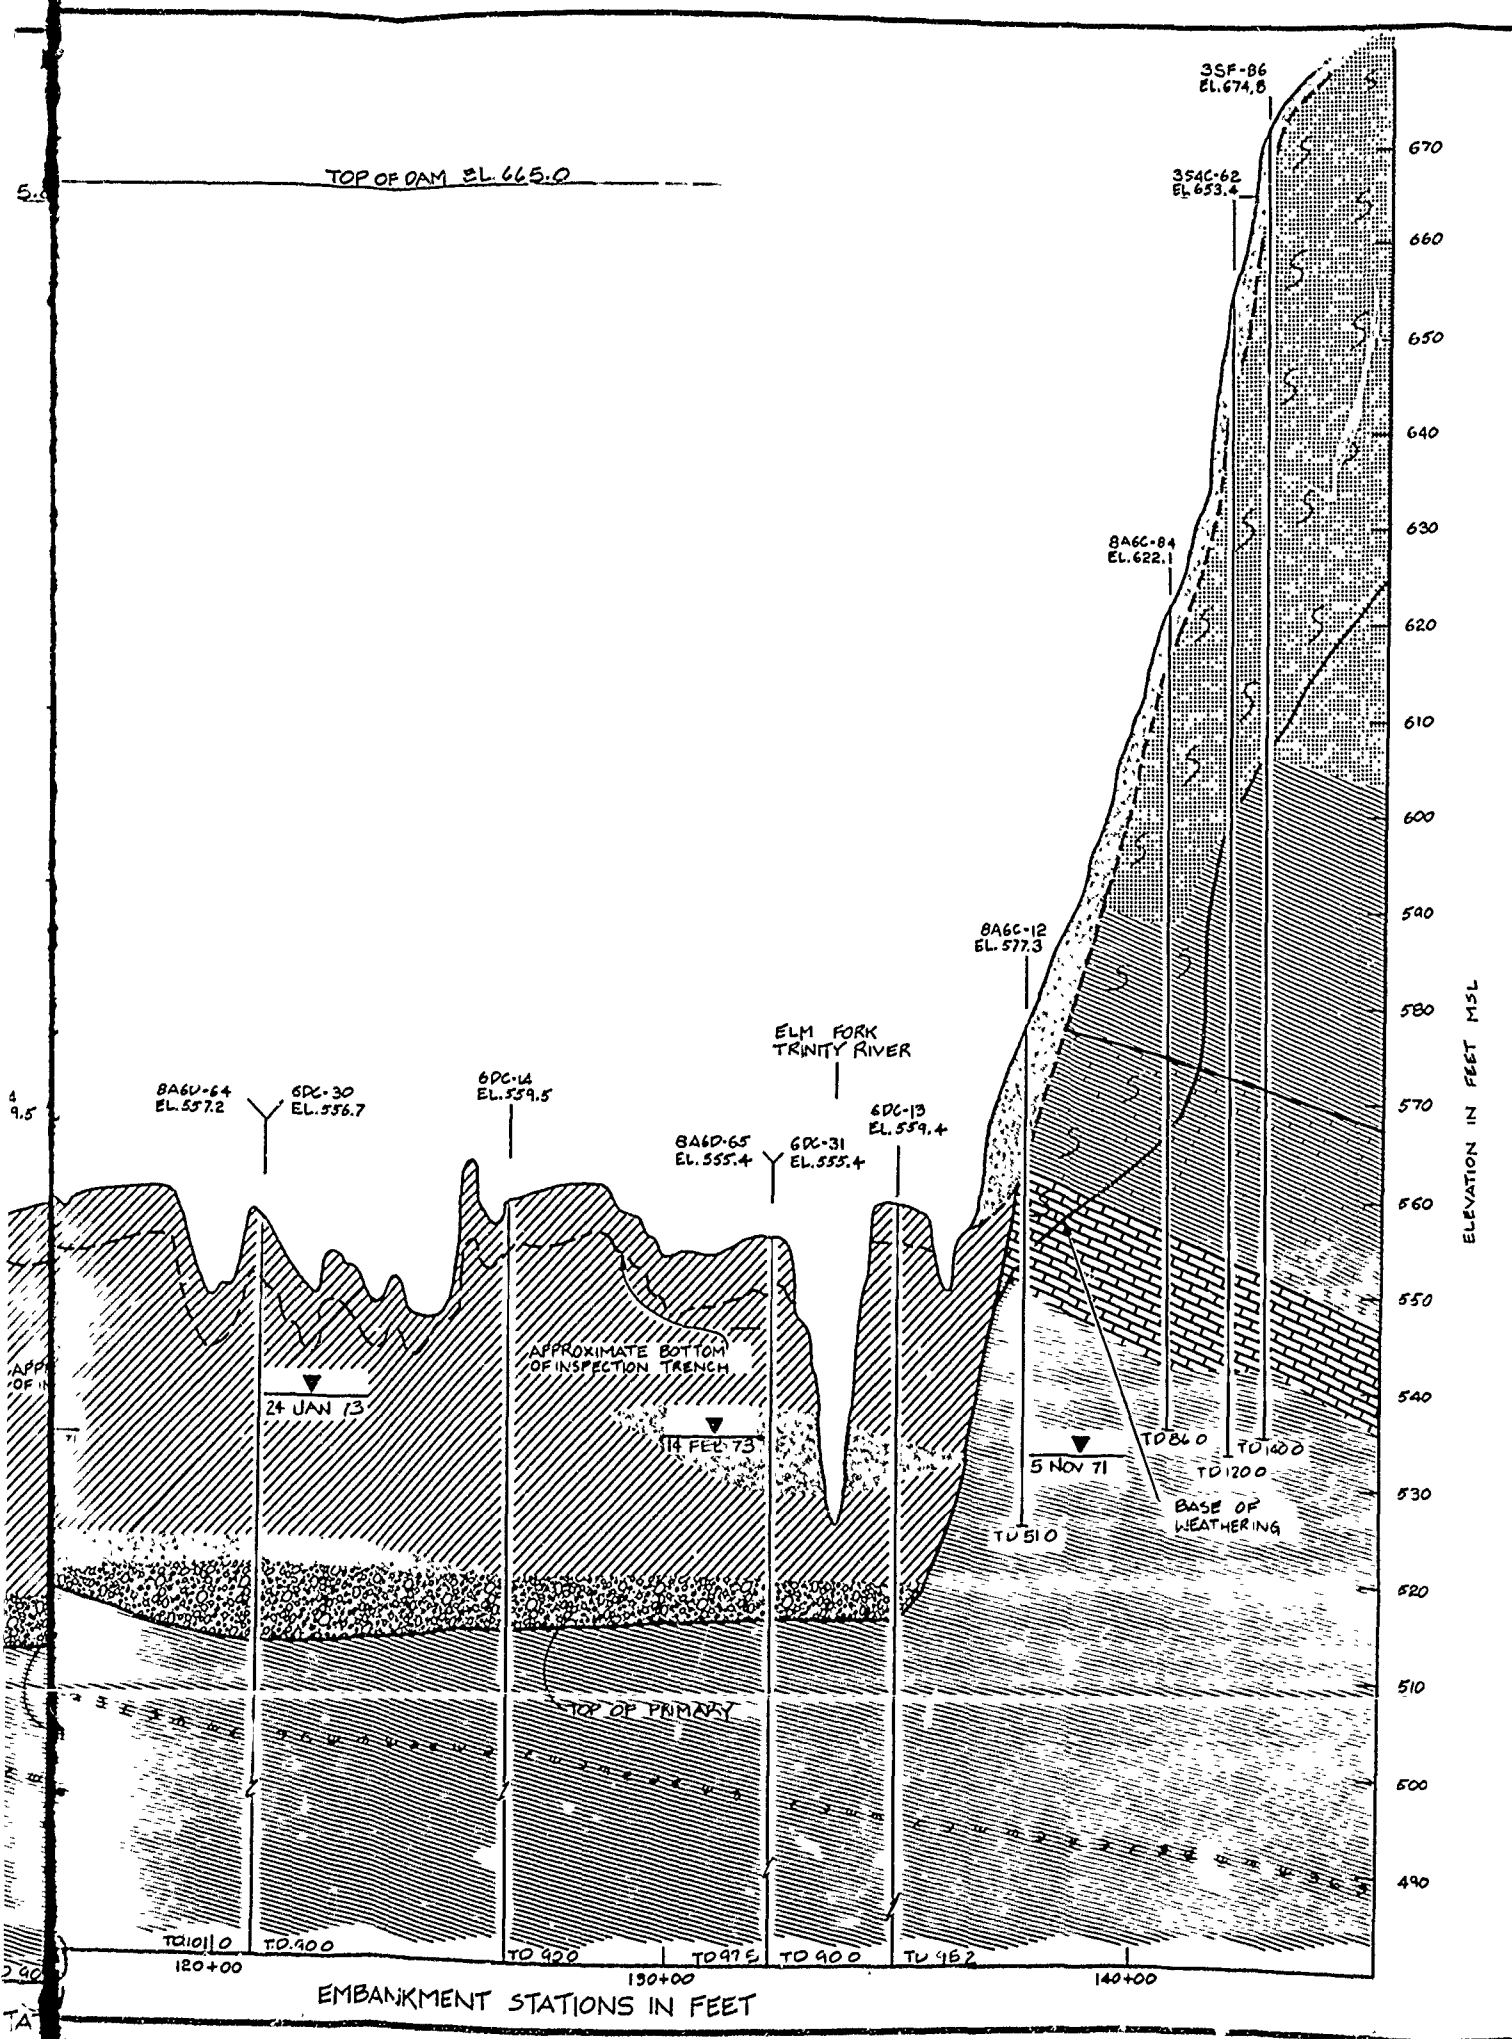

TOP OF DAM EL. 665.0

3SF-86
EL. 674.8

354C-62
EL. 653.4

8A6C-84
EL. 622.1

8A6C-12
EL. 577.3

ELM FORK
TRINITY RIVER

8A6D-64
EL. 557.2

6DC-30
EL. 556.7

6DC-14
EL. 559.5

8A6D-65
EL. 555.4

6DC-31
EL. 555.4

6DC-13
EL. 559.4

24 JAN 73

14 FEB 73

5 NOV 71

APPROXIMATE BOTTOM
OF INSPECTION
TRENCH

TO 840 TO 1400

TO 1700

BASE OF WEATHERING

TO 510

TOP OF PRIMARY

TO 1010

TO 900

TO 920

TO 975

TO 900

TO 952


120+00

130+00

140+00

EMBANKMENT STATIONS IN FEET

ELEVATION IN FEET MSL

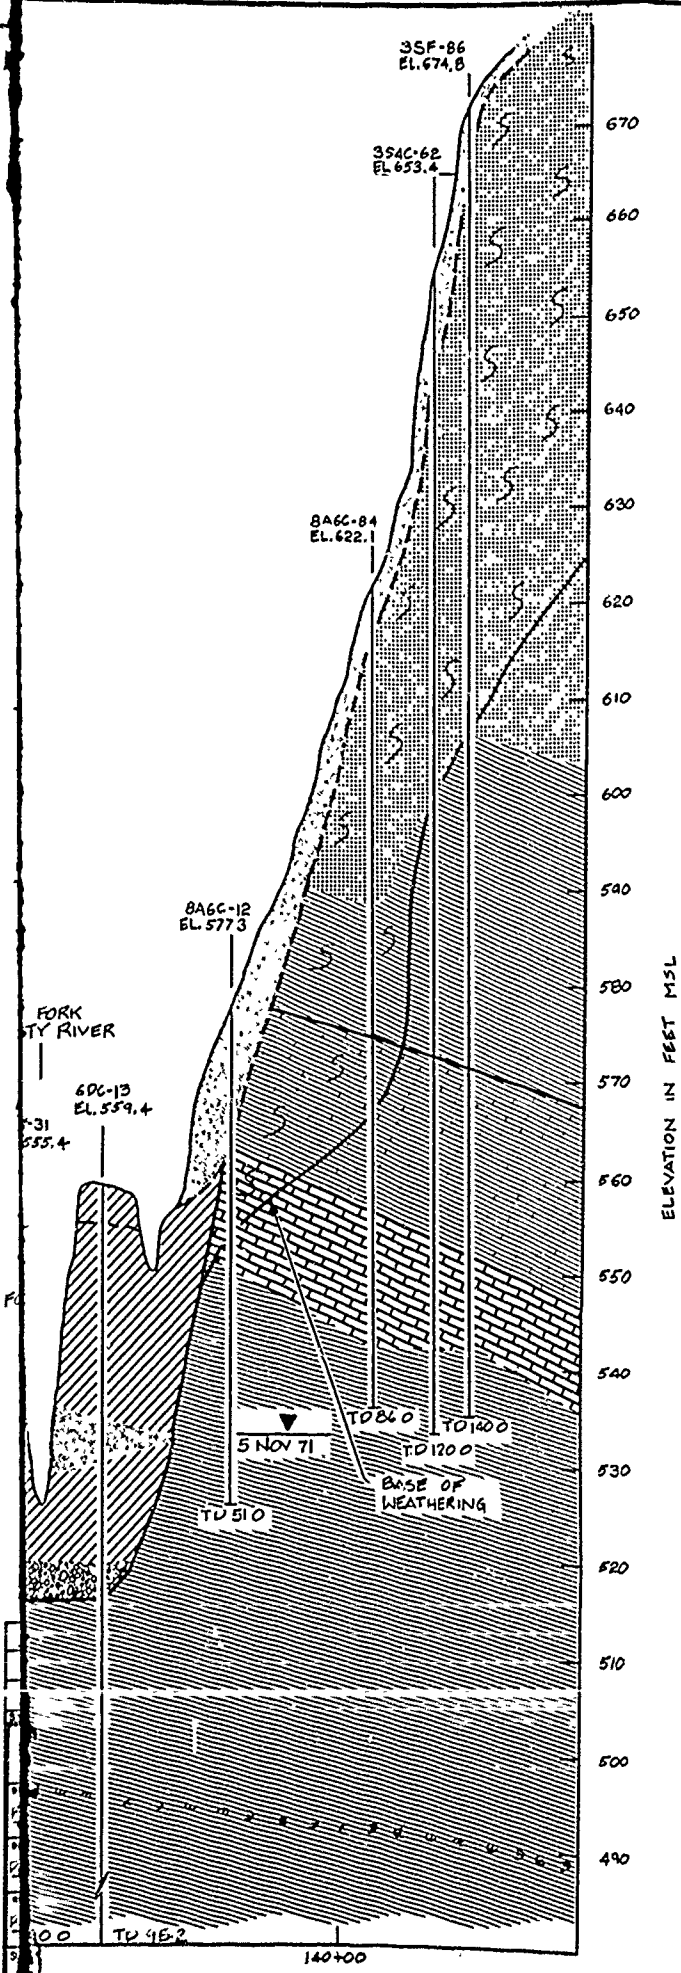



FOR LEGEND AND GENERAL NOTES SEE SEQ 19.1.

RECORD DRAWING-WORK AS BUILT

REV. LOG. NO.	ACTION	DATE	DESCRIPTION OF REVISION
U.S. ARMY ENGINEER DISTRICT, FORT WORTH CORPS OF ENGINEERS FORT WORTH, TEXAS			
DESIGNED BY:	RAY ROBERTS LAKE ELM FORK, TRINITY RIVER, TEXAS EMBANKMENT GEOLOGIC PROFILE EMBANKMENT CENTERLINE (STATION 107+00 TO 142+25)		
DRAWN BY:			
REVIEWED BY:			
SUBMITTED BY:			
R. HAGEN P. BAILEY R. HAGEN M. GREEN ENGINEER	INVITATION NO. DACW43-82B-0025 CONTRACT NO. DACW43-82C-0083 DRAWING NUMBER	DATE: MAR., 1983 SHEET NO. 4 OF 4	

TO ACCOMPANY FOUNDATION REPORT

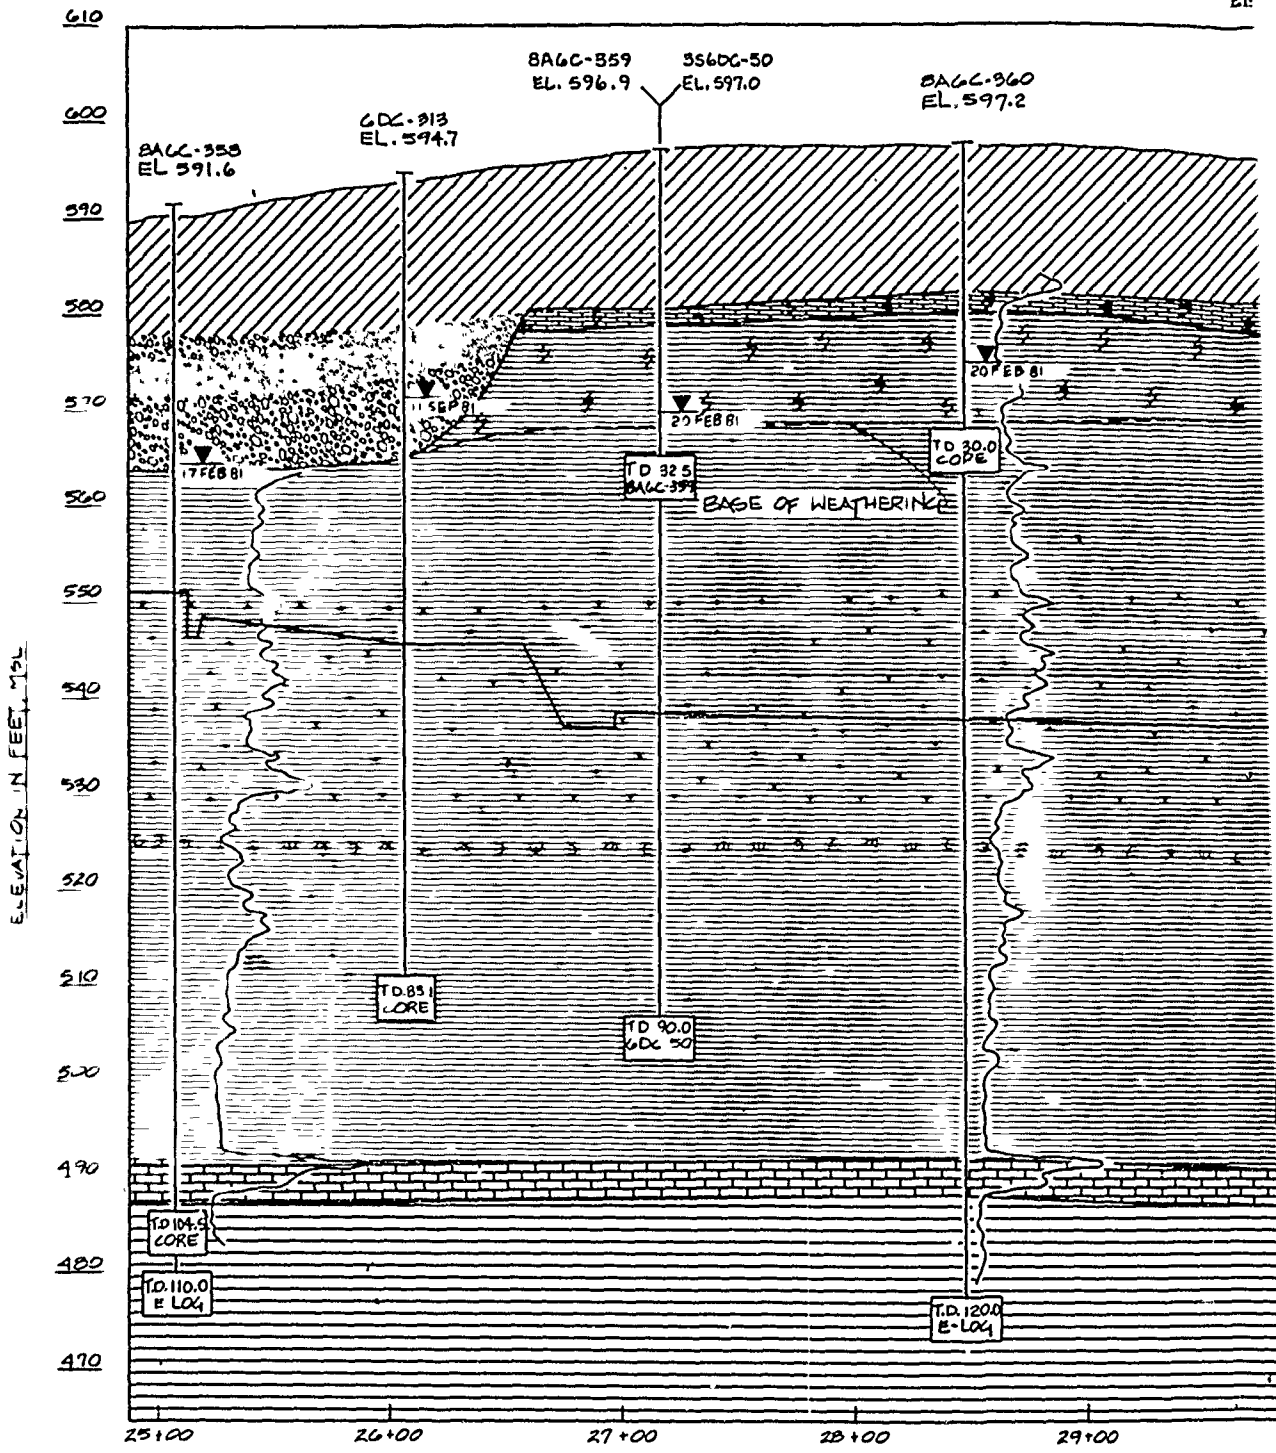

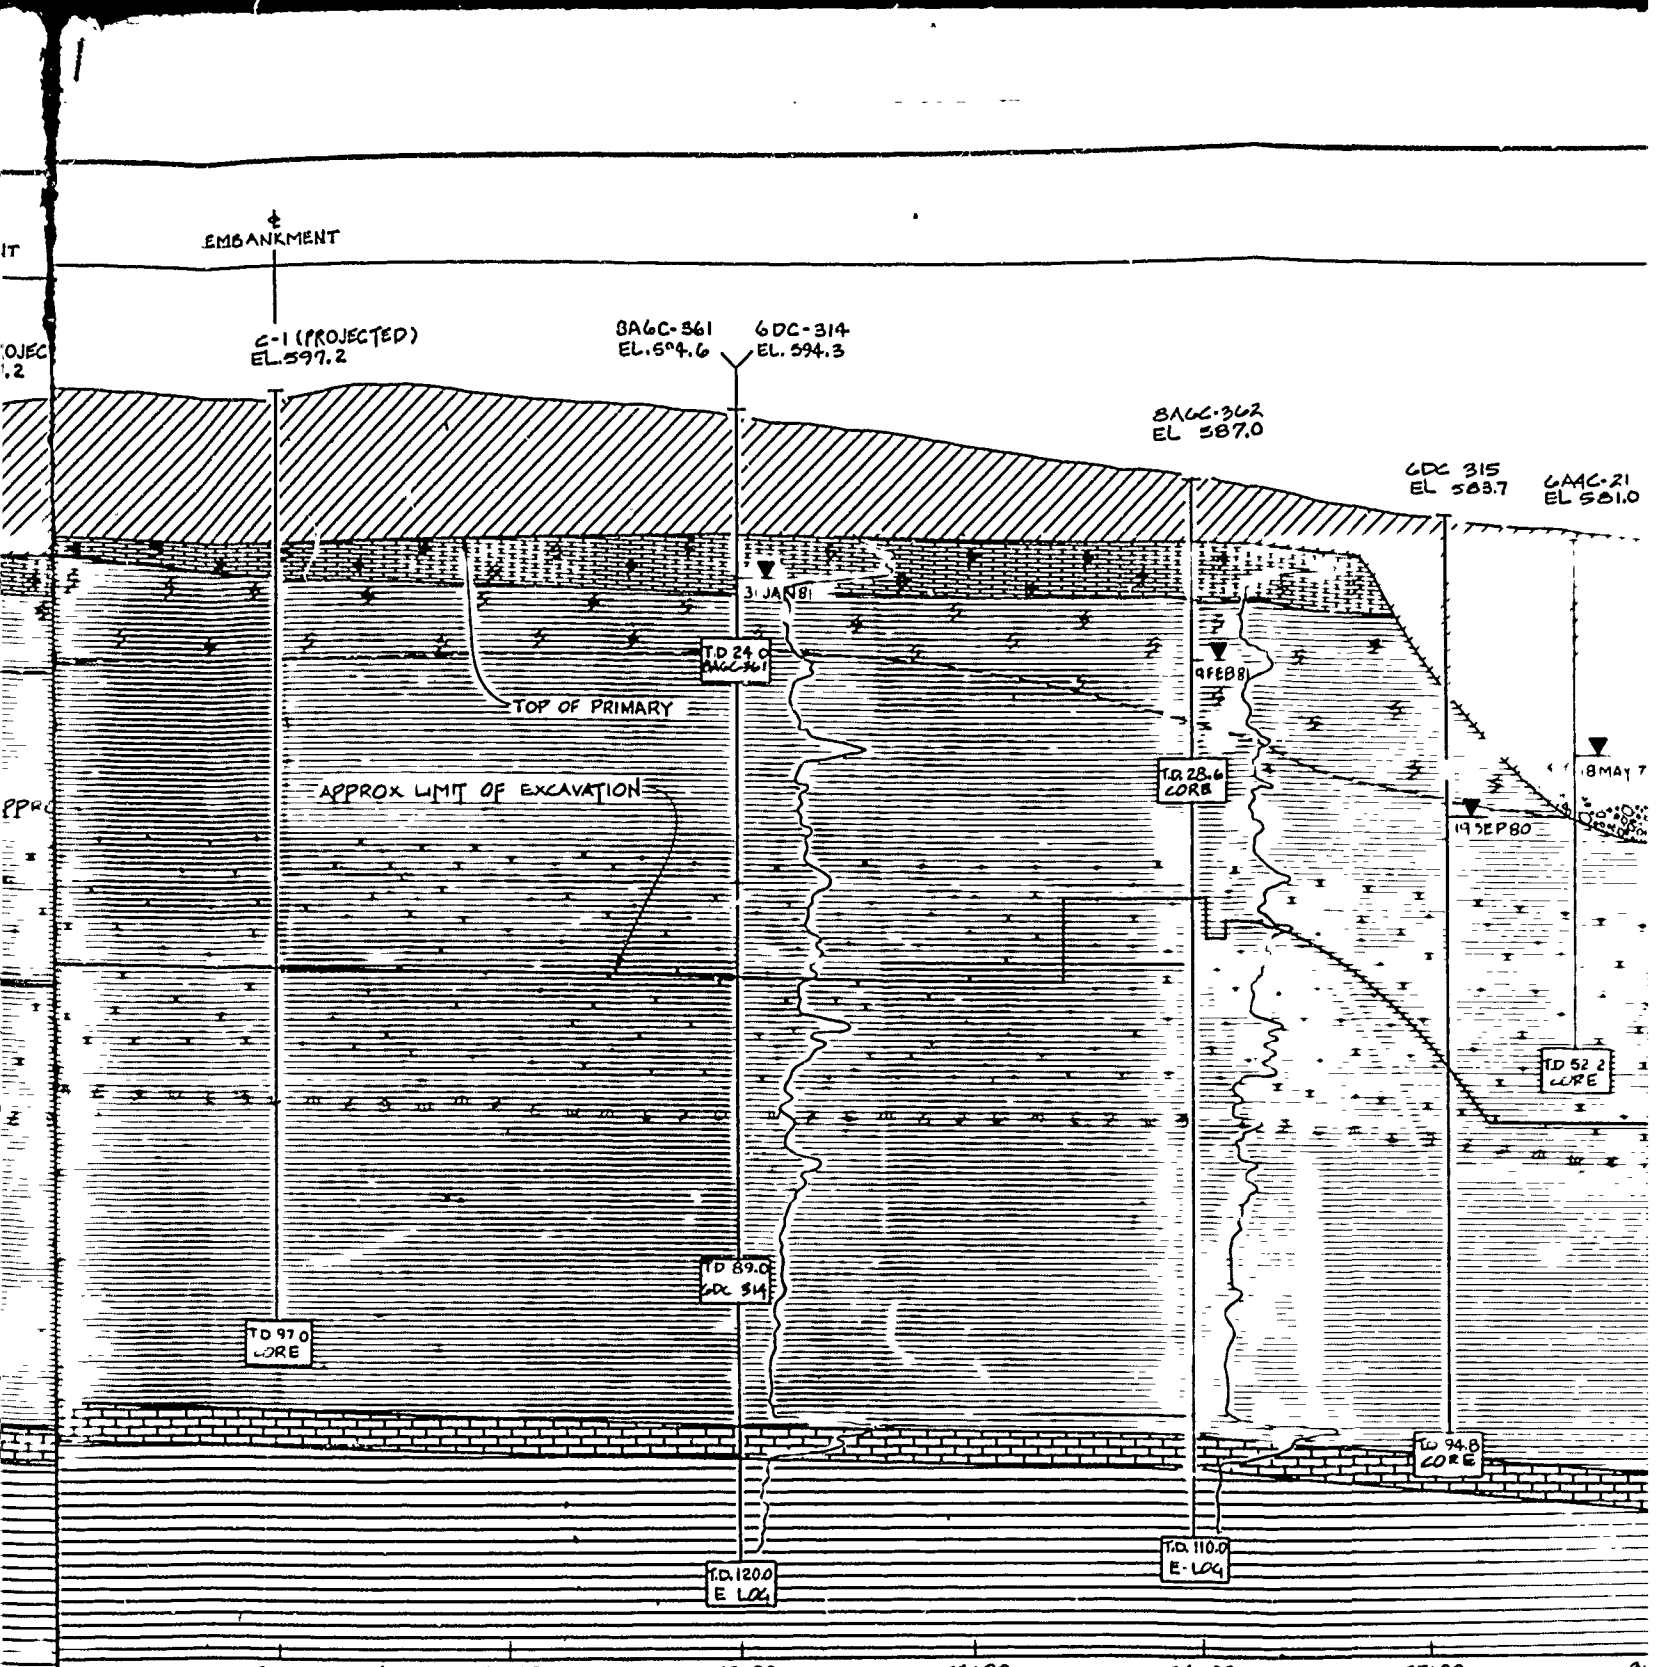


DISTANCES IN STATIONS ALONG OUTLET WORKS

00 30+00 31+00 32+00 33+00 34+00 35+00 36

FOR LEGEND AND GENERAL NOTES SEE SEQ 199.

RECORD DRAWING-WORK AS BUILT

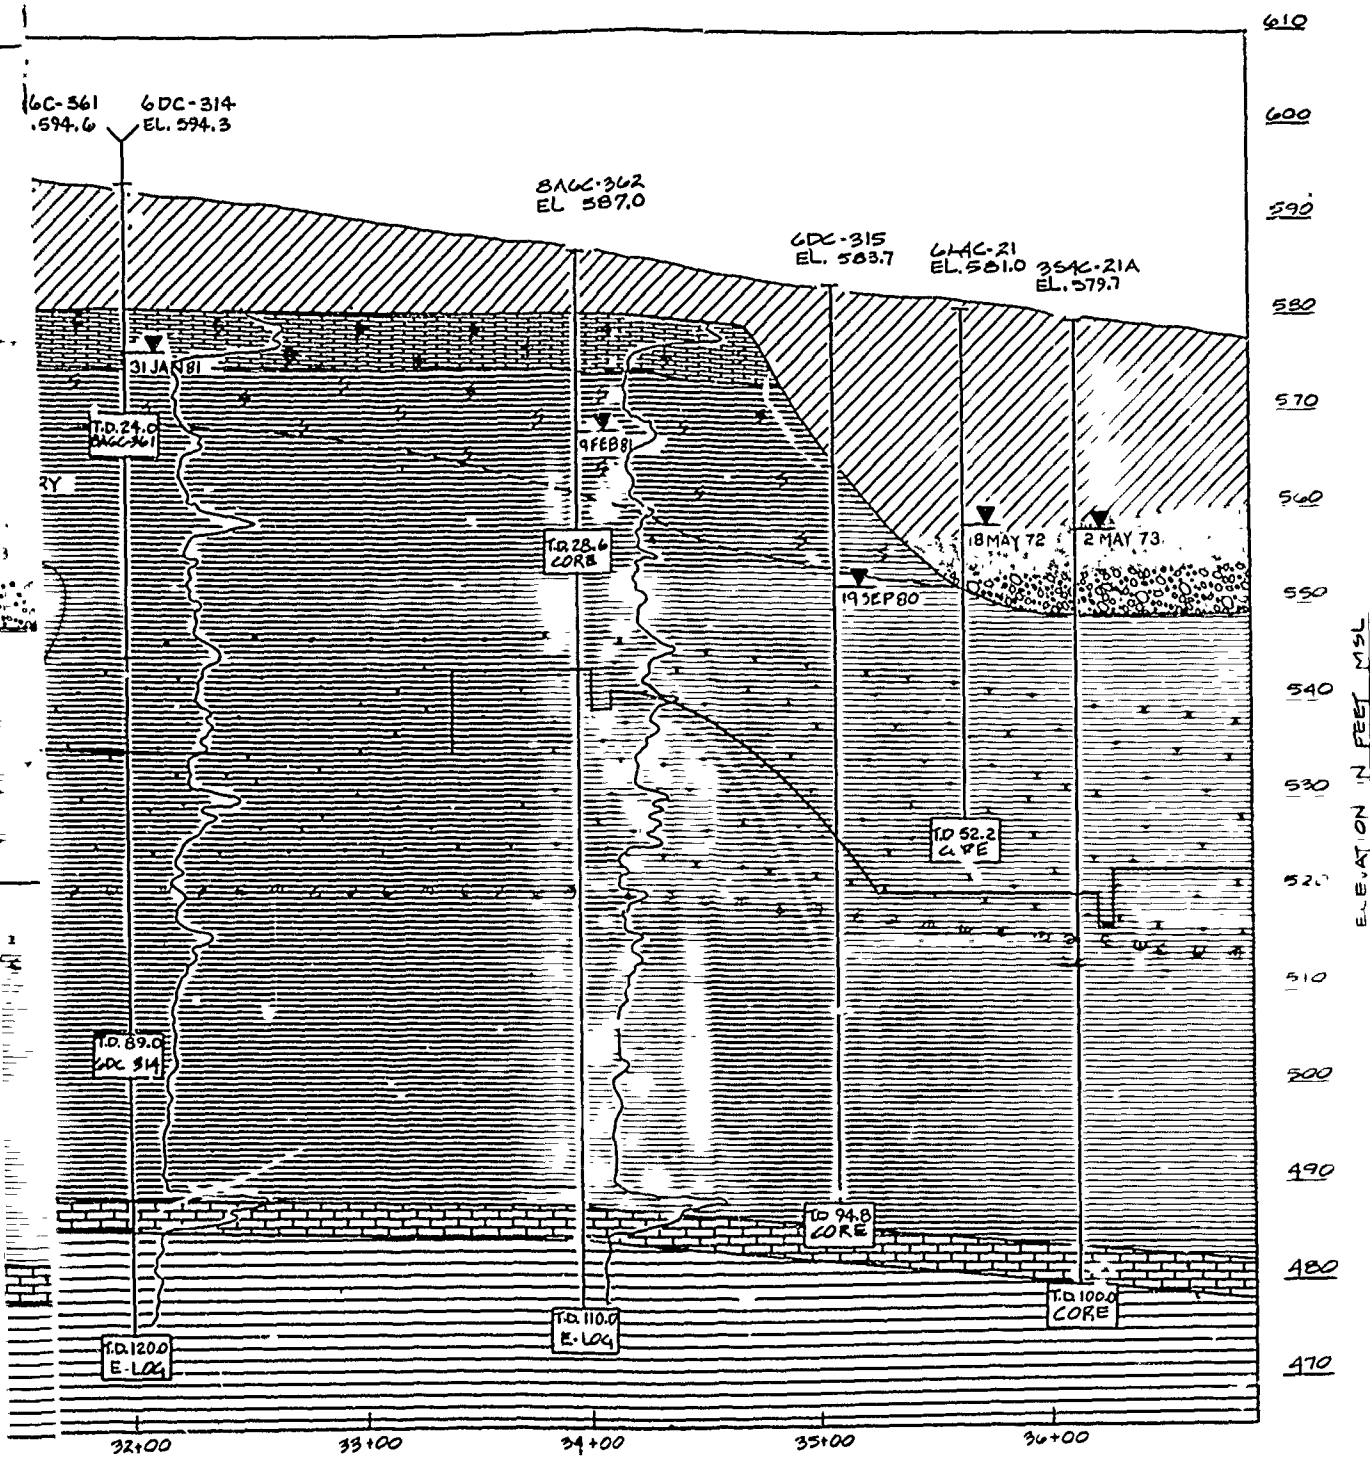



LET WORKS


FOR LEGEND AND GENERAL NOTES SEE SEC Q 199.

RECORD DRAWING-WORK AS BUILT

REVISION NO.	ACTION	DATE	DESCRIPTION OF REVISION
U.S. ARMY ENGINEER DISTRICT, FORT WORTH CORPS OF ENGINEERS FORT WORTH, TEXAS			
DESIGNED BY: R. HAGEN		RAY ROBERTS LAKE ELM FORK, TRINITY RIVER, TEXAS OUTLET WORKS GEOLOGIC PROFILE STATION 25+11 TO STATION 36+27	
DRAWN BY: M. BLAIN			
REVIEWED BY: R. HAGEN			
SUBMITTED BY: M. GREEN ENGINEER		INVITATION NO. DACHW8-82-8-0025 DATE: MAR 82	SHEET NO. OF 47
CONTRACT NO. DACH 63-82-C-0083		DRAWING NUMBER	SHEET NO. OF 47

TO ACCOMPANY FOUNDATION REPORT

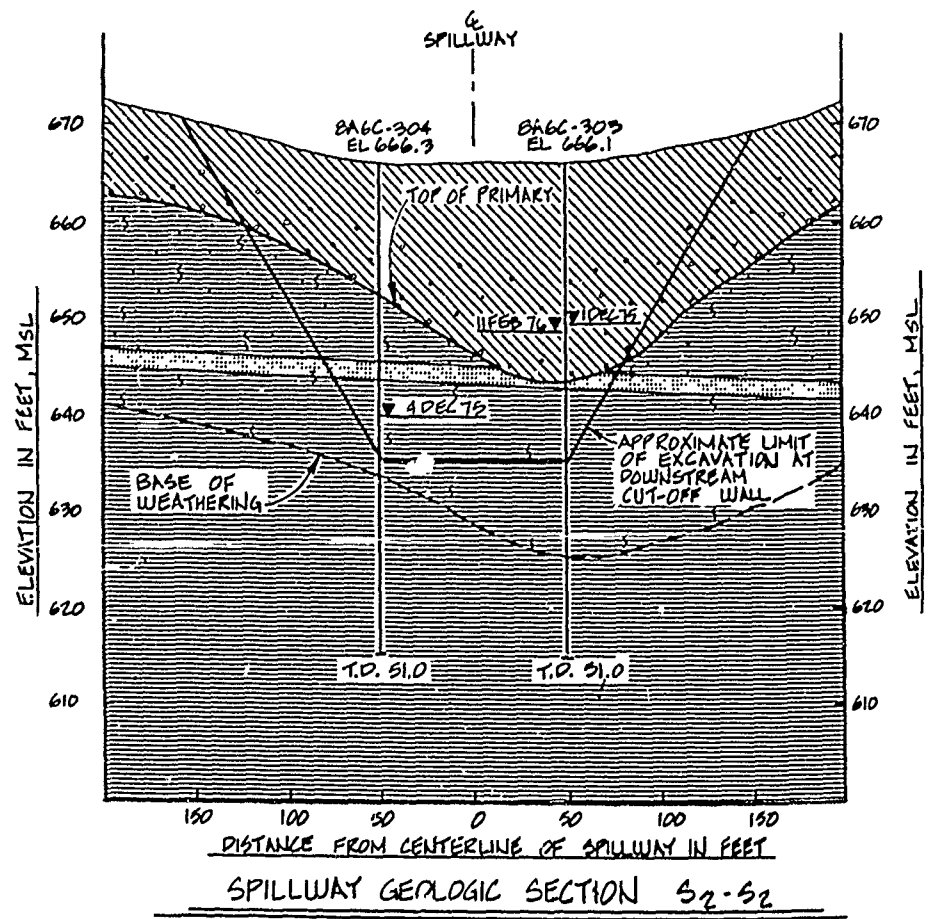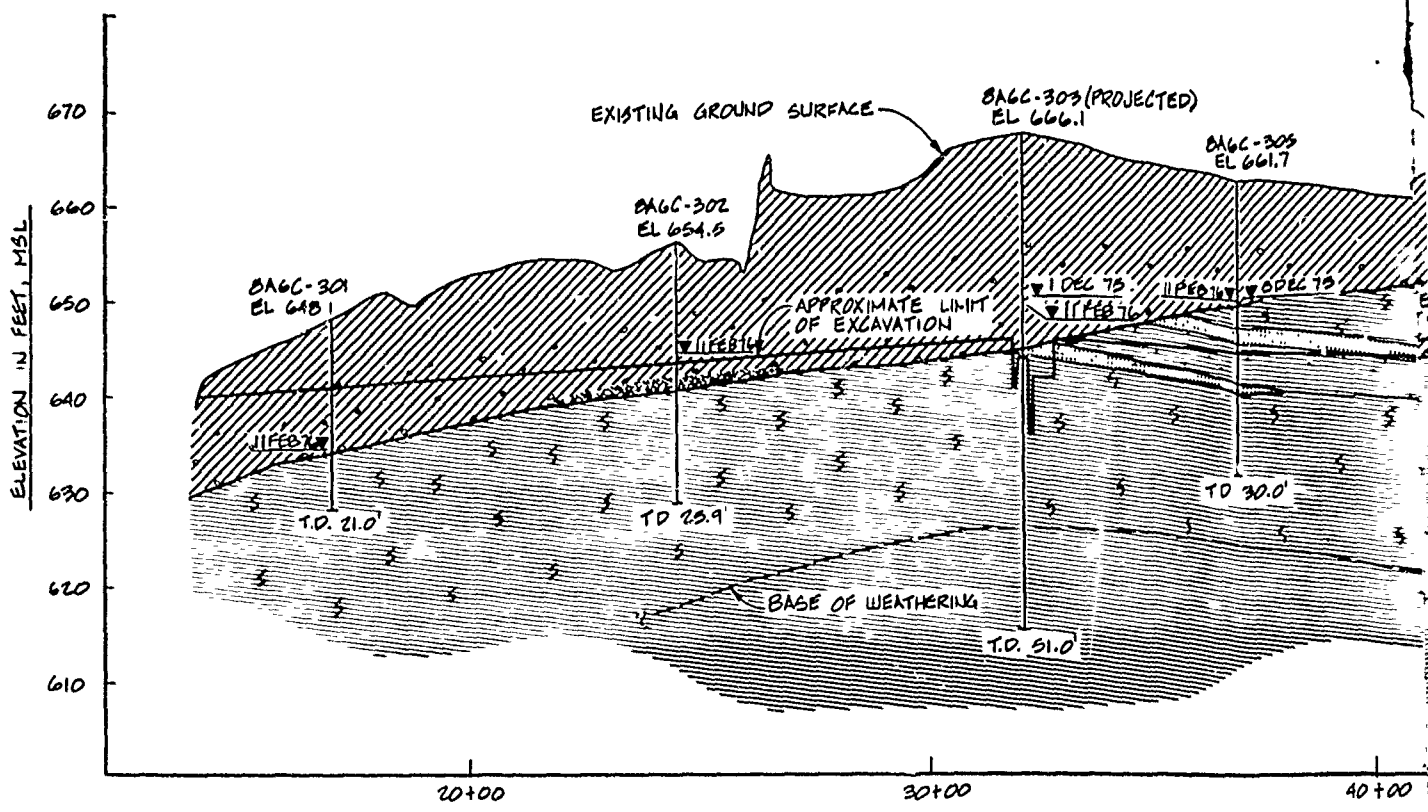

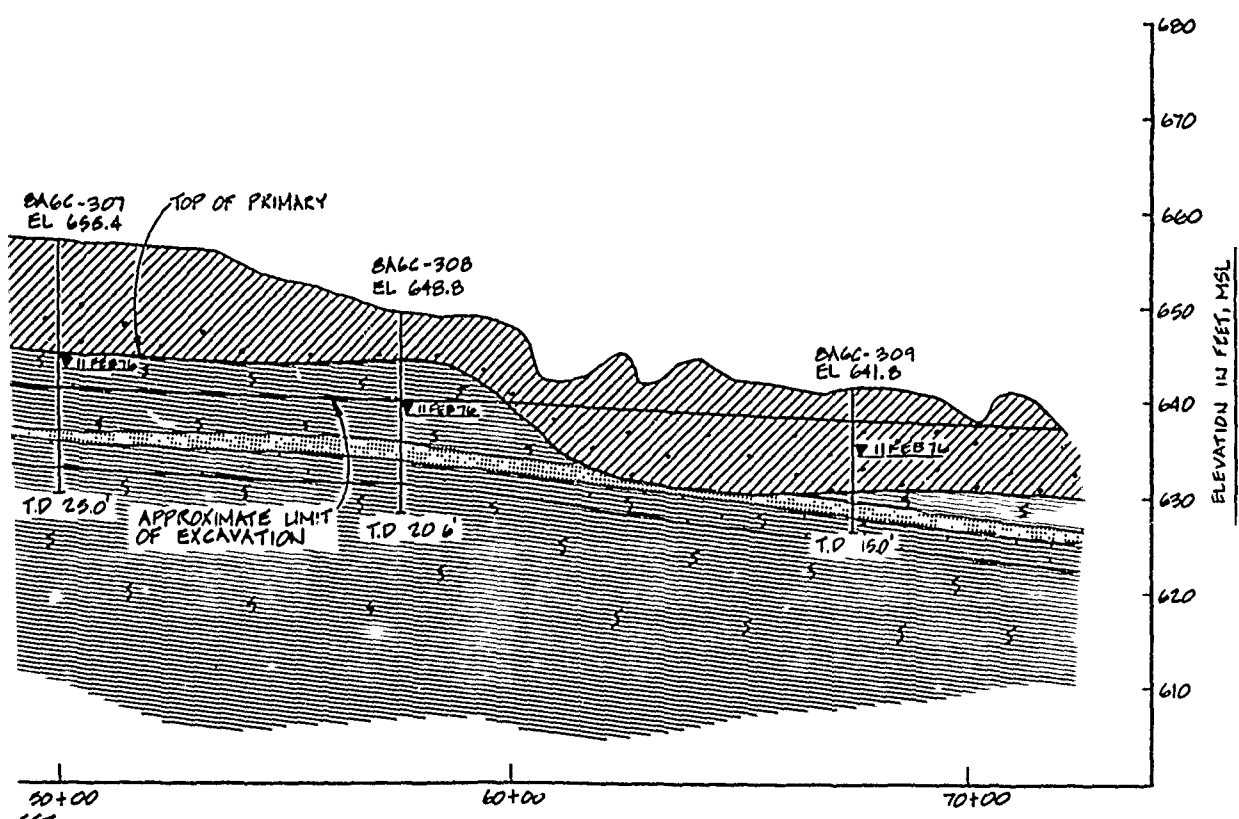


PROFILE S1-S1

- NOTES:
1. FOR LEGEND AND GENERAL NOTES SEE SEQ. 199.
 2. FOR LOCATION OF PROFILE AND SECTION SEE SEQ. 180.











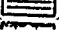
RECORD DRAWING-WORK AS BUILT

REV. NO.	NO.	ACTION	DATE	DESCRIPTION OF REVISION
U.S. ARMY ENGINEER DISTRICT, FORT WORTH CORPS OF ENGINEERS FORT WORTH, TEXAS				
DESIGNED BY:	RAY ROBERTS LAKE			
DRAWN BY:	ELM FORK, TRINITY RIVER, TEXAS			
REVISOR BY:	SPILLWAY, APPROACH CHANNEL AND DISCHARGE CHANNEL			
SUBMITTED BY:	GEOLOGIC PROFILE S1-S1 AND SECTION S2-S2			
ENGINEER:	INVIATION NO. DACHW 63-02-C-0025	DATE: MAR. 1962	SEQUENCE NO. 48	
	CONTRACT NO. DACHW 63-02-C-0023		SHEET NO. OF	48

TO-ACCOMPANY-FOUNDATION-REPORT

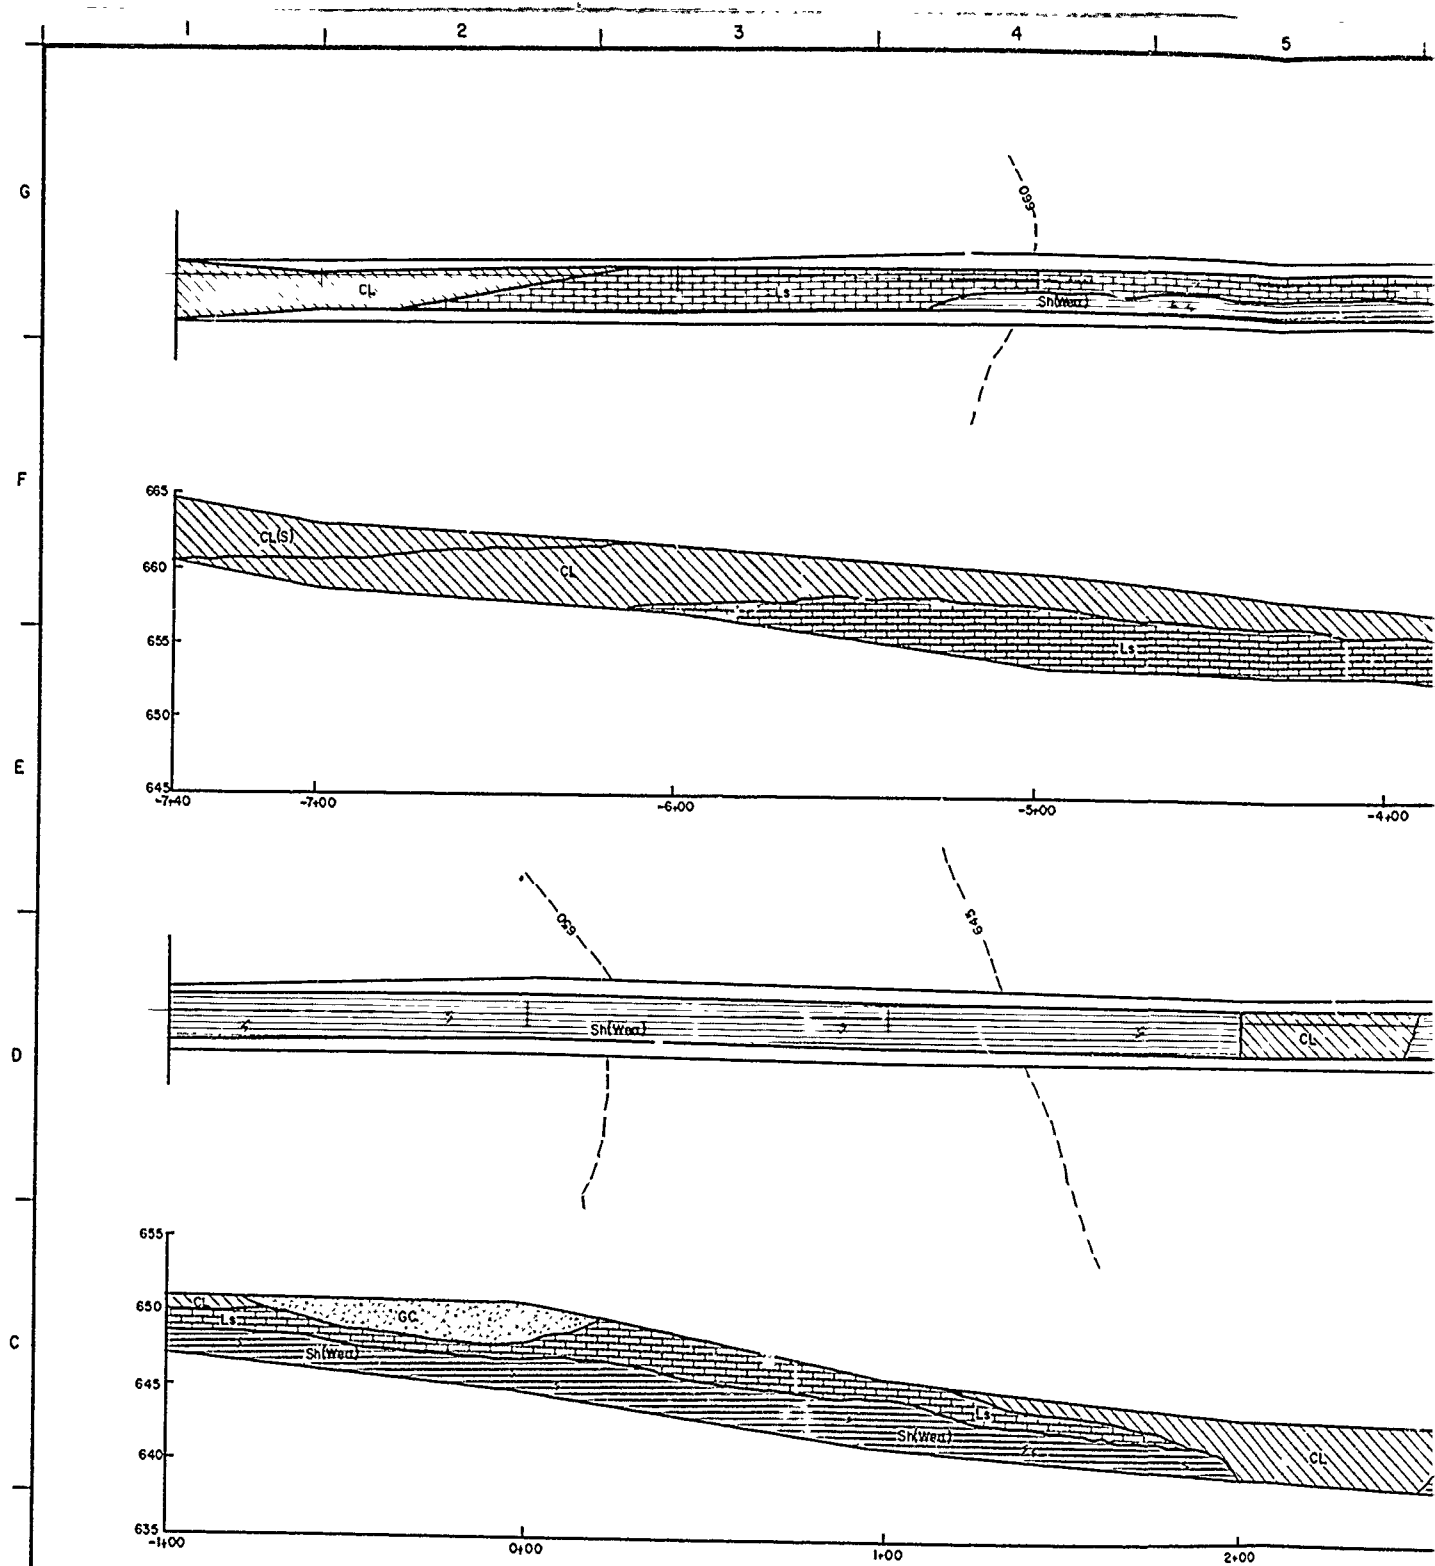



LEGEND

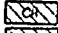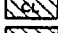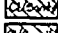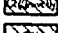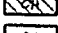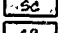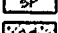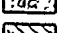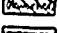-  CLAY, MEDIUM TO HIGH PLASTICITY, DARK BROWN
-  CLAY, LEAN
-  CLAY, LEAN, SANDY
-  CLAY, GRAVELLY
-  CLAY, HIGH PLASTICITY, ORGANIC, BLACK
-  SAND, CLAYEY, FINE
-  SAND, FINE, POORLY GRADED
-  GRAVEL, VARIABLY CLAYEY
-  CLAY, STIFF, HAS APPEARANCE OF WEATHERED SHALE INCLUDING SHALE-LIKE STRUCTURE.
-  SHALE, WEATHERED
-  SHALE, UNWEATHERED

NOTES

- 1. SECTION
- 2. NO INSI
- 3. PLAN V GEOLOG


G
F
E
D
C
B
A

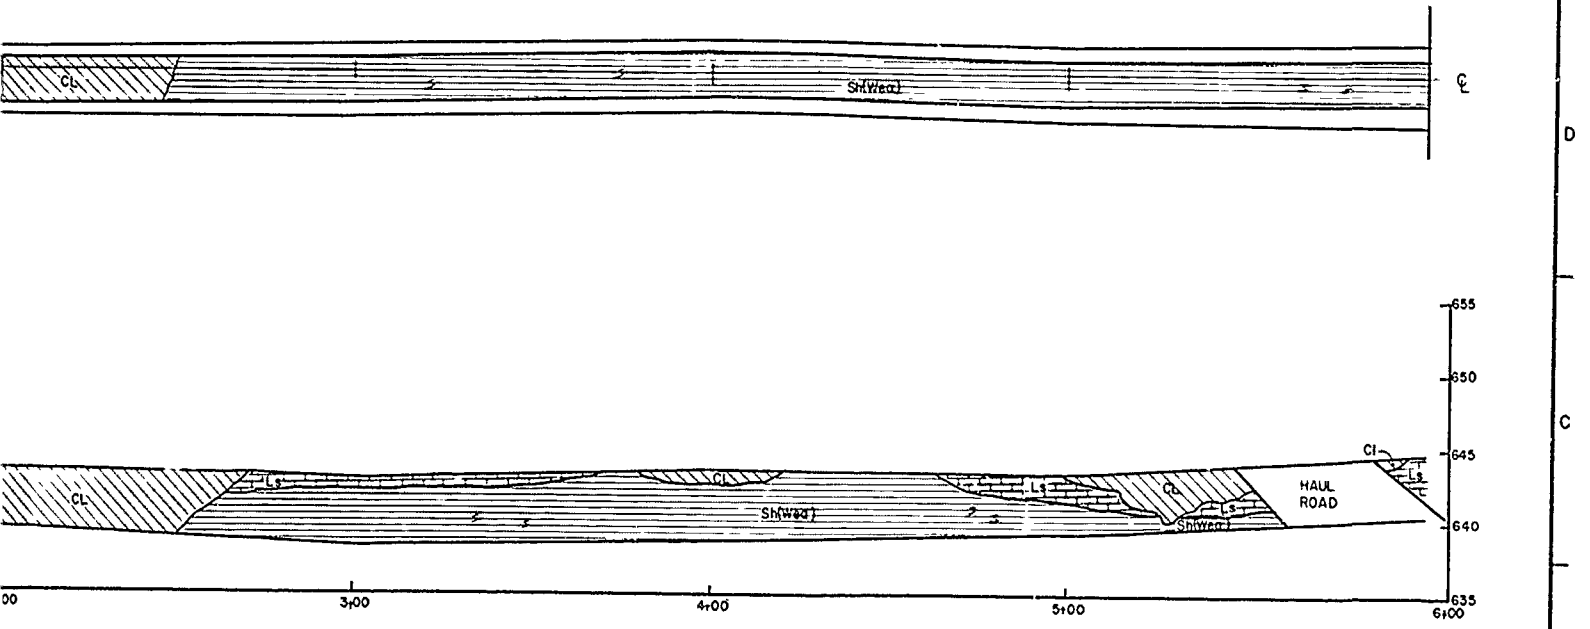
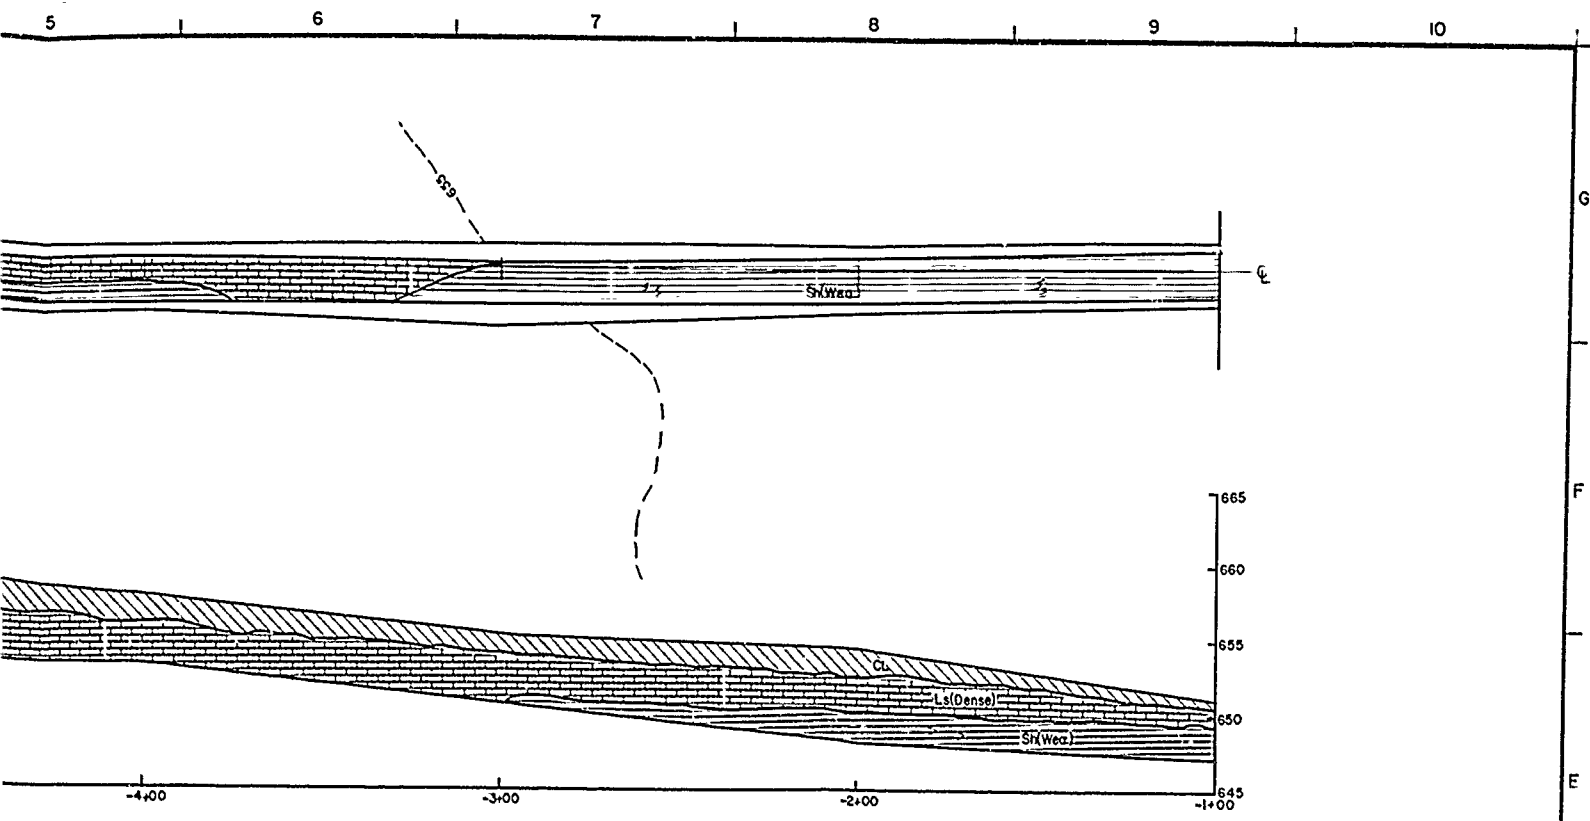


NOTES


1. SECTIONS REPRESENT UPSTREAM(LEFT) FACE OF INSPECTION TRENCH
2. NO INSPECTION TRENCH WAS EXCAVATED BETWEEN STATIONS 117+50 AND 125+50.
3. PLAN VIEW OF INSPECTION TRENCH PRESENTS GEOLOGY OF THE FLOOR ONLY. GEOLOGY OF SIDE SLOPES IS PRESENTED IN THE SECTION.


DESIGNED BY: H. BARNETT		RAY ROBERTS LAKE ELM W'ORK, TRINITY RIVER, TEXAS	
DRAWN BY: C. KIRBY		FOUNDATION REPORT INSPECTION TRENCH AS-BUILT PLAN AND PROFILE STA. -7+40 TO 6+00	
REVIEWED BY: R. BEHM			
SUBMITTED BY: ROBERT C. BEHM		SOL. NO.	DATED:
ENGINEER:		CONTR. NO.	SEQUENCE NO.
		DRAWING NUMBER	SHEET NO.

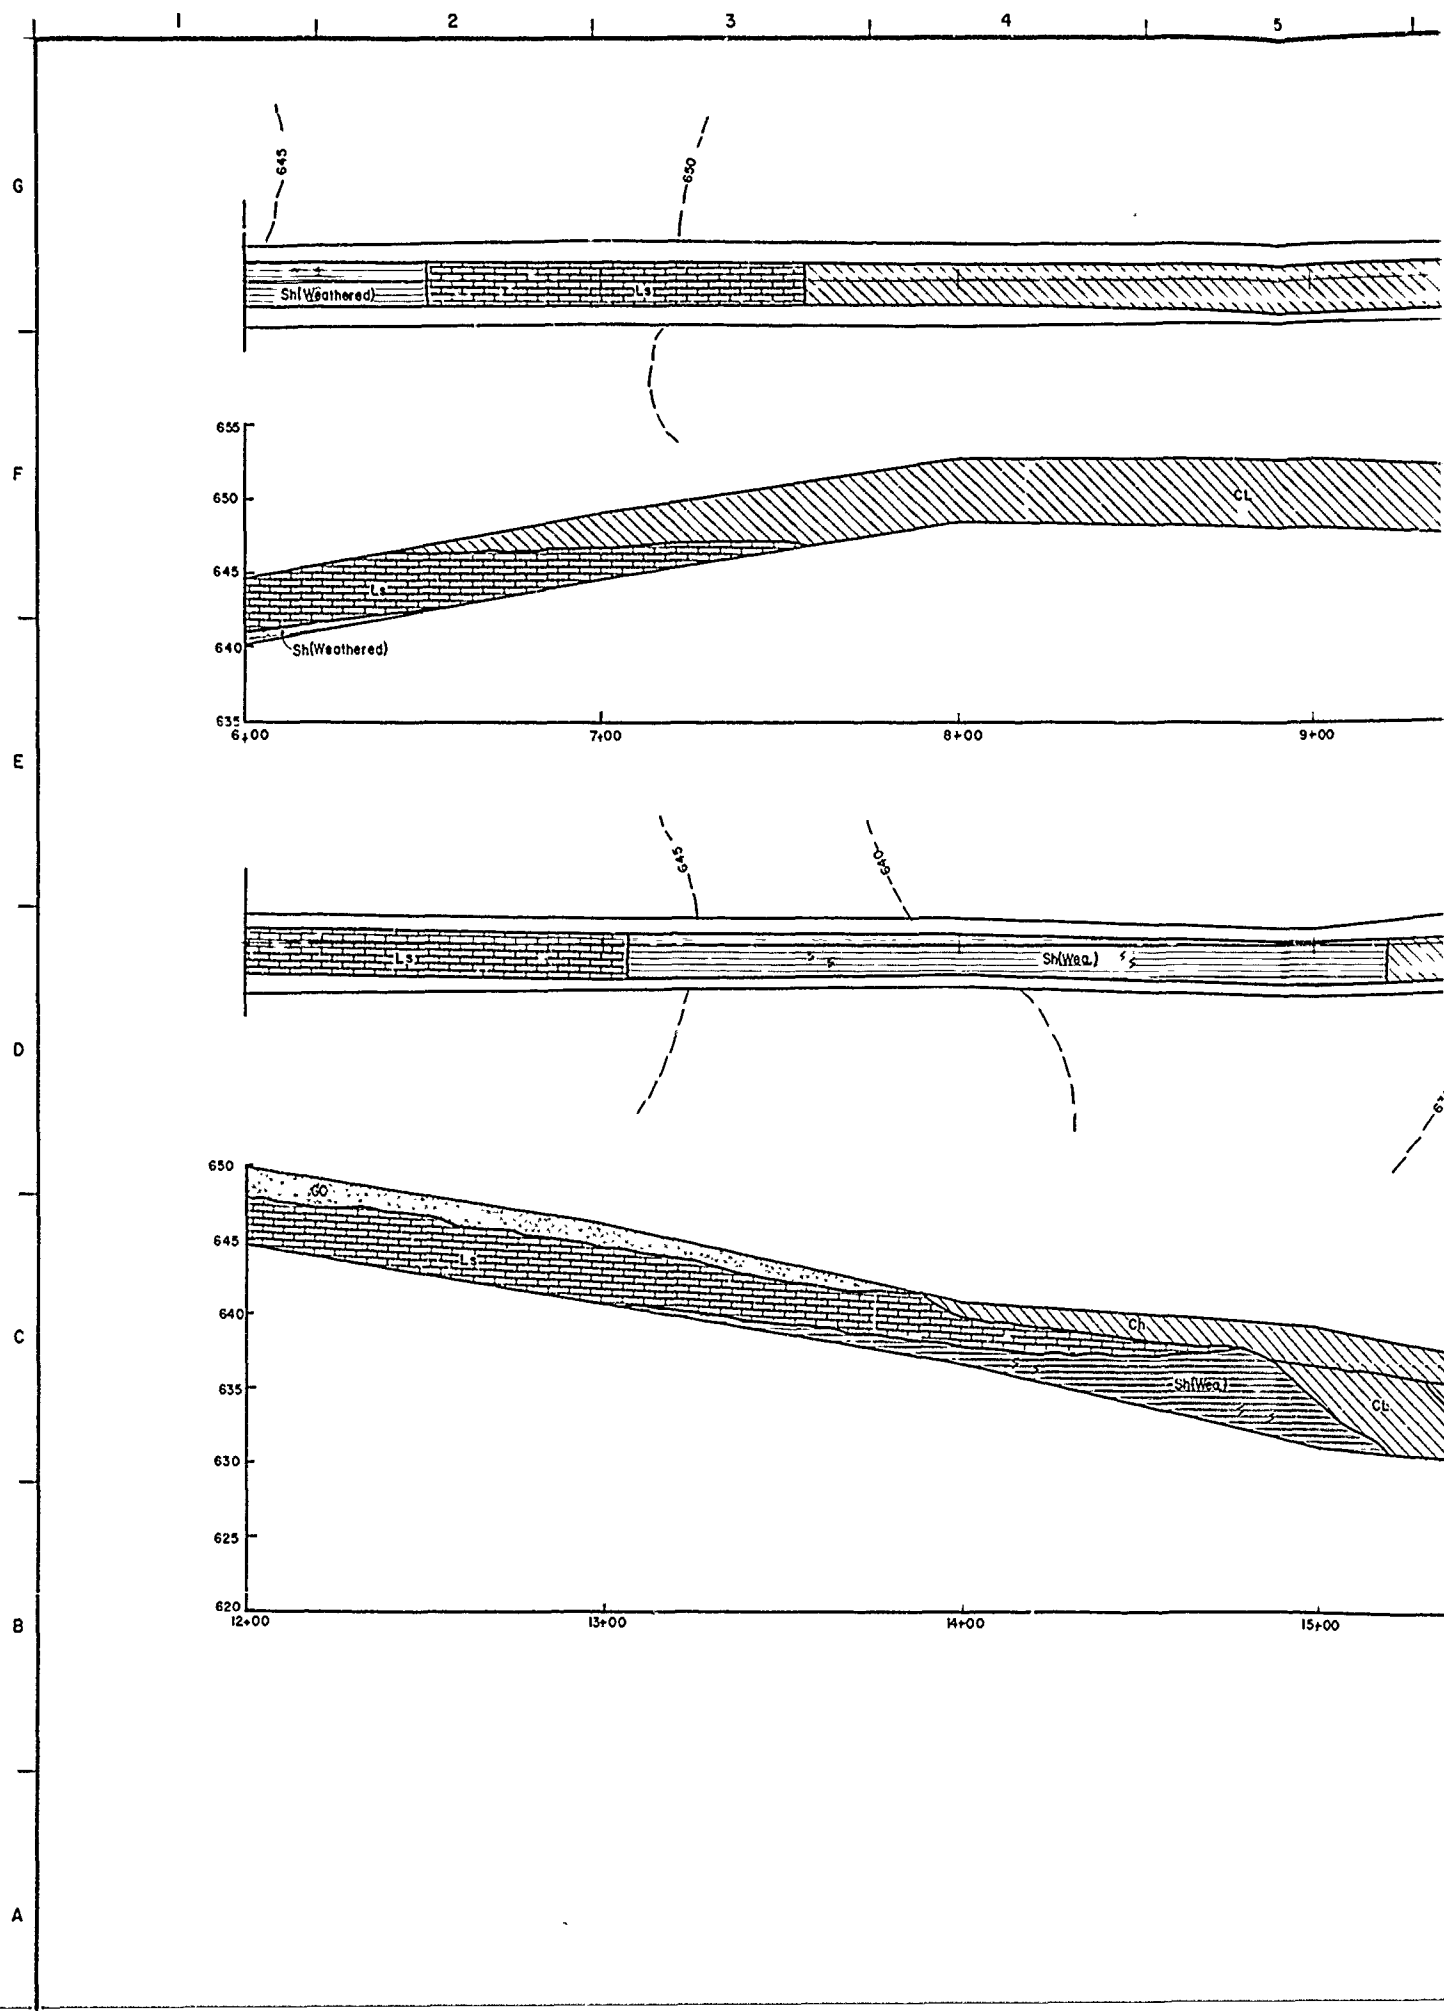

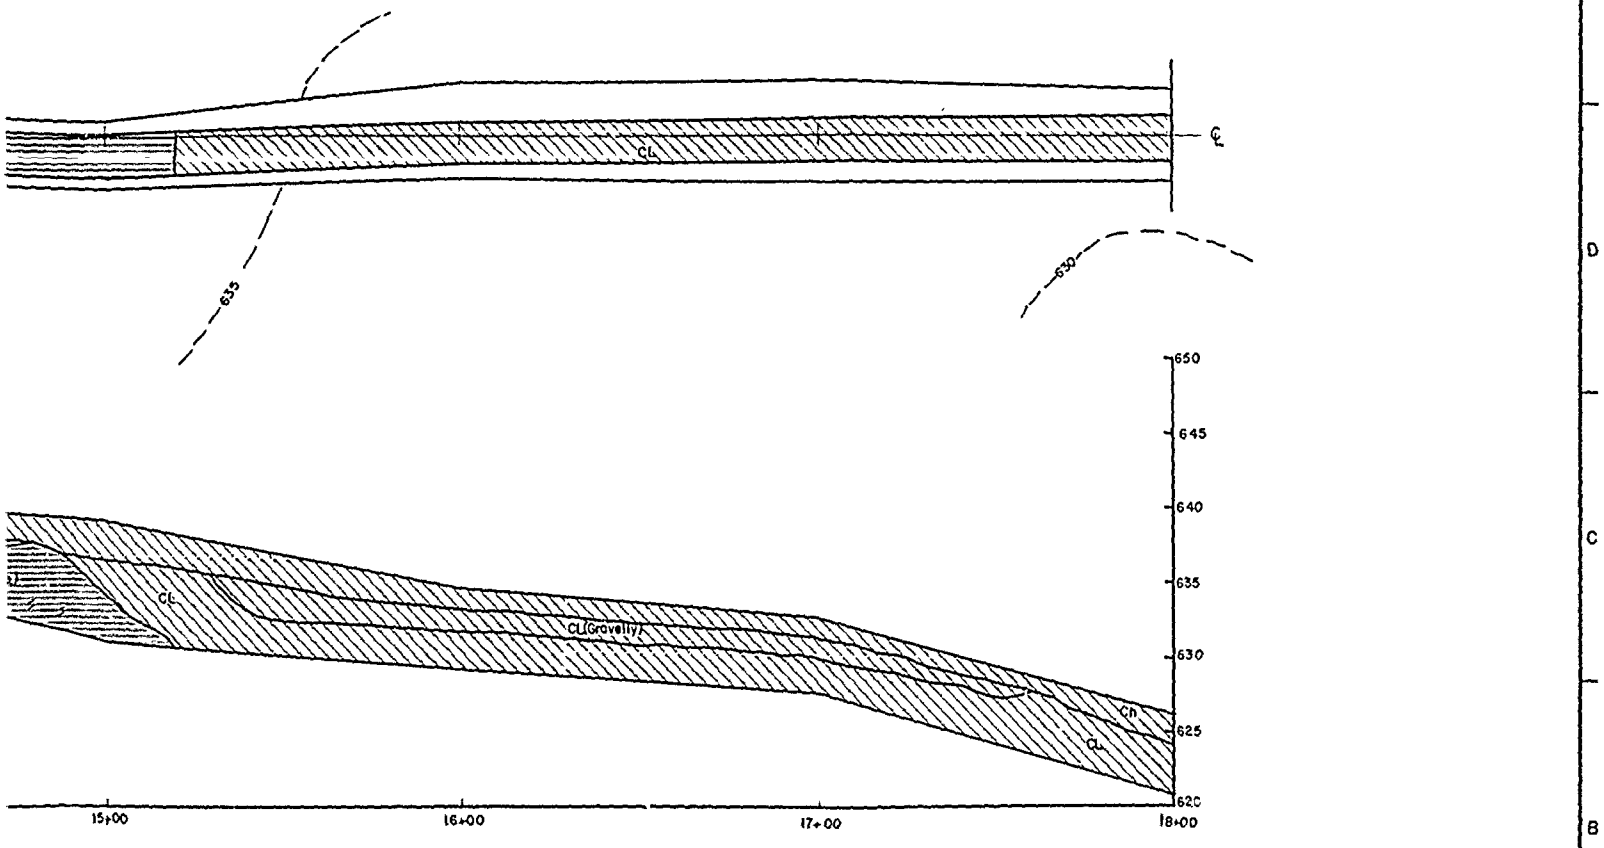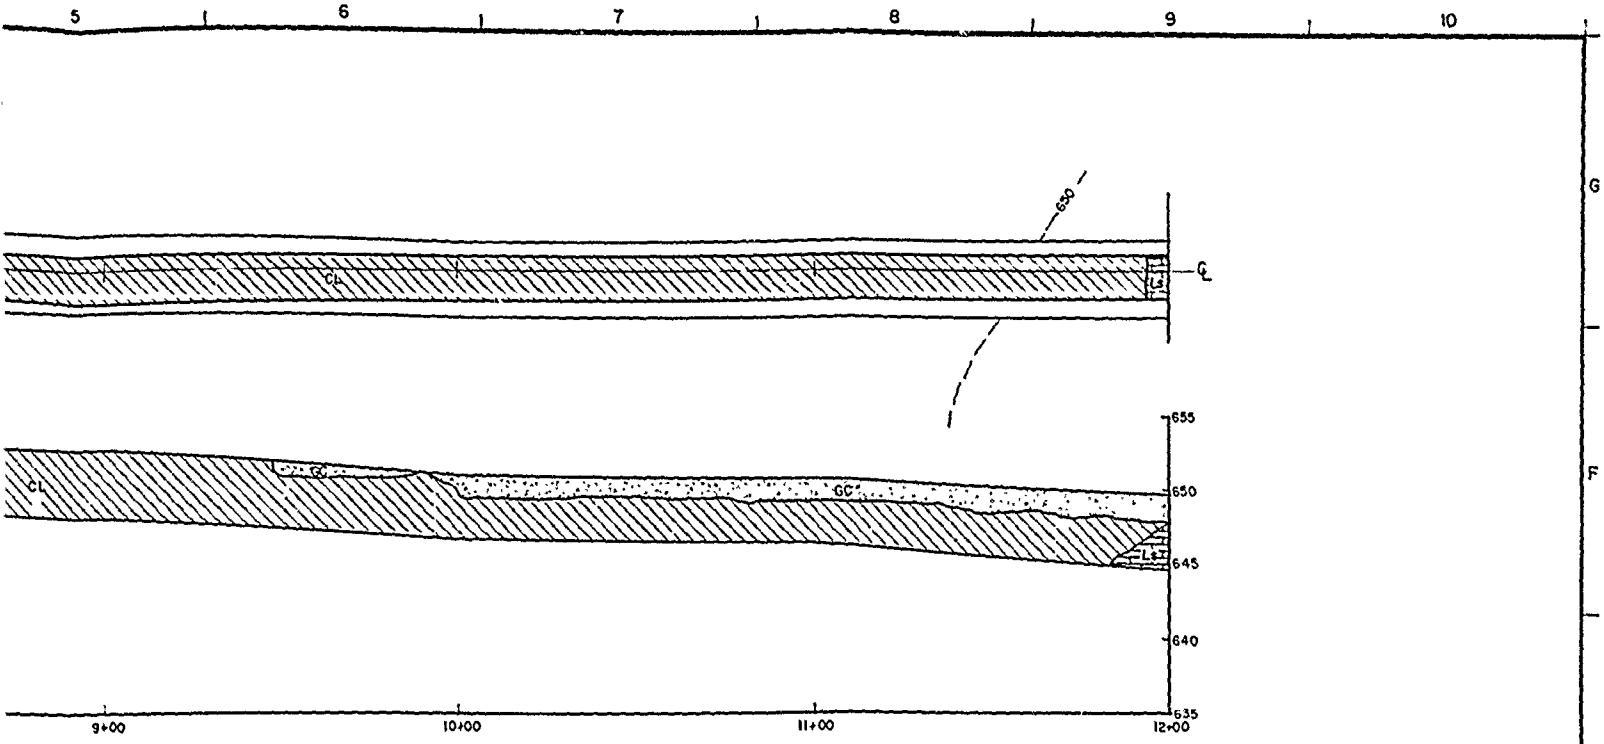



DESIGNED BY: H. BARNETT		DRAWN BY: C. KIRBY		REVIEWED BY: R. BEHM		SUBMITTED BY: ROBERT C. BEHM		ENGINEER:		SOL. NO.		DATED:		SEQUENCE NO. 50	
U.S. ARMY ENGINEER DISTRICT, FORT WORTH CORPS OF ENGINEERS FORT WORTH, TEX 8 RAY ROBERTS LAKE ELM FORK, TRINITY RIVER, TEXAS FOUNDATION REPORT INSPECTION TRENCH AS-BUILT PLAN AND PROFILE STA. 6+00 TO 18+00															

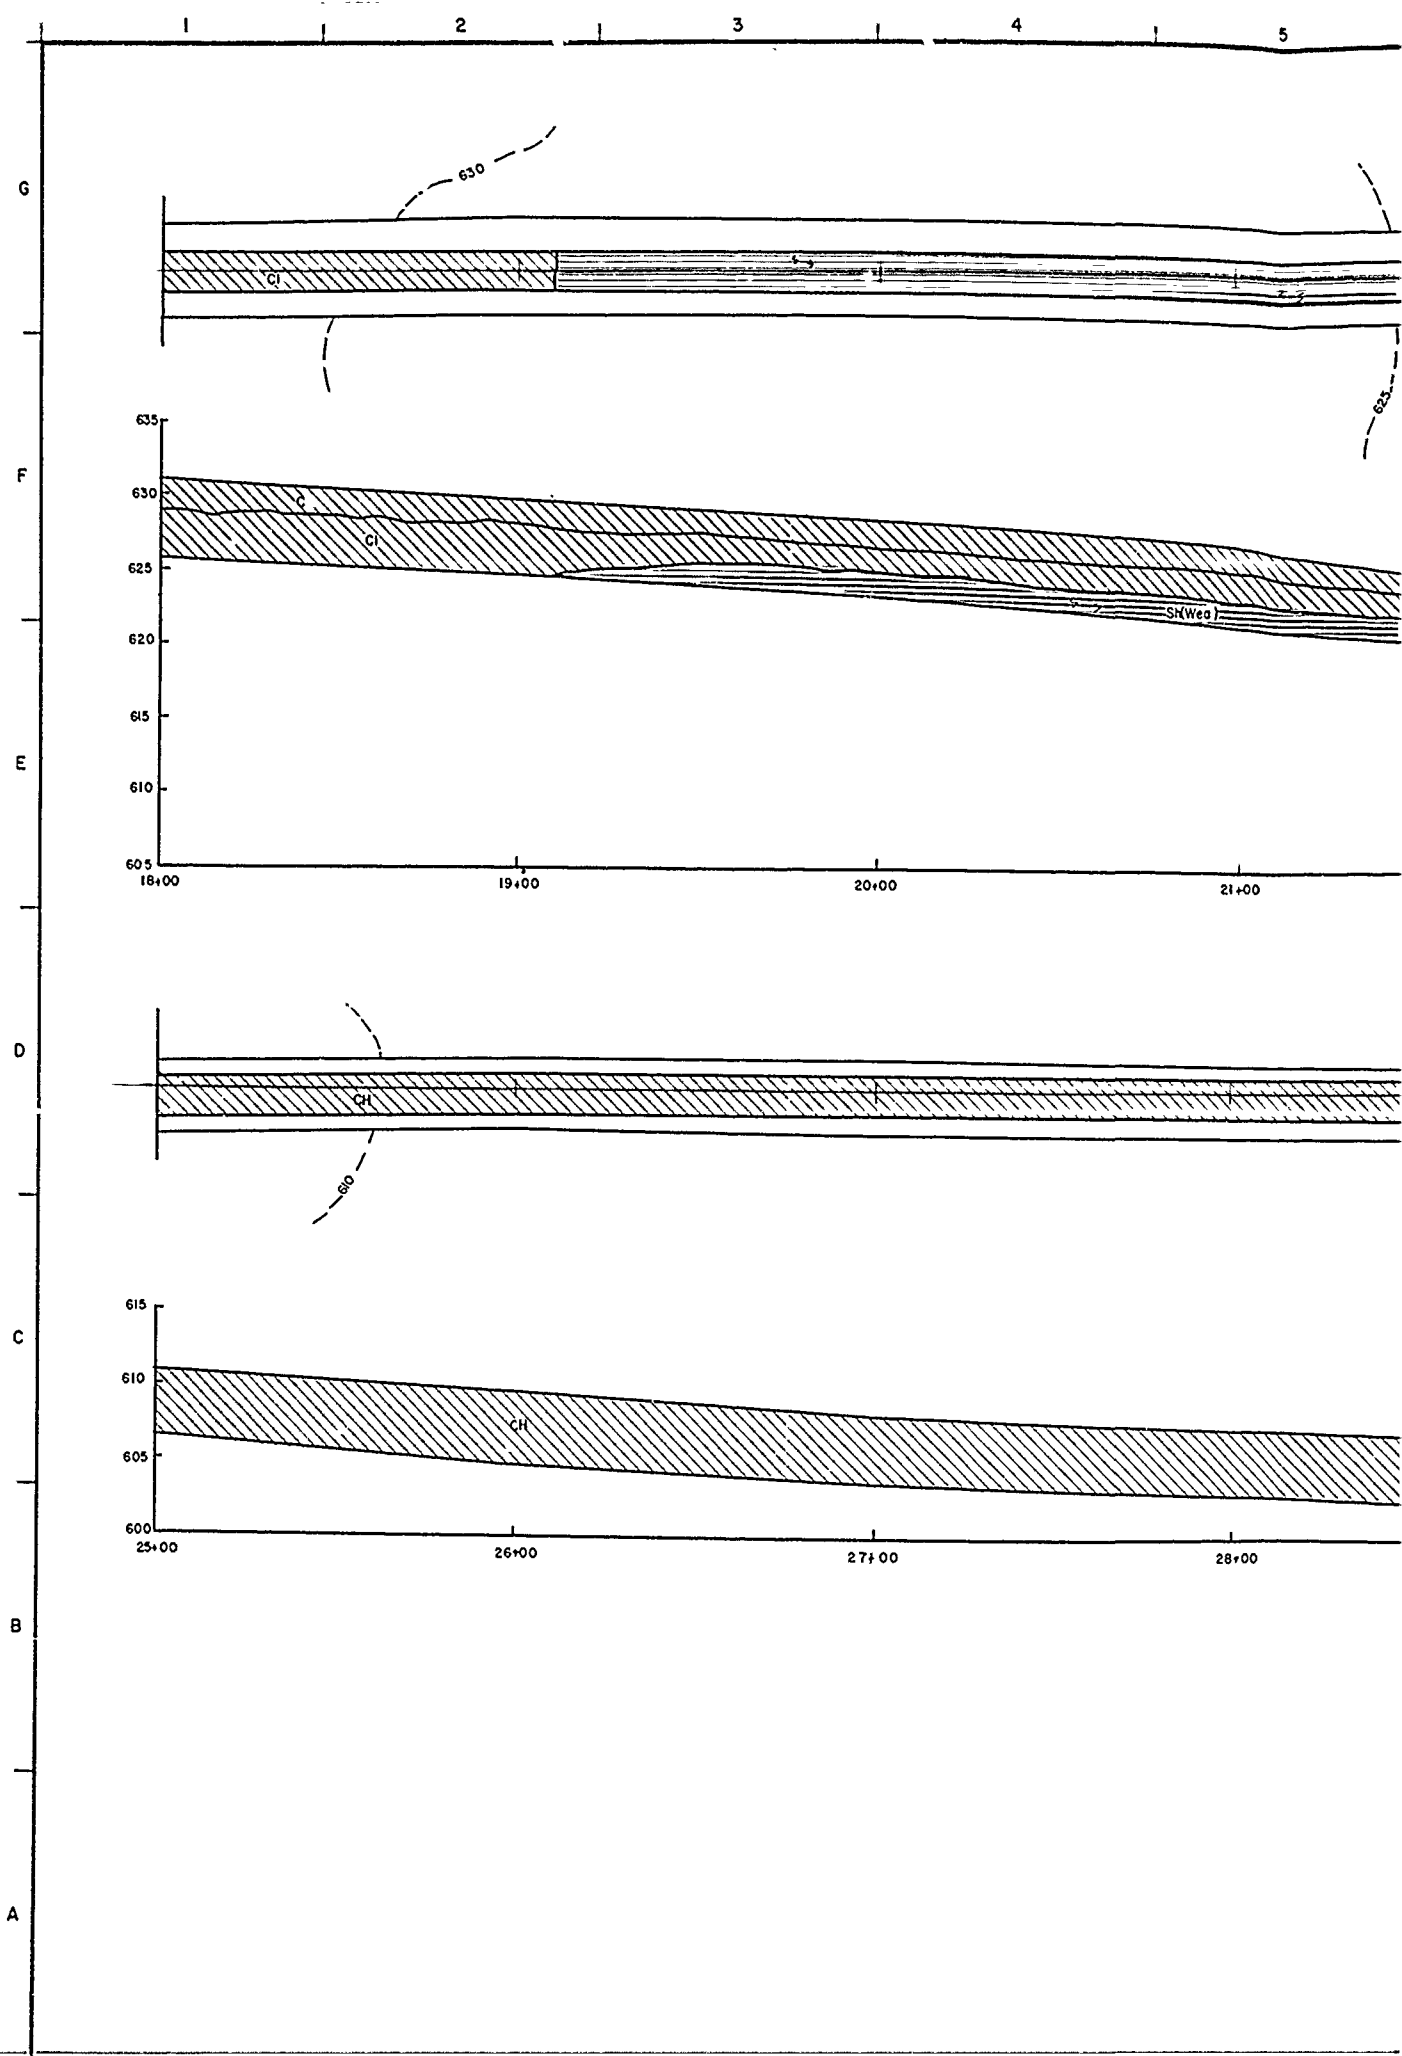

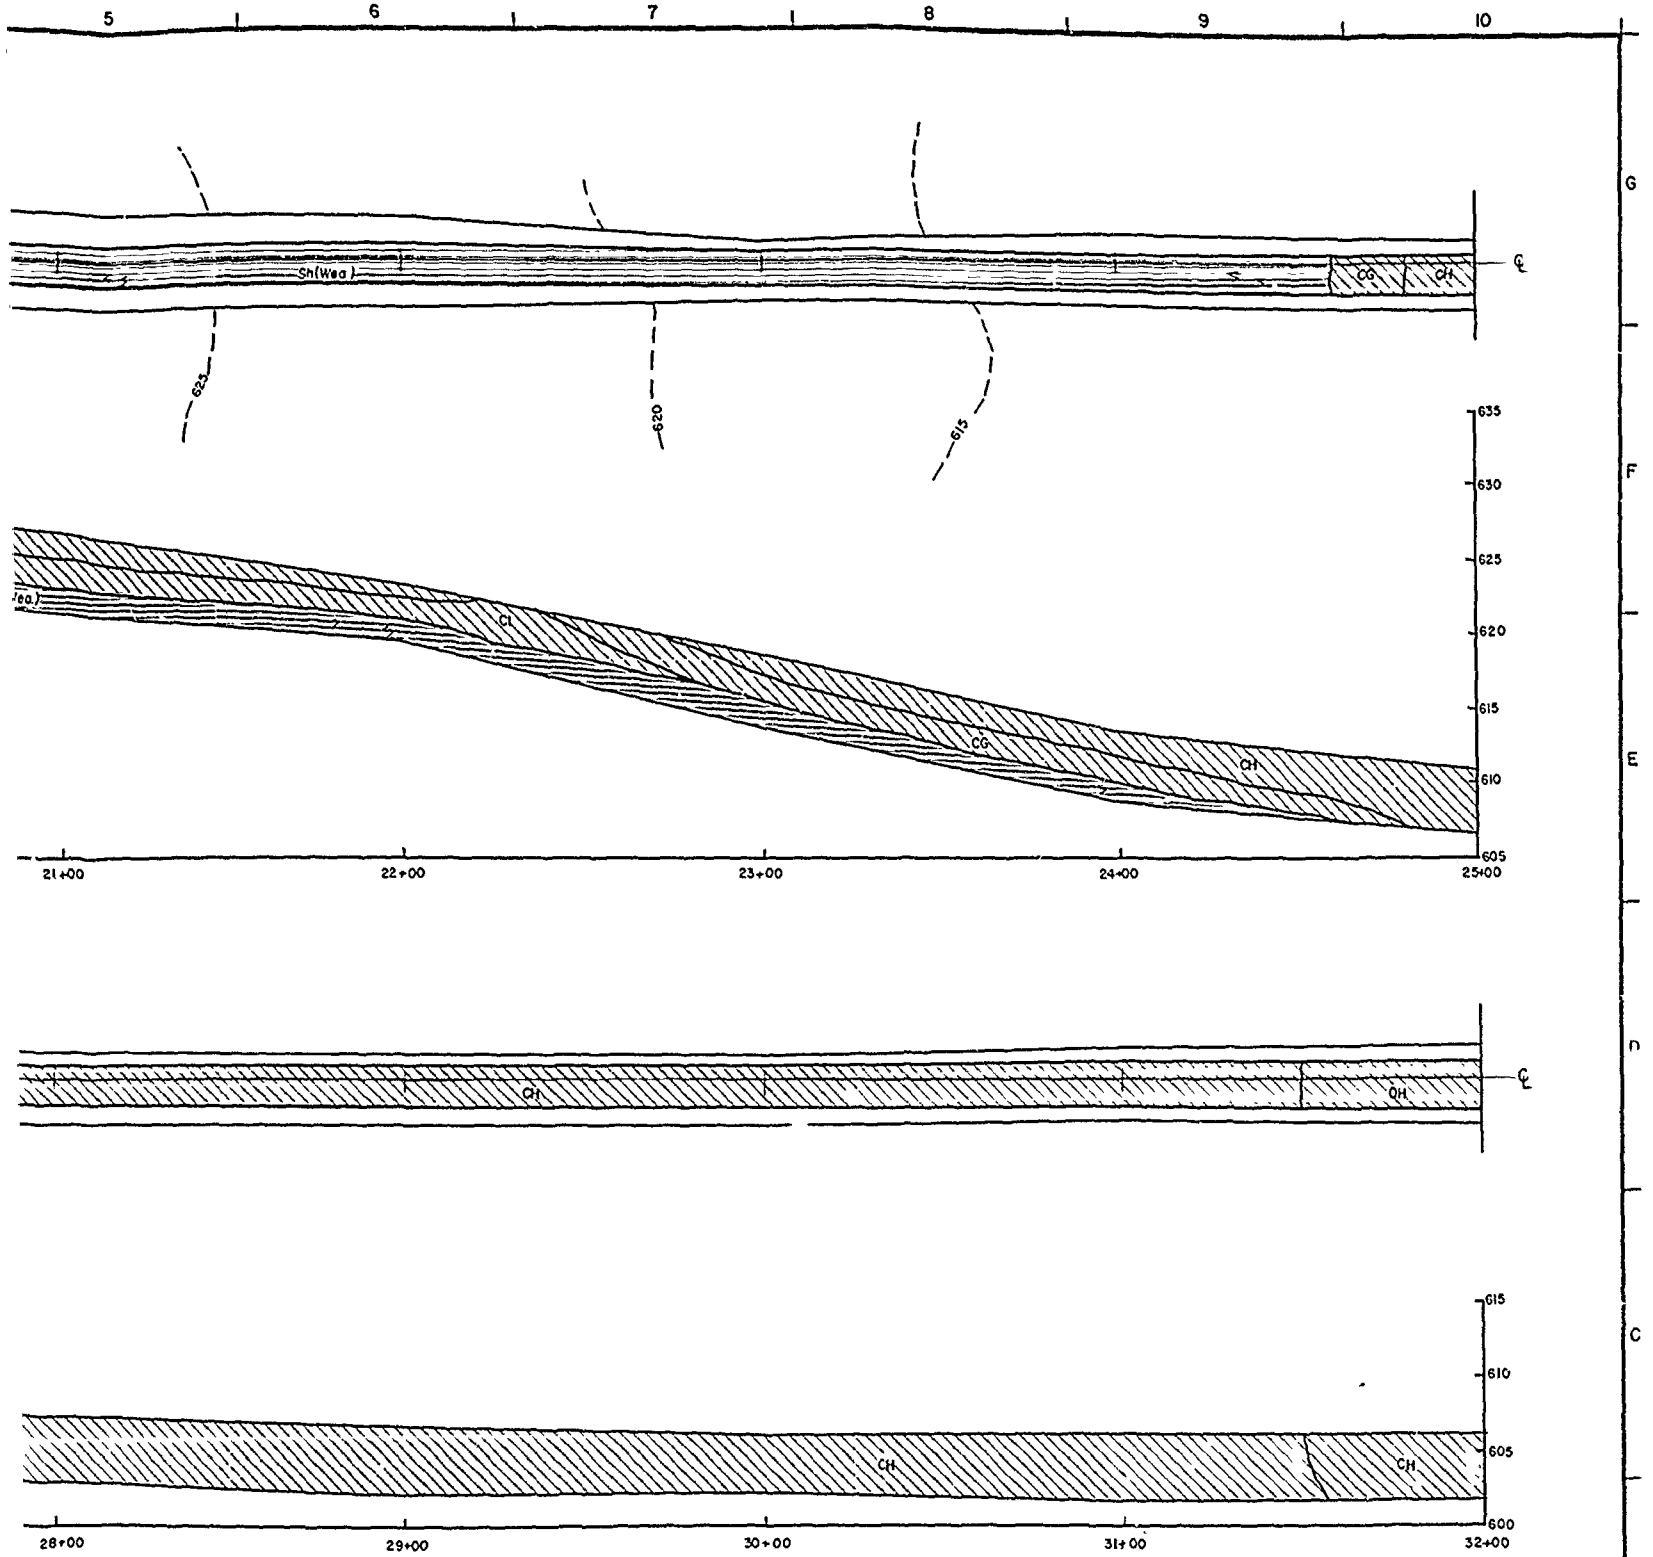



DESIGNED BY: H. BARNETT	RAY ROBERTS LAKE ELM FORK, TRINITY RIVER, TEXAS FOUNDATION REPORT INSPECTION TRENCH AS-BUILT PLAN AND PROFILE STA. 18+00 TO 32+00
DRAWN BY: C. KIRBY	
REVIEWED BY: R. BEHM	
SUBMITTED BY: ROBERT C. BEHM	
U.S. ARMY ENGINEER DISTRICT, FORT WORTH CORPS OF ENGINEERS FORT WORTH, TEXAS	SOIL NO. _____ DATED: _____ CONTR. NO. _____ DRAWING NUMBER _____ SHEET NO. _____ OF _____ SEQUENCE NO. 51

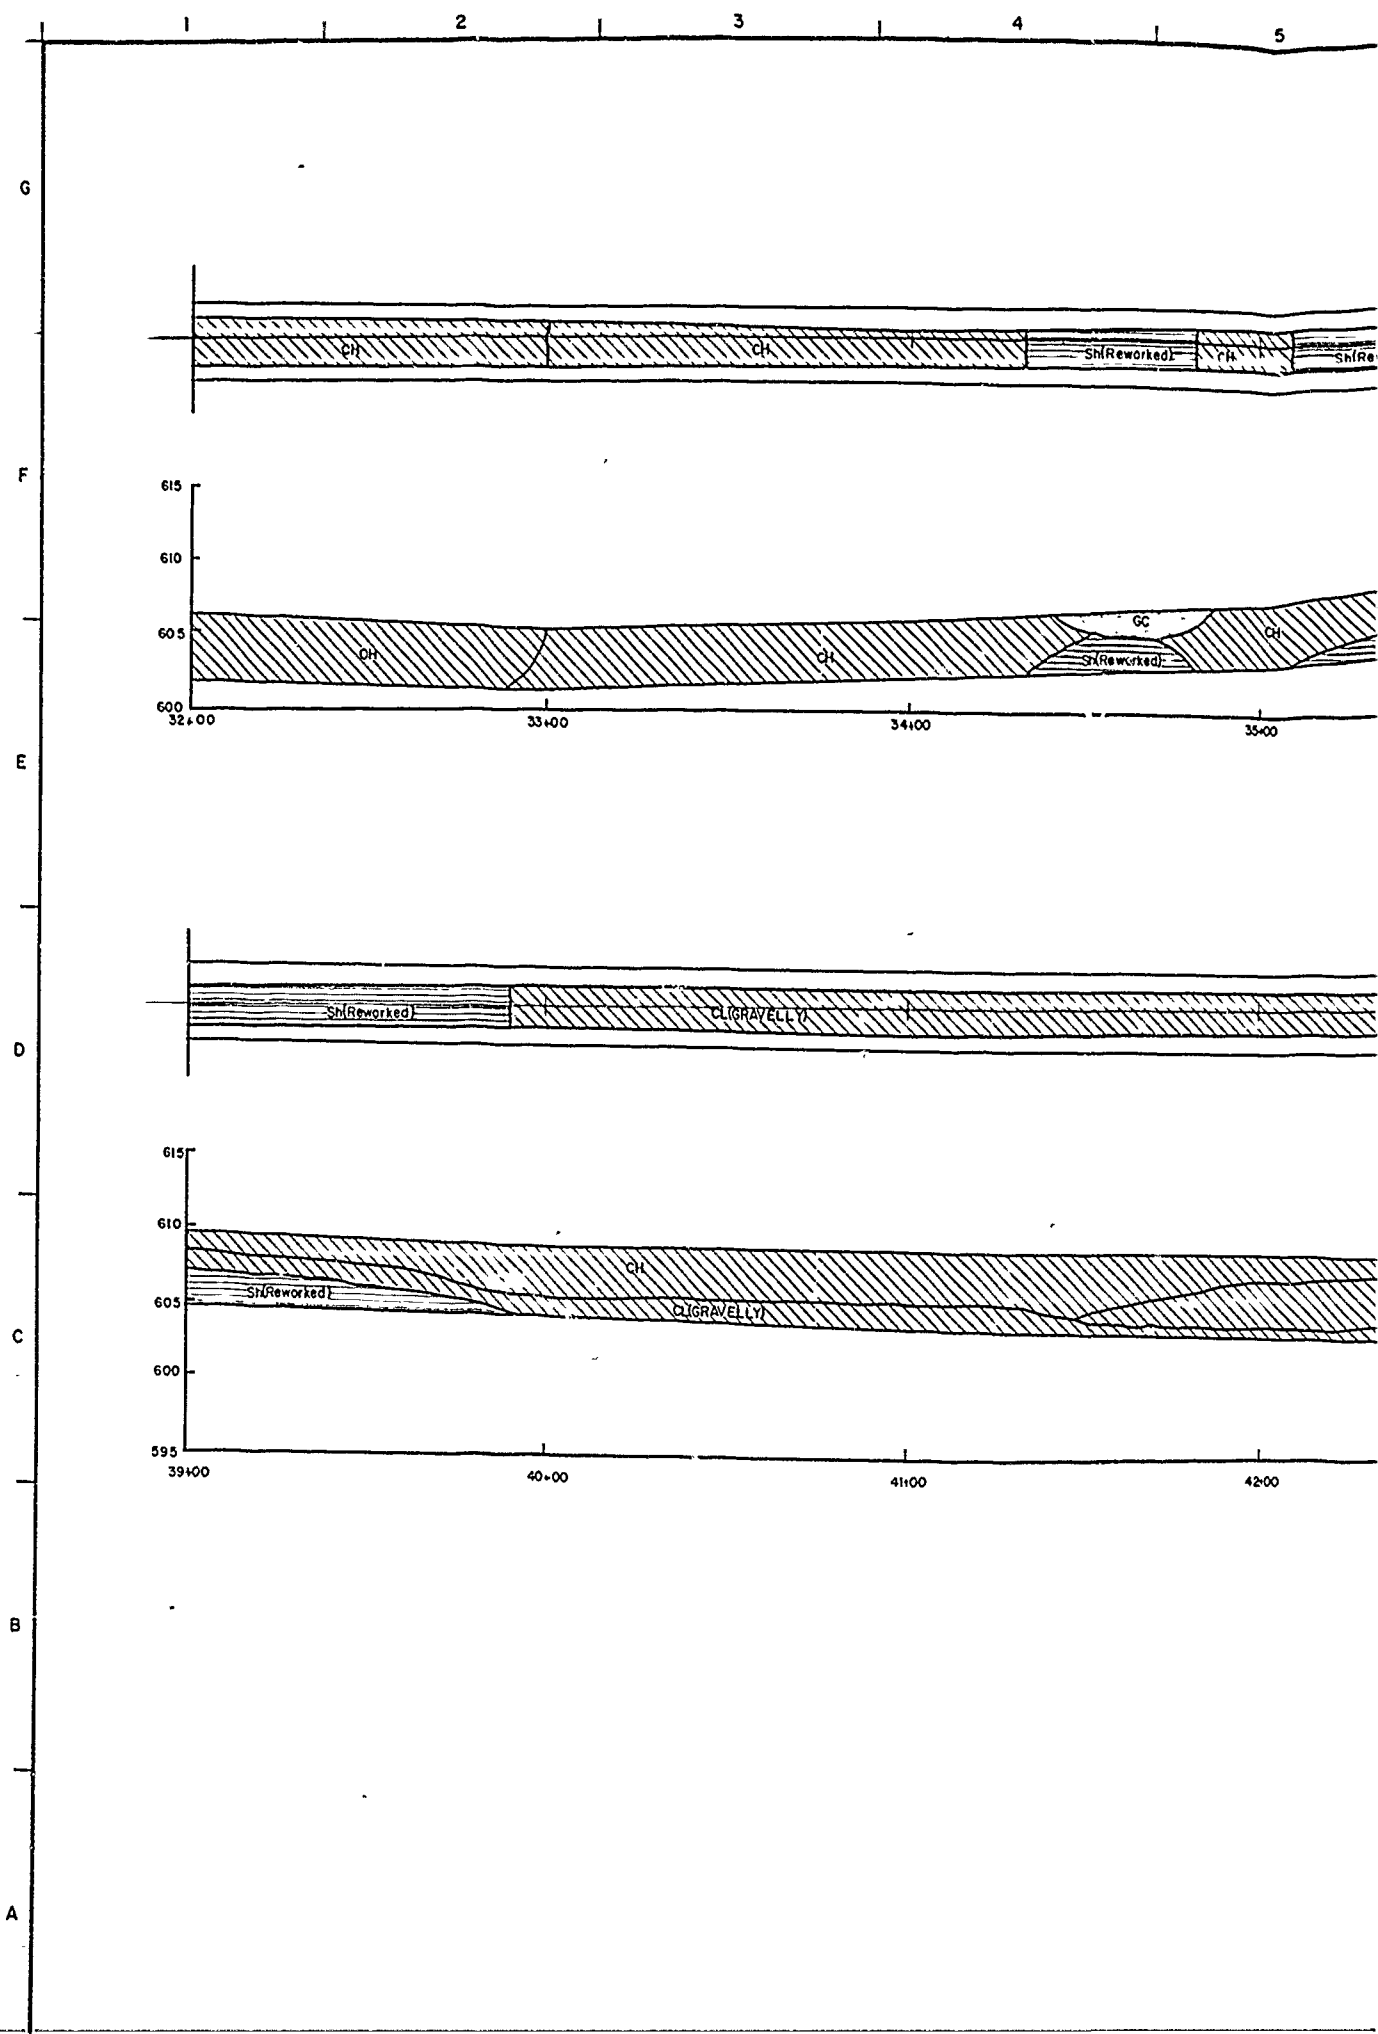

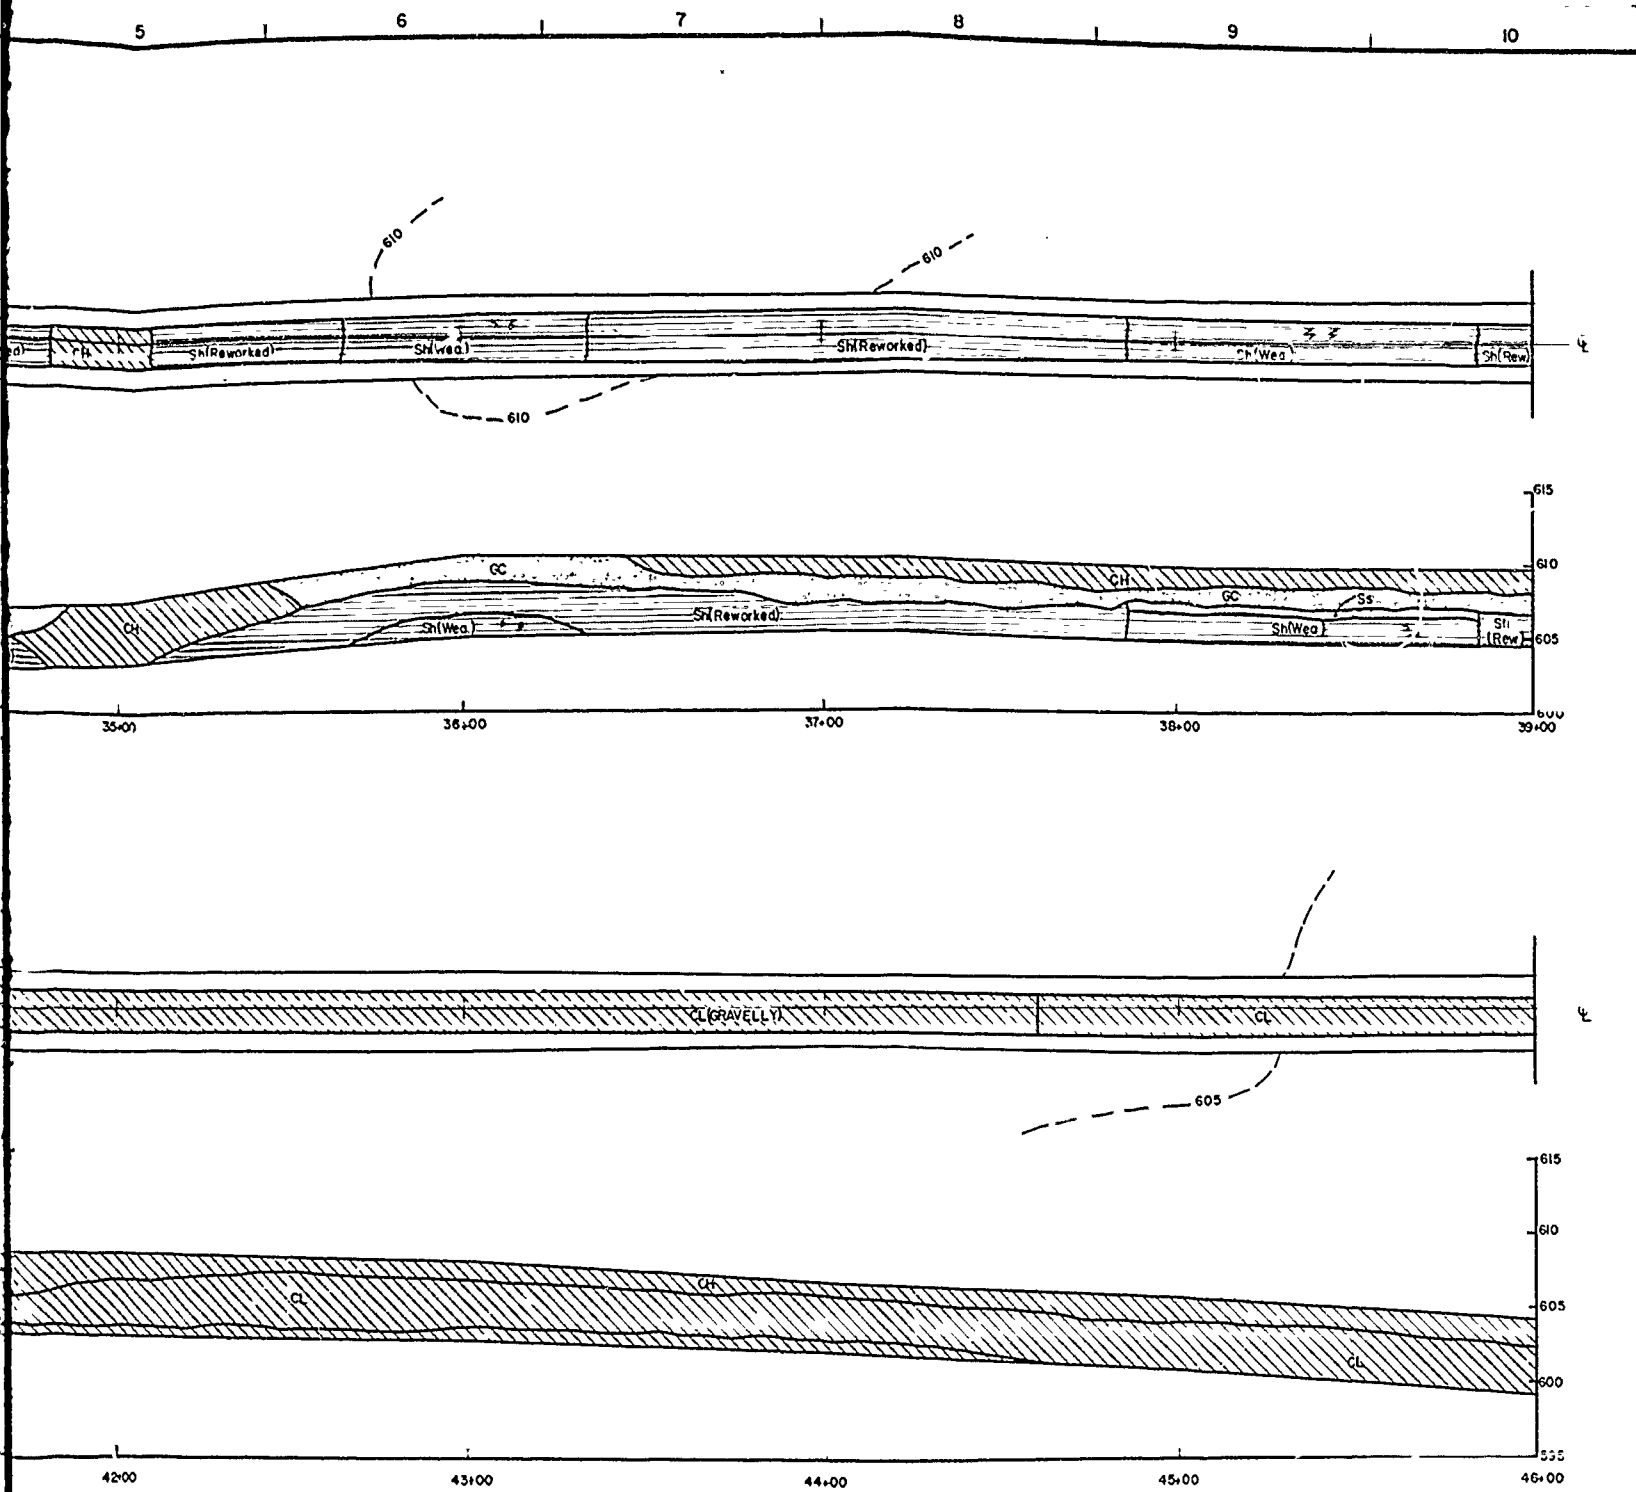



DESIGNED BY: H. BARNETT		RAY ROBERTS LAKE ELM FORK, TRINITY RIVER, TEXAS	
DRAWN BY: C. KIRBY		FOUNDATION REPORT INSPECTION TRENCH AS-BUILT PLAN AND PROFILE STA. 32+00 TO 46+00	
REVIEWED BY: R. BEHM		U.S. ARMY ENGINEER DISTRICT, FORT WORTH CORPS OF ENGINEERS FORT WORTH, TEXAS	
SUBMITTED BY: ROBERT C. BEHM		SOL. NO.	DATED:
		CONTR. NO.	SECURE:

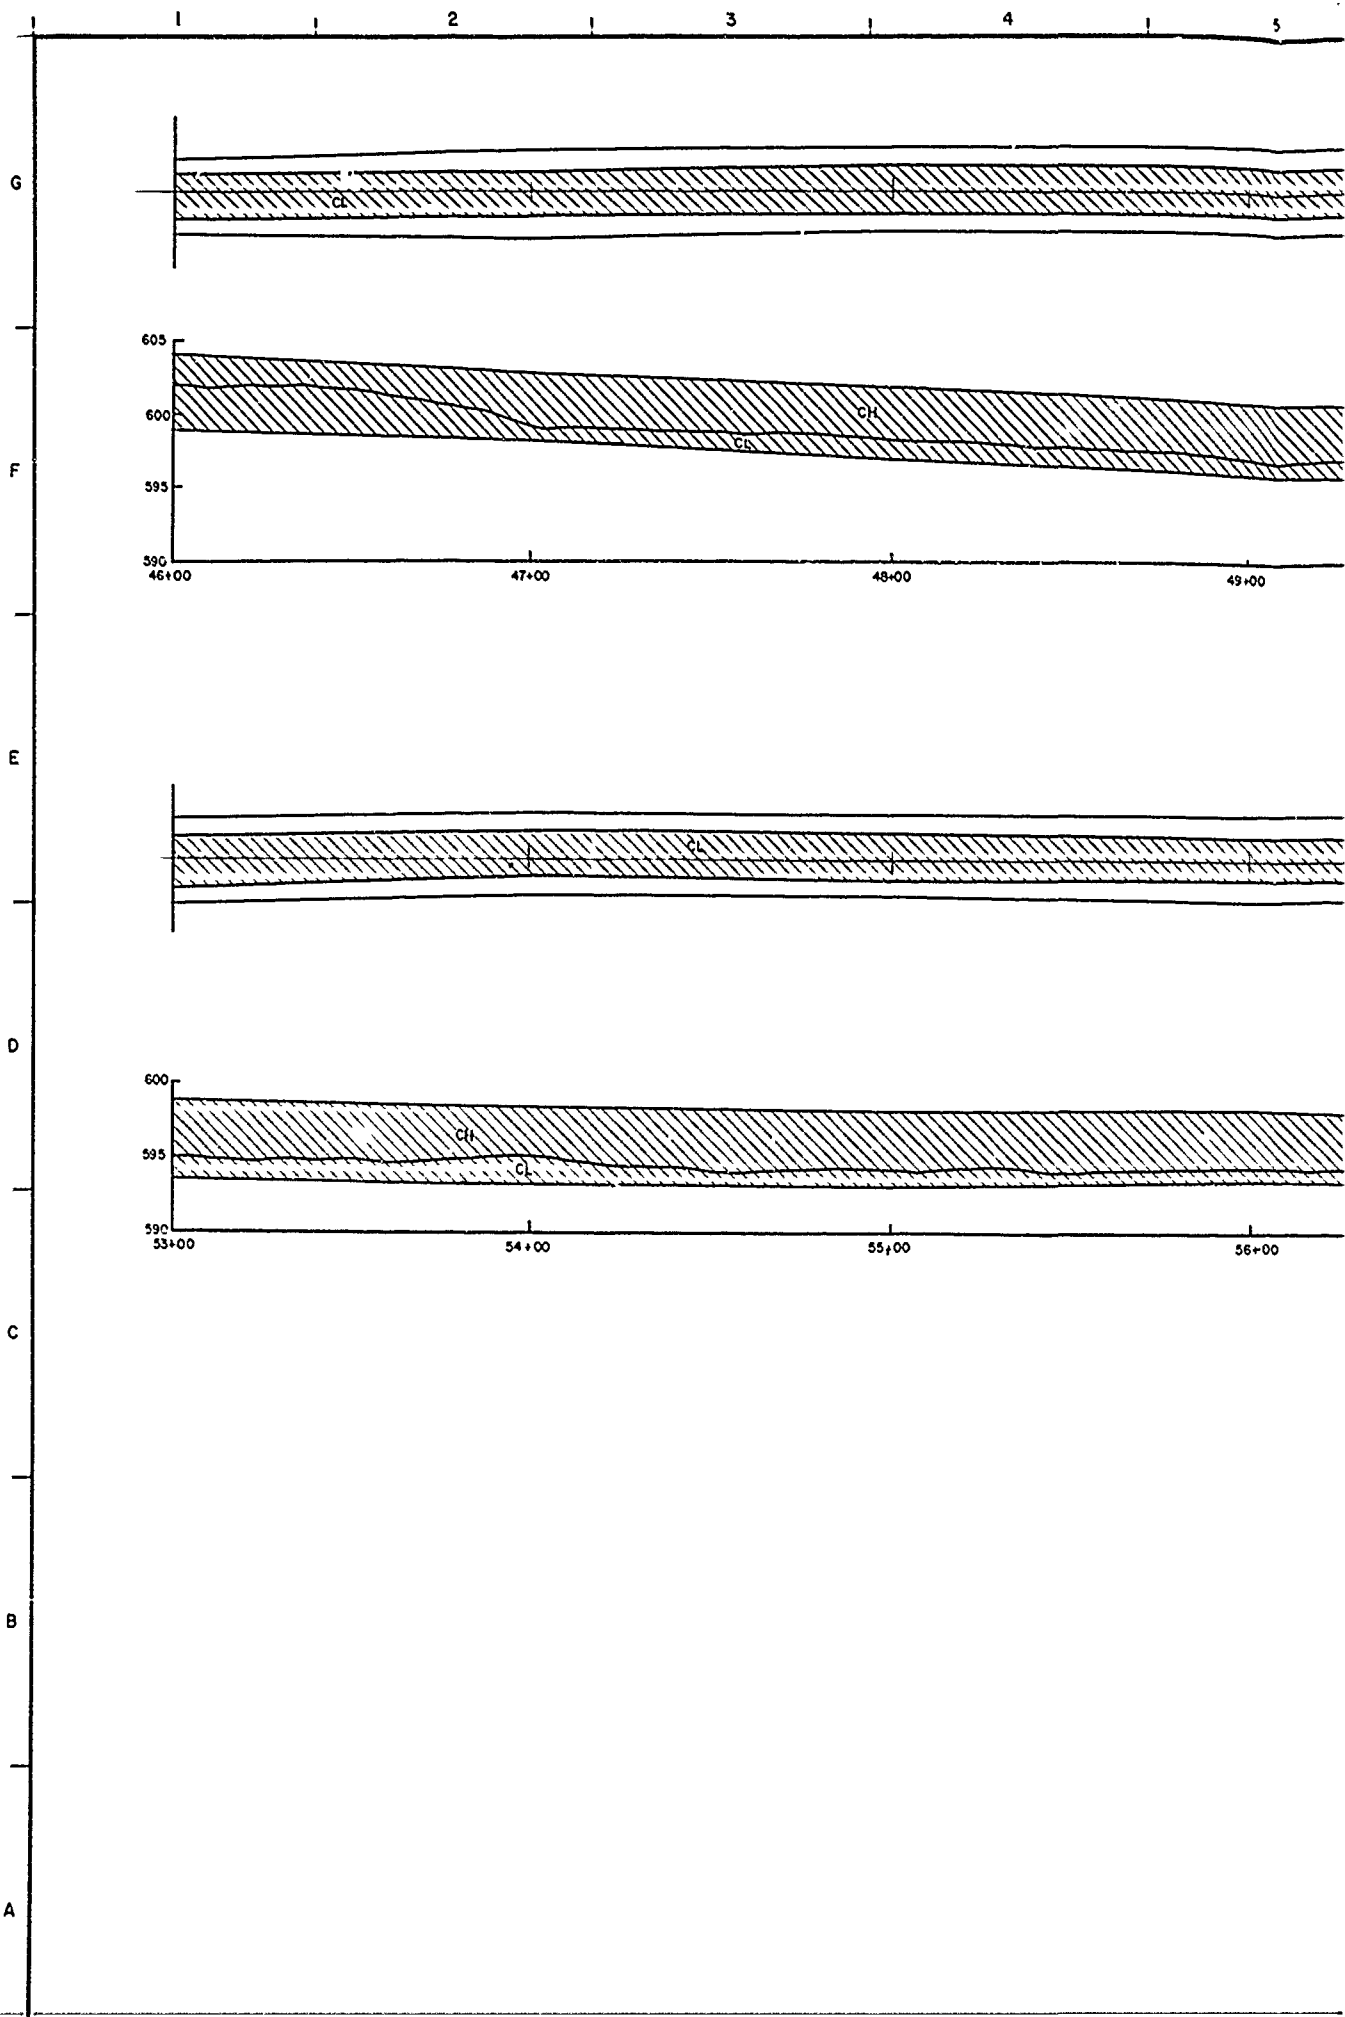

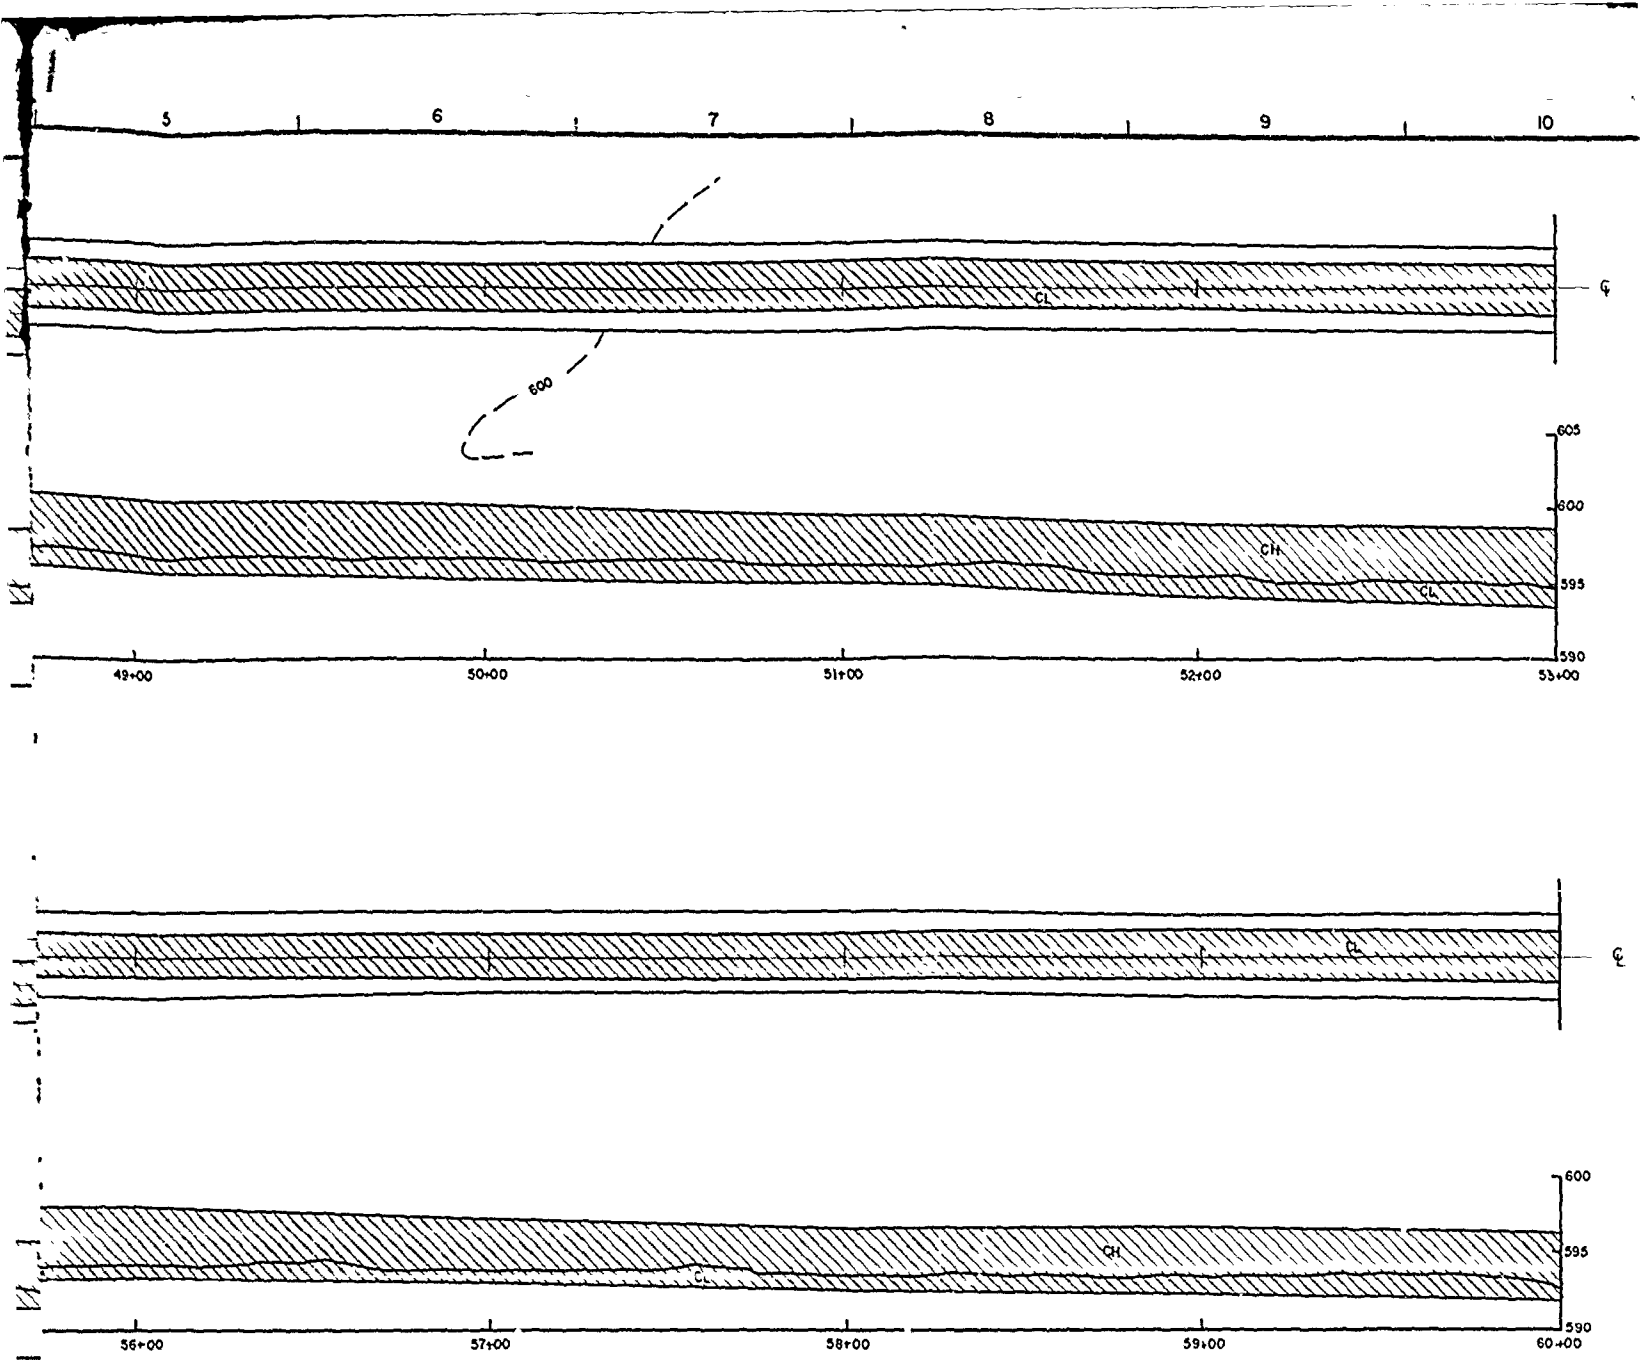

DESIGNED BY: H. BARNETT		RAY ROBERTS LAKE ELM FORK, TRINITY RIVER, TEXAS	
DRAWN BY: C. KIBBY		FOUNDATION REPORT INSPECTION TRENCH AS-BUILT PLAN AND PROFILE STA. 46+00 TO 60+00	
REVIEWED BY: R. BEHM			
SUBMITTED BY: ROBERT C. BEHM		SOL. NO.	DATED:
ENGINEER:		CONTR. NO.	SEQUENCE NO.

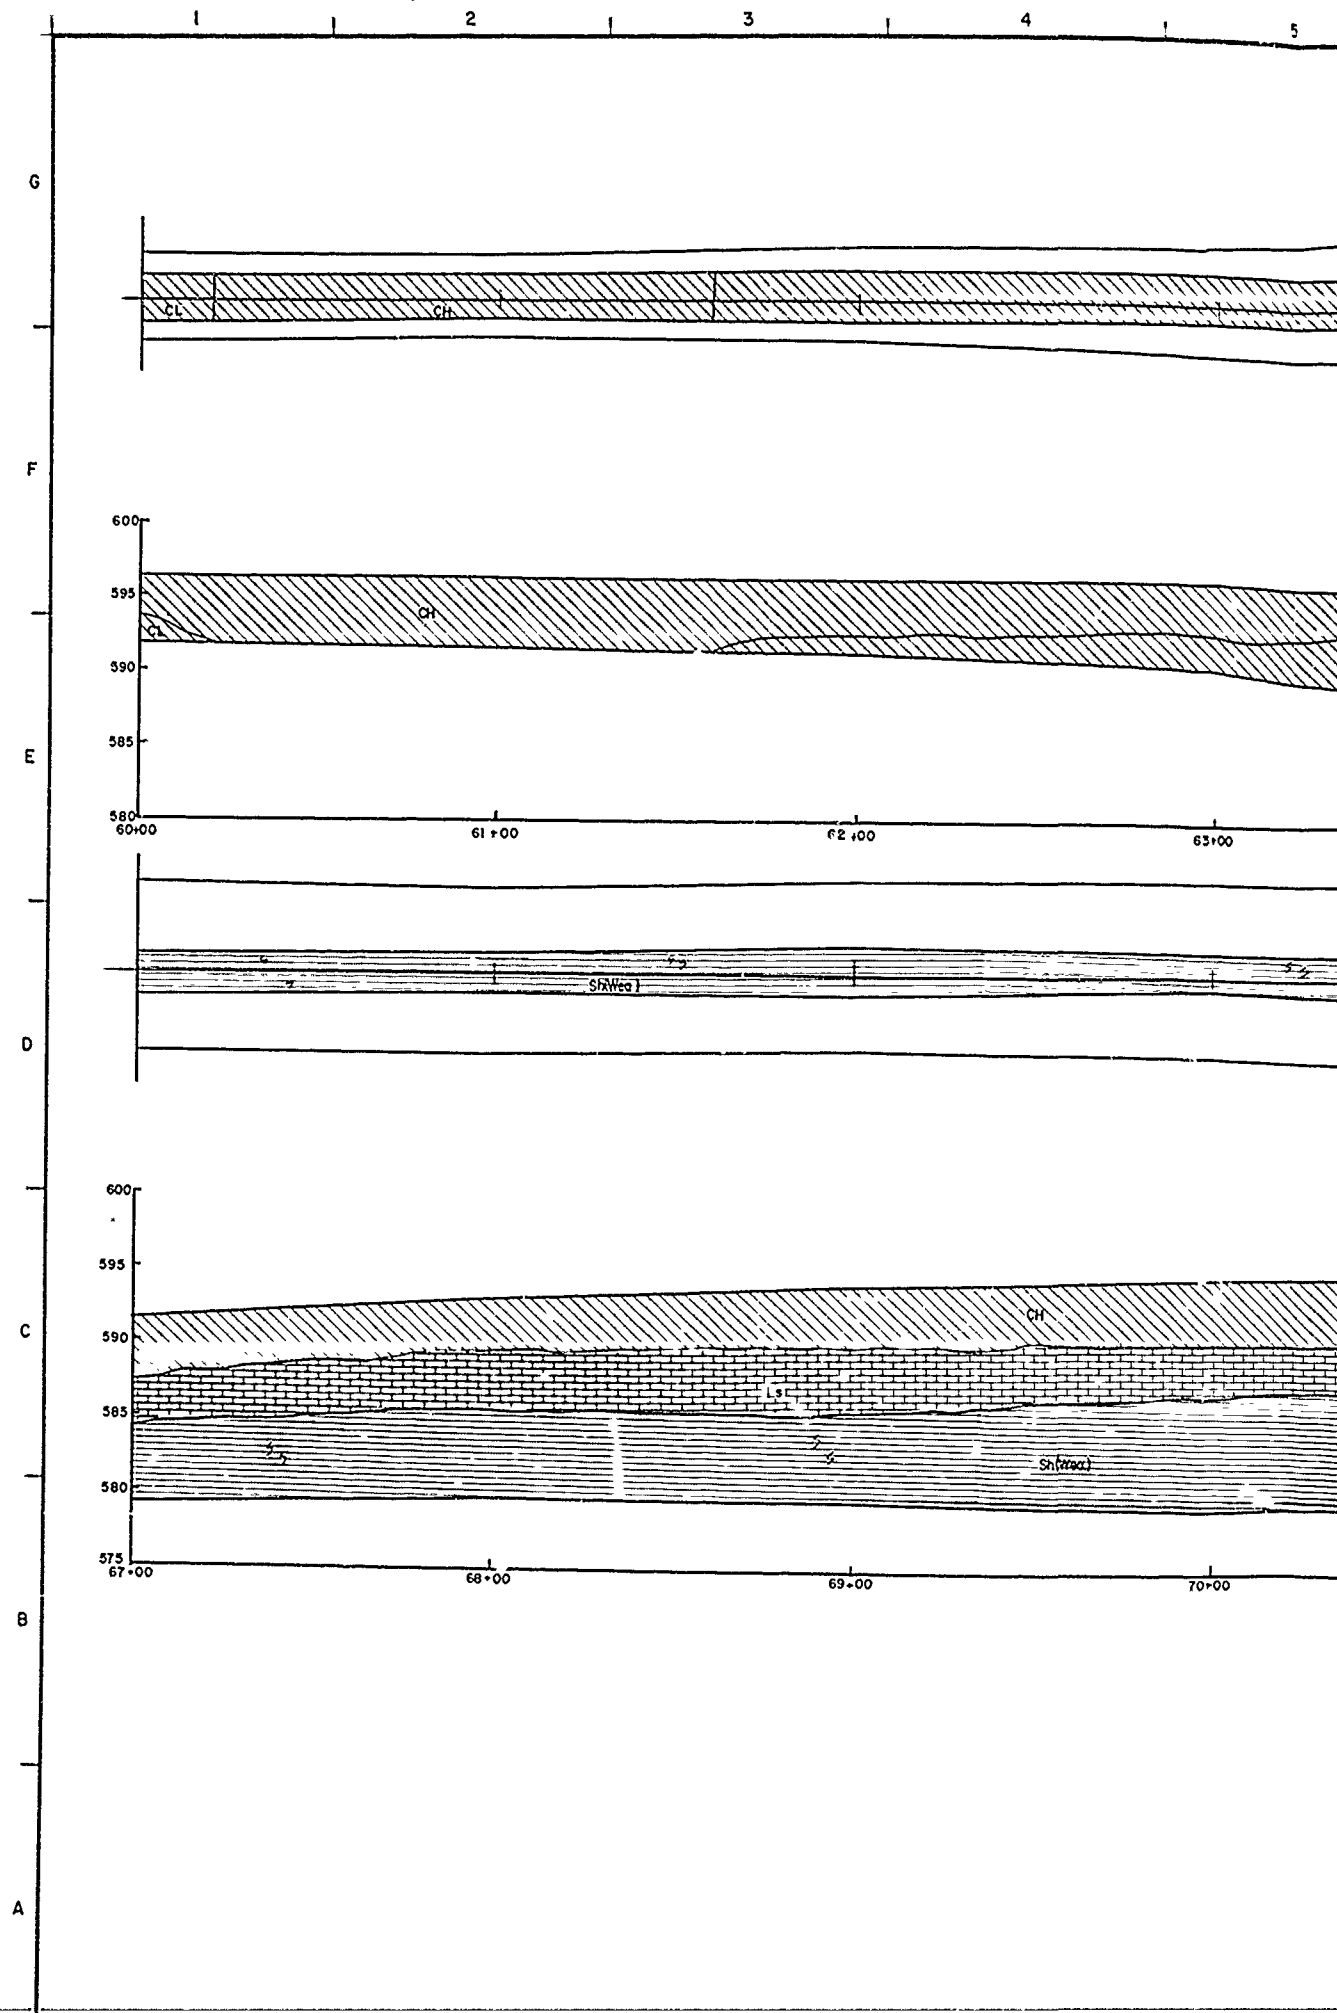


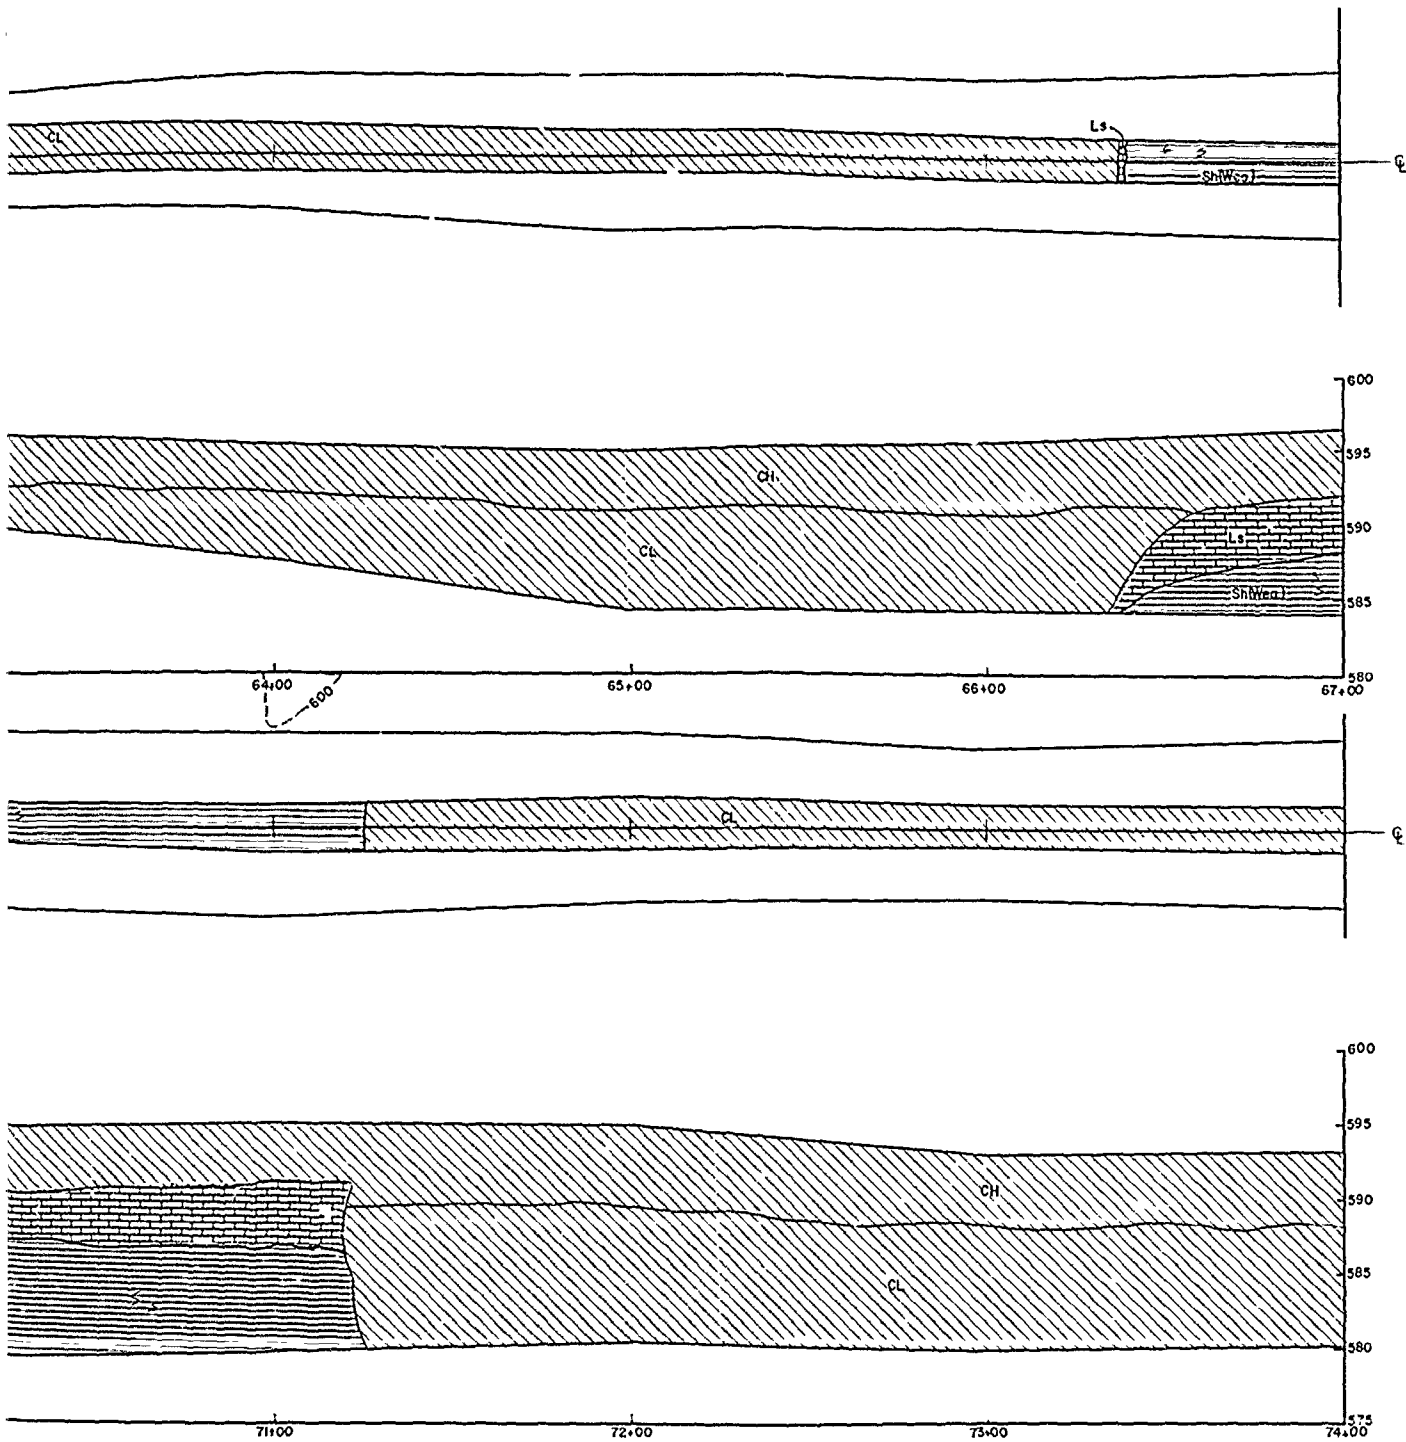


DESIGNED BY: H. BARNETT		RAY ROBERTS LAKE ELM FORK, TRINITY RIVER, TEXAS	
DRAWN BY: C. KIRBY		FOUNDATION REPORT	
REVIEWED BY: R. BEHM		INSPECTION TRENCH AS-BUILT PLAN AND PROFILE STA. 60+00 TO 74+00	
SUBMITTED BY: ROBERT C. BEHM ENGINEER		SOL. NO.	DATED:
		CONTR. NO.	SEQUENCE NO.
		DRAWING NUMBER	SHEET NO. OF
			54

TO ACCOMPANY FOUNDATION REPORT

G

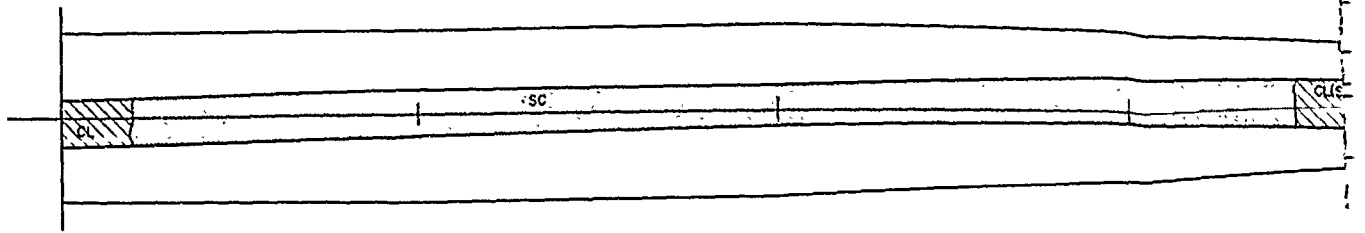


F

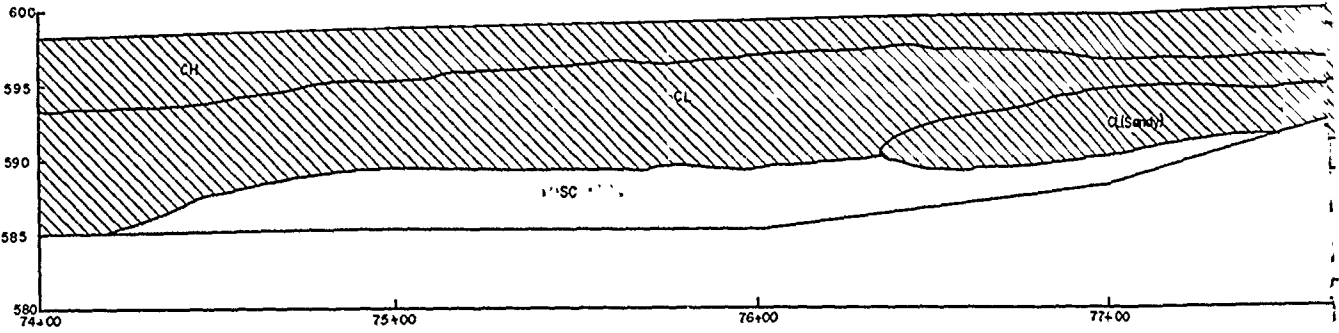


E

D

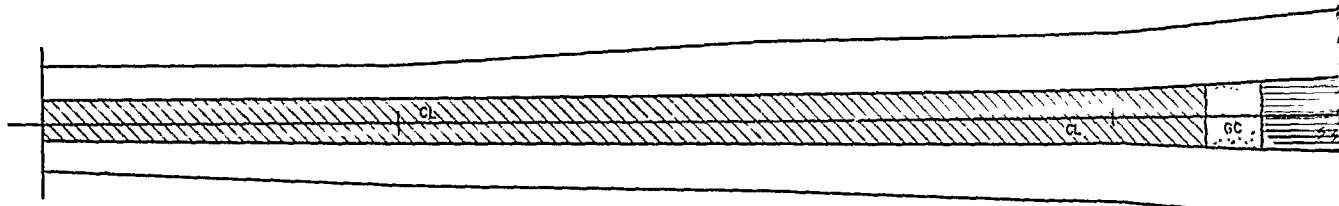


C

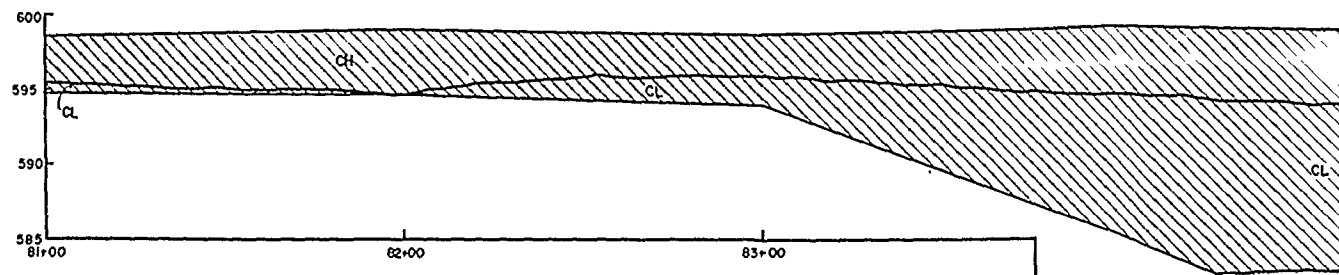

B

A

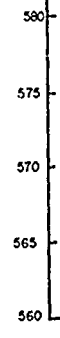





84+00

2

3

4

5

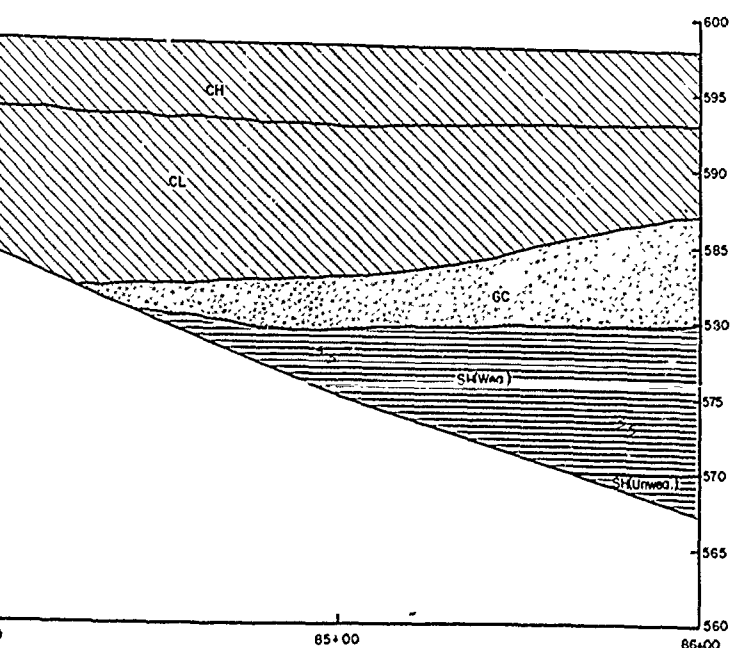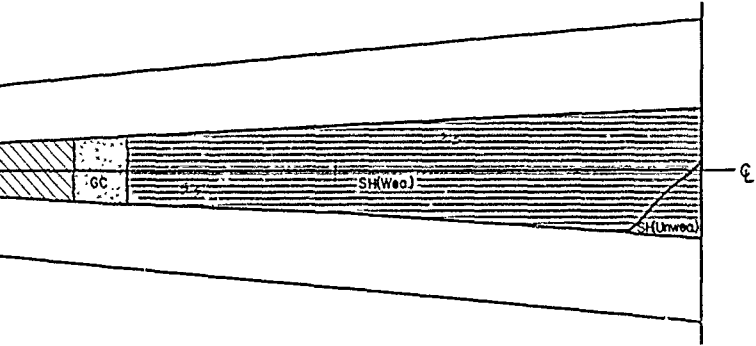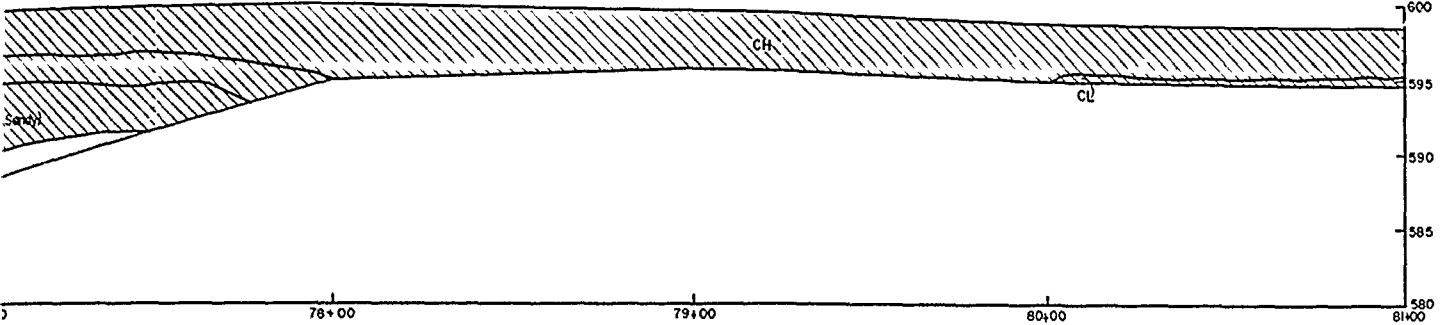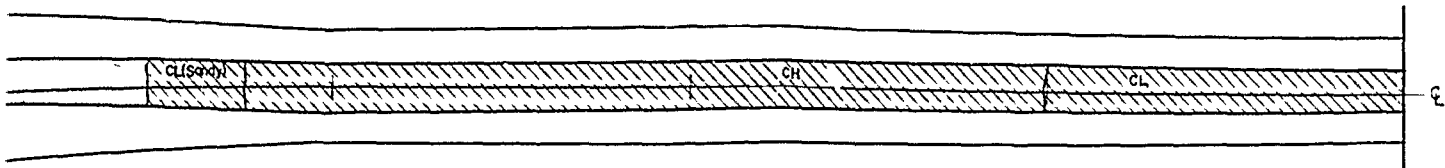

DESIGNED BY H. BARNETT		RAY ROBERTS LAKE ELM FORK, TRINITY RIVER, TEXAS	
DRAWN BY C. KIRBY		FOUNDATION REPORT	
REVIEWED BY R. BEHM		INSPECTION TRENCH	
SUBMITTED BY ROBERT C. BEHM		AS-BUILT PLAN AND PROFILE	
ENGINEER		STA 74+00 TO 86+00	
CONTR. NO.		SHEET NO. 55	
DRAWING NUMBER		SEQUENCE NO.	
DATED		OF	

TO ACCOMPANY FOUNDATION REPORT

G
F
E
D
C
B

5 6 7 8

G

F


E

D

C

B

A

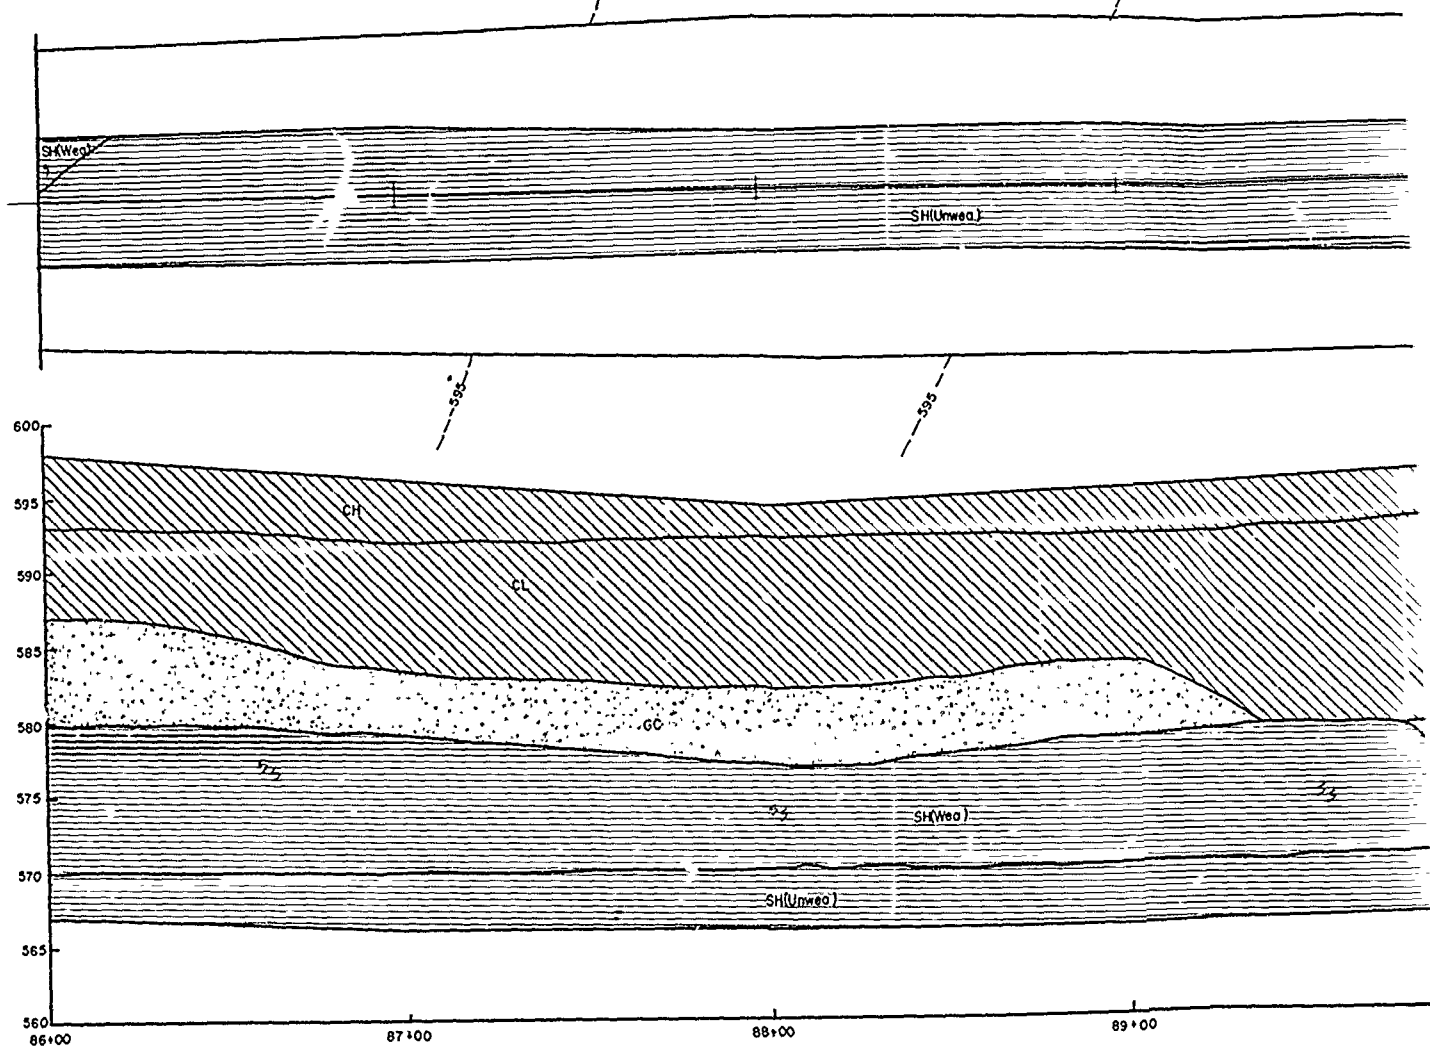

86+00

87+00

88+00

89+00

560

565

570

575

580

585

590

595

600

595

590

585

580

575

570

565

560

560


560

560

560

560

G
F
E
D
C
B

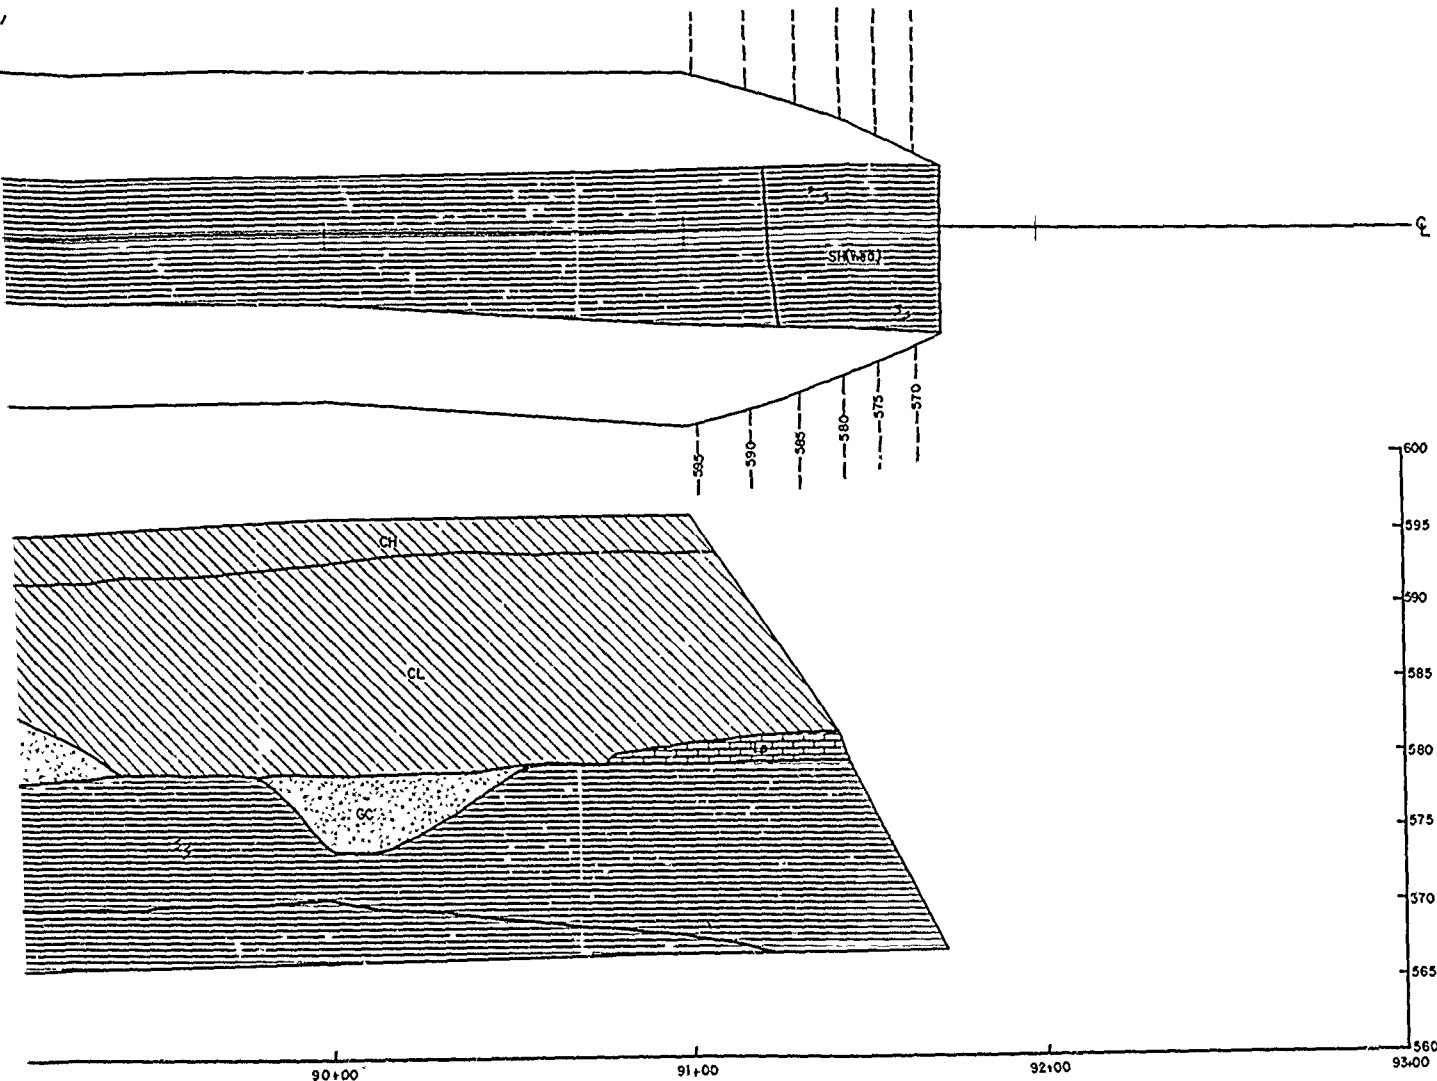

DESIGNED BY: H. RAPPETTI		DRAWN BY: C. KIRBY		REVIEWED BY: R. BEHM	
SUBMITTED BY: ROBERT C. BEHM		CONTR. NO.		DATED:	
ENGINEER:		DRAWING NUMBER		SHEET NO. OF	
				56	


U.S. ARMY ENGINEER DISTRICT, FORT WORTH
CORPS OF ENGINEERS
FORT WORTH, TEXAS

**RAY ROBERTS LAKE
ELM FOG, TRINITY RIVER, TEXAS
FOUNDATION REPORT
INSPECTION TRENCH
AS-BUILT PLAN AND PROFILE
STA. 86+00 TO 93+00**

5 6 7 8

TO ACCOMPANY FOUNDATION REPORT

G
F
E
D
C
B
A

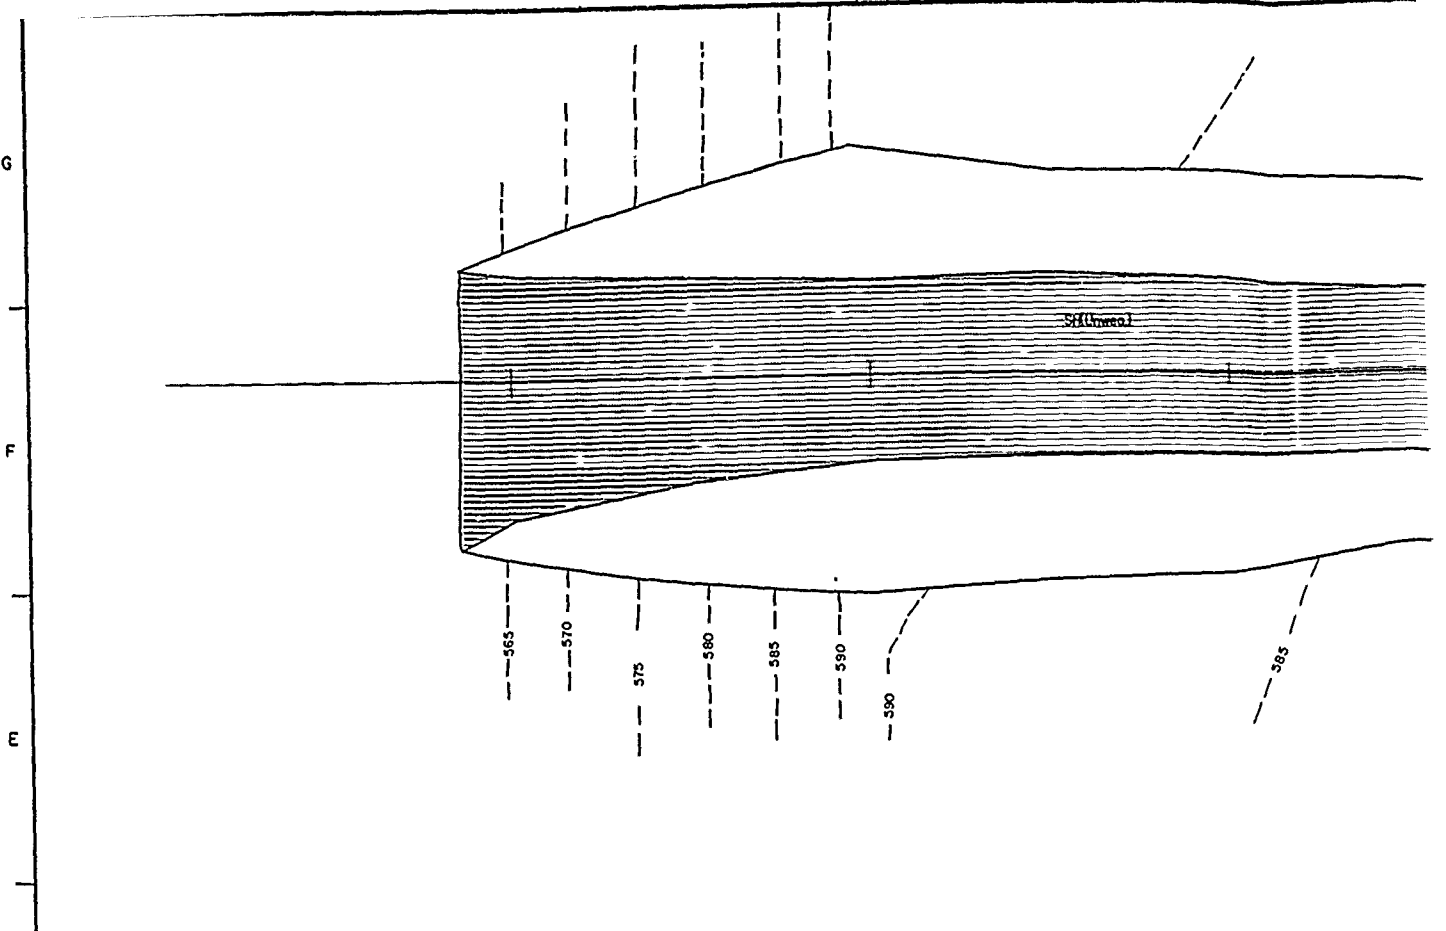

600
595
590
585
580
575
570
565
560

B

93+00


94+00



95+00

96+00

A


1 2 3 4 5

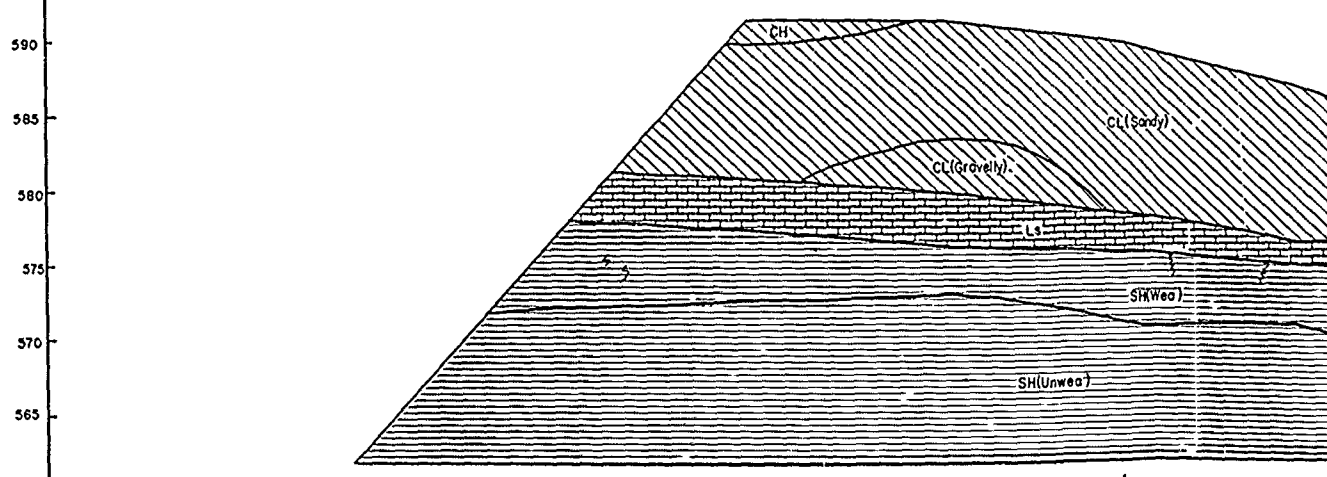


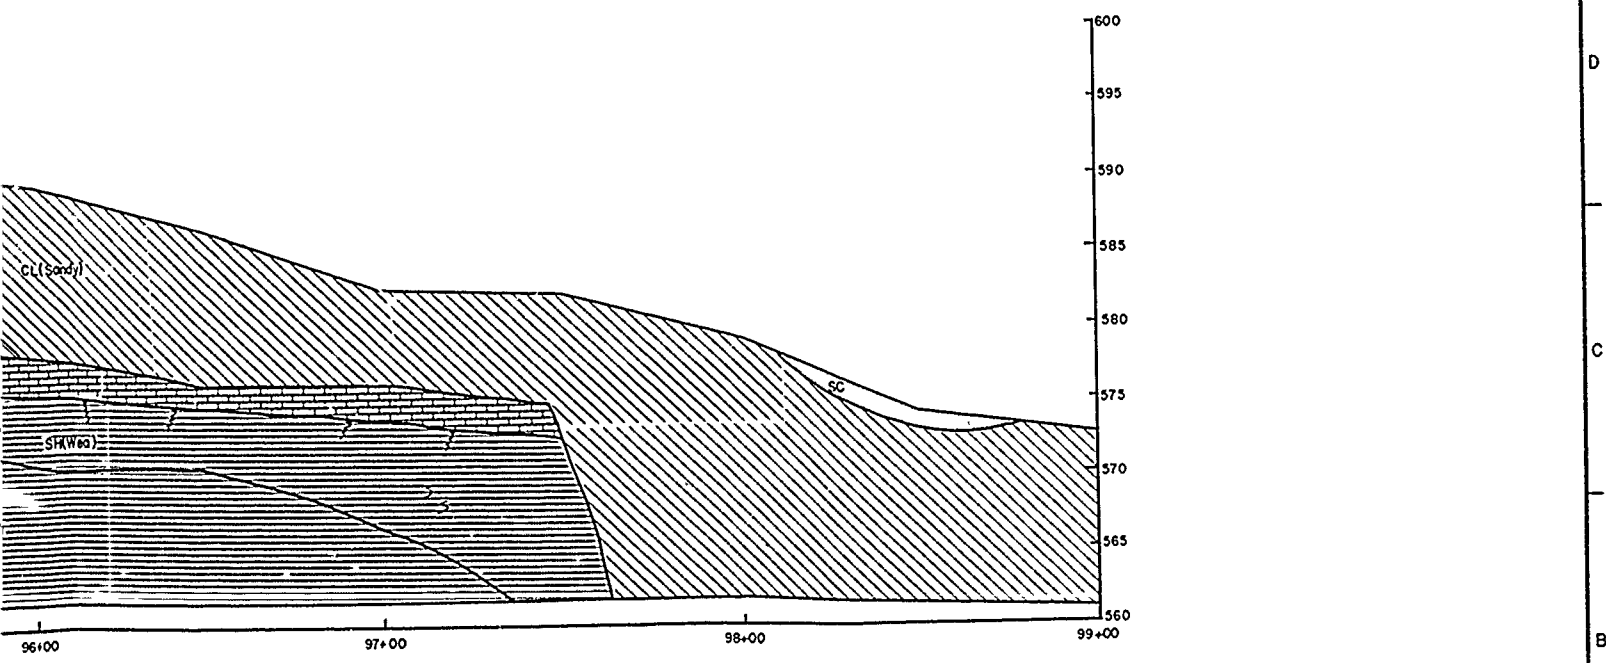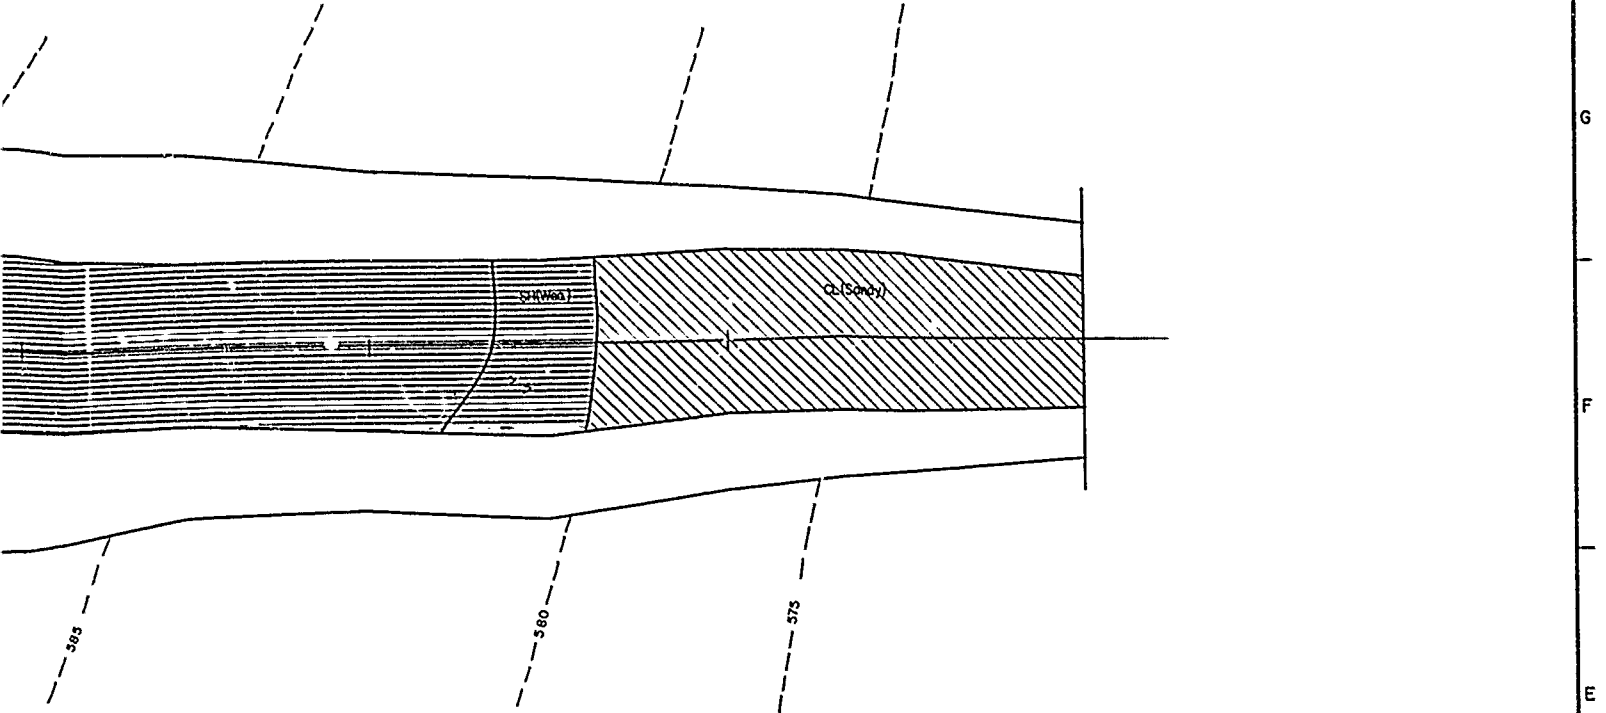

DESIGNED BY: H. BARNETT		RAY ROBERTS LAKE ELM FORK, TRINITY RIVER, TEXAS	
DRAWN BY: C. KIRBY		FOUNDATION REPORT INSPECTION TRENCH	
REVIEWED BY: R. BEHM		AS-BUILT PLAN AND PROFILE STA. 93 00 TO 99 00	
SUBMITTED BY: ROBERT C. BEHM ENGINEER		SOL. NO.	DATED:
		CONTR. NO.	REC. NO.
		DRAWING NUMBER	SHEET NO. 57


TO ACCOMPANY FOUNDATION REPORT

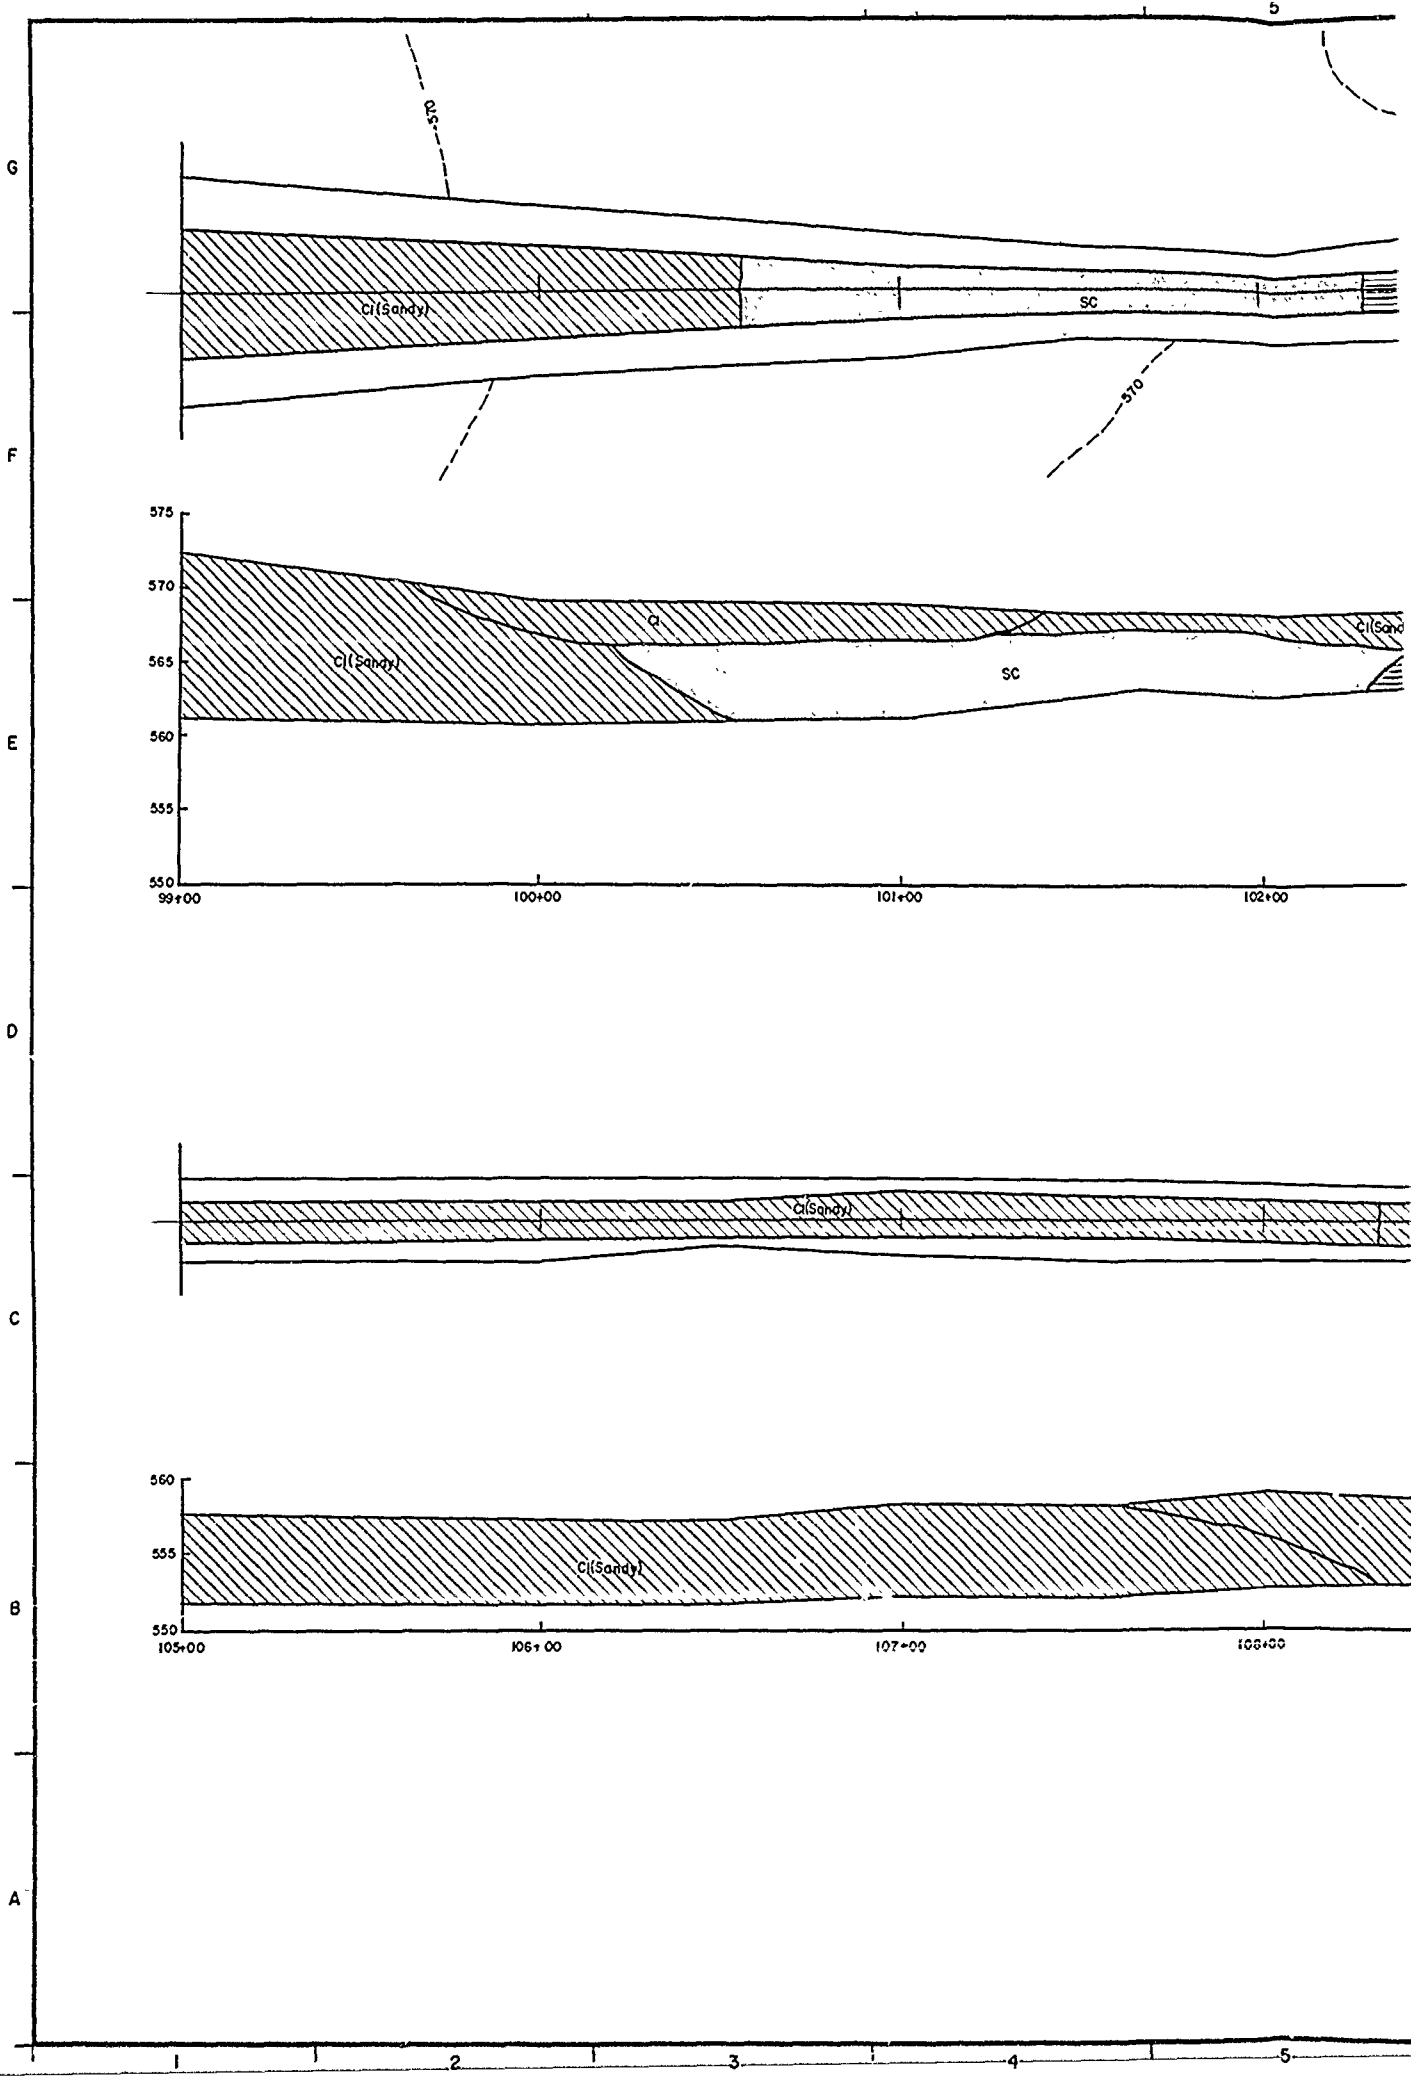


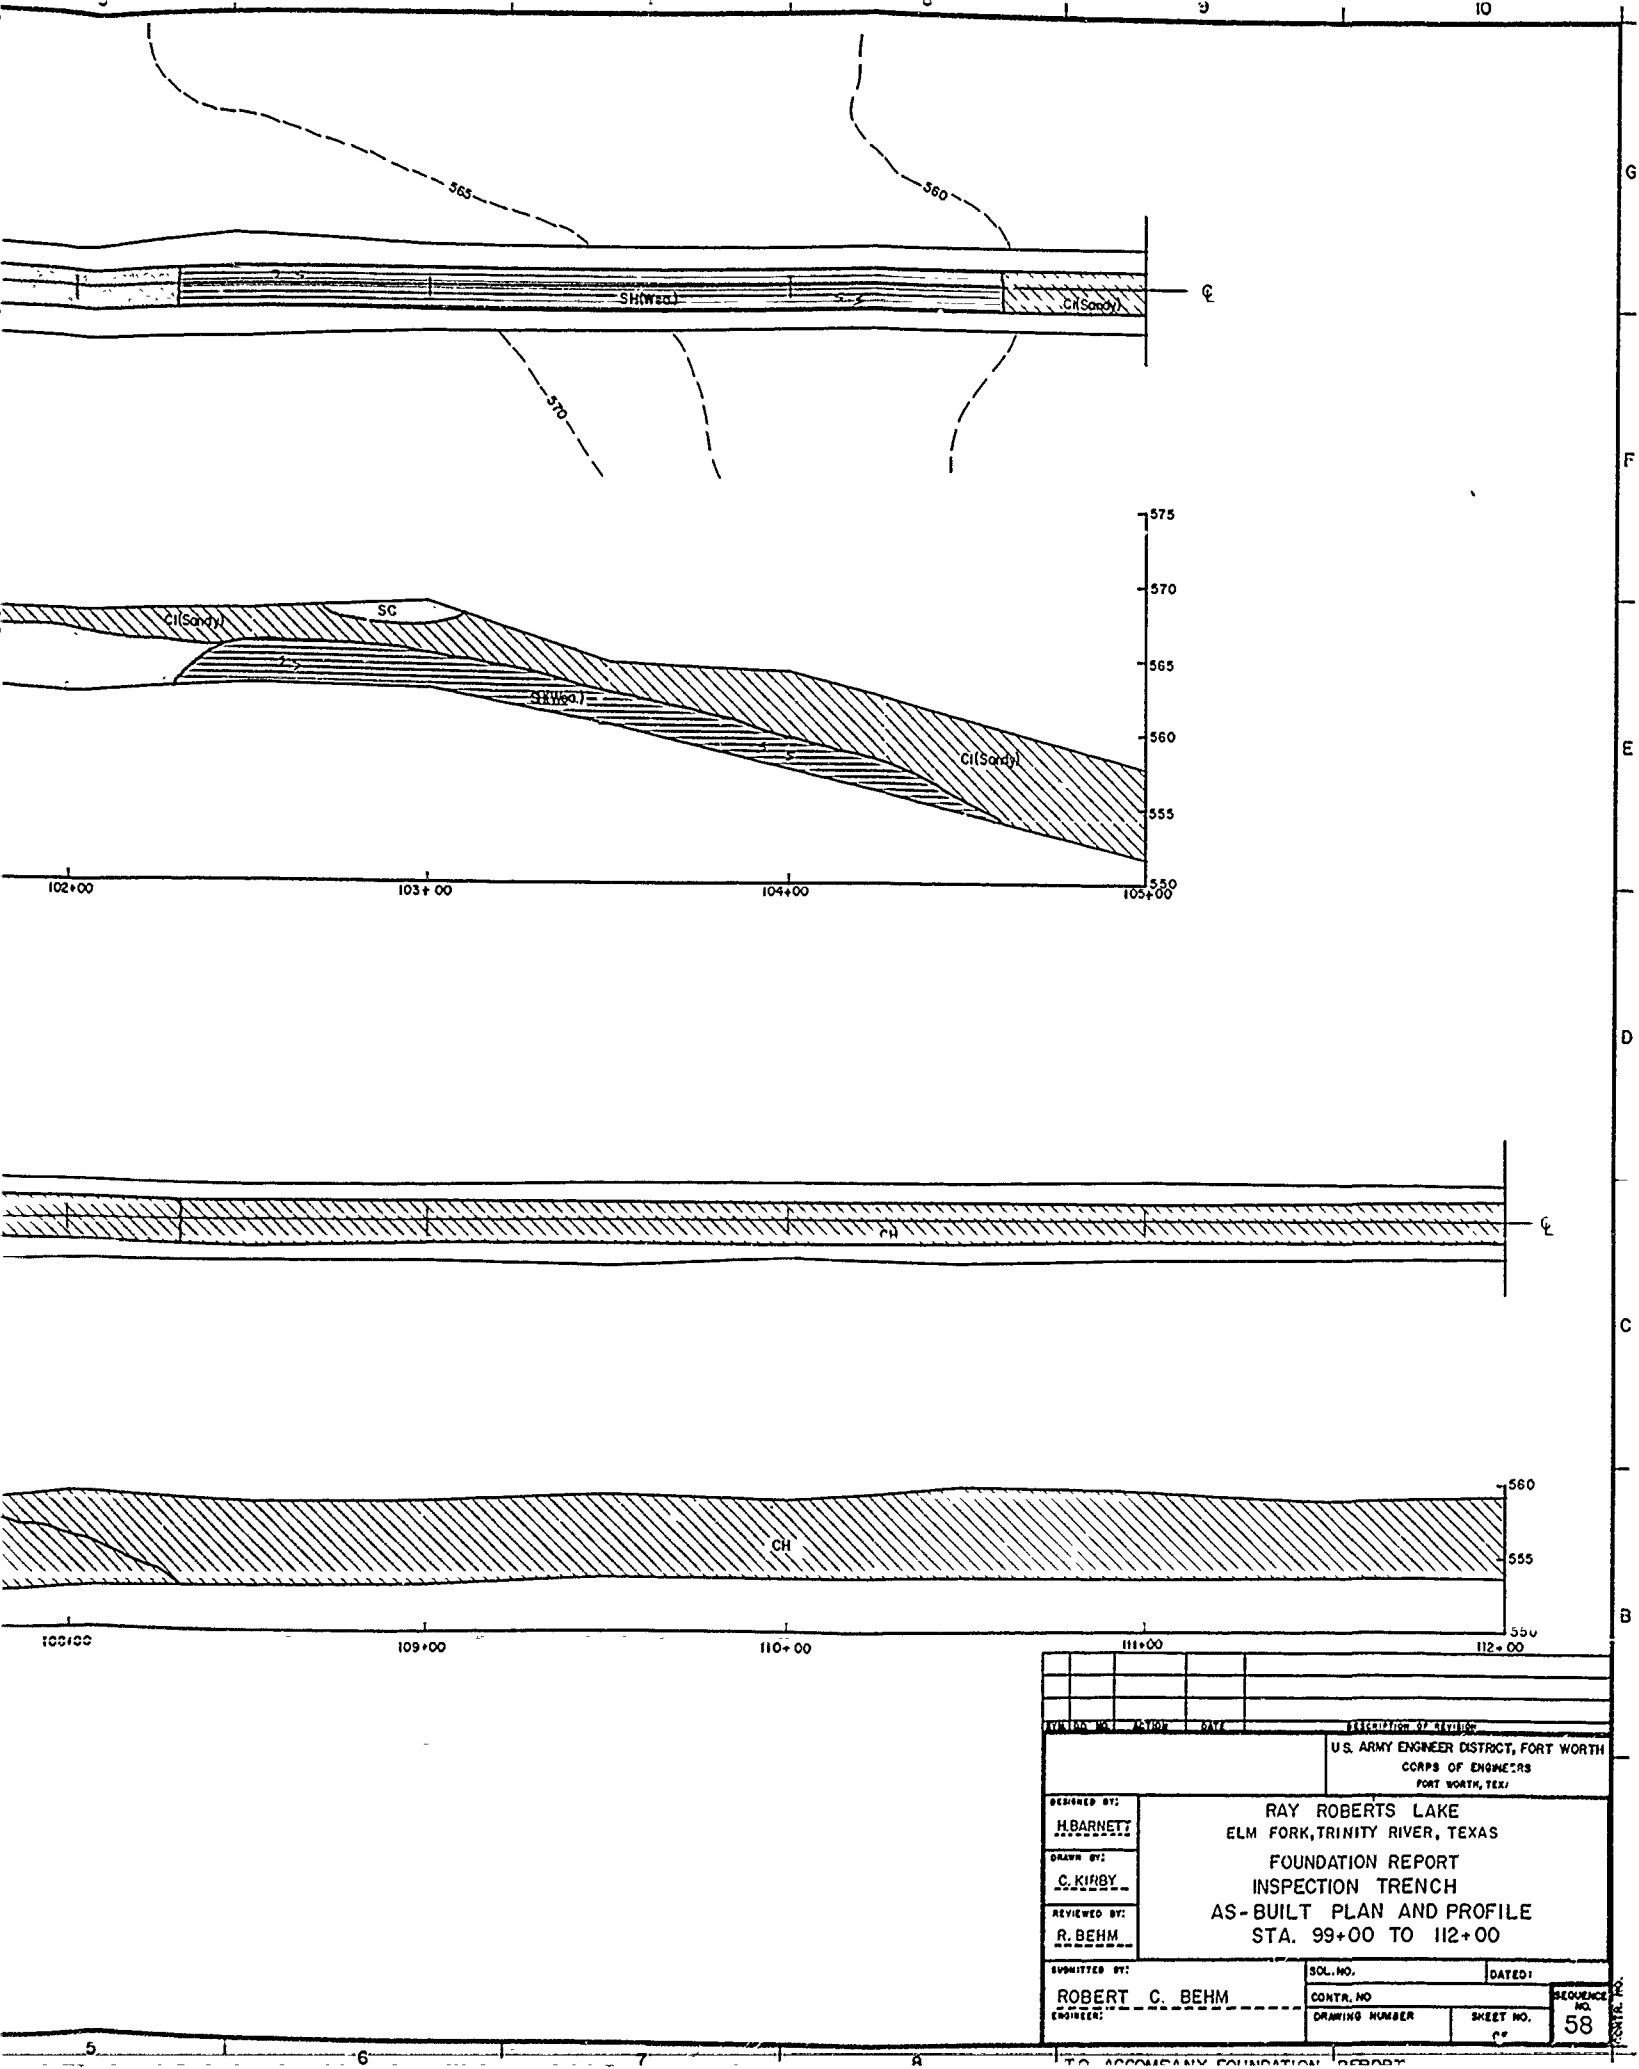




DESIGNED BY: <u>H. BARNETT</u>		RAY ROBERTS LAKE ELM FORK, TRINITY RIVER, TEXAS FOUNDATION REPORT INSPECTION TRENCH AS-BUILT PLAN AND PROFILE STA. 99+00 TO 112+00	
DRAWN BY: <u>C. KIRBY</u>			
REVIEWED BY: <u>R. BEHM</u>			
SUBMITTED BY: <u>ROBERT C. BEHM</u>			
CONTR. NO.		DATED:	
DRAWING NUMBER		SEQUENCE NO.	
SHEET NO.		OF	
58			

TO ACCOMPANY FOUNDATION REPORT

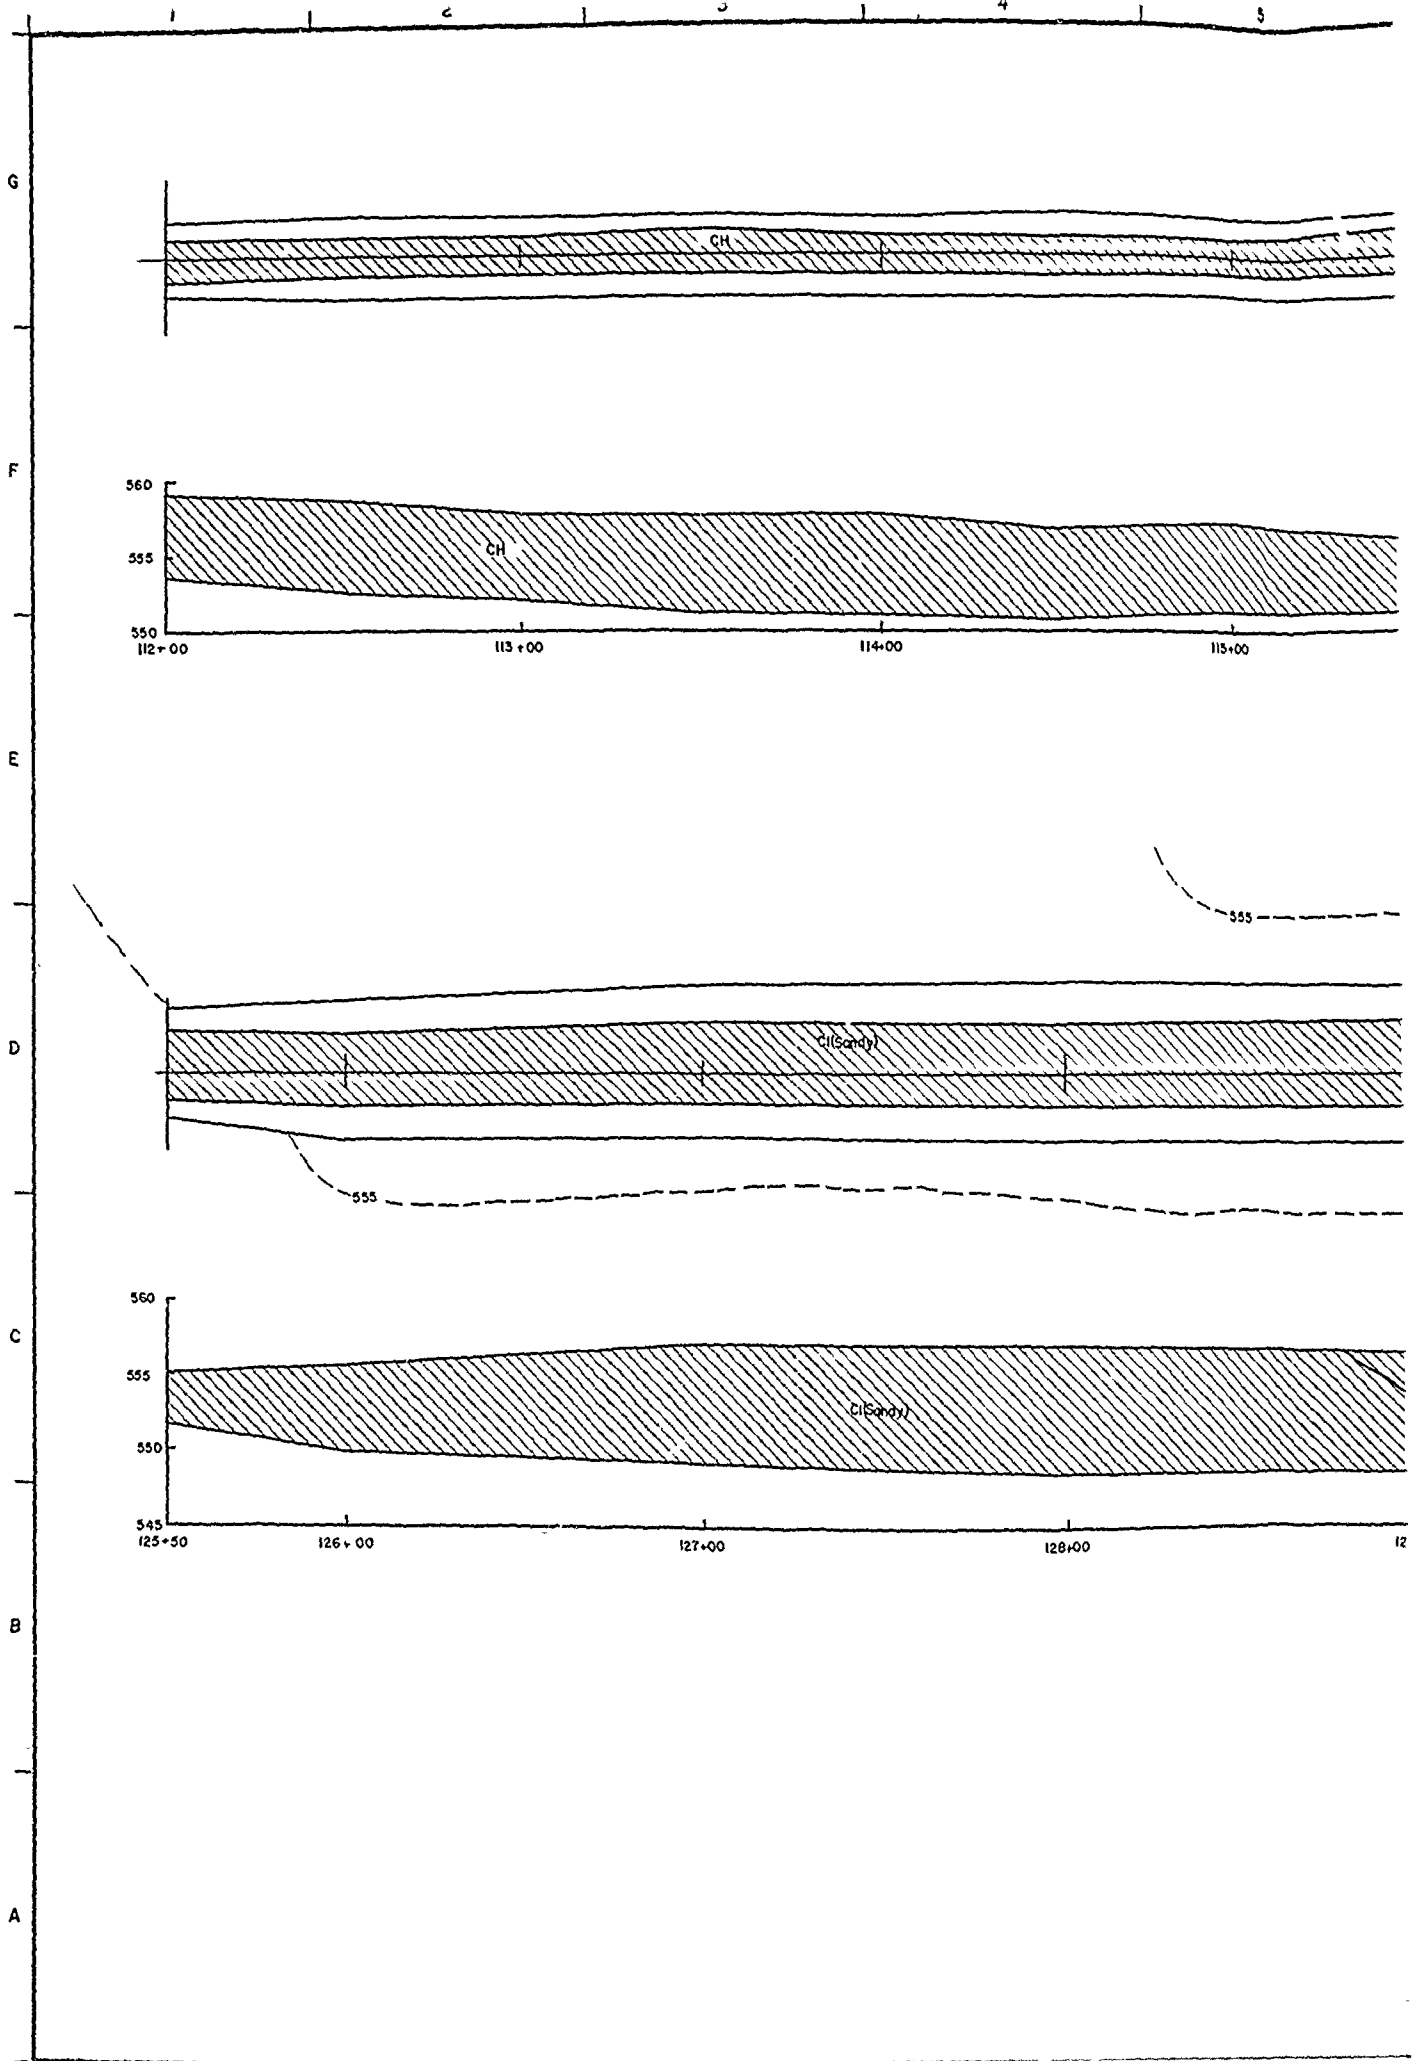

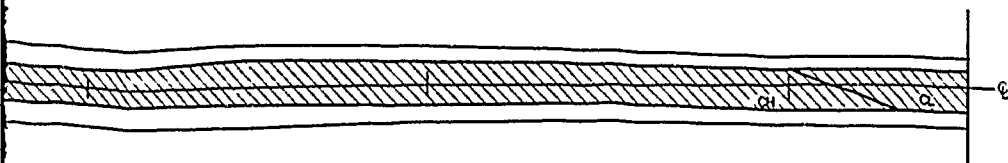




NOTE
 NO INSPECTION TRENCH WAS EXCAVATED BETWEEN STATIONS 117+50 AND 125+50

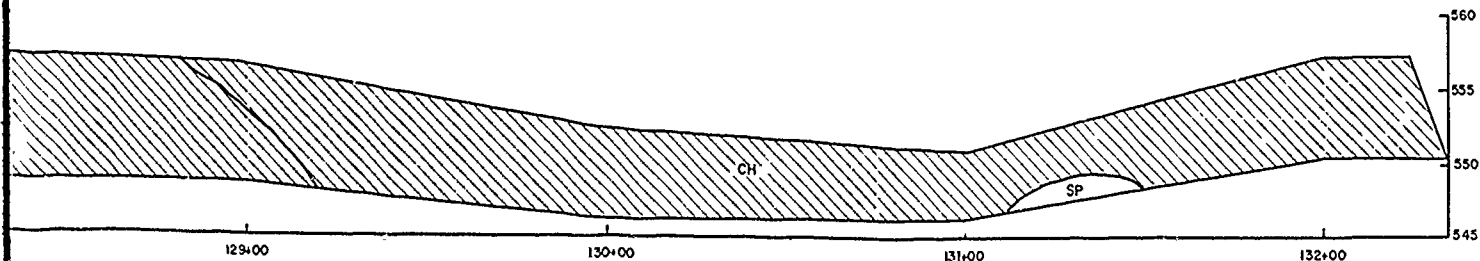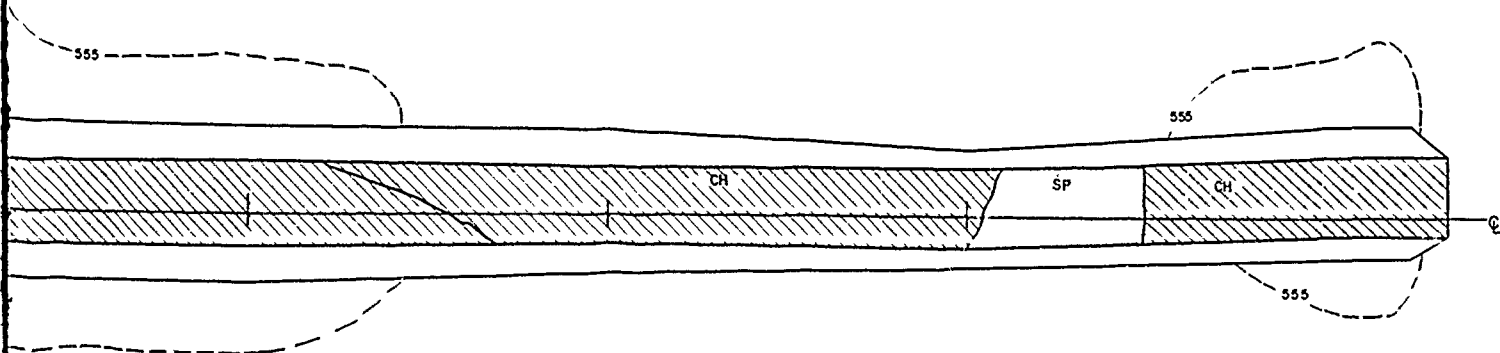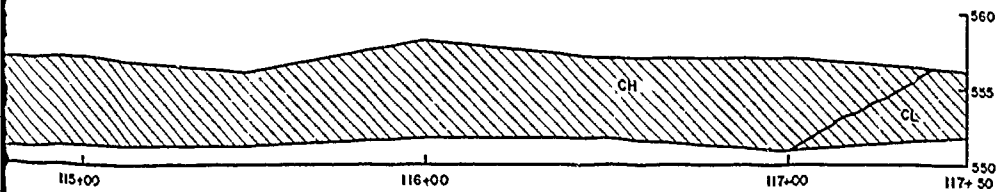

DESIGNED BY: H. BARNETT	RAY ROBERTS LAKE ELM FORK, TRINITY RIVER, TEXAS FOUNDATION REPORT INSPECTION TRENCH AS-BUILT PLAN AND PROFILE STA. 112+00 TO 117+50/125+50 TO 132+35	U.S. ARMY ENGINEER DISTRICT, FORT WORTH CORPS OF ENGINEERS FORT WORTH, TEXAS
DRAWN BY: C. KIRBY		
REVIEWED BY: R. BEHM		
SUBMITTED BY: ROBERT C. BEHM ENGINEER	SCALE NO.	DATED:
	CONTR. NO.	SEQUENCE NO. 59
	DRAWING NUMBER	SHEET NO. OF


TO ACCOMPANY FOUNDATION REPORT

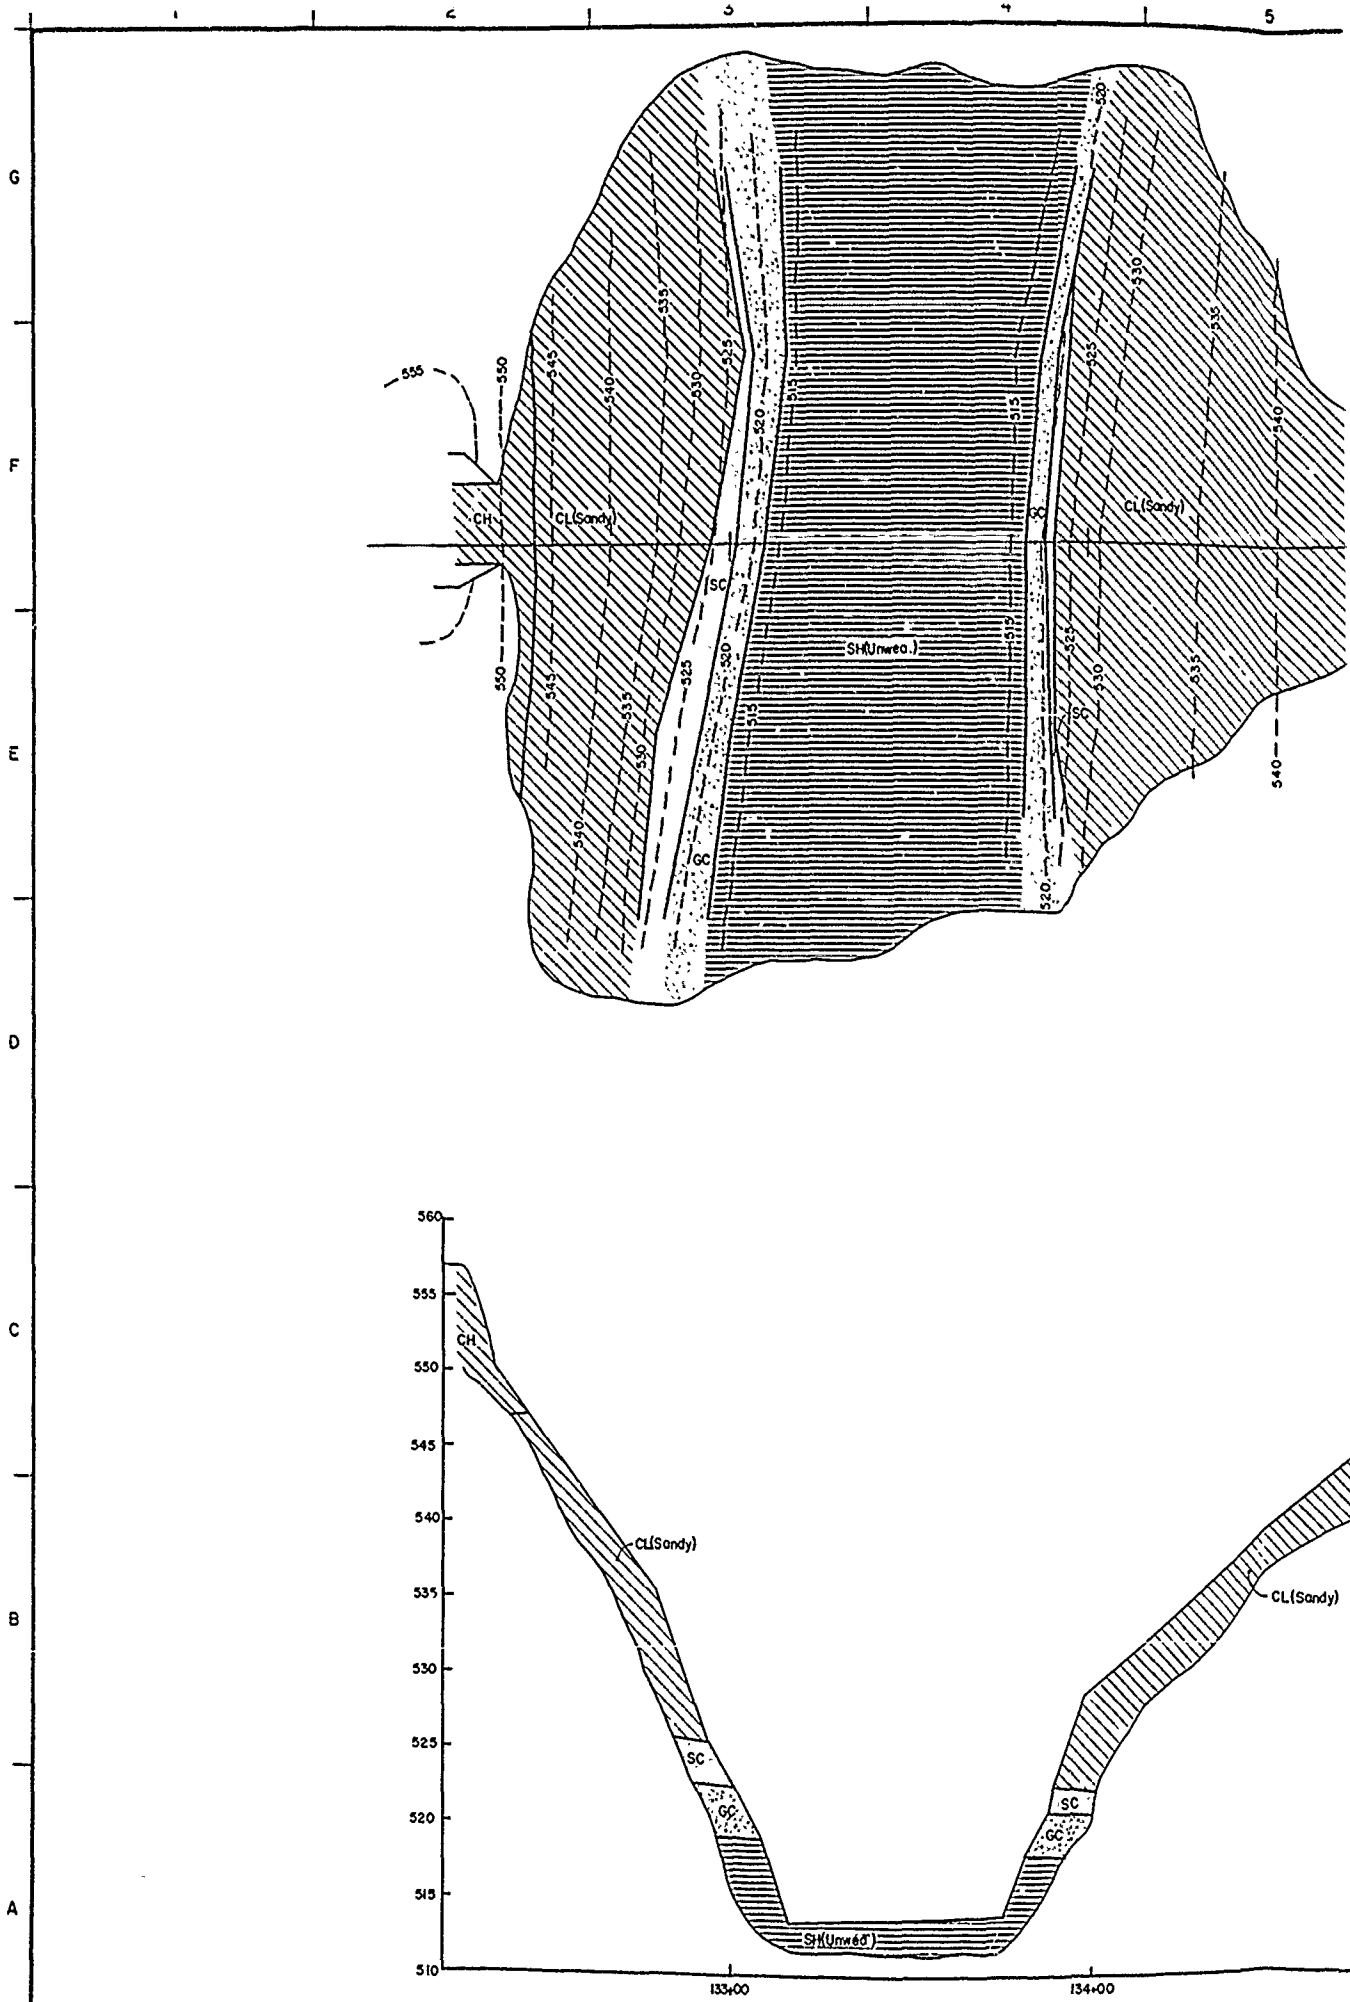

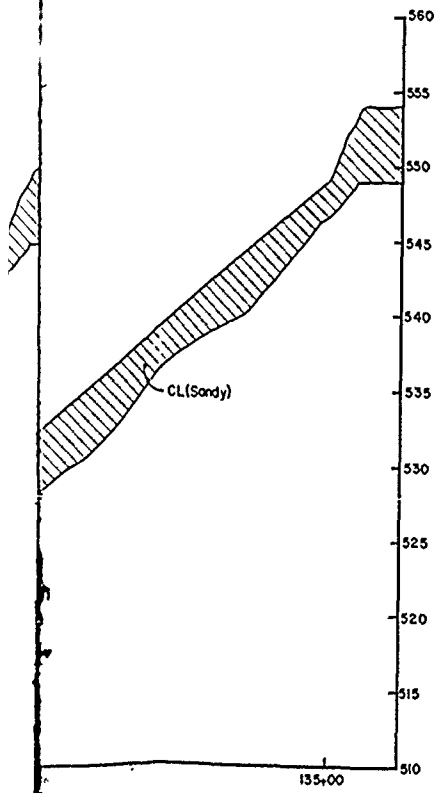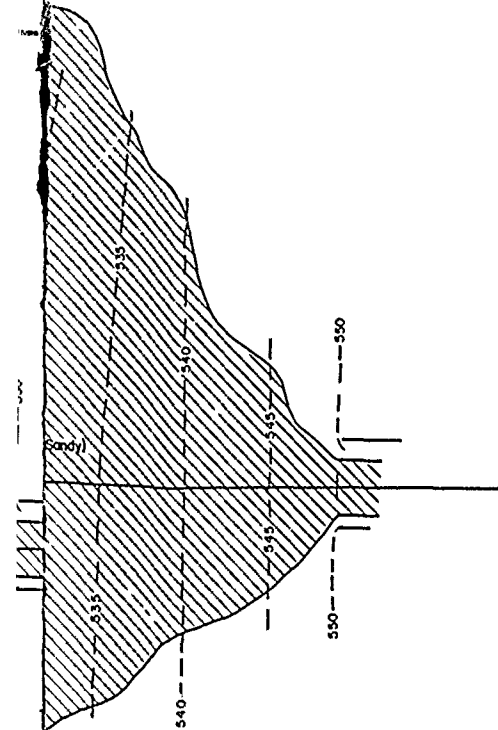
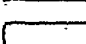



DESIGNED BY: H. BARNETT		RAY ROBERTS LAKE ELM FORK, TRINITY RIVER, TEXAS	
DRAWN BY: C. KIRBY		FOUNDATION REPORT INSPECTION TRENCH	
REVIEWED BY: R. BEHM		AS BUILT PLAN AND PROFILE STA. 132+35 TO 135+20	
SUBMITTED BY: ROBERT C BEHM		SOL. NO.	DATED:
ENGINEER:		CONTR. NO.	SHEET NO.
		DRAWING NUMBER	OF


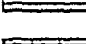
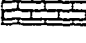
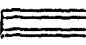

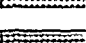

TO ACCOMPANY FOUNDATION REPORT


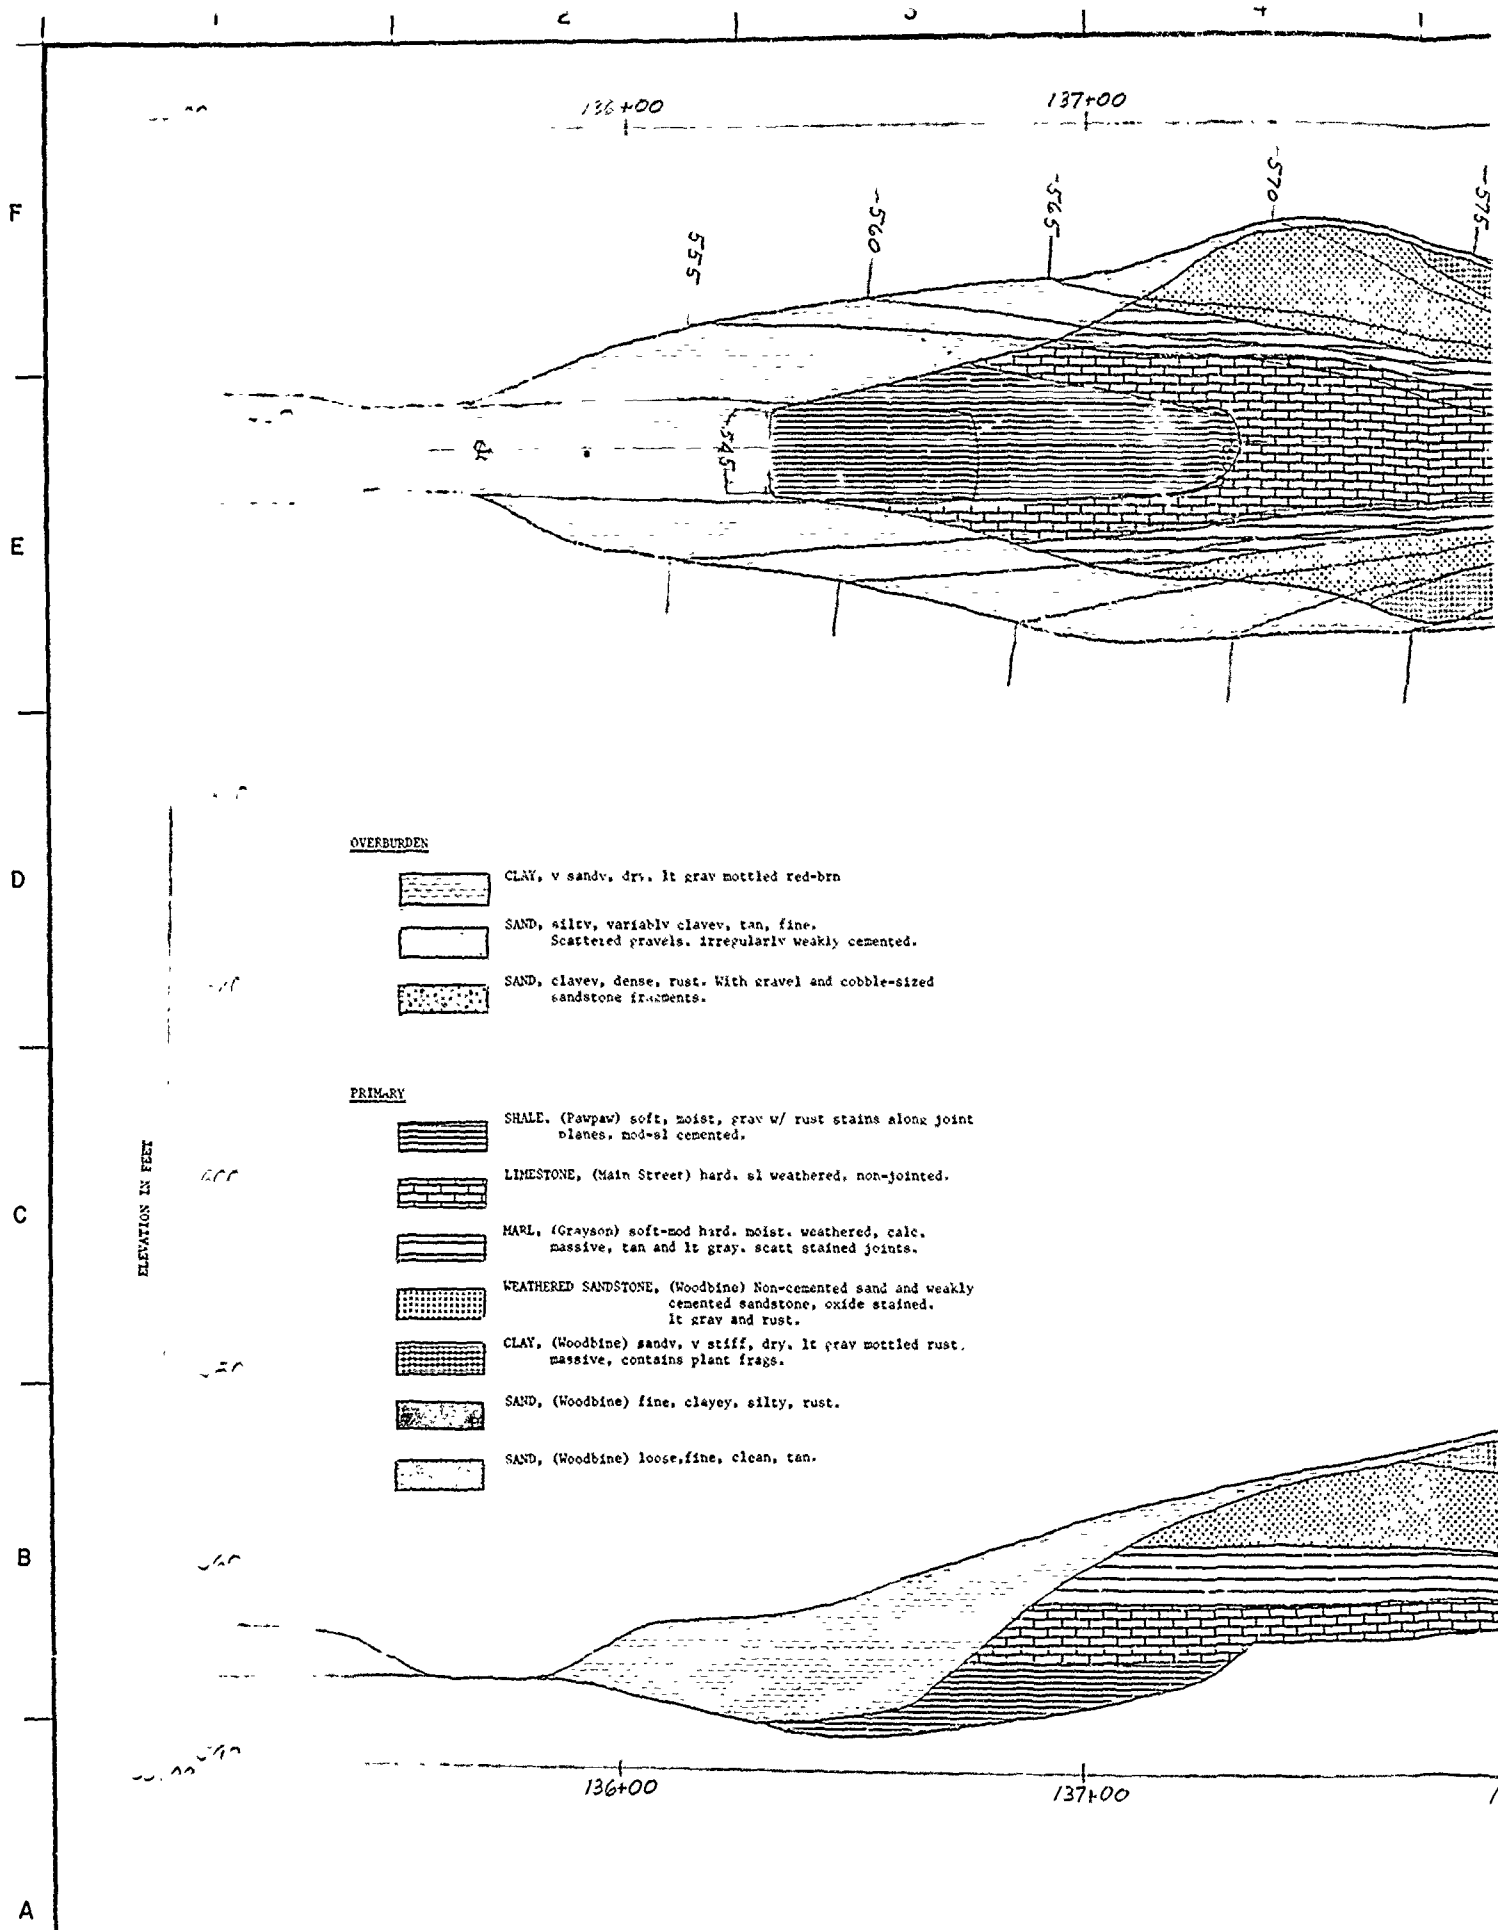


OVERBURDEN

-  CLAY, v sandv, dry. lt gray mottled red-brn
-  SAND, silty, variably clayey, tan, fine. Scattered gravels, irregularly weakly cemented.
-  SAND, clayey, dense, rust. With gravel and cobble-sized sandstone fragments.




PRIMARY

-  SHALE, (Pawpaw) soft, moist, gray w/ rust stains along joint planes, mod-sl cemented.
-  LIMESTONE, (Main Street) hard, sl weathered, non-jointed.
-  MARL, (Grayson) soft-mod hard, moist, weathered, calc. massive, tan and lt gray, scatt stained joints.
-  WEATHERED SANDSTONE, (Woodbine) Non-cemented sand and weakly cemented sandstone, oxide stained. lt gray and rust.
-  CLAY, (Woodbine) sandy, v stiff, dry, lt gray mottled rust. massive, contains plant frags.
-  SAND, (Woodbine) fine, clayey, silty, rust.
-  SAND, (Woodbine) loose, fine, clean, tan.

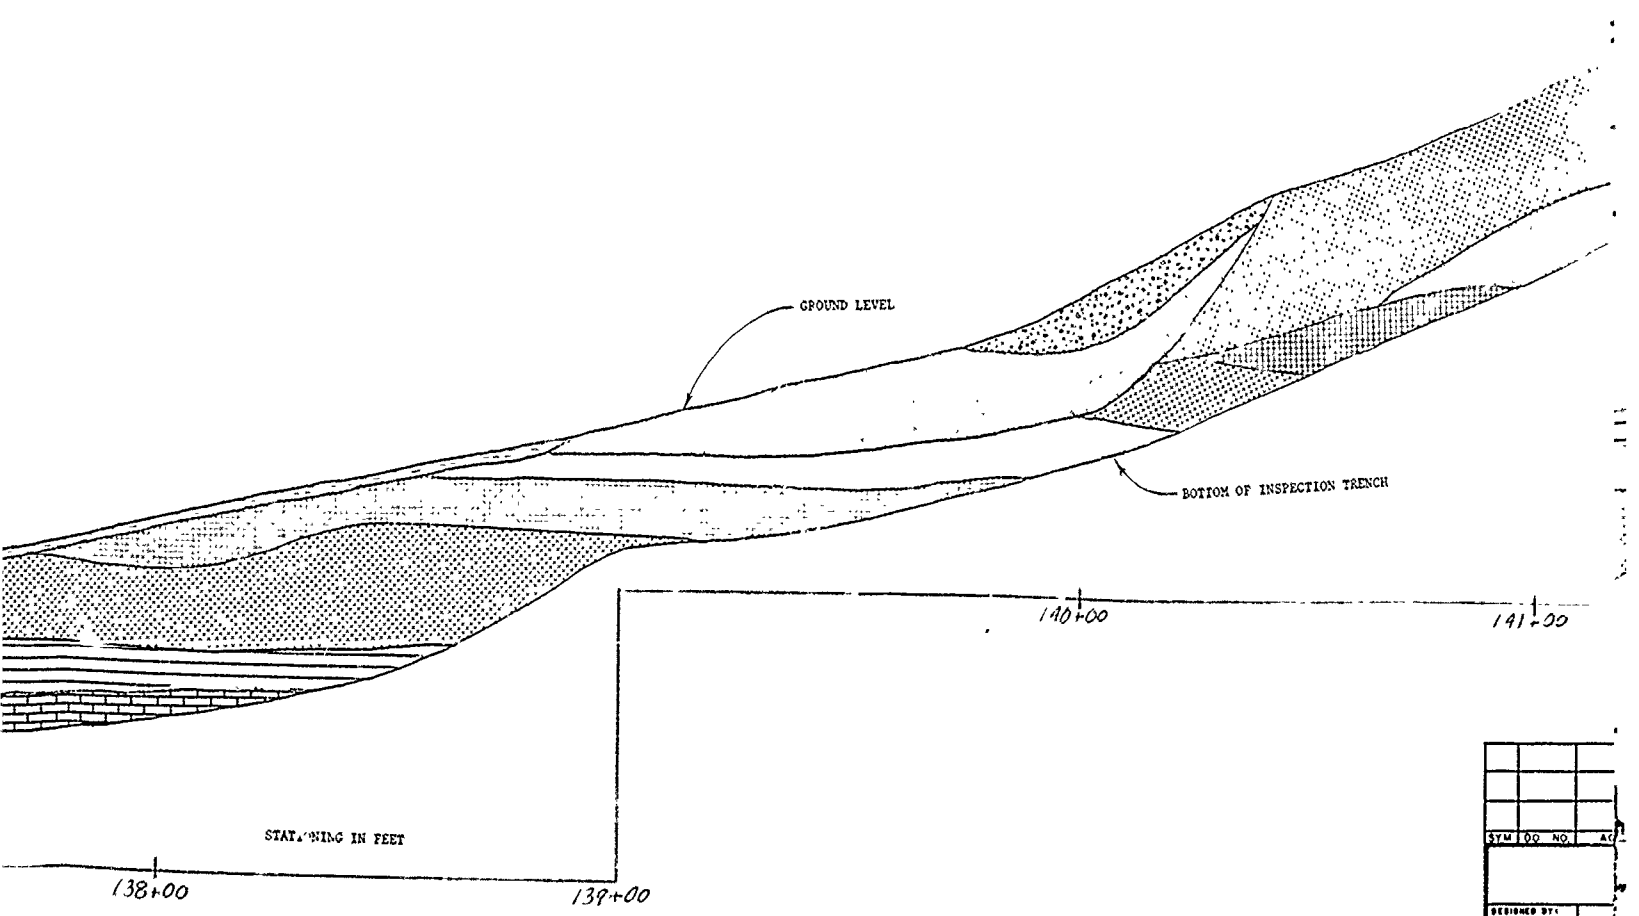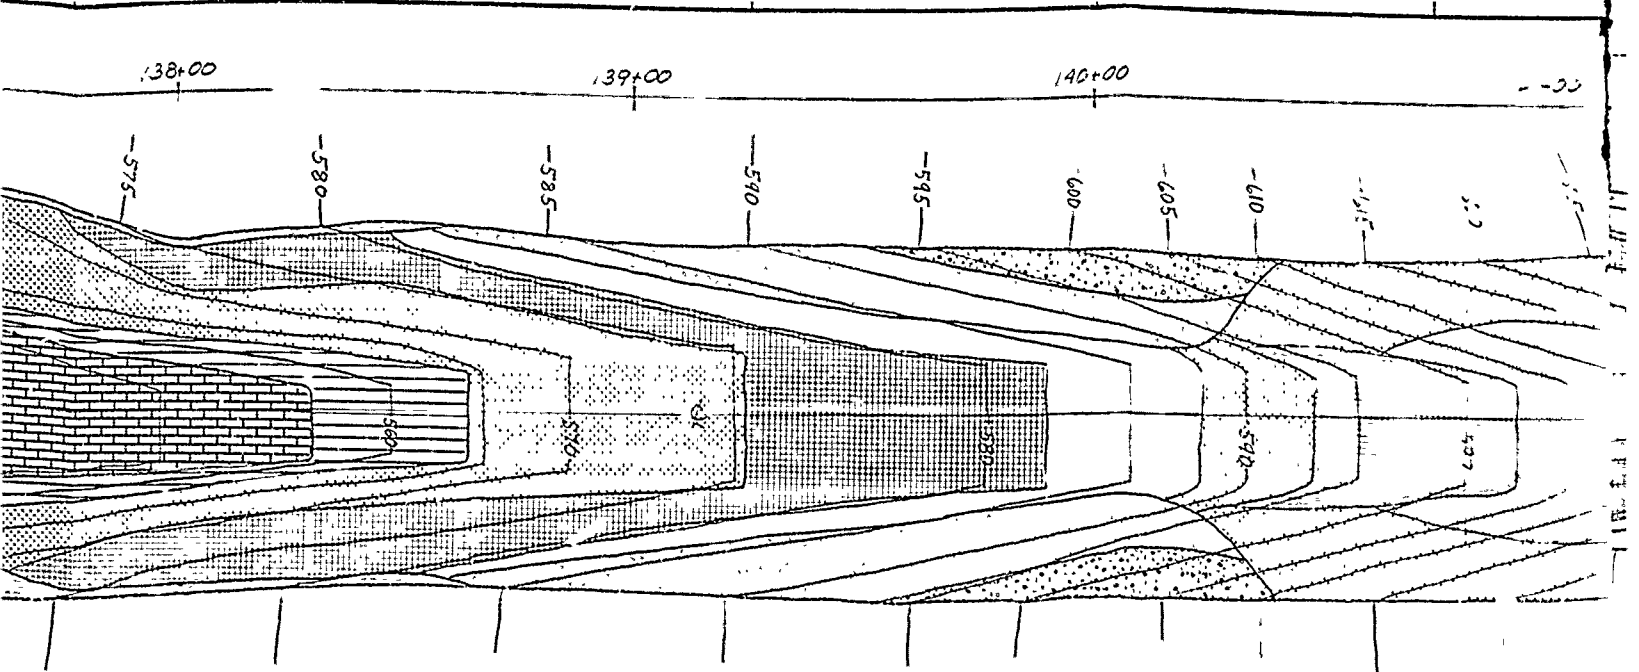


STATIONING IN FEET

DESIGNED BY:	R. HAGEN
DRAWN BY:	R. HAGEN
REVIEWED BY:	R. HAGEN

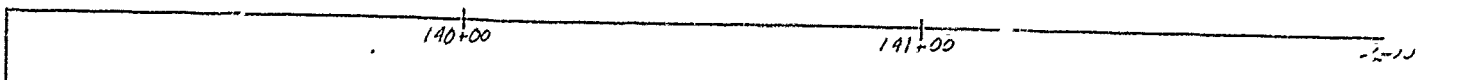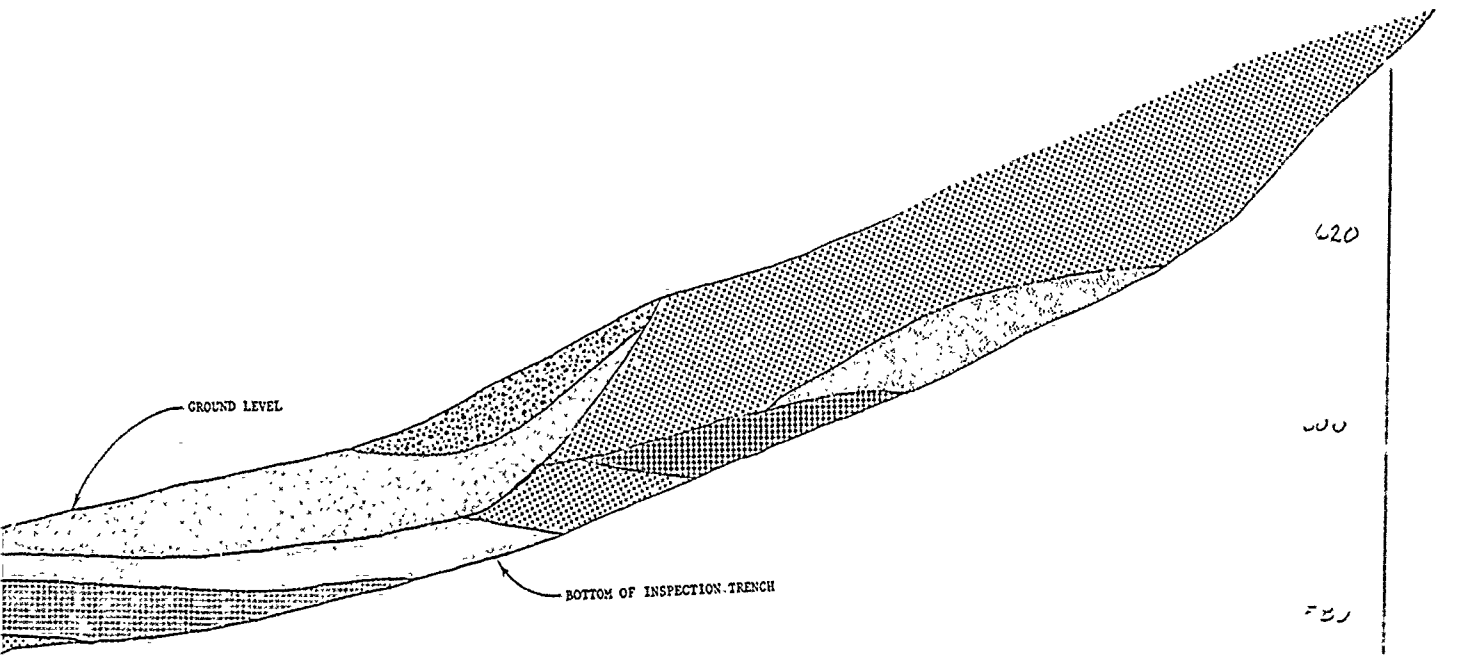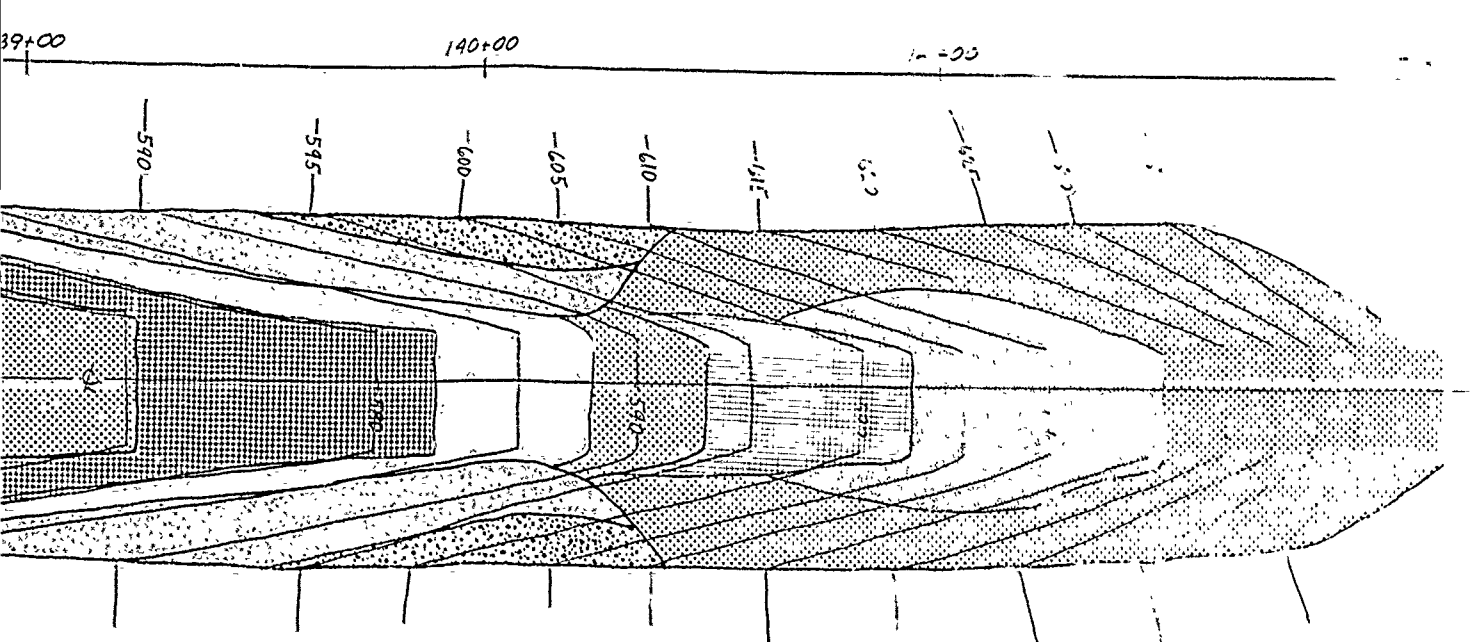

SYM	NO	NO	ACTION	DATE	DESCRIPTION OF REVISION
					U.S. ARMY ENGINEER DISTRICT, FORT WORTH CORPS OF ENGINEERS FORT WORTH, TEXAS
DESIGNED BY:	RAY ROBERTS LAKE ELM-FORK TRINITY RIVER, TEXAS				
DRAWN BY:	LEFT ABUTMENT INSPECTION TRENCH				
REVIEWED BY:	GEOLOGIC PLAN AND PROFILE STA. 135+00 TO STA. 142+00				
SUBMITTED BY:	ROBERT C. BEHAM			INVITATION NO.	DATE:

© DBM-1

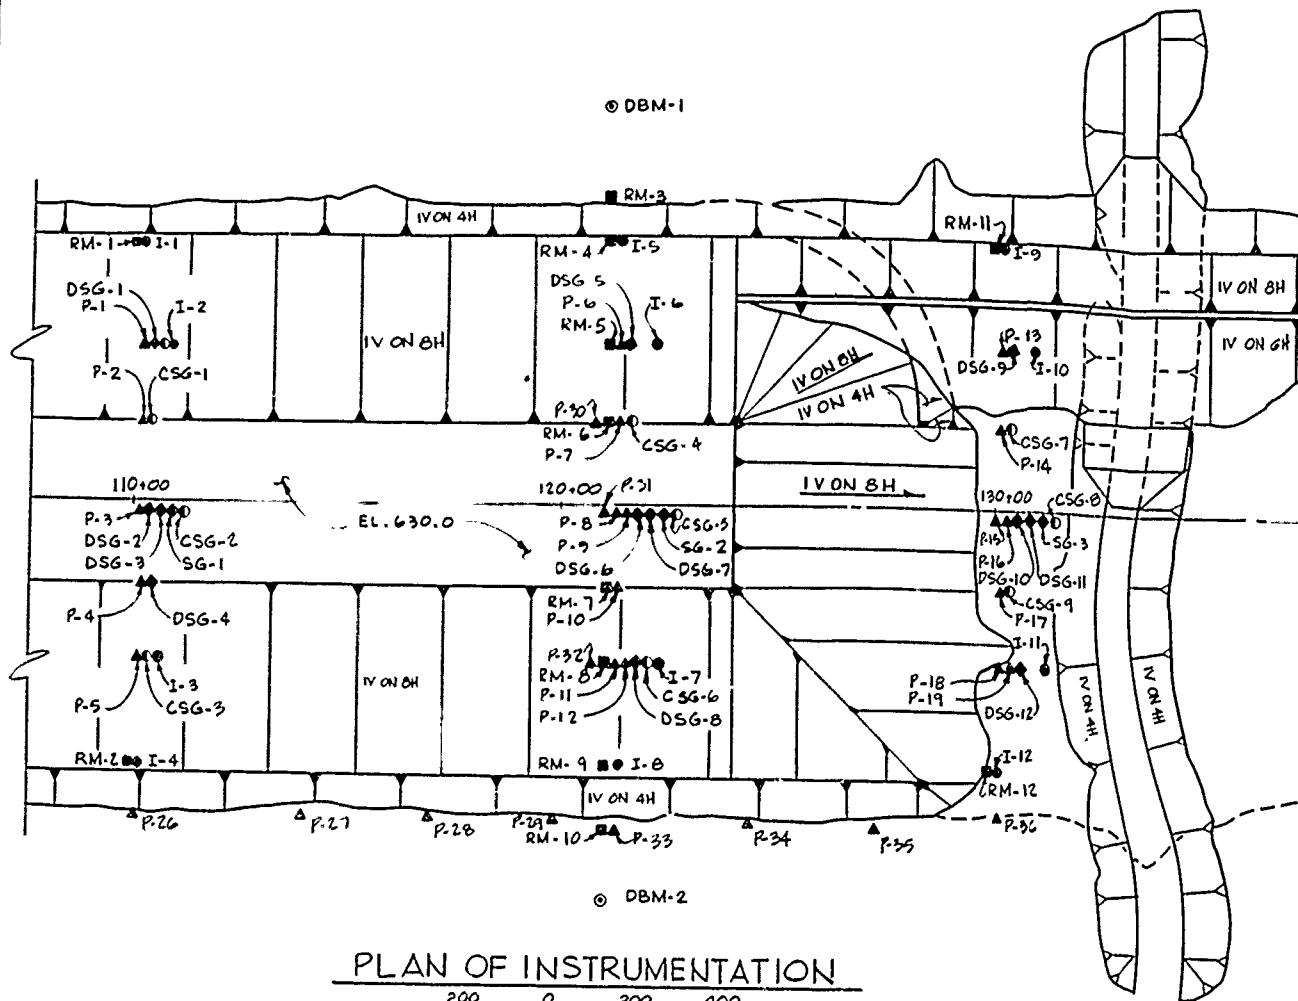

© DBM-2

PLAN OF INSTRUMENTATION

200 0 200 400
SCALE IN FEET




REFERENCE MARKS				
LINE	NO.	STATION	OFFSET	INSTALLATION SCHEDULE
A	RM-1	109+90.2	580.6 U/S	3
	RM-2	109+90.1	580.3 O/S	3
B	RM-3	120+89.4	579.6 U/S	1
	RM-4	120+90.3	579.1 U/S	3
	RM-5	120+90.7	350.0 U/S	3
	RM-6	120+90.7	350.0 U/S	3
	RM-7	120+90.3	351.1 O/S	3
C	RM-8	120+79.6	580.2 O/S	3
	RM-9	120+78.3	579.8 O/S	3
	RM-10	120+78.3	579.8 O/S	3
D	RM-11			3
	RM-12			3

POROUS PLASTIC TIP PIEZOMETERS						
LINE NO.	STATION	OFFSET	FILTER LOCATION	APPROX. FILTER EL. FT., MSL	INSTALLATION SCHEDULE	
A	P-1	110+15	349' U/S	WK CI	524-529	
	P-2	110+10	179' U/S	WK CI	529-534	
	P-3	110+10	24' O/S	WK CI	524-529	
	P-4	110+18	181' O/S	WK CI	525-530	
	P-5	110+10	350' O/S	WK CI	526-531	
B	P-6	121+10	350' U/S	WK CI	538-543	
	P-7	121+11	180' U/S	WK CI	538-543	
	P-8	121+01	24' O/S	WK CI	522-527	
	P-9	121+10	24' O/S	SH	492-496	
	P-10	121+10	180' O/S	WK CI	530-535	
	P-11	121+20	350' O/S	WK CI	536-541	
	P-12	121+10	350' O/S	SH	499-504	
C	P-13	129+99	351' U/S	WK CI	533-538	2
	P-14	130+11	112' U/S	WK CI	527-532	2
	P-15	130+00	24' O/S	WK CI	529-534	2
	P-16	130+10	24' O/S	SH	501-506	2
	P-17A	130+01	116' O/S	WK CI	526-531	2
	P-18	129+99	349' O/S	WK CI	524-529	2
	P-19	130+10	349' O/S	SH	499-504	2
SEEPAGE PIEZOMETERS	P-20	28+47	297' O/S	SD+GR	583-588	4
	P-21	32+46	299' O/S	SD+GR	581-586	4
	P-22	54+02	323' O/S	SD+GR	565-570	4
	P-23	63+00	327' O/S	SD+GR	565-570	4
	P-24	73+25	328' O/S	SD+GR	576-581	4
	P-25	85+07	320' O/S	SD+GR	576-581	4
	P-26	110+05	666' O/S	SD+GR	523-528	4
	P-27	114+00	678' O/S	SD+GR	521-526	4
	P-28	116+99	678' O/S	SD+GR	520-525	4
	P-29	119+99	678' O/S	SD+GR	518-523	4
	P-30	121+40	182' U/S	SD+GR	520-525	4
	P-31	120+40	26' O/S	SD+GR	512-518	4
P-32	121+00	345' O/S	SD+GR	524-529	4	
P-33	121+09	677' O/S	SD+GR	518-523	4	
P-34	124+30	675' O/S	SD+GR	520-525	4	
P-35	127+29	672' O/S	SD+GR	521-526	4	
P-36	130+10	675' O/S	SD+GR	522-527	4	

SETTLEMENT			
LINE NO.	STATION	OFF.	
A	DSG-1	110+30	350
	DSG-2	110+20	24
	DSG-3	110+30	24
	SG-1	110+50	25
DSG-4	110+20	350	
B	DSG-5	121+20	350
	DSG-6	121+20	24
	DSG-7	121+40	24
	SG-2	121+31	25
DSG-8	121+30	350	
C	DSG-9	130+09	351
	DSG-10	130+19	24
	SG-3	130+40	24
	DSG-11	130+19	350

POROUS PLASTIC TIP P			
LINE NO.	STATION	OFFSET	L
P-14B	130+07	120' U/S	5
P-31	137+62	104' U/S	
P-35	137+59	361' O/S	
P-39	137+58	621' O/S	
P-40	139+06	107' O/S	
P-41	139+04	565' O/S	
P-42	140+53	326' O/S	
P-43	141+41	92' O/S	
P-43B	141+39	95' O/S	

AF 10188A (3)

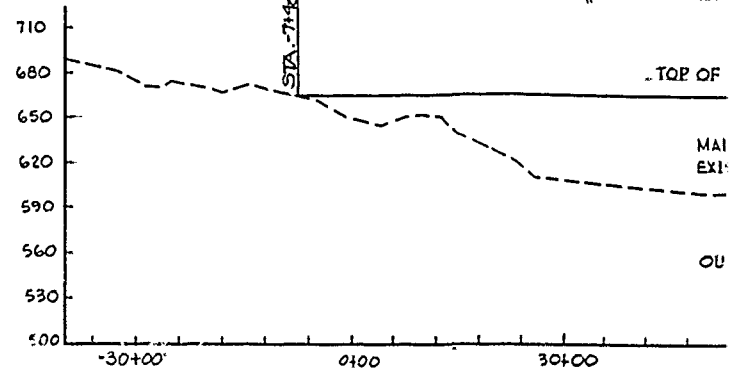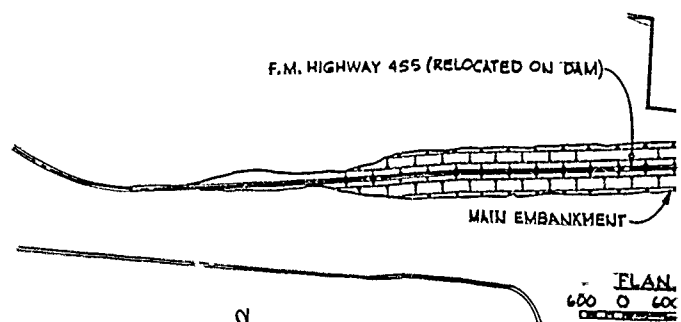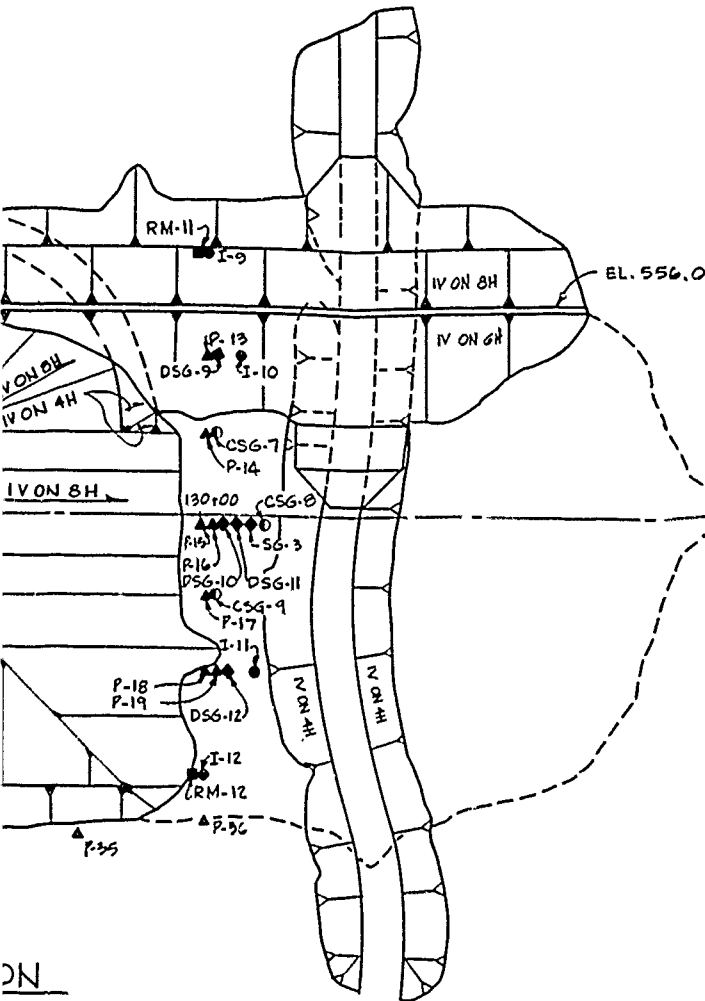

PER TION	APPROX. FILTER EL. FT., MSL	INSTALLATION SCHEDULE
CI	524-529	
CI	529-534	
CI	524-529	
CI	525-530	
CI	526-531	
CI	530-535	
CI	530-535	
CI	522-527	
CI	490-495	
CI	630-635	
CI	536-541	
H	499-504	
CI	533-538	2
CI	527-532	2
CI	524-529	2
CI	501-506	2
CI	526-531	2
CI	524-529	2
CI	499-504	2
GR	583-588	4
GR	581-586	4
GR	585-590	4
GR	585-590	4
GR	576-581	4
GR	576-581	4
GR	523-528	4
GR	521-526	4
GR	520-525	4
GR	513-518	4
GR	524-529	4
GR	518-523	4
GR	520-525	4
GR	521-526	4
GR	522-527	4

SETTLEMENT GAGES					
LINE	NO.	STATION	OFFSET	APPROX. PLATE EL.	INSTALLATION SCHEDULE
A	DSG-1	110+30	350' U/S	536	
	DSG-2	110+20	24' D/S	503	
	DSG-3	110+30	24' D/S	526	
	DSG-4	110+50	25' D/S	560	
	DSG-5	110+20	550' D/S	527	
B	DSG-6	121+20	350' U/S	540	
	DSG-7	121+20	24' D/S	526	
	DSG-8	121+40	24' D/S	508	
	DSG-9	121+31	25' D/S	527	
	DSG-10	121+30	350' D/S	540	
C	DSG-11	130+07	351' U/S	536	2
	DSG-12	130+19	24' D/S	532	2
	DSG-13	130+27	24' D/S	516	2
	DSG-14	130+40	24' U/S	558	2
DSG-15	130+19	350' D/S	526	2	

INCLINOMETERS					
LINE	NO.	STATION	OFFSET	APPROX. BOTTOM	INSTALLATION SCHEDULE
A	I-1	110+10	580' U/S	490	
	I-2	110+30	350' U/S	490	
	I-3	110+30	350' D/S	480	
	I-4	110+20	580' D/S	488	
B	I-5	121+10	580' U/S	500	
	I-6	121+30	350' U/S	498	
	I-7	121+50	350' D/S	494	
	I-8	121+10	580' D/S	494	
C	I-9	130+10	580' U/S	490	2
	I-10	130+30	350' U/S	496	2
	I-11	130+40	350' D/S	494	2
	I-12	130+10	580' D/S	494	2

- INSTALLATION SCHEDULE**
- AFTER STRIPPING STAK
 - AFTER STRIPPING STA
 - AS EMBANKMENT REA ELEVATION AT THIS ST OFFSET (BEFORE TOP)
 - AFTER ENTIRE EMB TOPPED-OUT

- LEGEND**
- ▲ PIEZOMETER
 - ◆ SETTLEMENT GAGE
 - COLLAPSIBLE SETTLE
 - INCLINOMETER
 - REFERENCE MARK
 - ⊙ BENCHMARK

POROUS PLASTIC TIP PIEZOMETERS (CONT.)						
LINE	NO.	STATION	OFFSET	FILTER LOCATION	APPROX. FILTER EL. FT., MSL	INSTALLATION SCHEDULE
A	P-14	130+07	120' U/S	SD & CI		
	P-31	137+62	104' U/S	SD		
	P-38	137+59	36' D/S			
	P-37	137+58	62' D/S			
	P-40	139+06	107' D/S	SD & CI		
	P-41	139+04	565' D/S	SD		
	P-42	140+53	326' D/S	SD		
B	P-43A	141+41	92' D/S	SD		
	P-43B	141+39	95' D/S	SD		


COLLAPSIBLE SETTLEMENT GAGES					
LINE	NO.	STATION	OFFSET	APPROX. BOTTOM	INSTALLATION SCHEDULE
A	CSG-1	110+20	180' U/S	490	
	CSG-2	110+50	24' U/S	480	
	CSG-3	110+40	350' D/S	480	
B	CSG-4	121+20	180' U/S	496	
	CSG-5	121+60	24' D/S	486	
	CSG-6	121+40	350' D/S	494	
C	CSG-7	130+20	180' U/S	496	2
	CSG-8	130+60	24' D/S	486	2
	CSG-9	130+20	180' D/S	494	2

DEEP BENCHMARK				
LINE	NO.	STATION	OFFSET	APPR. BOTTM
B	BM-1	21+00	380' D/S	500
B	BM-2	121+00	380' D/S	490
B	BM-3	143+00	50' D/S	650


PRO

1200
60


SEE EMBANKMENT INSTRUMENTATION PLAN THIS SEQUENCE

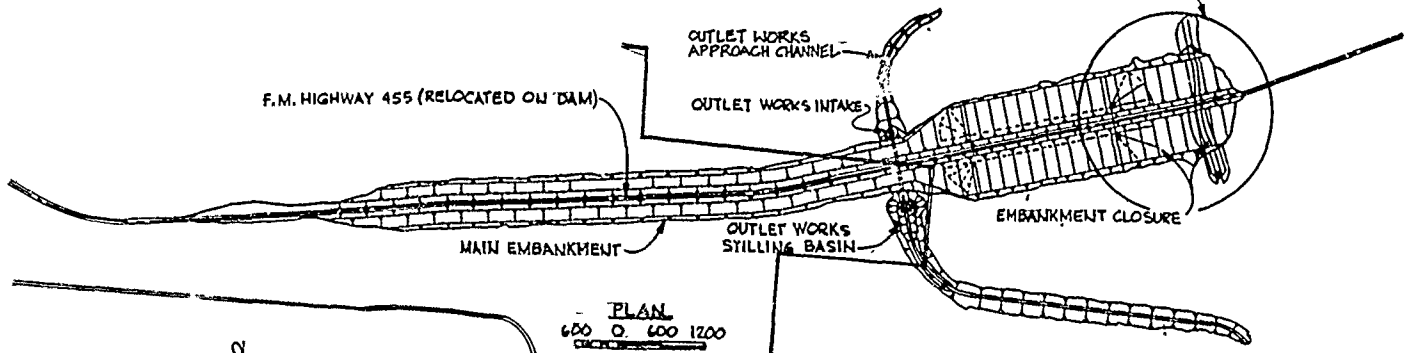

PLAN
600 O. 600 1200

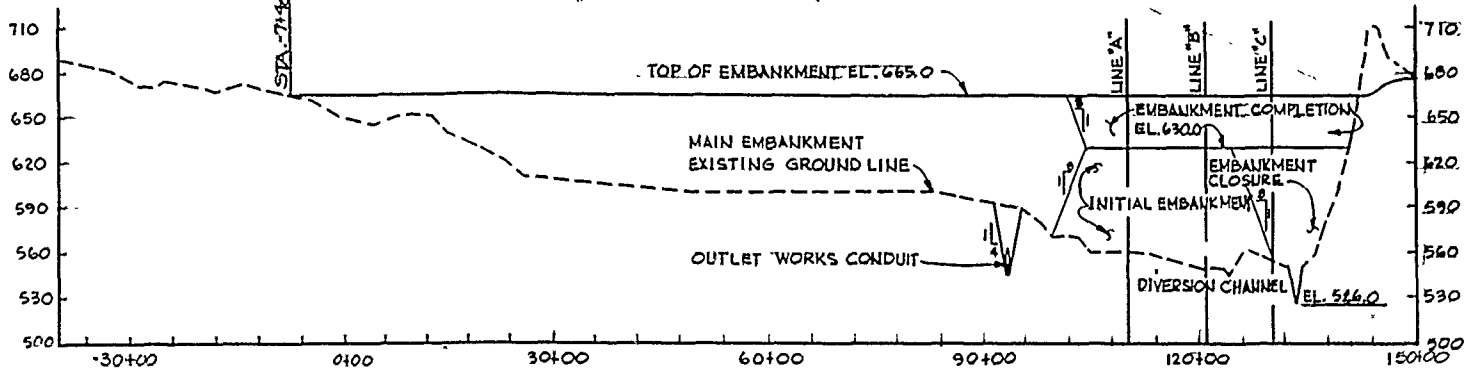

PROFILE

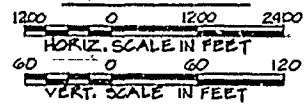

INCLINOMETERS					
LINE	NO.	STATION	OFFSET	APPROX. BOTTOM	INSTALLATION SCHEDULE
A	I-1	110+10	580' U/S	490	1
	I-2	110+30	350' U/S	490	1
	I-3	110+30	350' D/S	480	1
	I-4	110+20	580' D/S	488	1
B	I-5	121+10	580' U/S	500	1
	I-6	121+30	350' U/S	498	1
	I-7	121+50	350' D/S	494	1
	I-8	121+10	580' D/S	494	1
C	I-9	130+10	580' U/S	490	2
	I-10	130+30	350' U/S	496	2
	I-11	130+60	350' D/S	494	2
	I-12	130+20	580' D/S	494	2

INSTALLATION SCHEDULE LEGEND

- AFTER STRIPPING STAGE I
- AFTER STRIPPING STAGE III C
- AS EMBANKMENT REACHES FINISHED ELEVATION AT THIS STATION AND OFFSET (BEFORE TOPSOIL).
- AFTER ENTIRE EMBANKMENT IS TOPPED-OUT

LEGEND

- ▲ PIEZOMETER
- ◆ SETTLEMENT GAGE
- ◇ COLLAPSIBLE SETTLEMENT GAGE
- ⊖ INCLINOMETER
- REFERENCE MARK
- ⊙ BENCHMARK

COLLAPSIBLE SETTLEMENT GAGES					
LINE	NO.	STATION	OFFSET	APPROX. BOTTOM	INSTALLATION SCHEDULE
A	CS4-1	110+20	180' U/S	490	1
	CS4-2	110+50	24' U/S	480	1
	CS4-3	110+40	320' D/S	480	1
B	CS4-4	121+20	180' U/S	496	1
	CS4-5	121+60	24' D/S	486	1
	CS4-6	121+40	350' D/S	494	1
C	CS4-7	130+20	180' U/S	496	2
	CS4-8	130+60	24' D/S	486	2
	CS4-9	130+20	180' D/S	494	2

DEEP BENCHMARK					
LINE	NO.	STATION	OFFSET	APPROX. BOTTOM EL.	INSTALLATION SCHEDULE
B	DB1	121+00	380' D/S	500	1
B	DB2	121+00	380' D/S	490	1
C	DB3	143+00	50' D/S	650	1


NOTES:





- FOR SECTION THRU LINE A, SEE SEQ. NO. 44
- FOR SECTION THRU LINE B, SEE SEQ. NO. 45
- FOR SECTION THRU LINE C, SEE SEQ. NO. 46
- ALL INSTRUMENT ELEVATIONS ARE APPROXIMATE. ACTUAL ELEVATIONS WILL BE DETERMINED AT TIME OF INSTALLATION.
- ALL INSTRUMENTATION WILL HAVE PROTECTIVE FENCE, EXCEPT THOSE ALONG THE DOWNSTREAM CREST. FOR PROTECTIVE FENCE DETAILS, SEE SEQ. 41

RECORD DRAWING-WORK AS-BUILT

10182 2000000 304884 REVISD TO REFLECT AS-BUILT CHANGES 10182 2000000 304884 REVISD TO REFLECT AS-BUILT CHANGES			
DESIGNED BY	RAY ROBERTS LAKE		
DESIGNED BY	ELM FORK, TRINITY RIVER, TEXAS		
DESIGNED BY	CORPS OF ENGINEERS FORT WORTH, TEXAS		
DESIGNED BY	A. BRANCH		
DRAWN BY	J. FIESLER		
REVIEWED BY	A. BRANCH		
SUBMITTED BY	H. KARBS		
ENGINEER	INVITATION NO. DACW63-82-B-0026 DATE: MAR. 1982		
	CONTRACT NO. DACW63-82-C-0093		SEQUENCE NO.
	DRAWING NUMBER		SHEET NO.
			62

G
F
E
D
C
B
A

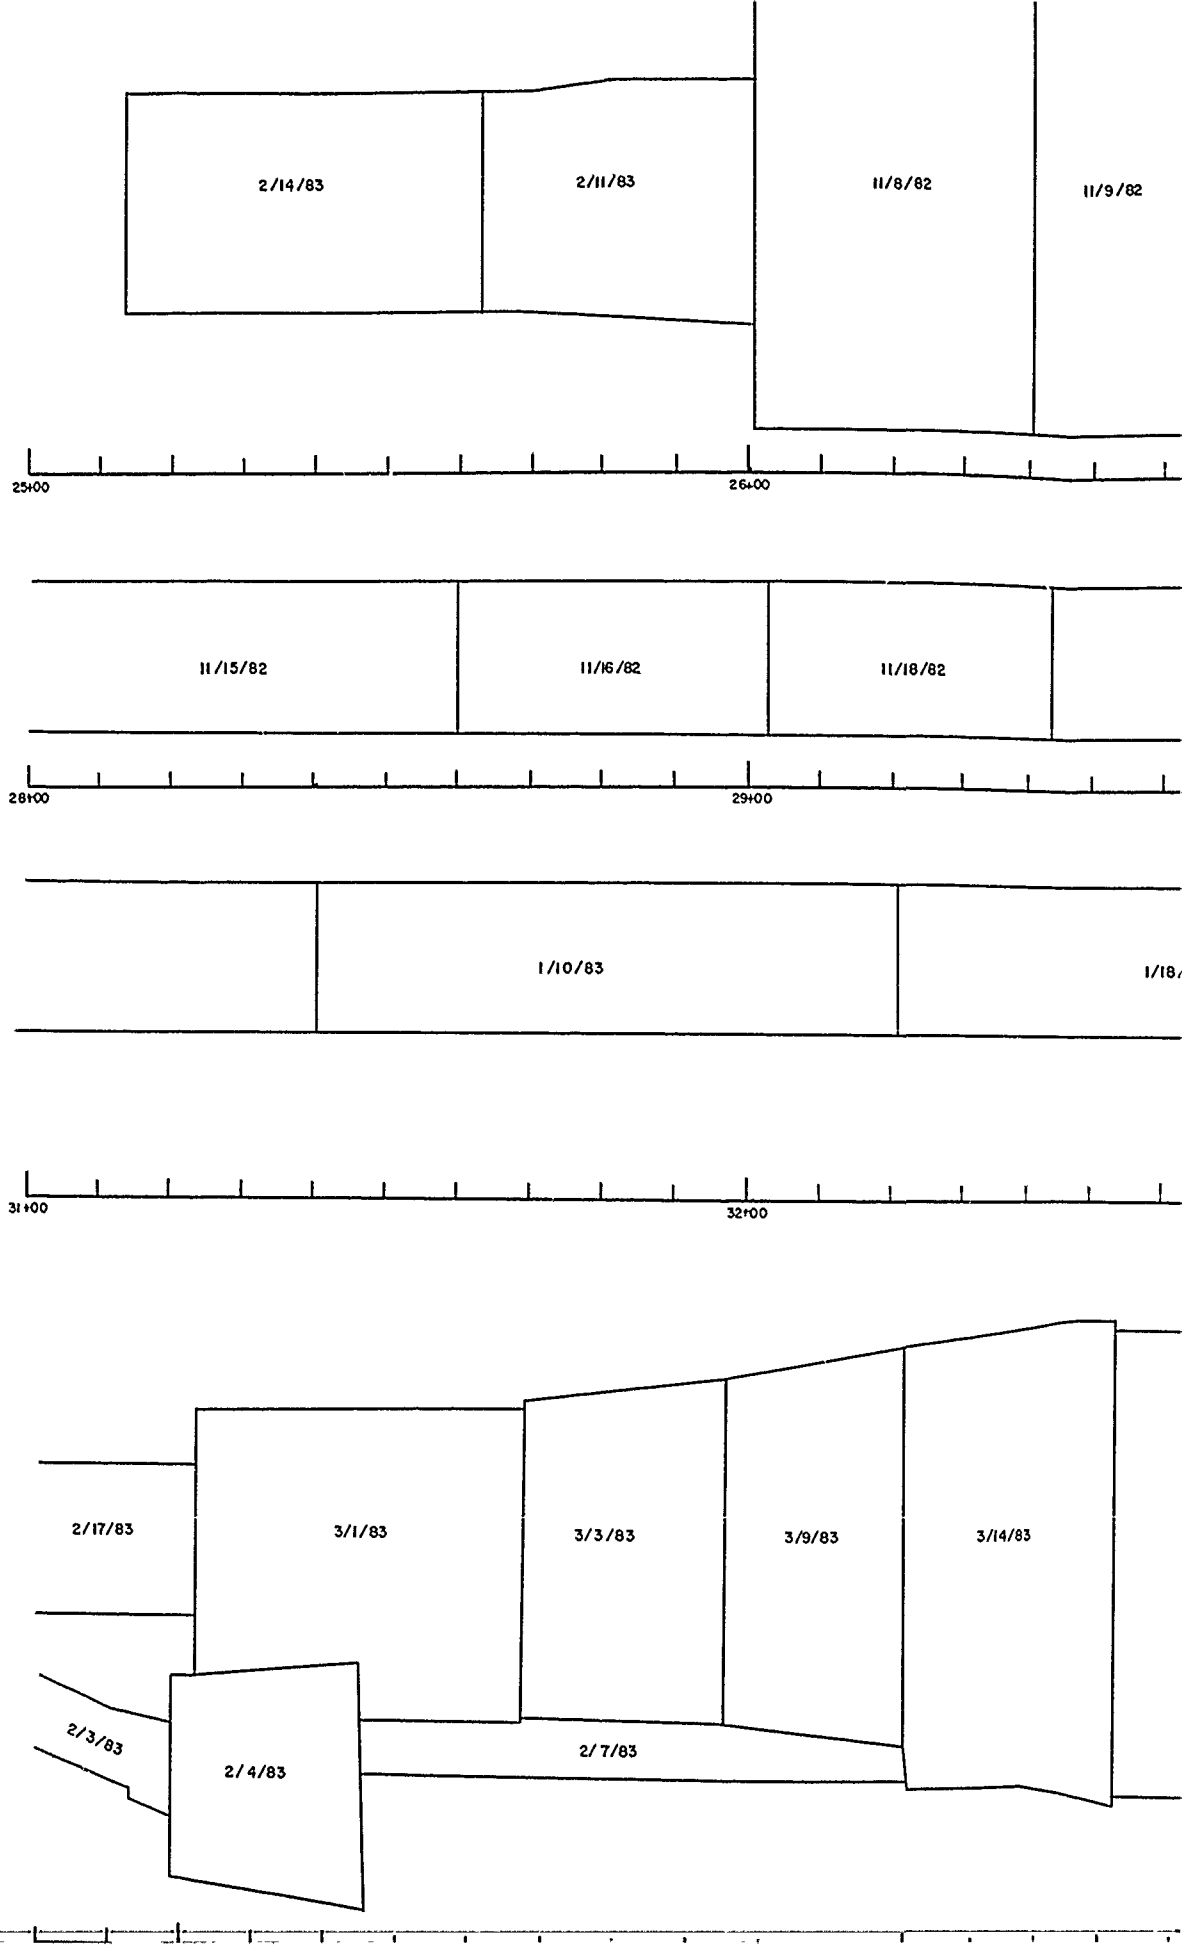

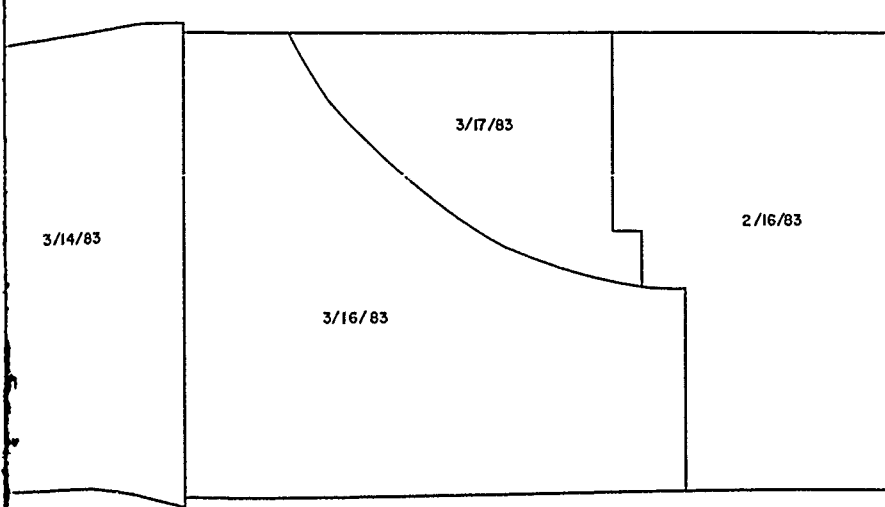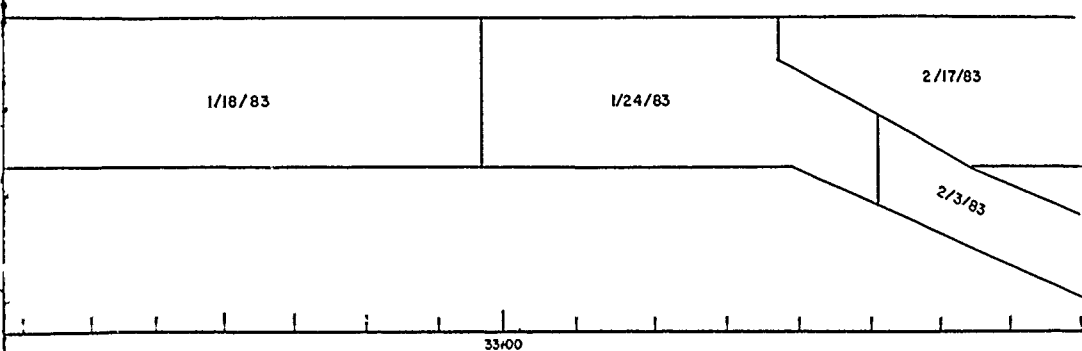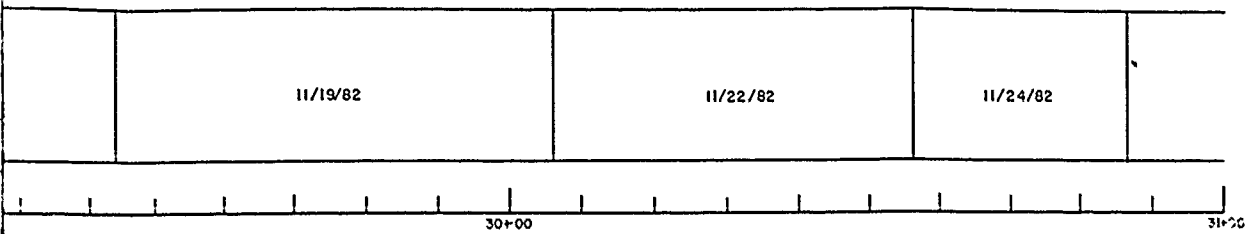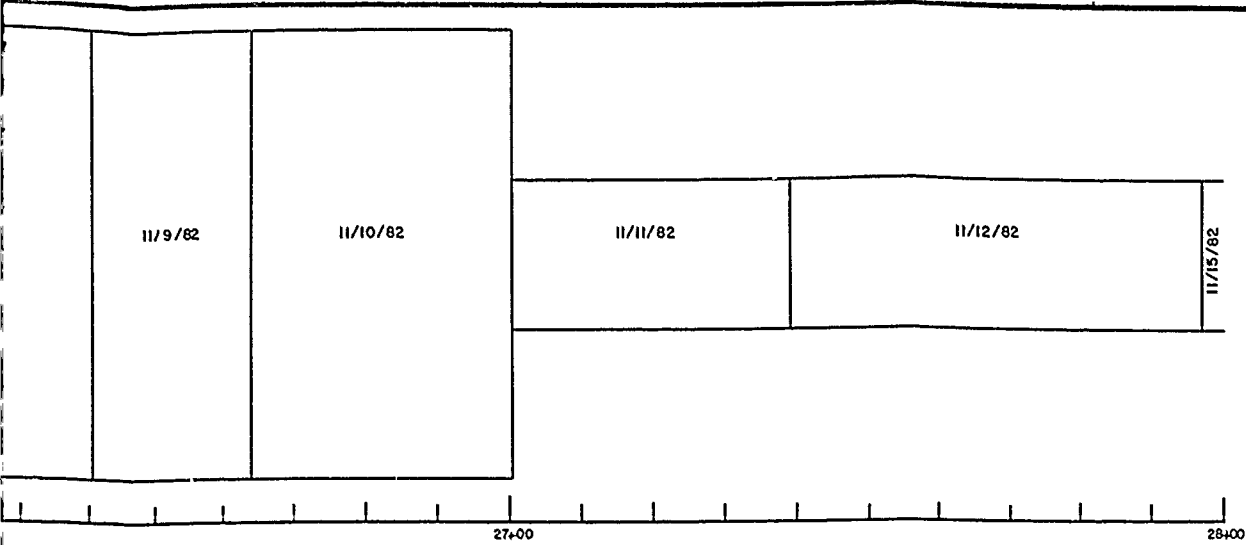

DESIGNED BY: HBARNETT		U.S. ARMY ENGINEER DISTRICT, FORT WORTH CORPS OF ENGINEERS FORT WORTH, TEXAS RAY ROBERTS LAKE ELM FORK, TRINITY RIVER, TEXAS FOUNDATION REPORT RECORD OF FOUNDATION APPROVAL
DRAWN BY: C. KIRBY		
REVIEWED BY: R. BEHM		
DATE: _____		