

AD-A077 425

NEW YORK STATE DEPT OF ENVIRONMENTAL CONSERVATION ALBANY F/G 13/13
NATIONAL DAM SAFETY PROGRAM. HIGINBOTHAM BROOK WATERSHED PROJEC--ETC(U)
SEP 79 @ KOCH DACW51-79-C-0001


UNCLASSIFIED

NL

1 OF 2

AD
A077425



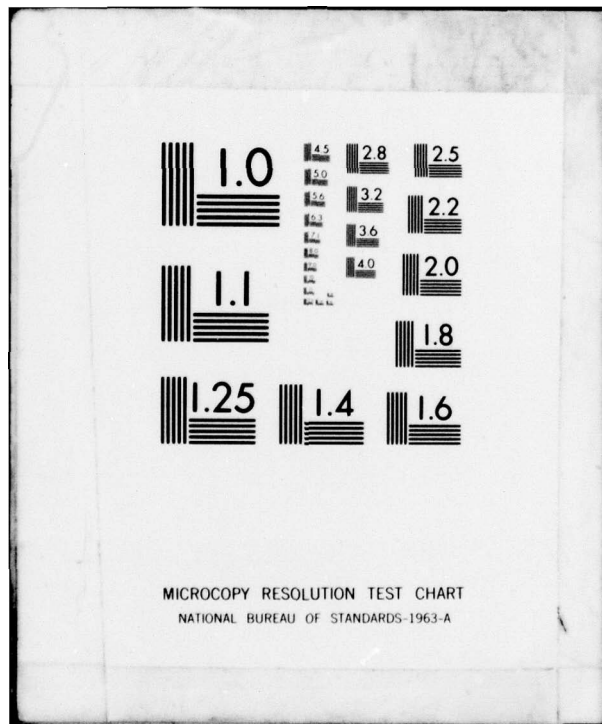

LEVEL 1 (8) B.S.

SECURITY CLASSIFICATION OF THIS PAGE (When Data Entered)

REPORT DOCUMENTATION PAGE

READ INSTRUCTIONS BEFORE COMPLETING FORM

1. REPORT NUMBER		2. GOVT ACCESSION NO.	3. RECIPIENT'S CATALOG NUMBER
4. TITLE (and Subtitle) Phase I Inspection Report Higinbotham Brook Watershed Project Oswego River Basin, Madison County, New York Inventory No. 703		5. TYPE OF REPORT & PERIOD COVERED Phase I Inspection Report National Dam Safety Program	
7. AUTHOR(s) George Koch P.E.		8. CONTRACT OR GRANT NUMBER(s) DACW-51-79-C-0001	
9. PERFORMING ORGANIZATION NAME AND ADDRESS New York State Department of Environmental Conservation/ 50 Wolf Road Albany, New York 12233		10. PROGRAM ELEMENT, PROJECT, TASK AREA & WORK UNIT NUMBERS	
11. CONTROLLING OFFICE NAME AND ADDRESS New York State Department of Environmental Conservation/ 50 Wolf Road Albany, New York 12233		12. REPORT DATE 25 September 1979	
14. MONITORING AGENCY NAME & ADDRESS (if different from Controlling Office) Department of the Army 26 Federal Plaza/ New York District, Coff New York, New York 10007		13. NUMBER OF PAGES	
		15. SECURITY CLASS. (of this report) UNCLASSIFIED	
		15a. DECLASSIFICATION/DOWNGRADING SCHEDULE	
16. DISTRIBUTION STATEMENT (of this Report) Approved for public release; Distribution unlimited.			
17. DISTRIBUTION STATEMENT (of this Report) National Dam Safety Program, Higinbotham Brook Watershed Project (Inventory Number NY703). Oswego River Basin, Madison County, New York. Phase I Inspection Report,			
18. SUPPLEMENTARY NOTES			
19. KEY WORDS (Continue on reverse side if necessary and identify by block number) Dam Safety National Dam Safety Program Visual Inspection Hydrology, Structural Stability Higinbotham Brook Watershed Project Madison County			
20. ABSTRACT (Continue on reverse side if necessary and identify by block number) This report provides information and analysis on the physical condition of the dam as of the report date. Information and analysis are based on visual inspection of the dam by the performing organization. The examination of documents and visual inspection of the Higinbotham Brook dams and appurtenant structures did not reveal conditions which constitute a hazard to human life or property. (over)			

AD A 077425

DDC FILE COPY

DDC RECEIVED NOV 30 1979

393970

13

(cont) → The total discharge capacity of the spillways is adequate for the Probable Maximum Flood (PMF).

The following remedial actions are required during this construction season:

- (1) Repair the erosion areas on and in the vicinity of Dam 1. Seed and mulch all unprotected areas to establish erosion resistant vegetation;
- (2) Repair the eroded areas in the downstream channel;
- (3) Periodically monitor the slopes in the reservoir area and repair as required;
- (4) Provide a program of seeding and mulching of all earth surfaces on the dams and in the reservoir area to establish erosion protection material. If vegetation cannot resist long term erosion action, an alternate method may be required; and
- (5) Provide a program of periodic inspection and maintenance of the dams and appurtenances. This program must include yearly operation and lubrication of the reservoir drain system. Document this information for future reference;
- (6) Develop an emergency action plan.

THIS DOCUMENT IS BEST QUALITY PRACTICABLE.
THE COPY FURNISHED TO DDC CONTAINED A
SIGNIFICANT NUMBER OF PAGES WHICH DO NOT
REPRODUCE LEGITELY.

DISCLAIMER NOTICE

**THIS DOCUMENT IS BEST QUALITY
PRACTICABLE. THE COPY FURNISHED
TO DDC CONTAINED A SIGNIFICANT
NUMBER OF PAGES WHICH DO NOT
REPRODUCE LEGIBLY.**

PREFACE

This report is prepared under guidance contained in the Recommended Guidelines for Safety Inspection of Dams, for Phase I Investigations. Copies of these guidelines may be obtained from the Office of Chief of Engineers, Washington, D.C. 20314. The purpose of a Phase I Investigation is to identify expeditiously those dams which may pose hazards to human life or property. The assessment of the general condition of the dam is based upon available data and visual inspections. Detailed investigation, and analyses involving topographic mapping, subsurface investigations, testing, and detailed computational evaluations are beyond the scope of a Phase I Investigation; however, the investigation is intended to identify any need for such studies.

In reviewing this report, it should be realized that the reported condition of the dam is based on observations of field conditions at the time of inspection along with data available to the inspection team. In cases where the reservoir was lowered or drained prior to inspection, such action, while improving the stability and safety of the dam, removes the normal load on the structure and may obscure certain conditions which might otherwise be detectable if inspected under the normal operating environment of the structure.

It is important to note that the condition of a dam depends on numerous and constantly changing internal and external conditions, and is evolutionary in nature. It would be incorrect to assume that the present condition of the dam will continue to represent the condition of the dam at some point in the future. Only through frequent inspections can unsafe conditions be detected and only through continued care and maintenance can these conditions be prevented or corrected.

Phase I inspections are not intended to provide detailed hydrologic and hydraulic analyses. In accordance with the established Guidelines, the Spillway Test flood is based on the estimated "Probable Maximum Flood" for the region (greatest reasonably possible storm runoff), or fractions thereof. Because of the magnitude and rarity of such a storm event, a finding that a spillway will not pass the test flood should not be interpreted as necessarily posing a highly inadequate condition. The test flood provides a measure of relative spillway capacity and serves as an aide in determining the need for more detailed hydrologic and hydraulic studies, considering the size of the dam, its general condition and the downstream damage potential.

Accession For	<input checked="" type="checkbox"/>
NTIS GAMA	<input type="checkbox"/>
DDC TAB	<input type="checkbox"/>
Unannounced	
Justification	
By	
Dissemination/	
Availability Order	
1st	1st
Special	Special

AP 23

OSWEGO RIVER BASIN
HIGINBOTHAM BROOK WATERSHED PROJECT
NY 703
DEC #103C-4286
PHASE I INSPECTION REPORT

TABLE OF CONTENTS

	<u>PAGE NO.</u>
- ASSESSMENT	-
- OVERVIEW PHOTOGRAPH	-
1 PROJECT INFORMATION	1
1.1 GENERAL	1
a. Authority	1
b. Purpose of Inspection	1
1.2 DESCRIPTION OF PROJECT	1
a. Description of the Dam and Appurtenant Structures	1
b. Location	2
c. Size Classification	2
d. Hazard Classification	2
e. Ownership	2
f. Purpose of the Dams	2
g. Design and Construction History	2
h. Normal Operating Procedures	2
1.3 PERTINENT DATA	2
a. Drainage Area	2
b. Discharge at Dam Site	2
c. Elevation	2
d. Reservoir	3
e. Storage	3
f. Dam	3
g. Spillway	3
h. Auxiliary Spillway	3
i. Reservoir Drain	3
2 ENGINEERING DATA	4
2.1 GEOLOGY	4
2.2 SUBSURFACE INVESTIGATION	4
2.3 EMBANKMENT AND APPURTENANT STRUCTURES	4
2.4 CONSTRUCTION RECORDS	4
2.5 OPERATION RECORD	5
2.6 EVALUATION OF DATA	5

	<u>PAGE NO.</u>
3 VISUAL INSPECTION	6
3.1 FINDINGS	6
a. General	6
b. Dam 1	6
c. Principal Spillway at Dam 1	6
d. Auxiliary Spillway	6
e. Dam 2	6
f. Dam 3	7
g. Reservoir Drain	7
h. Downstream Channel	7
i. Reservoir	7
3.2 EVALUATION	7
4 OPERATION AND MAINTENANCE PROCEDURES	9
4.1 PROCEDURES	9
4.2 MAINTENANCE OF THE DAM	9
4.3 WARNING SYSTEM IN EFFECT	9
4.4 EVALUATION	9
5 HYDROLOGIC/HYDRAULIC	10
5.1 DRAINAGE AREA CHARACTERISTICS	10
5.2 ANALYSIS CRITERIA	10
5.3 SPILLWAY CAPACITY	10
5.4 RESERVOIR CAPACITY	10
5.5 FLOODS OF RECORD	10
5.6 OVERTOPPING POTENTIAL	10
5.7 EVALUATION	11
6 STRUCTURAL STABILITY	12
6.1 EVALUATION OF STRUCTURAL STABILITY	12
a. Visual Observations	12
b. Design and Construction Data	12
c. Post Construction Changes	12
d. Seismic Stability	12
7 ASSESSMENT/RECOMMENDATIONS	13
7.1 ASSESSMENT	13
a. Safety	13
b. Adequacy of Information	13
c. Need for Additional Investigations	13
7.2 RECOMMENDED MEASURES	13

PHASE I REPORT
NATIONAL DAM SAFETY PROGRAM

Name of Dam: Higinbotham Brook Watershed Project
I.D. No. NY 703

State Located: New York

County Located: Madison

Stream: Higinbotham Brook (tributary of Oneida
Creek and Oswego River)

Date of Inspection: July 24, 1979

ASSESSMENT

The examination of documents and visual inspection of the Higinbotham Brook dams and appurtenant structures did not reveal conditions which constitute a hazard to human life or property.

The total discharge capacity of the spillways is adequate for the Probable Maximum Flood (PMF).

The following remedial actions are required during this construction season:

1. Repair the erosion areas on and in the vicinity of Dam 1. Seed and mulch all unprotected areas to establish erosion resistant vegetation;
2. Repair the eroded area in the downstream channel;
3. Periodically monitor the slopes in the reservoir area and repair as required;
4. Provide a program of seeding and mulching of all earth surfaces on the dams and in the reservoir area to establish erosion protection material. If vegetation cannot resist long term erosion action, an alternate method may be required;
5. Provide a program of periodic inspection and maintenance of the dams and appurtenances. This program must include yearly operation and lubrication of the reservoir drain system. Document this information for future reference;

6. Develop an emergency action plan.

George Koch

George Koch
Chief, Dam Safety Section
New York State Department of
Environmental Conservation
NY License No. 45937

Approved By:

Clark H. Benn

Col. Clark H. Benn
New York District Engineer

Date:

25 September 79



Overview of Higinbotham Brook Watershed Project
Dam 1 in foreground & Dam 2 in background
Photo #1



Overview of Dam 3
Photo #2

PHASE I INSPECTION REPORT
NATIONAL DAM SAFETY PROGRAM
HIGINBOTHAM BROOK WATERSHED PROJECT
I.D. NO. NY 703
DEC #103C-4286
OSWEGO RIVER BASIN
MADISON COUNTY, NEW YORK

SECTION 1: PROJECT INFORMATION

1.1 GENERAL

a. Authority

The Phase I inspection reported herein was authorized by the Department of the Army, New York District, Corps of Engineers, to fulfill the requirements of the National Dam Inspection Act, Public Law 92-367.

b. Purpose of Inspection

Evaluation of the existing conditions of the subject dam to identify deficiencies and hazardous conditions, determine if they constitute hazards to life and property and recommend remedial measures where necessary.

1.2 DESCRIPTION OF PROJECT

a. Description of the Dam and Appurtenant Structures

The Higinbotham Brook Watershed Project consists of 1 main dam and 2 smaller closure dams designed to reduce floodwater damage. The maximum heights of the dams are: Dam 1 = 53 feet, Dam 2 = 14 feet, and Dam 3 = 21 feet. The structures are homogeneous compacted earth fill from on site borrow areas, composed of gravels, silts, and sands, with minor amounts of oversize material greater than 6 inches. A vegetated auxiliary spillway, excavated between Dams 1 and 2, provides temporary flood storage below its crest, and will contain the runoff produced by a 100 year frequency storm.

An internal drainage system is located beneath the downstream portion of earth fill on Dam 1 to control the phreatic surface and to provide a safe outlet for foundation seepage. A cut-off trench was excavated along the centerline of each dam to reduce seepage.

The principal spillway, located at Dam 1, is composed of a rectangular drop inlet structure (2 stage reinforced concrete riser), a 30-inch diameter reinforced concrete pipe beneath the dam, and a plunge pool to dissipate energy at the conduit outlet. An 18-inch diameter reinforced concrete pipe, with a manually operated slide gate, the controls of which are located atop the riser; serve as the reservoir drain system.

Further information concerning the dams and appurtenances is included in Appendix G, Drawings.

b. Location

The dams are located on Higinbotham Brook, a tributary of Oneida Creek and the Oswego River, approximately 2000 feet southwest of the City of Oneida.

c. Size Classification

Dam 1 is 53 feet high and is classified as "intermediate" in size (40 to 100 feet in height). Dam 2 and 3 are classified as "small" in size (less than 40 feet in height).

d. Hazard Classification

The dams are classified as high hazard, because of their location above the City of Oneida.

e. Ownership

The dams are owned and operated by the County of Madison, New York.

f. Purpose of the Dams

The dams are floodwater retarding structures.

g. Design and Construction History

The dams were designed and construction supervised by the U.S. Department of Agriculture, Soil Conservation Service (SCS). Construction of the dam was completed in 1978. The SCS office, located in Syracuse, has all design and construction information.

h. Normal Operating Procedures

Normal flows are discharged through the principal spillway. This structure has sufficient capacity to store and discharge a 100 year flood. Flow in excess of the 100 year storm will be discharged through the auxiliary spillway located between Dam 1 and 2.

1.3

PERTINENT DATA

a. <u>Drainage Area</u> (acres)		512
Height of dam (feet)	Dam 1 = 53, Dam 2 = 14, Dam 3 = 21	
b. <u>Discharge at Dam Site</u> (cfs)		
Maximum known Flood	Unknown, built 1978	
Spillway at Design Pool (El. 532.3)		766
Spillway at Maximum Pool (El. 536.4)		4141
Maximum Capacity of Reservoir drains		18
Total Discharge, Max. Pool		4141
Average Daily Discharge		Varies
c. <u>Elevation</u> (ft. above MSL-Datum)		
Top of Dam		536.4
Design Pool		523.3
Auxiliary Spillway Crest		530.0
Invert of Low Stage Inlet-- Riser		513.1
Invert Reservoir Drain Inlet		486.4
Principal Spillway Crest		528.0

- d. Reservoir (Acres)
- | | |
|---|-----|
| Surface Area at Top of Dam | 15 |
| Surface Area at Crest of Auxiliary Spillway | 10 |
| Surface Area at Principal Spillway Crest | 8.8 |
- e. Storage (Acre-feet)
- | | |
|--------------------------|-----|
| Spillway Crest | 73 |
| Auxiliary Spillway Crest | 92 |
| Top of Dam | 176 |
- f. Dam
- Type: Homogeneous earth keyed earth cutoff trench and internal drains.
- Length (ft.) Dam 1 = 185, Dam 2 = 235, Dam 3 = 180
- Upstream slope Dam 1 = 1:3.5, Dam 2 & 3 = 1:3.0
- Downstream slope Dam 1 = 1:2.5 & 1:3.0, Dam 2 = 1:3.0 & 1:2.5, Dam 3 = 1:2.5
- Crest Width, ft. Dam 1 = 18, Dam 2 & 3 = 12
- g. Spillway
- Type: Ungated reinforced concrete 2 stage drop inlet 2.5' x 7.5', 283' of 30" reinforced concrete pipe, plunge pool.
- Weir Length, ft. 15.0
- h. Auxiliary Spillway (Emergency)
- Type: Grass-lined channel having trapezoidal cross-section.
- | | |
|--|-------|
| Bottom Width (ft.) | 80 |
| Side Slopes | 1:3.0 |
| Length of Level Section (in profile) (ft.) | 50 |
| Exit Slope (ft./ft.) | 0.029 |
- i. Reservoir Drain
- Type: 18-inch diameter reinforced concrete pipe with reinforced concrete inlet.
- Control: Manually operated vertical slide gate mounted inside principal spillway riser.

SECTION 2: ENGINEERING DATA

2.1 GEOLOGY

The Higinbotham Brook Watershed Project Dams are located in the Erie-Ontario lowlands near the boundary of the Appalachian Uplands. This province encompasses the relatively low, flat areas lying south of Lake Erie and Lake Ontario and extending up the Black River Valley. From the lakes, the land rises gently southward. The simple erosional topography has been modified substantially by glacial deposition. Bedrock, which was observed outcropping in the reservoir area, is Vernon shale of the Silurian Period (435 - 395 million years ago). Surficial soils are of the Wampsville series. These soils were formed of glaciofluvial deposits from mostly limestone and reddish shale. These deposits occur on alluvial fans, outwash plains, terraces, and kames. The soils are well drained, runoff is medium, and internal drainage is medium to rapid.

2.2 SUBSURFACE INVESTIGATION

A subsurface investigation was conducted by SCS in 1975. This program consisted of 6 drill holes and 29 test pits at locations along the dams, auxiliary spillway, structural elements, and borrow area. Applicable subsurface information is included in Appendix G, Drawings #24 and 25.

In general, the soils in the vicinity of the dams are of glacial outwash origin and are silty sand, clayey with some gravel (maximum 3" diameter) and silty gravel, clayey with some boulders (maximum size 10") over weathered Vernon shale over Vernon shale. Depth to shale bedrock is variable.

2.3 EMBANKMENT AND APPURTENANT STRUCTURES

The dam was designed and constructed under the supervision of SCS. "As-built" drawings of this project are on file at the SCS office in Syracuse. Selected drawings of the dams and appurtenances are included in Appendix G. The design of the watershed project includes 3 homogeneous compacted earth dams (Height: Dam 1 = 53 ft., Dam 2 = 14 ft., Dam 3 = 21 ft.); each with a compacted earth cutoff trench, and Dam 1 containing internal drains parallel to the axis of the dam and beneath its centerline. A reinforced concrete riser and 30-inch diameter reinforced concrete pipe serves as the principal spillway. A vegetated earth channel between Dam 1 and 2 serves as an auxiliary spillway.

2.4 CONSTRUCTION RECORDS

Complete construction records are available from the SCS office in Syracuse. Eight anti-seep collars were installed instead of the 9 originally specified for the principal spillway. Seepage was encountered at the downstream toe of Dam 1 during construction. Riprap and filter material was placed to control the seepage. To prevent the development of erosion, riprap was placed at the right (southeast) abutment of Dam 3 on both the upstream and downstream side of the abutment.

2.5 OPERATION RECORD

Since the dam is an ungated floodwater retarding structure, no operating records are maintained regarding water levels. During periods of extreme rainfall, SCS personnel do monitor the dam and reservoir.

2.6 EVALUATION OF DATA

The data presented in this report has been compiled with the aid of information obtained from Mr. Donald W. Lake, Jr., Head of the SCS Design Section in Syracuse, New York. This information appears to be adequate and reliable for Phase 1 inspection purposes.

SECTION 3: VISUAL INSPECTION

3.1 FINDINGS

a. General

Visual inspection of the Higinbotham Brook Watershed Project Dams was conducted on July 24, 1979. The weather was partly cloudy and the temperature ranged in the 80's. The reservoir water surface was approximately the invert elevation of the low stage inlet on the principal spillway riser (elevation 513.1).

b. Dam 1

No signs of distress were observed in the earth embankment and no evidence of uncontrolled seepage, misalignment, sloughing, subsidence, depressions, surface cracking, or undesirable growth were noted in connection with the embankment. While no riprap was in use on the upstream slope for wave protection, little erosion in this area was apparent. (See photos 1, 3 & 7) Erosion was apparent at the right (southeast) abutment contact of the upstream face to a depth of approximately 1 foot (See photo #6). Erosion was also evident on the slopes of the abutments on the downstream side of the dam where stripping was conducted prior to embankment placement (See photos #3 & 8). Seepage was apparent at the toe of the dam flowing at a rate of 2 to 5 gallons per minute through riprapped covered filter material. This flow was exiting into the plunge pool on the right side of the outlet pipe (See photos #8 & 10). No migration of fines was noted. This seepage is reported to be the result of seepage points encountered at the base of the dam during construction. The seepage seems to be adequately controlled by the filter material and riprap protection.

Two 8-inch diameter internal drains encased in a 2 zoned drain fill material provide control of the phreatic surface and foundation seepage. The left drain was discharging at a rate of approximately 3 to 5 gallons per minute. (See photos #8 & 9)

c. Principal Spillway at Dam 1

The principal spillway consists of a vertical drop inlet structure, a reinforced concrete pipe through the embankment, a plunge pool at the toe of the embankment, and an outlet channel. These components appear to be in satisfactory condition. (See photos #3, 7, 8 & 9)

d. Auxiliary Spillway

The auxiliary spillway is a vegetated earth channel located between Dam 1 and 2. The vegetation in the channel had not been mowed since seeding. The spillway channel should be mowed in order to establish a good stand of grass. The channel seems to be stable and constructed according to design. (See photos #1, 3, 4 & 5)

e. Dam 2

This dam is a low closure embankment adjacent to the auxiliary spillway. Its purpose is to direct flow into the auxiliary spillway and away from the adjacent hospital (See photos #3, 4 & 5). The riprap placed at the junction of the dam and auxiliary spillway is used to prevent erosion of the dam by auxiliary

spillway flows. The dam appears to be stable with no signs of distress, seepage, erosion, misalignment, sloughing, subsidence, depressions, surface cracking, or undesirable growth noted.

f. Dam 3

This dam is a closure embankment located approximately 900 feet southwest of Dam 1 (See photo #2). There are no signs of distress in the earth embankment and no evidence of seepage, misalignment, sloughing, subsidence, depressions, surface cracking, or undesirable growth were noted. Riprap was placed on the original grade at the right (southeast) abutment on both the upstream and downstream sides of the dam to provide erosion protection of the abutment slopes.

g. Reservoir Drain

An 18-inch diameter reinforced concrete pipe with a manually operated vertical slide gate serves as the reservoir drain system. This system is reported to be operational.

h. Downstream Channel

The downstream channel below the plunge pool is a vegetated earth channel. A reinforced box culvert transmits the flow of the channel beneath the highway embankment of N.Y. Route #5. (See photo #12) Headward erosion, approximately 2 feet in length, was evident in the channel about 200 feet below the plunge pool (See photo #11).

i. Reservoir

The immediate reservoir area contains very steep side slopes and sloughing of these slopes was apparent (See photo #14). No sedimentation problems were reported.

During construction, what appeared to be surface cracking developed in numerous locations particularly along unvegetated cut slopes. (See photo #13) Extensive testing was conducted to determine if the soils were of a dispersive nature. The testing indicated that the soils were not dispersive and after further study, it was concluded by SCS that the cracking was the process of erosion in the fine grained soils. Additional information concerning this testing is included in Appendix F, Stability Analysis. The erosion observed during the inspection does not appear to be significant providing vegetation is initiated.

3.2

EVALUATION

The problem areas observed during the inspection are considered minor in nature; requiring only remedial action or monitoring of existing conditions. These areas are as follows:

1. Erosion of the right upstream abutment contact and original grade above the abutment contacts on the downstream face of Dam 1. These areas require repair and seeding, and mulching to establish erosion resistant vegetation. Riprap may be required if vegetation cannot withstand the erosive forces;

2. Headward erosion in the downstream channel requires repair and erosion protection material;
3. The very steep slopes in the reservoir area and the minor erosion of the adjacent cut slopes should be monitored periodically with repairs initiated as required;
4. The erosive characteristics of the surficial soils are such that vegetative cover is required to resist even minor erosion. Periodically inspect the dams and surrounding watershed to identify problem areas. Immediately provide seeding and mulching of all areas in which vegetation is not developing properly;
5. Provide a program of periodic inspection and maintenance of the dams and appurtenances. This program must include yearly operation and lubrication of the reservoir drain system. Document this information for future reference. Also, develop an emergency action plan for notification of downstream residents and the proper governmental authorities.

SECTION 4: OPERATION AND MAINTENANCE PROCEDURES

4.1 PROCEDURES

The normal water surface elevation is approximated by the low stage inlet elevation. Downstream flows are limited by the 30-inch diameter principal spillway pipe, except during periods of extremely heavy runoff when the auxiliary spillway is in service. The dam provides 92 acre feet of flood storage up to the crest of the auxiliary spillway.

4.2 MAINTENANCE OF THE DAM

The dams are maintained by the County of Madison, New York. Maintenance is not considered satisfactory as evidenced by the erosion of numerous slopes in the vicinity of Dam 1 and in the reservoir area.

4.3 WARNING SYSTEM IN EFFECT

There is no warning system in effect or in preparation.

4.4 EVALUATION

The dams and appurtenant structures have not been maintained in a satisfactory condition as noted in "Section 3: Visual Inspection".

SECTION 5: HYDROLOGIC/HYDRAULIC

5.1 DRAINAGE AREA CHARACTERISTICS

Delineation of the watershed of the Higinbotham Brook Watershed Project was made using the USGS 7.5 minute quadrangle for Oneida, New York. The watershed consists of woodlands and fields situated in a rural section. Relief ranges from shallow to moderate, except in the immediate reservoir area where numerous slopes are very steep. The drainage area is 512 acres or 0.8 square miles.

5.2 ANALYSIS CRITERIA

The analysis of the spillway capacity of the dam and storage of the reservoir was performed using the Corps of Engineers HEC-1 computer program, incorporating the "Snyder Synthetic Unit Hydrograph" method and the "Modified Puls" flood routing procedure. The spillway design flood selected for analysis was the PMF in accordance with the recommended "Guidelines" of the U.S. Army Corps of Engineers.

5.3 SPILLWAY CAPACITY

The principal and auxiliary spillways are uncontrolled structures. The principal spillway operates under weir or orifice flow conditions depending upon the floodwater inflow to the reservoir pool. The auxiliary spillway was analyzed as a broad-crested weir having a discharge coefficient (c) of 3.087.

The spillways have sufficient capacity for discharging the peak outflow from the PMF. For this storm, the peak inflow is equal to the peak outflow which is calculated to be 1723 cfs. When the spillways are discharging the peak outflow, the water surface will be 3.8 feet below the top of the dam. Additional information concerning this analysis is included in Appendix D.

5.4 RESERVOIR CAPACITY

Normal flood control storage capacity of the reservoir between the low stage inlet of the principal spillway and the auxiliary spillway is 69.7 acre-feet, which is equivalent to a runoff depth of 1.6 inches over the drainage area. Surge storage capacity to the maximum high water elevation is an additional 83.8 acre-feet, which is equivalent to a runoff depth over the drainage area of 2.0 inches. The total storage capacity of the dam is 153.5 acre-feet, which is equivalent to 3.6 inches of direct runoff.

5.5 FLOODS OF RECORD

Since the dam was completed in 1978, no significant floods have occurred which can be reported.

5.6 OVERTOPPING POTENTIAL

Analysis indicates the total discharge capacity is sufficient to prevent overtopping of the dam from the PMF.

5.7

EVALUATION

The Higinbotham Brook Watershed Project dams have sufficient capacity to impound and adequately discharge floodwaters expected to result from the PMF.

SECTION 6: STRUCTURAL STABILITY

6.1 EVALUATION OF STRUCTURAL STABILITY

a. Visual Observations

No signs of distress or instability were observed in connection with the earth embankments.

b. Design and Construction Data

A stability analysis was conducted by SCS during design of Dam 1. The analyses were performed using the Modified Swedish Circle method. The soil parameters assumed were $\gamma_d = 105$ pcf, $\gamma_m = 120$ pcf, $\gamma_{sat} = 128.5$ pcf, $\phi = 14^\circ$, and $C = 350$ psf. The results of the analyses are as follows:

<u>Condition</u>	<u>Minimum Factor of Safety</u>
1. Upstream Slope = 1:3.5, drawdown from 10 feet above permanent pool, 10 ft. wide berm at el. 513.1;	1.27
2. Downstream Slope = 1:2.5 changing to 1:3.0, steady state seepage with drain, 12 ft. wide berm at el. 513.1	1.41

The calculated factor of safety for the upstream slope during rapid drawdown is in excess of the minimum factor of 1.2 recommended by the Corps of Engineers. The calculated factor of safety for the downstream slope during steady state seepage conditions is slightly below the value of 1.5 recommended by the Corps of Engineers. Since the assumed conditions of the analysis were for a reservoir level 10 feet above normal, the resulting factors of safety would be lower than that calculated at normal pool. In addition, this factor of safety in the analysis is not significantly lower than the recommended value. The dam is, therefore, considered to have adequate factors of safety for stability.

A summary of the analysis is included in Appendix F.

c. Post Construction Changes

Eight anti-seep collars were installed instead of the 9 originally specified for the principal spillway conduit. Also, seepage was encountered at the downstream toe of Dam 1 during construction. To control this seepage, a blanket of filter material and riprap was installed near the outlet of the principal spillway conduit.

In addition, riprap was placed on the right (southeast) abutment of Dam 3 on both the upstream and downstream abutment slopes to control erosion.

d. Seismic Stability

The dam is located in Seismic Zone 1. Therefore, a seismic analysis is not warranted.

SECTION 7: ASSESSMENT/RECOMMENDATIONS

7.1 ASSESSMENT

a. Safety

The Phase 1 inspection of the Higinbotham Brook Watershed Project did not reveal conditions which constitute a hazard to human life or property. The earth embankments are not considered to be unstable and appear capable of retarding floodwaters resulting from the PMF.

b. Adequacy of Information

Information reviewed for Phase 1 inspection purposes is considered adequate.

c. Need for Additional Investigations

No additional investigations are required at this time.

7.2 RECOMMENDED MEASURES


- a. Repair the areas in which erosion has occurred on Dam 1 (right abutment upstream face) and conduct seeding and mulching operations in all unprotected areas to establish erosion resistant vegetation.
- b. Repair the eroded area of the downstream channel with erosion protection material.
- c. Periodically monitor the slopes in the reservoir area and repair as required.
- d. Provide a program of periodic inspection of all earth surfaces on the dams and in the reservoir area. Where vegetation is not satisfactorily resisting erosion due to insufficient ground cover, provide a seeding and mulching program to establish erosion resistant vegetation. If established vegetation cannot resist erosion, an alternate erosion protection material may be required.
- e. Provide a program of periodic inspection and maintenance of the dams and appurtenances. This program must include yearly operation and lubrication of the reservoir drain system. Document this information for future reference.
- f. Develop an emergency action plan for notification of downstream residents and the proper governmental authorities.

APPENDIX A

PHOTOGRAPHS



Dam 1
Photo #3 A & B

 

Auxiliary Spillway (left) and Upstream Face of Dam 2 (right)
Photo # 4 A & B



Dam 2 - Crest & Downstream Face
Auxiliary Spillway in Background
Photo #5



Dam 1 - Upstream Face Right Abutment Erosion
Photo #6



Dam 1 - Principal Spillway Riser
Photo #7



Dam 1 - Outlet of Principal Spillway Conduit
Photo #8



Dam 1 - Principal Spillway Conduit
Note Drainpipe
Photo #9



Dam 1 - Seepage Point in Plunge Pool
Right Side of Conduit
Photo #10



Downstream Channel, Dam 1 in Background
Note Channel Erosion
Photo #11



Downstream Channel Looking Downstream Toward N.Y. Rt. #5
Photo #12



Cut Slope in Reservoir Area
Note Erosion and Sparse Vegetation
Photo #13



Steep Slopes in Reservoir Area
Note Shale Outcrop at Right
Photo #14

APPENDIX B

ENGINEERING DATA CHECKLIST

Check List
Engineering Data
Design Construction Operation

Name of Dam H. G. Johnson

I.D. # NY 703

DEC # 103 C - 4286

Item	Remarks		
Dam	Plans Yes	Details Yes	Typical Sections Yes
Spillway(s)	"	"	"
Outlet(s)	"	"	"
Design Reports	Yes by SCS in DEC file		
Design Computations	SCS has all info		
Discharge Rating Curves	SCS has all info		
Dam Stability	Yes		
Seepage Studies	SCS has all info		
Subsurface and Materials Investigations	Yes see plans		

Item

Remarks

Constructed 1978 by Santoro & Taroson, Inc Syracuse NY

Construction History

Surveys, Modifications,
Post-Construction Engineering
Studies and Reports

Year surface cracking & exposed earth cuts
thought to be dispersive clays - testing did not
indicate this - cracking thought to be erosion
of fine material from decomposed shale soils

Accidents or Failure of Dam
Description, Reports

NONE

Operation and Maintenance Records
Operation Manual

NONE

APPENDIX C

VISUAL INSPECTION CHECKLIST

VISUAL INSPECTION CHECKLIST

1) Basic Data

a. General

Name of Dam Higinbotham Brook Watershed Project

I.D. # NY 703 DEC # 103C-9286

Location: Town Oneida County Madison

Stream Name Higinbotham Brook

Tributary of Oneida CK. and Oswego River

Longitude (W), Latitude (N) 75° 39' 21" | 43° 04' 38"

Hazard Category C High

Date(s) of Inspection July 29 1979

Weather Conditions Partly Cloudy 80's

b. Inspection Personnel Kenneth Harmer Bob McCarty

Donald Lake (SCS)

c. Persons Contacted Donald W. Lake, J.E. Head Design Section

SCS - Syracuse NY Tel (315) 423-5505

d. History:

Date Constructed 1978

Owner County of Madison, N.Y.

Designer Soil Conservation Service

Constructed by Santoro & Tarason Inc
Syracuse NY

2) Technical Data

Type of Dam Earth Embankment Dam #1 Primary Dam #2 & 3 closure dikes

Drainage Area 0.8 sq. mi. (512 acres)

Height 53 19 21 Length 186 235 180

Upstream Slope 1:3.5 Downstream Slope 1:2.5 then 1:3 at base

Dam #2 1:3.0 1:3.0 and 1:2.5

Dam #3 1:3.0 1:2.5

2) Technical Data (Cont'd.)

External Drains: on Downstream Face None @ Downstream Toe None

Internal Components:

Impervious Core None

Drains Yes

Cutoff Trench Yes

Grout Curtain None

3) Embankment

a. Crest

(1) Vertical Alignment good condition

(2) Horizontal Alignment good condition

(3) Surface Cracks none

(4) Miscellaneous _____

b. Slopes

(1) Undesirable Growth or Debris, Animal Burrows _____

(2) Sloughing, Subsidence or Depressions none
erosion at right abutment contact on upstream side of dam 1 \approx 1 foot deep

(3) Slope Protection Dam 1: at toe near plunge pool, Dam 2: on downstream face near corner of auxiliary spillway,

Dam 3: at right abutment on both upstream and downstream junctions

(4) Surface Cracks or Movement at Toe for erosion protection

none evident

(5) Seepage Dam 1: seepage along right side of plunge pool at toe of riprap flow: 2-5 gpm, lines not observed; Dam 2: none evident;
Dam 3: none evident

(6) Condition Around Outlet Structure generally good condition

c. Abutments

Some erosion and sloughing of exposed soil and shales where excavation occurred in original grade of both abutments on downstream side of dam #1

(1) Erosion at Embankment and Abutment Contact on upstream slopes right abutment Dam 1

(2) Seepage along Contact of Embankment and Abutment none evident

(3) Seepage at toe or along downstream face in plunge pool riprap right side of outlet pipe flow 2-5 gpm SCS ripraped due to abutment seepage during construction

d. Downstream Area - below embankment

narrow channel

(1) Subsidence, Depressions, etc. headward erosion \approx 2 feet deep due to blow of outlet channel \approx 200 feet below toe of dam

(2) Seepage, unusual growth none evident

(3) Evidence of surface movement beyond embankment toe none evident

(4) Miscellaneous _____

e. Drainage System

2 8" diameter internal drain pipes parallel to principal spillway surrounded by 3 zone drain fill + short chimney drain (19')

--(1) Condition of relief wells, drains, etc. _____

_____ good condition of drains _____

(2) Discharge from Drainage System Left drain flowing approx 3.5 gpm

4) Instrumentation

(1) Monumentation/Surveys _____

_____ see plans for survey data

(2) Observation Wells _____ none

(3) Weirs _____ none

(4) Piezometers _____ none

(5) Other _____

5) Reservoir

a. Slopes very steep in immediate reservoir area (normal pool)

_____ shale bedrock or bedrock controlled

b. Sedimentation _____ no problems reported

6) Spillway(s) (including tail race channel)

- a. General Standard SCS Design Principal spillway &
Auxiliary spillway on right side of Dam #1
- b. Principle Spillway good condition no debris
- c. Emergency or Auxiliary Spillway good condition
no cutting of vegetation to encourage growth
of new seeded areas after original construction
last year
- d. Condition of Tail race channel Ripraped plunge pool
& part of outlet channel with filter material beneath to
collect sumps encountered during construction
headward erosion has started \approx 200 feet from toe of Dam #1
- e. Stability of Channel side/slopes headward erosion of outlet channel \approx 2 feet deep
working toward toe of dam

7) Downstream Channel

a. Condition (debris, etc.) no debris, landward erosion
of downstream channel ≈ 2 ft. deep & 200 ft
below toe of dam

b. Slopes steep where eroded

c. Approximate number of homes village of Oneida below NY Rt #5
concrete box culvert under Rt #5

8) Miscellaneous

9) Structural :

a. Concrete Surfaces _____

_____ good condition _____

b. Structural Cracking _____ none evident _____

c. Movement - Horizontal & Vertical Alignment (Settlement) _____

_____ no problems observed _____

d. Junctions with Abutments or Embankments _____

_____ good condition _____

e. Drains - Foundation, Joint, Face _____ internal drains in good

_____ condition _____

f. Water passages, conduits, sluices _____

_____ good condition & reported operational _____

g. Seepage or Leakage _____ none collected to concrete or

_____ structural elements _____

h. Joints - Construction, etc. _____

good condition

i. Foundation _____ appears to be no problem

j. Abutments _____ N/A

k. Control Gates reported operational

l. Approach & Outlet Channels _____ no structural problems

m. Energy Dissipators (plunge pool, etc.) _____ plunge pool - good condition

n. Intake Structures _____ good condition

o. Stability _____ appears good

p. Miscellaneous _____

APPENDIX D
HYDROLOGIC/HYDRAULIC
ENGINEERING DATA AND COMPUTATIONS

CHECK LIST FOR DAMS
HYDROLOGIC AND HYDRAULIC
ENGINEERING DATA

1

AREA-CAPACITY DATA:

	<u>Elevation</u> (ft.)	<u>Surface Area</u> (acres)	<u>Storage Capacity</u> (acre-ft.)
1) Top of Dam	<u>536.4</u>	<u>15.0</u>	<u>176.2</u>
2) Design High Water (Max. Design Pool)	<u>532.3</u>	<u>11.8</u>	<u>120.2</u>
3) Auxiliary Spillway Crest	<u>530.0</u>	<u>10.0</u>	<u>92.4</u>
4) Invert of Low Stage inlet riser	<u>513.1</u>	<u>2.5</u>	<u>22.7</u>
5) Service Spillway Crest	<u>528.0</u>	<u>8.8</u>	<u>73.4</u>

DISCHARGES

	<u>Volume</u> (cfs)
1) Average Daily	<u>Varies</u>
2) Spillway @ Maximum High Water	<u>4191</u>
3) Spillway @ Design High Water	<u>766</u>
4) Spillway @ Auxiliary Spillway Crest Elevation	<u>140</u>
5) Low Level Outlet	<u>18</u>
6) Total (of all facilities) @ Maximum High Water	<u>4191</u>
7) Maximum Known Flood	<u>Unknown</u> b: H 1978

CREST:

ELEVATION: 536.4 Top of Dam

Type: Earth Embankment

Width: 18' Dam 1, 12' Dam 2 & 3 Length: Dam 1: 185', Dam 2: 235', Dam 3: 180'

Spillover Principal spillway - weir length 15 ft., 2.5 x 7.5 rectangular riser

Location Center of upstream slope - principal spillway in Dam #1
At right abutment of Dam #1 - Auxiliary spillway

SPILLWAY:

PRINCIPAL

EMERGENCY

crest 528.0, low stage 513.1 Elevation 530.0

Uncontrolled Reinforced Concrete, 2 stage Type Vegetated Earth

2.5' x 7.5' Width 80', 1:3 side slopes

Type of Control

Uncontrolled Uncontrolled Uncontrolled

Controlled:

_____ Type _____
 (Flashboards; gate)

1 Number 1

weir length 15 ft. Size/Length 80' wide

Invert Material Earth

Anticipated Length of operating service 100 year storm

283.33' of 30" Reinforced Conc. pipe Chute Length 427

14.5 ft. Height Between Spillway Crest & Approach Channel Invert (Weir Flow) _____

OUTLET STRUCTURES/EMERGENCY DRAWDOWN FACILITIES:

Type: Gate Sluice _____ Conduit Penstock _____
 Shape: Gate: 24" Flat from Slide Gate Conduit Round Rein. Conc. Pipe
 Size: 24" gate 18" diameter
 Elevations: Entrance Invert 486.4
 Exit Invert 479.0
 Tailrace Channel: Elevation 476.5

HYDROMETEROLOGICAL GAGES:

Type: NONE
 Location: _____
 Records:
 Date - _____
 Max. Reading - _____

FLOOD WATER CONTROL SYSTEM:

Warning System: NONE

 Method of Controlled Releases (mechanisms):
None except for Manually Operated Reservoir Drain
Slide Gate

DRAINAGE AREA: 512 Acres

DRAINAGE BASIN RUNOFF CHARACTERISTICS:

Land Use - Type: Forest & Farm lands

Terrain - Relief: Moderate to shallow slopes

Surface - Soil: Glacial fill or weathered Vernon shale

Runoff Potential (existing or planned extensive alterations to existing (surface or subsurface conditions)

None

Potential Sedimentation problem areas (natural or man-made; present or future)

None

Potential Backwater problem areas for levels at maximum storage capacity including surcharge storage:

None

Dikes - Floodwalls (overflow & non-overflow) - Low reaches along the Reservoir perimeter:

Location: Dam 2 & 3 used to control these areas east & south east of Dam #1
Elevation: Same as dam #1 536.9

Reservoir:

Length @ Maximum Pool N/A (Miles)

Length of Shoreline (@ Spillway Crest) N/A (Miles)

DESIGN REPORT SUMMARY

I. Watershed data

A. Structure class		
H. Drainage area	<u>512</u>	Ac.
C. Time of concentration - T_c	<u>1.0</u>	Hrs
D. Hydrologic curve number - C_n Moisture Condition II	<u>77</u>	

II. Principal spillway


A. Conduit		
1. Size (I.D.)	<u>30</u>	In.
2. Length	<u>252</u>	Ft.
B. Riser		
1. Size	<u>2.5x7.5</u>	Ft.
2. Height (floor to crest)	<u>43</u>	Ft.
C. Weir length	<u>15</u>	Ft.
D. Reservoir drain size	<u>16</u>	In.
E. Type of energy dissipator	<u>Plunge Pool</u>	

III. Emergency spillway

A. Width	<u>80</u>	Ft.
B. Side slopes	<u>3:1</u>	
C. Length of level section	<u>50</u>	Ft.
D. Exit slope	<u>0.029</u>	Ft./Ft.
E. Maximum velocity - in exit section (ESH)	<u>7.0</u>	Ft./Sec.
F. Duration of flow (ESH) through emergency spillway	<u>4.5</u>	Hrs.
G. Frequency of use	<u>51</u>	

IV. Earth fill

	<u>Dam 1</u>	<u>Dam 2</u>	<u>Dam 3</u>	
A. Height (ft.)	53	14	21	
B. Volume (C.Y.)				<u>45200</u> (3 dams)
C. Compaction (Class)				

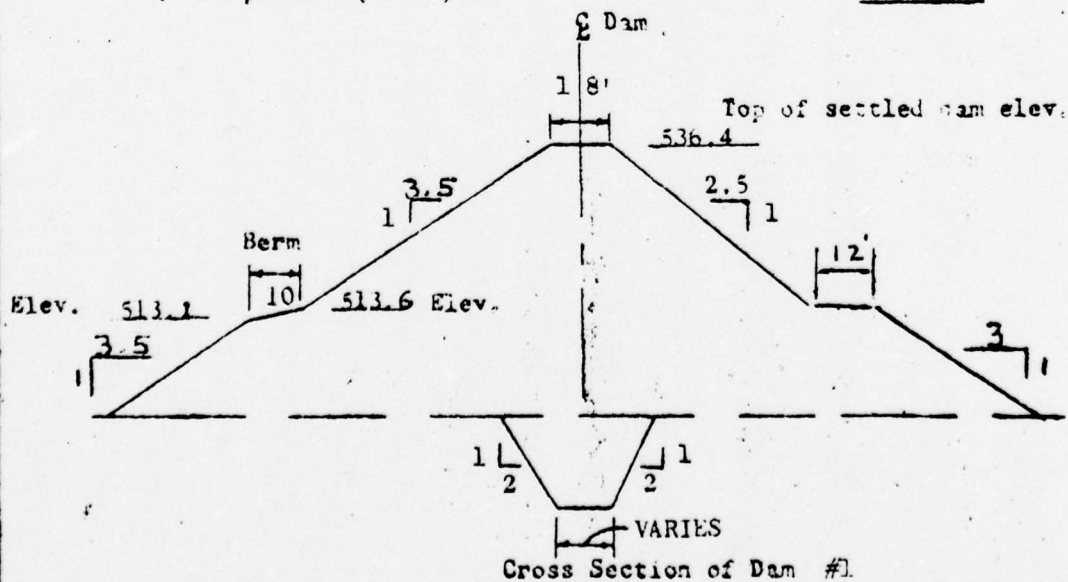

U.S. DEPARTMENT OF AGRICULTURE - SOIL CONSERVATION SERVICE

ELEMENT OF STRUCTURE	DETERMINING FACTOR	ELEV FT	SURFACE AREA AC	STORAGE		INFLOW		PEAK OUTFLOW CFS
				AF	INCHES	YOLF INCHES	RATE CFS	
Invert of Orifice	100-year submerged sediment accumulation 1.47 AC	513.1	2.5	22.7 ^{2/}	0.53 ^{2/}			
Crest of Riser	71 Ac. Ft. Evaluation storm storage plus 100-year total sediment	528.0	8.8	73.4 ^{2/}	1.72 ^{2/}			18
Crest of Emergency Spillway	100-year frequency storm AMC II	530.0	10.0	92.4 ^{2/}	2.17 ^{2/}			140
Design High Water	ES-1020 Sheet 2 of 5**	532.3	11.8	120.2 ^{2/}	2.82 ^{2/}	5.92	1408	766
Top of Dam	ES-1020 Sheet 3 of 5** RAPF	536.4	15.0	176.2 ^{2/}	4.13 ^{2/}	18.58	4470	4141

* Volume expressed in inches of runoff from controlled watershed of 512 acres
 ** Refer to Hydrologic criteria in National Engineering Memorandum SCS-27 (Rev.)
 1/ Does not include 4.1 AF of sediment allocated to flood pool
 2/ Does not include 26.8 AF of sediment storage

Note this is 39% RAPF

Higinbotham Brook DAM
NY 703

D.A. = Drainage area in square miles

L = River mileage from the given station to the upstream limits of the drainage area

LCA = River mileage from the station to the center of gravity of the drainage area

PMP = Probable Maximum Precipitation in inches

t_p = Lag time from mid-point of unit rainfall duration, t_r , to peak of unit hydrograph, in hours.

t_r = Unit rainfall duration, equal to $\frac{t_p}{5.5}$, in hours.

C_t = Coefficient depending upon units and drainage basin characteristics

t_r = Unit rainfall duration other than standard unit; t_r adopted in specific study, in hours.

t_{pr} = Lag time from mid-point of unit rainfall duration t_r , to peak of unit hydrograph, in hours

$$D.A = 0.8 \text{ square miles, } L = 1.1 \text{ miles, } LCA = .6 \text{ miles}$$

$$PMP = 19 \text{ inches } C_t = 2$$

$$C_p = 0.625 \text{ from average } 640 C_p = 400$$

$$t_p = C_t (L \cdot LCA)^{0.3} = 2 (1.1 \times .6)^{0.3} = 1.77 \text{ hours}$$

$$t_r = \frac{t_p}{5.5} = \frac{1.77}{5.5} = .32 \text{ hours (Use 1 hr. hydrograph)}$$

$$t_{pr} = t_p + 0.25 (t_r - t_r) = 1.77 + .25(1 - .32) = 1.94 \text{ hrs.}$$

From HYR 33 - Figure 2, Depth - Area - Duration

$$6 \text{ hour } \% \text{ 111} = \quad , \quad 12 \text{ hour } \% = 123$$

$$24 \text{ hour } \% \text{ 133} = \quad , \quad 48 \text{ hour } \% = 142$$

 FLOOD HYDROGRAPH PACKAGE (HLC-1)
 DAM SAFETY VERSION JULY 1973
 LAST MODIFICATION 26 FEB 76
 MODIFIED BY: PIPYJELL APR 79

 THIS PROGRAM IS CURRENTLY BEING MODIFIED
 TO RUN ON THE USS HONEYWELL SYSTEM

PLEASE REPORT ANY USUAL OPERATIONAL PROBLEMS
 TO THE TILLSMITH (PH. 423) PH: 7-5366

LINE	DESCRIPTION	UNIT	VALUE	UNIT	VALUE	UNIT	VALUE	UNIT	VALUE
1	A	HOURS WITH BRK	703	DEC	1030-4236				
2	A	SCS FLOOD CONTROL STRUCTURE							
3	A								
4	A		100						
5	BI		5						
6	J		1						
7	JL		0.5						
8	K		0						
9	K1								
10	A		1						
11	P		10						
12	T								
13	M		1.94						
14	K		2						
15	K		1						
16	K1								
17	Y								
18	Y1		1						
19	Y4		513.1						
20	Y5		0						
21	Y5		22.7						
22	Y5		73.4						
23	Y5		513.1						
24	Y5		536.4						
25	K		09						
26	A								

OSMPSO RIVER BASIN
 HADISUJI COUNTY
 PMF - SNYDER UH

INFLOW HYDROGRAPH

ROUTED HYDROGRAPH AT DAM - NO BREACH

-513.1 -1

1 0.1

1

185

09

24

27

30

PREVIEW OF SEQUENCE OF STREAM NETWORK CALCULATIONS
RULIFF HYDROGRAPH AT 1
RULITE HYDROGRAPH TO 2
END OF NETWORK

 FLOOD HYDROGRAPH PACKAGE (HE9-1)
 DAN SAFETY VERSION JULY 1971
 LAST MODIFICATION 26 FEB 79
 MODIFIED FOR HONEYWELL APS-79

 THIS PROGRAM IS CURRENTLY BEING MODIFIED
 TO RUN ON THE OS3 HONEYWELL SYSTEM

PLEASE REPORT ANY UNUSUAL OPERATIONS PROBLEMS
 TO WILE TILLSON (NL 423) PH: 7-5666

RUN DATE 09/07/77

HIGHBRUSH BRANK BY 703 DEC 103C-4285
 SCS FLOOD CONTROL STRUCTURE

USWEGO RIVER BASIN
 MADISON COUNTY
 PMF - SHYDER UH

JOB SPECIFICATION											
NO	DIR	UNIT	IBAY	IHR	ININ	NETRC	IPLT	IPRT	NSTAH		
100	1	0	0	0	0	0	0	0	0		
	JOPER	NWT	LROPT	TRACE							
	5	0	0	0							

MULTI-PLAN ANALYSES TO BE PERFORMED
 NPLAN= 1 RTIU= 2 LRTID= 1
 RTIUS= 0.50 1.00

SUR-AREA RUNOFF COMPUTATION

INFLD HYDROGRAPH											
ISTAO	ICDIP	TECON	ITAPE	JPLT	INAHE	ISTAGE	IAUTO				
1	0	0	0	0	1	0	0				

HYDROGRAPH DATA											
IHYD	I-ING	TAREA	SNAP	TRSDA	TRSPC	RATIO	ISHM	ISAME	LOCAL		
1	1	0.80	0.	0.80	0.	0.	0	1	0		

PRECIP DATA

SPFE	R15	R6	R12	R24	R48	R72	R90
0.	19.00	111.00	123.00	133.00	142.00	0.	0.

TRSPC COMPUTED BY THE PROGRAM IS 0.000

LOSS DATA											
LROPT	STKKS	DLTKR	RTIUL	ERAIN	STKRS	RTIUK	STRTL	CHSTL	ALSMX	RTIMP	
0	0.	0.	1.00	0.	0.	1.00	1.00	0.10	0.	0.	

UNIT HYDROGRAPH DATA
 TP= 1.04 CP=0.63 IITA= 0

RECESSION DATA

STATQ= 2.00 QRCSN= 2.00 RTIUR= 1.00
 APPROXIMATE CLARK COEFFICIENTS FROM GIVEN SHYDER CP AND TP ARE TC= 2.51 AND R= 1.33 INTERVALS

MO-DA	HR-MN	PERIOD	RAIN	EXCS	LUSS	COMP Q	E-10-OF-PERIOD FLOW	MO-DA	HR-MN	PERIOD	RAIN	EXCS	LUSS	COMP Q
1.01	1.00	1	0.01	0.	0.01	2.	1.03	3.00	51	0.	0.	0.	0.	11.
1.01	2.00	2	0.01	0.	0.01	2.	1.03	4.00	52	0.	0.	0.	0.	6.
1.01	3.00	3	0.01	0.	0.01	2.	1.03	5.00	53	0.	0.	0.	0.	4.
1.01	4.00	4	0.01	0.	0.01	2.	1.03	6.00	54	0.	0.	0.	0.	3.
1.01	5.00	5	0.01	0.	0.01	2.	1.03	8.00	55	0.	0.	0.	0.	2.
1.01	6.00	6	0.01	0.	0.01	2.	1.03	9.00	56	0.	0.	0.	0.	2.
1.01	7.00	7	0.02	0.	0.02	2.	1.03	10.00	57	0.	0.	0.	0.	2.
1.01	8.00	8	0.02	0.	0.02	2.	1.03	11.00	58	0.	0.	0.	0.	2.
1.01	9.00	9	0.02	0.	0.02	2.	1.03	12.00	59	0.	0.	0.	0.	2.
1.01	10.00	10	0.02	0.	0.02	2.	1.03	13.00	60	0.	0.	0.	0.	2.
1.01	11.00	11	0.02	0.	0.02	2.	1.03	14.00	61	0.	0.	0.	0.	2.
1.01	12.00	12	0.02	0.	0.02	2.	1.03	15.00	62	0.	0.	0.	0.	2.
1.01	13.00	13	0.11	0.	0.11	2.	1.03	16.00	63	0.	0.	0.	0.	2.
1.01	14.00	14	0.14	0.	0.14	2.	1.03	17.00	64	0.	0.	0.	0.	2.
1.01	15.00	15	0.17	0.	0.17	2.	1.03	18.00	65	0.	0.	0.	0.	2.
1.01	16.00	16	0.43	0.02	0.42	3.	1.03	19.00	66	0.	0.	0.	0.	2.
1.01	17.00	17	0.10	0.06	0.10	7.	1.03	20.00	67	0.	0.	0.	0.	2.
1.01	18.00	18	0.13	0.03	0.10	14.	1.03	21.00	68	0.	0.	0.	0.	2.
1.01	19.00	19	0.01	0.	0.01	16.	1.03	22.00	69	0.	0.	0.	0.	2.
1.01	20.00	20	0.01	0.	0.01	12.	1.03	23.00	70	0.	0.	0.	0.	2.
1.01	21.00	21	0.01	0.	0.01	7.	1.03	0.	71	0.	0.	0.	0.	2.
1.01	22.00	22	0.01	0.	0.01	4.	1.04	1.00	72	0.	0.	0.	0.	2.
1.01	23.00	23	0.01	0.	0.01	3.	1.04	2.00	73	0.	0.	0.	0.	2.
1.02	0.	24	0.01	0.	0.01	3.	1.04	3.00	74	0.	0.	0.	0.	2.
1.02	1.00	25	0.10	0.00	0.10	2.	1.04	4.00	75	0.	0.	0.	0.	2.
1.02	2.00	26	0.10	0.00	0.10	2.	1.04	5.00	76	0.	0.	0.	0.	2.
1.02	3.00	27	0.10	0.00	0.10	2.	1.04	6.00	77	0.	0.	0.	0.	2.
1.02	4.00	28	0.10	0.00	0.10	3.	1.04	7.00	78	0.	0.	0.	0.	2.
1.02	5.00	29	0.10	0.00	0.10	3.	1.04	8.00	79	0.	0.	0.	0.	2.
1.02	6.00	30	0.10	0.00	0.10	3.	1.04	9.00	80	0.	0.	0.	0.	2.
1.02	7.00	31	0.30	0.20	0.10	13.	1.04	10.00	81	0.	0.	0.	0.	2.
1.02	8.00	32	0.30	0.20	0.10	41.	1.04	11.00	82	0.	0.	0.	0.	2.
1.02	9.00	33	0.30	0.20	0.10	73.	1.04	12.00	83	0.	0.	0.	0.	2.
1.02	10.00	34	0.30	0.20	0.10	91.	1.04	13.00	84	0.	0.	0.	0.	2.
1.02	11.00	35	0.30	0.20	0.10	100.	1.04	14.00	85	0.	0.	0.	0.	2.
1.02	12.00	36	0.30	0.20	0.10	104.	1.04	15.00	86	0.	0.	0.	0.	2.
1.02	13.00	37	1.69	1.59	0.10	173.	1.04	16.00	87	0.	0.	0.	0.	2.
1.02	14.00	38	2.02	1.92	0.10	367.	1.04	17.00	88	0.	0.	0.	0.	2.
1.02	15.00	39	2.53	2.43	0.10	674.	1.04	18.00	89	0.	0.	0.	0.	2.
1.02	16.00	40	6.41	6.31	0.10	1113.	1.04	19.00	90	0.	0.	0.	0.	2.
1.02	17.00	41	2.36	2.26	0.10	1635.	1.04	20.00	91	0.	0.	0.	0.	2.
1.02	18.00	42	1.95	1.76	0.10	1723.	1.04	21.00	92	0.	0.	0.	0.	2.
1.02	19.00	43	0.15	0.05	0.10	1333.	1.04	22.00	93	0.	0.	0.	0.	2.
1.02	20.00	44	0.15	0.05	0.10	829.	1.04	23.00	94	0.	0.	0.	0.	2.
1.02	21.00	45	0.15	0.05	0.10	434.	1.05	0.	95	0.	0.	0.	0.	2.
1.02	22.00	46	0.15	0.05	0.10	217.	1.05	1.00	96	0.	0.	0.	0.	2.
1.02	23.00	47	0.15	0.05	0.10	115.	1.05	2.00	97	0.	0.	0.	0.	2.
1.03	0.	48	0.15	0.05	0.10	67.	1.05	3.00	98	0.	0.	0.	0.	2.
1.03	1.00	49	0.	0.	0.	38.	1.05	4.00	99	0.	0.	0.	0.	2.
1.03	2.00	50	0.	0.	0.	22.	1.05	0.	100	0.	0.	0.	0.	2.

SUM 21.58 17.92 3.67 9412.
 (548.) (455.) (93.) (266.52)

PEAK	6-HOUR	24-HOUR	72-HOUR	TOTAL VOLUME
1723.	1108.	384.	130.	9411.
49.	34.	11.	4.	266.
	13.93	17.84	18.13	18.24
	353.80	453.16	460.61	463.27
	574.	761.	773.	778.
	773.	936.	954.	959.

CFS
 CM5
 INCHES
 M-1
 AC-FT
 T-1000 C-1

513.1	513.6	513.2	513.3	513.3	513.4	513.4	513.4	513.4	513.5	513.5
513.0	513.0	513.0	513.7	513.7	513.7	513.8	514.1	514.7	514.4	514.7
514.7	513.0	513.0	513.0	513.0	513.0	513.0	515.0	515.0	515.0	515.0
515.2	513.0	517.0	513.9	513.9	523.2	523.2	529.2	530.7	530.7	531.4
522.2	522.2	522.1	521.3	521.3	530.2	530.2	529.6	529.6	529.2	528.8
520.4	523.2	523.7	527.3	527.3	527.0	526.6	526.3	525.9	525.9	525.6
525.3	523.0	524.4	524.1	524.4	523.9	523.6	523.3	523.1	523.1	522.9
522.0	522.2	522.0	521.6	521.6	521.5	521.4	521.2	521.0	521.0	520.8
520.0	520.3	520.3	520.1	520.1	519.6	519.7	519.5	519.4	519.4	519.3
519.1	519.0	518.9	518.8	518.8	518.5	518.4	518.3	518.2	518.2	518.1

PEAK OUTFLW IS 1735. AT TIME 42.00 HOURS

CFS	1735.	6-HOUR	1201.	24-HOUR	365.	72-HOUR	127.	TOTAL VOLUME	9207.
CMS	49.		54.	10.	4.	4.	261.		
INCIES		13.06	354.66	430.72	17.79	17.79	17.64		
AC-FT		595.	723.	758.	936..	758.	453.20		
THUR: C-1		714.	892.	936..			939.		

PEAK FLOW AND STORAGE (EFD OF PERIOD) SUMMARY FOR MULTIPLE PLAN-RATIO ECONOMIC COMPUTATIONS
 FLOWS IN CUBIC FEET PER SECOND (CUBIC METERS PER SECOND)
 AREA IN SQUARE MILES (SQUARE KILOMETERS)

RATIOS APPLIED TO FLOWS

OPERATION	STATION	AREA	PLAN	RATIO	1	RATIO	2
					0.50		1.00
HYDROGRAPH AT	1	0.80 (0.00)	1	0.80	(24.4)	(1723.	(48.80)
ROUTED TO	2	0.00 (-0.00)	1	0.50	(24.12)	(1735.	(49.12)

LIST OF REFERENCES

APPENDIX E

APPENDIX E

REFERENCES

- 1) U.S. Department of Commerce, Technical Paper No. 40, Rainfall Frequency Atlas of the United States, May 1961.
- 2) Soil Conservation Service, National Engineering Handbook, Section 4, Hydrology, August 1972 (U.S. Department of Agriculture).
- 3) H.W. King and E.F. Brater, Handbook of Hydraulics, 5th edition, McGraw-Hill, 1963.
- 4) T.W. Lambe and R.V. Whitman, Soil Mechanics, John Wiley and Sons, 1965.
- 5) W.D. Thornbury, Principles of Geomorphology, John Wiley and Sons, 1969.
- 6) University of the State of New York, Geology of New York, Education Leaflet 20, Reprinted 1973.
- 7) Cornell University Agriculture Experiment Station (compiled by M.G. Cline and R.L. Marshall), General Soil Map of New York State and Soils of New York Landscapes, Information Bulletin 119, 1977.

APPENDIX F
STABILITY ANALYSES

Design Jones

UNITED STATES DEPARTMENT OF AGRICULTURE
SOIL CONSERVATION SERVICE

Midwest TSC, Soil Mechanics Lab, 800 "J" Street, Lincoln, NE 68508

SUBJ: ENGINEERING - New York, WF-08, Higinbotham Brook

DATE: October 4, 1978

TO: Lloyd E. Thomas
State Conservation Engineer
U.S. Courthouse & Federal Building
100 S. Clinton Street, Room 771
SCS, Syracuse, New York 13260

ATTACHMENTS

1. Form SCS-ENG-354, Soil Mechanics Laboratory Data, 2 sheets
2. Figure 1, Plot of Percent Sodium Versus Total Dissolved Salts, 1 sheet
3. Figure 2, Summary of Pinhole Study, 1 sheet

INTRODUCTION

The index tests and the dispersion tests requested on the 12 samples from the above site have been completed and the results are summarized on the attached data sheet.

DISCUSSION

The laboratory dispersion test (double hydrometer method) and the pinhole test indicate the materials generally have a dispersive clay fraction; however, the "crumb" test and the chemical test generally show the materials to have low dispersion. See the attached Plot of Total Dissolved Salts Versus Percent Sodium, and the test results on the Summary Sheet.

Additional pinhole tests were made on six selected samples. The pinhole tests were made using a 0.01 Normal solution of calcium chloride (CaCl_2) instead of distilled water for the eroding fluid (as in the regular pinhole test) to determine if the material smaller than the 5-micron size (.005 mm) is really dispersive clay or just finely ground rock flour that can be physically eroded like a very fine sand or silt, when water runs over it. Earlier pinhole tests in the laboratory have shown that using flowing water with conductivity greater than that of the pore water fluid in the soil caused no appreciable enlargement of the pinhole in dispersive clay soils; whereas, distilled water erodes the pinhole greatly.

Pinhole tests were also made on the six samples in which the soil was cured in a compacted state for 3 to 5 days to determine if compacting the materials prior to testing would affect the test results.

The results of the additional tests are summarized in the attached figure 2. The tests generally show that the six samples were only slightly less erosive using the calcium chloride solution, so it appears the samples do not contain much highly dispersive clay. Highly dispersive clays would not have eroded significantly using the salt solution.




The pinholes appeared to erode from the exit back through the sample in the classical manner of "piping" as described in most soil mechanics textbooks, rather than failing along the entire length of the hole as in the dispersive clay type of piping.


CONCLUSIONS

The low plasticity materials are highly susceptible to erosion by flowing water. The clay fraction seems to perform like a very fine single-grain material rather than a dispersive clay.

Prepared by:

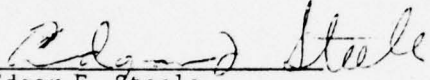
Edgar F. Steele
Civil Engineer

Reviewed and Approved by:


Lorn P. Dunnigan, Head
Soil Mechanics Laboratory

Attachments

cc:


Lloyd E. Thomas, State Conservation Engineer, SCS, Syracuse, NY (3 copies)
Edgar L. Helme, Head, Engineering Staff, NETSC, SCS, Broomall, PA
B. S. Ellis, Geologist, SCS, Syracuse, NY

USDA:SCS:ES Steele:R&CC

MECHANICAL ANALYSIS EXPRESSED AS PERCENT FINER BY DRY WEIGHT										ATTERBERG LIMITS		UNIFIED CLASS- IFICATION	SOLUBLE SALTS %	DIS- PER- SON %	MOISTURE - DENSITY RELATIONSHIPS		UNOBTAINED SAMPLE DATA		SPECIAL TESTS						
SAND		GRAVEL						LL	PI	WATER % CURVE	REL % PCT				W %	W %	W %	W %	W %	W %	W %	W %	W %	W %	
#40	#100	#20	#4	3/8"	1/2"	3/4"	1"	1 1/2"	2"																
72	81	83	89	94	97	99	99	100		21	10	CL- ML	39					823	3.52	7.1	2465	1		ND4	
82	86	90	93	95	96	98	100			24	8	CL	45					525	3.24	7.2	4215	1		ND3	
85	86	89	92	95	96	99	100			24	6	CL ML	52					878	2.51	7.1	3220	1		D2	
82	87	89	92	95	97	99	100			26	10	CL	44					770	2.60	7.2	3715	2		ND3	
89	92	94	96	98	99	100				19	5	CL ML	67					697	2.87	7.3	3790	2		D1	
88	91	93	95	97	98	99	100			18	5	CL ML	61					921	2.17	7.4	3315	1		D2	

FIGURE I

NOTE: PERCENT SODIUM (MEQ./LITER) = $\frac{\text{Na}(100)}{\text{Ca} + \text{Mg} + \text{Na} + \text{K}}$

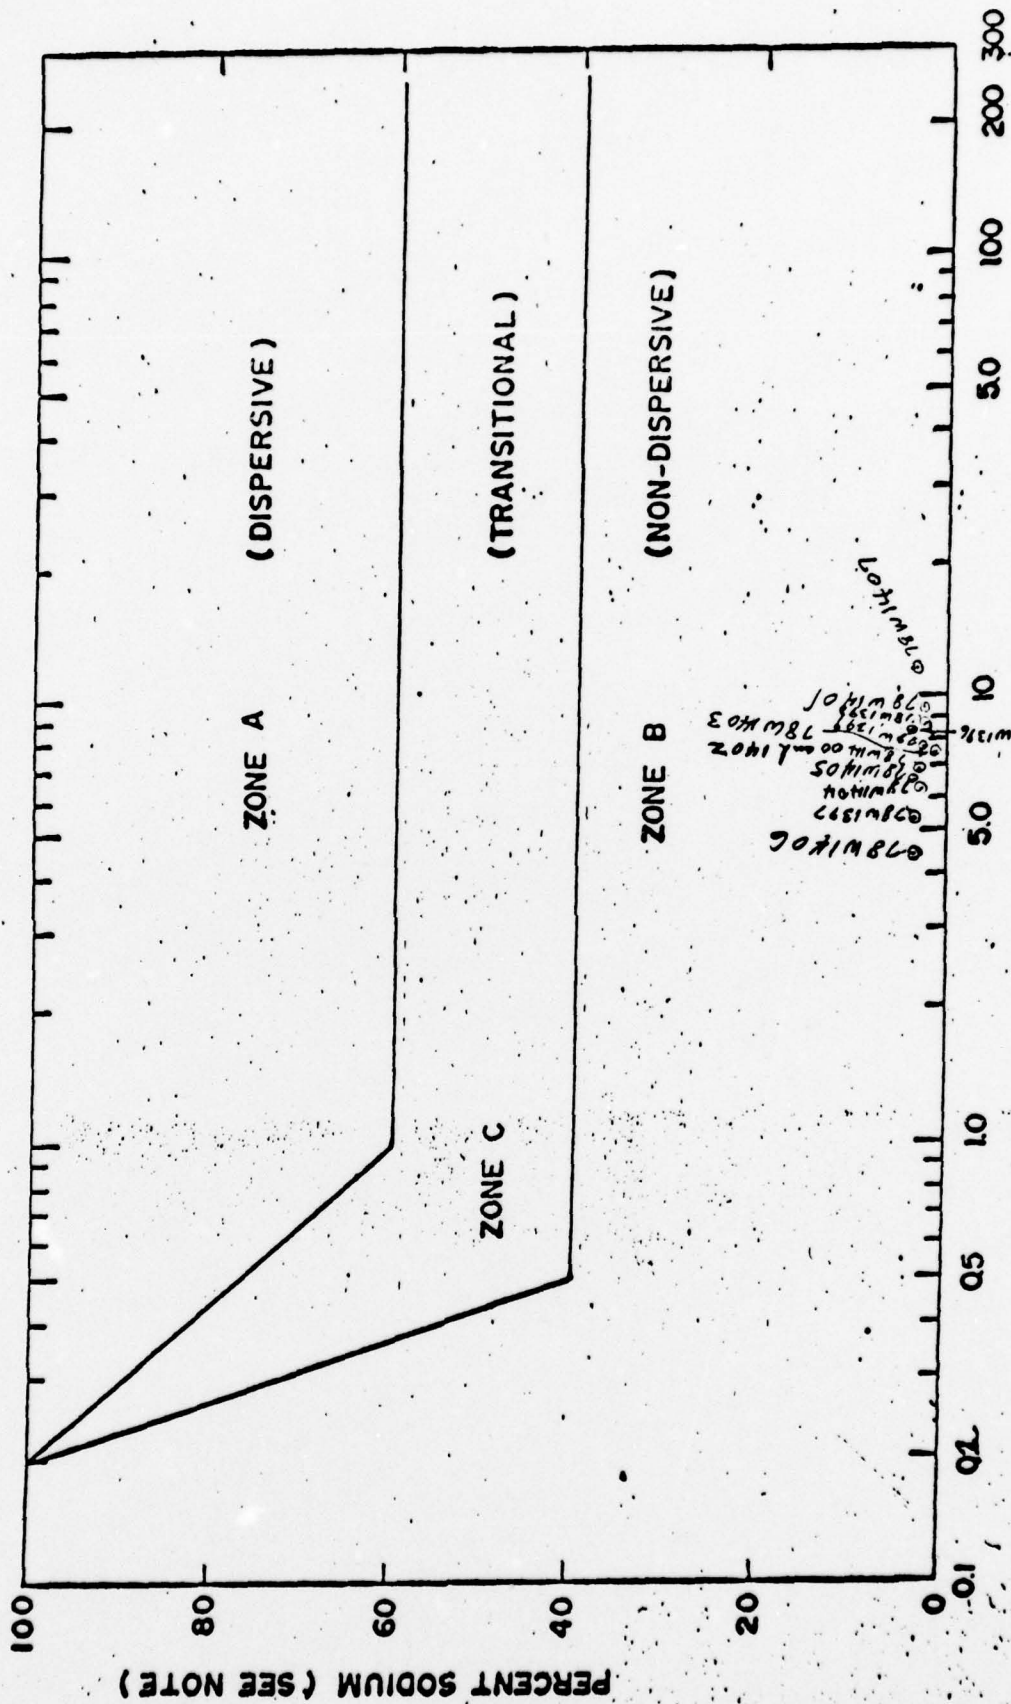

TOTAL DISSOLVED SALTS IN SATURATION EXTRACT IN MILLIEQUIVALENTS PER LITER

(TDS = Ca + Mg + Na + K)

New York Highbotham Brook
 E.F.S. 9/25/78
 Pinhole Evaluation Study

Sample Number	Pinhole Test Results		Tested with 0.01M CaCl ₂ Solution	
	Tested with distilled water	Tested with 0.01M CaCl ₂ Solution	Carving Time	Carving Time
1397	ND3 Carving Time 1 hour Sketch: 3mm, 5mm	ND3 Carving Time 5 days Sketch: 1mm, 2.5mm, 5mm, 10/87"	ND2 Carving Time 1 hr Sketch: 3mm	ND1 Carving Time 3 days Sketch: 1mm
1398	D2 Sketch: 3mm, 5mm	D2 Sketch: 3mm, 2mm, 5mm	ND3 Sketch: 3mm, 4mm, 5mm	ND3 Sketch: 1mm, 2mm, 5mm
1401	D2 Sketch: 3mm, 5mm, 4mm	ND3 Sketch: 3mm, 5mm	ND3 Sketch: 2mm, 4mm, 5mm	ND3 Sketch: 2mm, 5mm
1402	D1 Sketch: 3mm	D1 Sketch: 3mm, 12mm	D2? or ND3 Sketch: 3mm, 12mm	D2? or ND3 Plugged or necked Sketch: 5mm
1403	D1 Sketch: 3mm	ND3 Sketch: 2mm, 6mm	ND3 Sketch: 2mm	ND3 Sketch: 2mm, 5mm
1404	D1 Sketch: 4mm, 6mm	D2 Sketch: 2mm, 2.5mm, 12mm	ND3? Sketch: 3mm, 12mm	ND3 Sketch: 3mm, 12mm

FIGURE 2

UNITED STATES DEPARTMENT OF AGRICULTURE
SOIL CONSERVATION SERVICE - Soil Mechanics Laboratory

800 "J" Street, Lincoln, Nebraska 68508

SUBJECT: ENG 13-18, New York WF-08, Higinbotham Brook
(Madison County)

DATE: May 28, 1975

TO: Donald W. Shanklin
State Conservation Engineer
Soil Conservation Service
Syracuse, New York

ATTACHMENTS

1. Form SCS-ENG-354, Soil Mechanics Laboratory Data, 1 sheet.
2. Form SCS-ENG-355A & B, Triaxial Shear Test Data, 3 tests, 6 sheets.
3. Form SCS-352, Compaction and Penetration Resistance, 3 sheets.

DISCUSSION

The soil mechanics tests requested on the three borrow samples from the above site have been completed and the results of the tests are attached.

The minus No. 4 fractions of Samples B-126 (75W1209) and G-608 (75W1210) are fairly dilatant materials. The shear test specimens had to be molded at optimum moisture content to hold the prestress from the compacting effort.

The shear test results are tabulated below.

Sample No.		Unified Class	Atterberg Limits		Shear Parameters			
Field	Lab.		LL	PI	Total Stress		Effective Stress	
					ϕ°	c, psf	$\bar{\phi}^\circ$	\bar{c} , psf
A-204	75W1208	CL	34	12	14.5	500	35	0
B-126	1209	GC	29	9	14.5	650	27	325
G-608	1210	CL	25	9	12	300	24.5	125

Prepared by:

Edgar F. Steele
Edgar F. Steele
Civil Engineer

Reviewed & Approved by:

Lorn P. Dunnigan
Lorn P. Dunnigan
Head, Soil Mechanics Laboratory

cc:

Donald W. Shanklin (2)
Bernard S. Ellis, Syracuse
Donald E. Wallin, Syracuse
Arthur B. Holland, Upper Darby, PA

Attachments



MATERIALS TESTING REPORT U. S. DEPARTMENT of AGRICULTURE **SOIL CONSERVATION SERVICE** **TRIAxIAL SHEAR TEST**


PROJECT and STATE: HIGHWATER BROOK NEW YORK SAMPLE LOCATION: EMER. SPUR

FIELD SAMPLE NO: A-204.1 DEPTH: 1-2' GEOLOGIC ORIGIN: _____

TYPE OF SAMPLE: COMPACTED TESTED AT: SML-LINCOLN APPROVED BY: _____ DATE: _____

INDEX TEST DATA		SPECIMEN DATA		TYPE OF TEST	
USCS _____	LL <u>34</u> ; PI <u>12</u>	HEIGHT <u>3.0</u> "	DIAMETER <u>1.4</u> "	UU <input type="checkbox"/>	
% FINER (mm): 0.002 <u>23</u> ; 0.005 <u>34</u> ; 0.074 (# 200) <u>62</u>		MATERIALS TESTED PASSED # <u>11</u> SIEVE		CU <input type="checkbox"/>	
G _s (-#4) <u>2.69</u> ; G _s (+#4) _____		METHOD OF PREPARATION <u>STATIC COMPACTED IN 2 LIFTS</u>		CU <input checked="" type="checkbox"/>	
STANDARD: γ _d MAX. <u>105.0</u> pcf ; w ₀ <u>19.5</u> %		MOLDING MOISTURE <u>22.3</u> %		CD <input type="checkbox"/>	
MODIFIED: γ _d MAX. _____ pcf ; w ₀ _____ %		MOLDED AT <u>96.0</u> % OF γ _d MAXIMUM			

DRY DENSITY		B Parameter	MOISTURE CONTENT, %			TIME OF CONSOLIDATION (hrs.)	MINOR PRINCIPAL STRESS σ ₃ (psi)	DEVIATOR STRESS σ ₁ - σ ₃ (psi)	AXIAL STRAIN AT FAILURE, ε (%)
INITIAL pcf <input checked="" type="checkbox"/> g/cc <input type="checkbox"/>	CONSOLIDATED pcf <input type="checkbox"/> g/cc <input type="checkbox"/>		START OF TEST	DEG. OF SAT. AT START OF TEST	END OF TEST				
100.8		0.98	w _i = <u>4.8</u>	24.2	16:83	10	15.7	6.5	
100.8		0.95		23.0	16:17	25	25.2	6.1	
100.7		0.97		22.4	16:95	40	36.8	7.6	

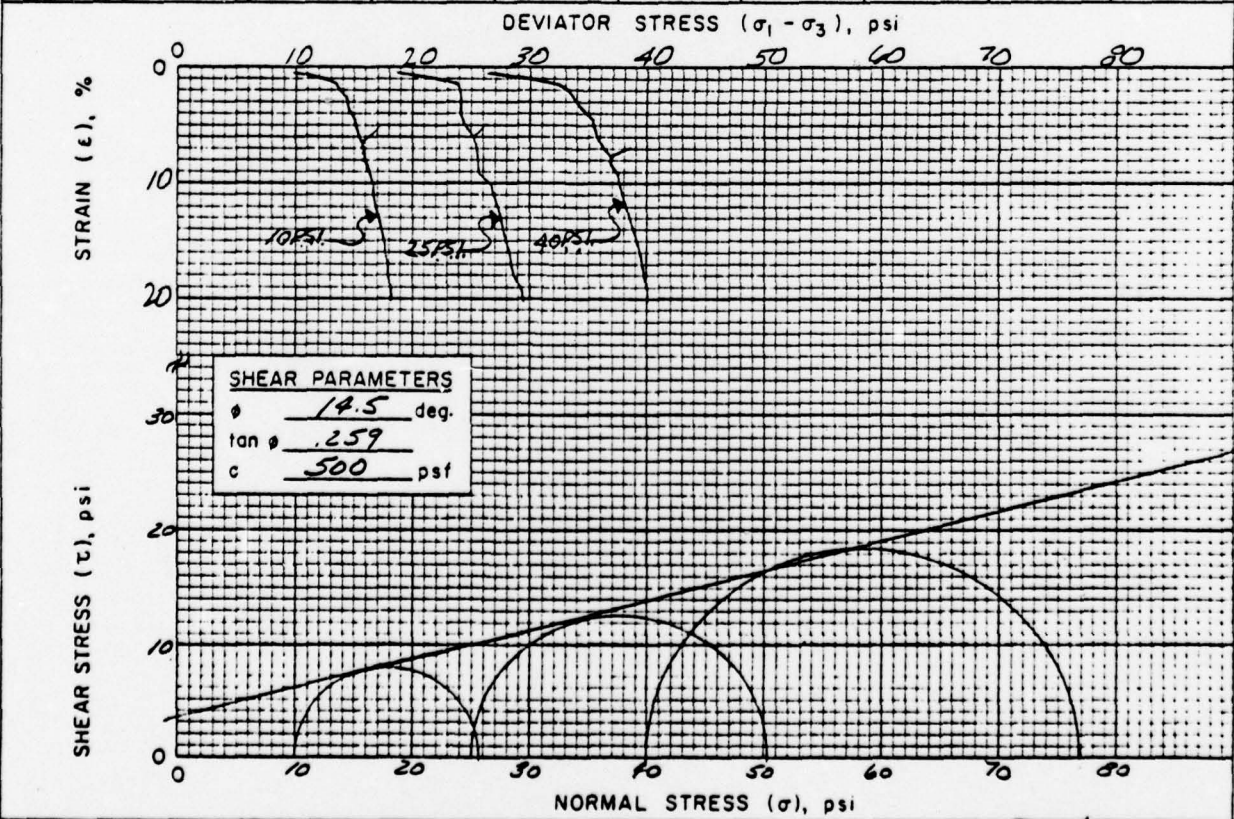


REMARKS BACK-PRESSURED *[Signature]*

MATERIALS TESTING REPORT U. S. DEPARTMENT of AGRICULTURE SOIL CONSERVATION SERVICE **TRIAxIAL SHEAR TEST** with pore pressure measured

PROJECT and STATE: HIGHSTAM BRICK NEW YORK SAMPLE LOCATION: EMER. SPURV.

TYPE OF SAMPLE: COMPACTED TESTED AT: SML-LINCOLN APPROVED BY: _____ DATE: _____

MINOR PRINCIPAL STRESS, σ_3 (psi)	PORE PRESSURE, u (psi)	EFFECTIVE MINOR PRINCIPAL STRESS, $\bar{\sigma}_3$ (psi)	DEVIATOR STRESS, $\sigma_1 - \sigma_3$ (psi)	FAILURE CRITERIA	AXIAL STRAIN AT FAILURE, ϵ (%)
10	4.4	5.6	15.7		6.5
25	14.7	10.3	25.2		6.1
40	25.9	14.1	36.8		7.6

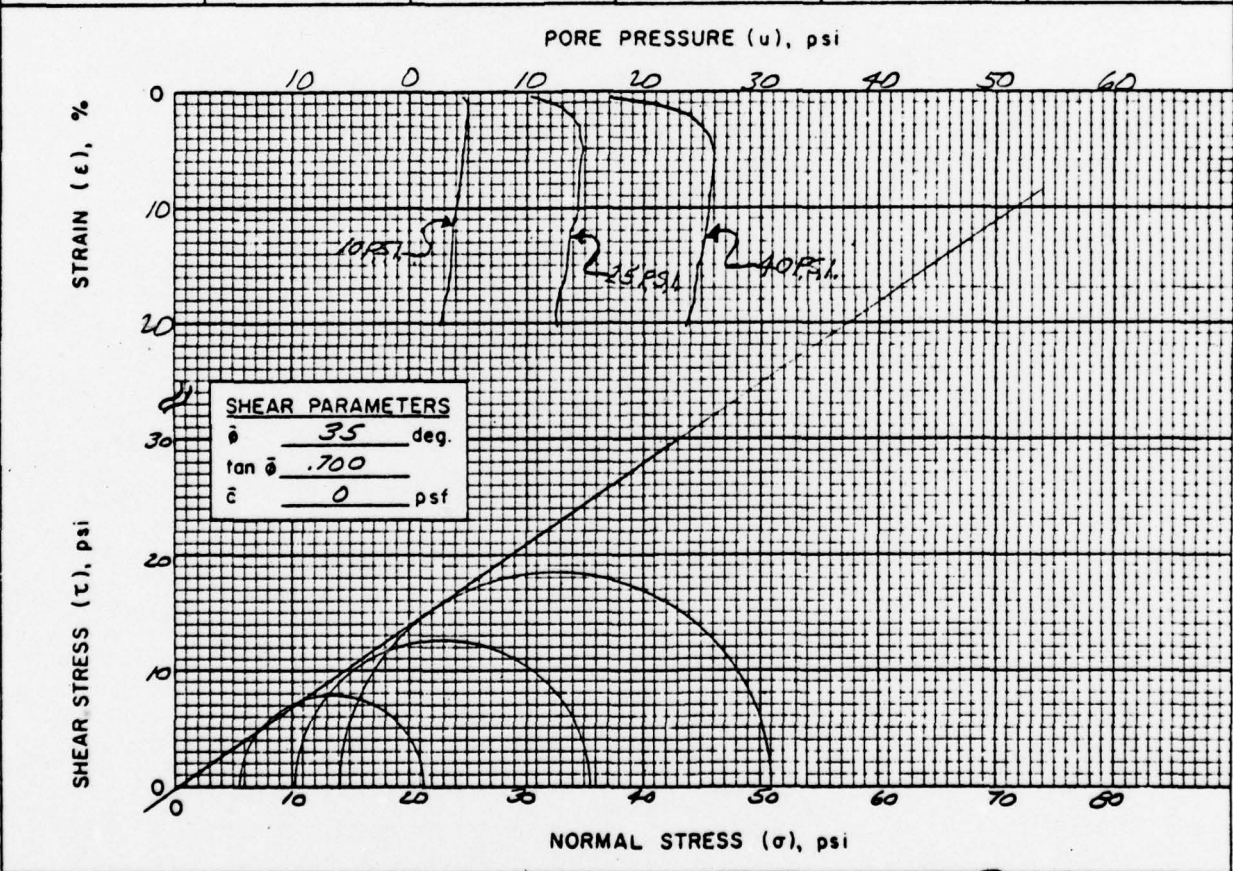

REMARKS BACK-PRESSURED *GHY*

MATERIALS TESTING REPORT U. S. DEPARTMENT of AGRICULTURE SOIL CONSERVATION SERVICE **TRIAxIAL SHEAR TEST**


PROJECT and STATE: HIGINBOTHAM BROOK NEW YORK SAMPLE LOCATION: BORROW

FIELD SAMPLE NO. B-126.1 DEPTH 1.0-11.0' GEOLOGIC ORIGIN _____

TYPE OF SAMPLE COMPACTED TESTED AT SML LINCOLN APPROVED BY _____ DATE _____

INDEX TEST DATA		SPECIMEN DATA		TYPE OF TEST
USCS _____	LL <u>29</u> ; PI <u>9</u>	HEIGHT <u>3.0</u> "	DIAMETER <u>1.4</u> "	UU <input type="checkbox"/>
% FINER (mm): 0.002 <u>11</u> ; 0.005 <u>17</u> ; 0.074 (# 200) <u>28</u>		MATERIALS TESTED PASSED <u>#4</u> SIEVE	METHOD OF PREPARATION <u>STATIC</u>	CU <input type="checkbox"/>
G _s (-#4) <u>2.78</u> ; G _s (+#4) _____		<u>2 LAYER COMPACTION</u>	MOLDING MOISTURE <u>13.5</u> %	CU <input checked="" type="checkbox"/>
STANDARD: γ _d MAX. <u>12.5</u> pcf ; w ₀ <u>13.5</u> %		MOLDED AT <u>94.7</u> % OF γ _d MAXIMUM		CD <input type="checkbox"/>
MODIFIED: γ _d MAX. _____ pcf ; w ₀ _____ %				

DRY DENSITY		B _o Parameter	MOISTURE CONTENT, %			TIME OF CONSOLIDATION (hrs.)	MINOR PRINCIPAL STRESS σ ₃ (psi)	DEVIATOR STRESS σ ₁ - σ ₃ (psi)	AXIAL STRAIN AT FAILURE, ε (%)
INITIAL pcf <input checked="" type="checkbox"/> g/cc <input type="checkbox"/>	CONSOLIDATED pcf <input type="checkbox"/> g/cc <input type="checkbox"/>		START OF TEST	DEG. OF SAT. AT START OF TEST	END OF TEST				
<u>115.1</u>		<u>0.95</u>			<u>17.6</u>	<u>16.08</u>	<u>10</u>	<u>18.0</u>	<u>1.5</u>
<u>115.2</u>		<u>0.97</u>			<u>17.0</u>	<u>17.00</u>	<u>20</u>	<u>25.8</u>	<u>1.5</u>
<u>115.1</u>		<u>0.96</u>			<u>16.7</u>	<u>16.78</u>	<u>30</u>	<u>32.1</u>	<u>1.5</u>

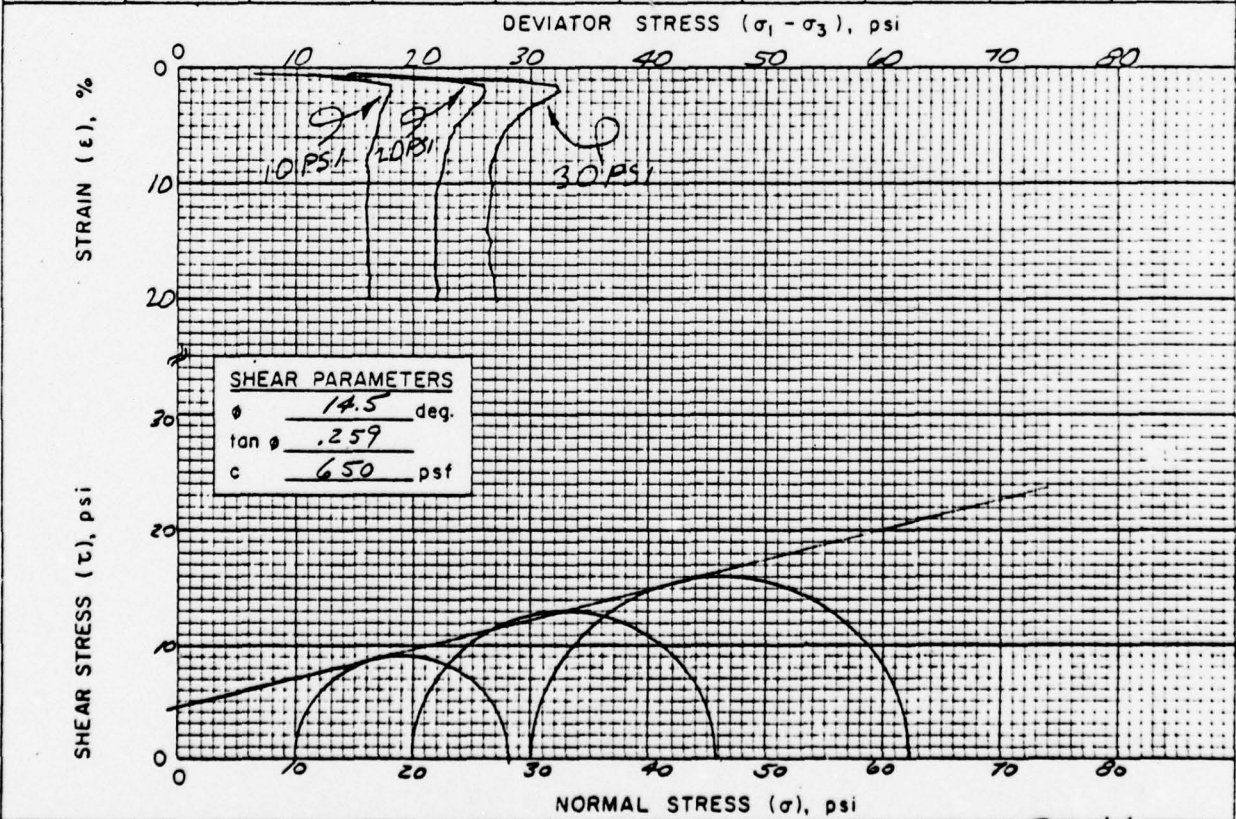


REMARKS BACK-PRESSURED GAH

MATERIALS TESTING REPORT	U. S. DEPARTMENT of AGRICULTURE SOIL CONSERVATION SERVICE	TRIAxIAL SHEAR TEST with pore pressure measured
---------------------------------	--	---

PROJECT and STATE <u>HIGINBOTHAM BROOK NEW YORK</u>	SAMPLE LOCATION <u>BORROW</u>
--	----------------------------------

TYPE OF SAMPLE <u>COMPACTED</u>	TESTED AT <u>SML LINCOLN</u>	APPROVED BY	DATE
------------------------------------	---------------------------------	-------------	------

MINOR PRINCIPAL STRESS, σ_3 (psi)	PORE PRESSURE, u (psi)	EFFECTIVE MINOR PRINCIPAL STRESS, $\bar{\sigma}_3$ (psi)	DEVIATOR STRESS, $\sigma_1 - \sigma_3$ (psi)	FAILURE CRITERIA	AXIAL STRAIN AT FAILURE, ϵ (%)
<u>10</u>	<u>3.7</u>	<u>6.3</u>	<u>18.0</u>		<u>1.5</u>
<u>20</u>	<u>10.8</u>	<u>9.2</u>	<u>25.8</u>		<u>1.5</u>
<u>30</u>	<u>15.4</u>	<u>14.6</u>	<u>32.1</u>		<u>1.5</u>

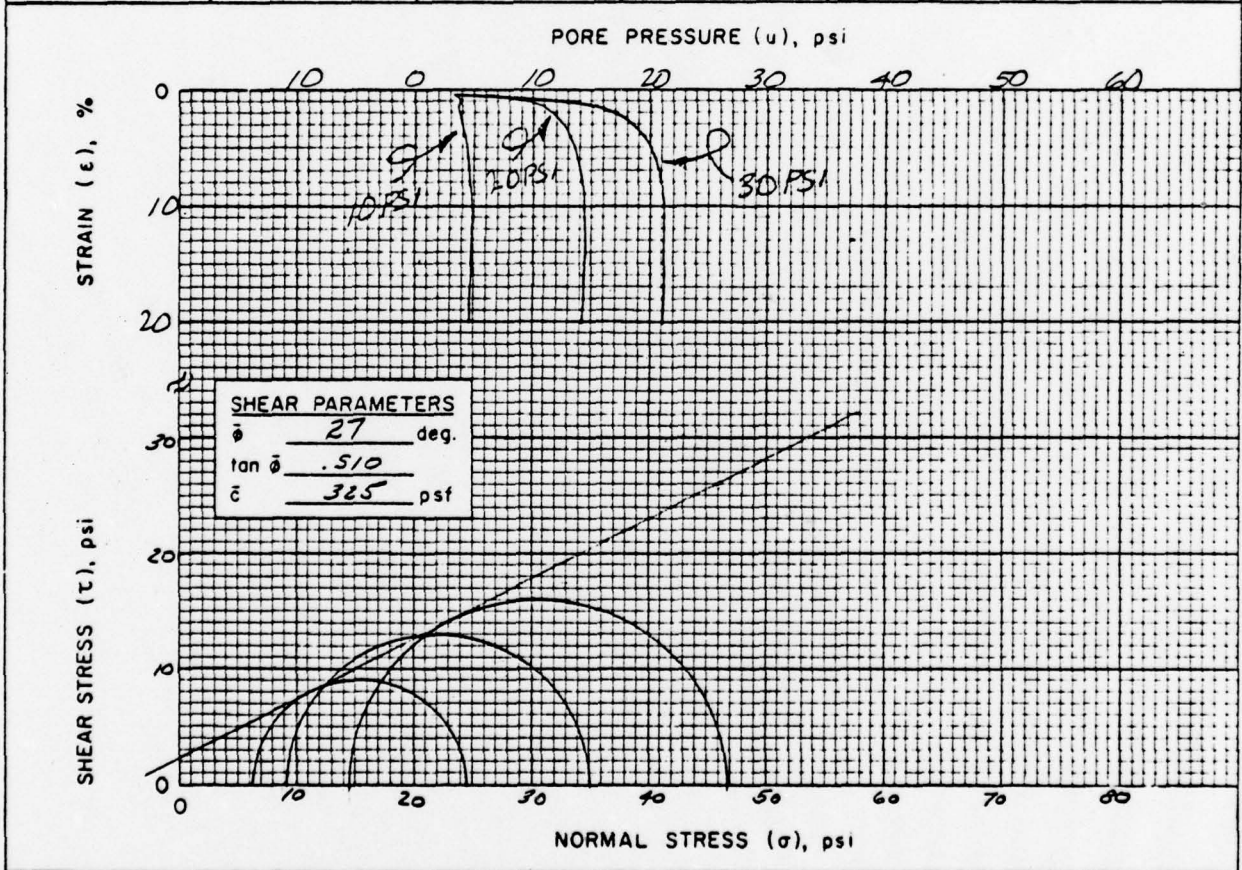

REMARKS BACK-PRESSURED

[Signature]
1978

MATERIALS TESTING REPORT U. S. DEPARTMENT of AGRICULTURE **SOIL CONSERVATION SERVICE** **TRIAxIAL SHEAR TEST**


PROJECT and STATE: HIGHWORTHAM BROOK, NEW YORK SAMPLE LOCATION: DIVERSION

FIELD SAMPLE NO: G-608.1 DEPTH: 1-9' GEOLOGIC ORIGIN:

TYPE OF SAMPLE: COMPACTED TESTED AT: SAN-LINCOLN APPROVED BY: DATE:

INDEX TEST DATA		SPECIMEN DATA		TYPE OF TEST
USCS _____	LL <u>25</u> ; PI <u>9</u>	HEIGHT <u>3.0</u> "	DIAMETER <u>1.4</u> "	UU <input type="checkbox"/>
% FINER (mm): 0.002 <u>24</u> ; 0.005 <u>33</u> ;	0.074 (*200) <u>78</u>	MATERIALS TESTED PASSED <u>#4</u> SIEVE	METHOD OF PREPARATION <u>STATIC</u>	CU <input type="checkbox"/>
G _s (-#4) <u>2.74</u> ; G _s (+#4) _____	STANDARD: γ _d MAX. <u>117.5</u> pcf; w ₀ <u>14.0</u> %	MOLDING MOISTURE <u>13.4</u> %	MOLDED AT <u>94.9</u> % OF γ _d MAXIMUM	CU <input checked="" type="checkbox"/>
MODIFIED: γ _d MAX. _____ pcf; w ₀ _____%				CD <input type="checkbox"/>


DRY DENSITY		B PARAMETER	MOISTURE CONTENT, %			TIME OF CONSOLI- DATION (hrs.)	MINOR PRINCIPAL STRESS σ ₃ (psi)	DEVIATOR STRESS σ ₁ - σ ₃ (psi)	AXIAL STRAIN AT FAILURE, ε (%)
INITIAL pcf <input type="checkbox"/> g/cc <input type="checkbox"/>	CONSOLI- DATED pcf <input type="checkbox"/> g/cc <input type="checkbox"/>		START OF TEST	DEG. OF SAT. AT START OF TEST	END OF TEST				
<u>111.5</u>		<u>0.75</u>		<u>18.7</u>	<u>16:00</u>	<u>10</u>	<u>10.5</u>	<u>1.5</u>	
<u>111.4</u>		<u>0.95</u>		<u>17.9</u>	<u>16:18</u>	<u>20</u>	<u>14.4</u>	<u>1.5</u>	
<u>111.6</u>		<u>0.96</u>		<u>17.0</u>	<u>16:25</u>	<u>30</u>	<u>21.2</u>	<u>2.0</u>	

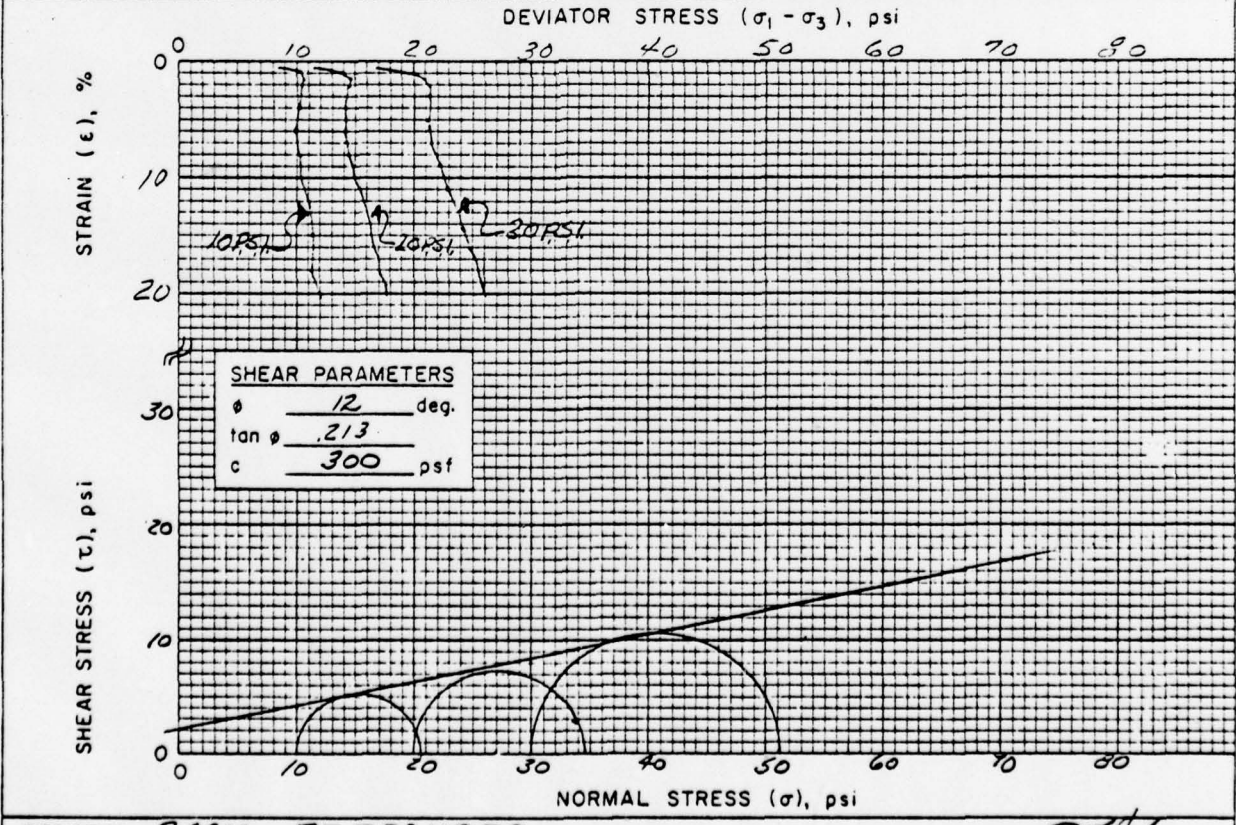

REMARKS BACK-PRESSURED RAH/828

MATERIALS TESTING REPORT U. S. DEPARTMENT of AGRICULTURE SOIL CONSERVATION SERVICE **TRIAxIAL SHEAR TEST** with pore pressure measured

PROJECT and STATE <i>HIGHBORNHAM BROOK, NEW YORK</i>		SAMPLE LOCATION <i>DIVISION</i>			
TYPE OF SAMPLE <i>COMPACTED</i>	TESTED AT <i>SMIL-LINCOLN</i>	APPROVED BY		DATE	
MINOR PRINCIPAL STRESS, σ_3 (psi)	PORE PRESSURE, u (psi)	EFFECTIVE MINOR PRINCIPAL STRESS, $\bar{\sigma}_3$ (psi)	DEVIATOR STRESS, $\sigma_1 - \sigma_3$ (psi)	FAILURE CRITERIA	AXIAL STRAIN AT FAILURE, ϵ (%)
<i>10</i>	<i>4.2</i>	<i>5.8</i>	<i>10.5</i>		<i>1.5</i>
<i>20</i>	<i>10.7</i>	<i>9.3</i>	<i>14.4</i>		<i>1.5</i>
<i>30</i>	<i>17.2</i>	<i>12.8</i>	<i>21.2</i>		<i>2.0</i>

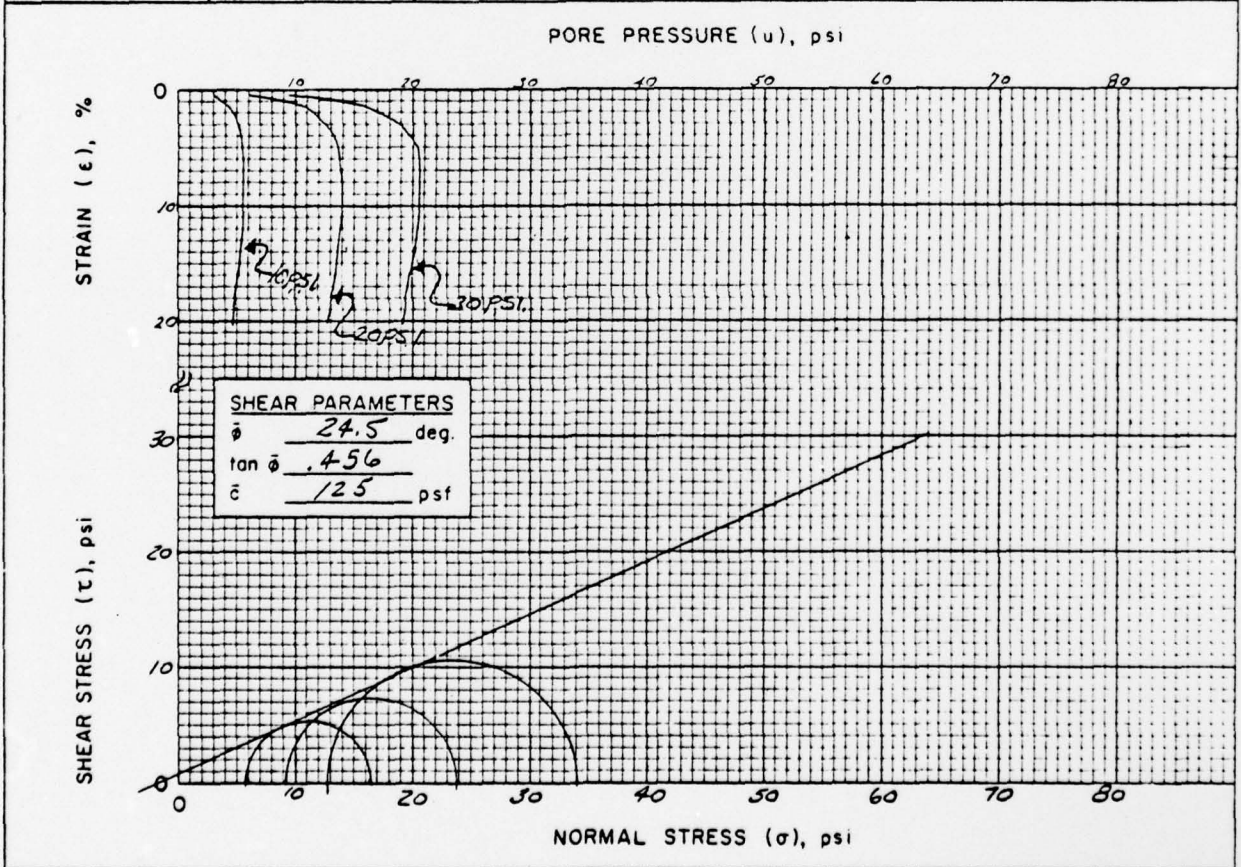

REMARKS *BACK-PRESSURED* *R.H. 2/73*

MATERIALS TESTING REPORT U. S. DEPARTMENT of AGRICULTURE **SOIL CONSERVATION SERVICE** **COMPACTION AND PENETRATION RESISTANCE**

PROJECT and STATE: Higinbotham Brook, New York



FIELD SAMPLE NO: A-2041 LOCATION: Emer. Spillway DEPTH: 1-2'

GEOLOGIC ORIGIN: _____ TESTED AT: SML-LINCOLN APPROVED BY: [Signature] DATE: 5/28/75

CLASSIFICATION: CL LL 34 PI 12 CURVE NO. 1 OF 3

MAX. PARTICLE SIZE INCLUDED IN TEST: < #4 " STD. (ASTM D-698) ; METHOD A

SPECIFIC GRAVITY (G_s) { MINUS NO. 4 2.69 MOD. (ASTM D-1557) ; METHOD _____
PLUS NO. 4 _____ OTHER TEST (SEE REMARKS)

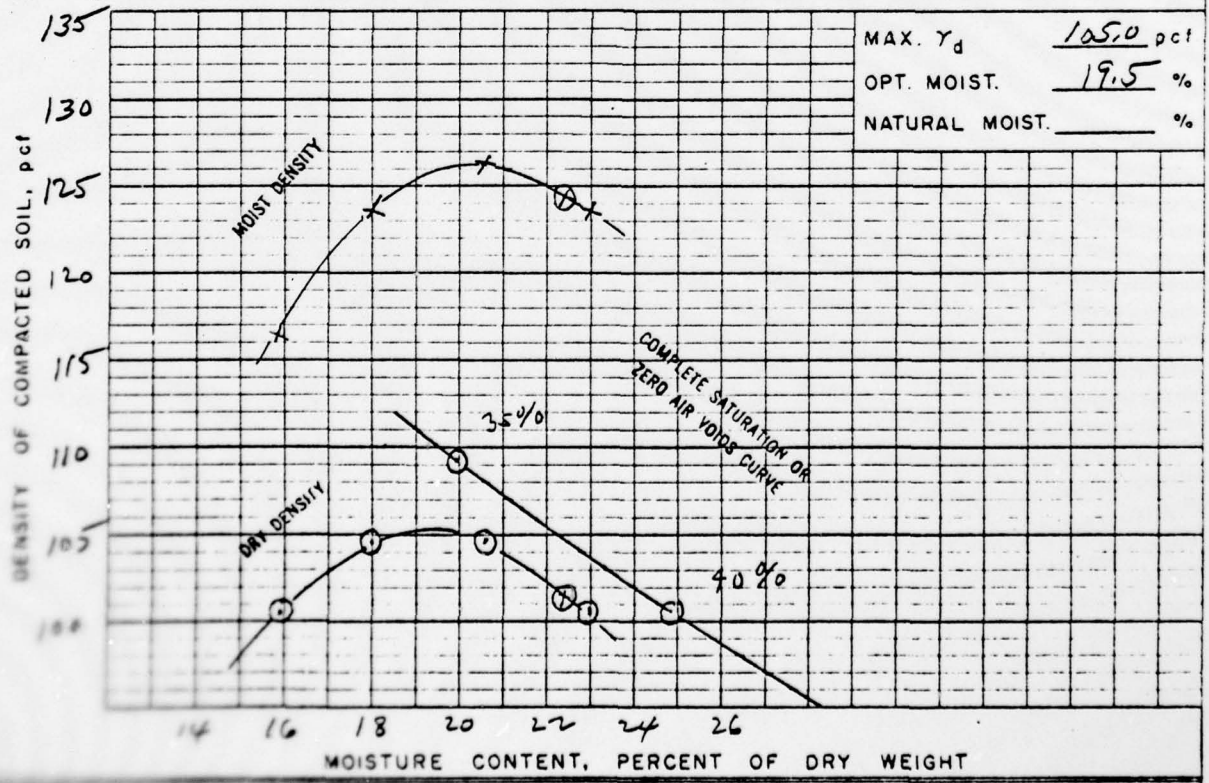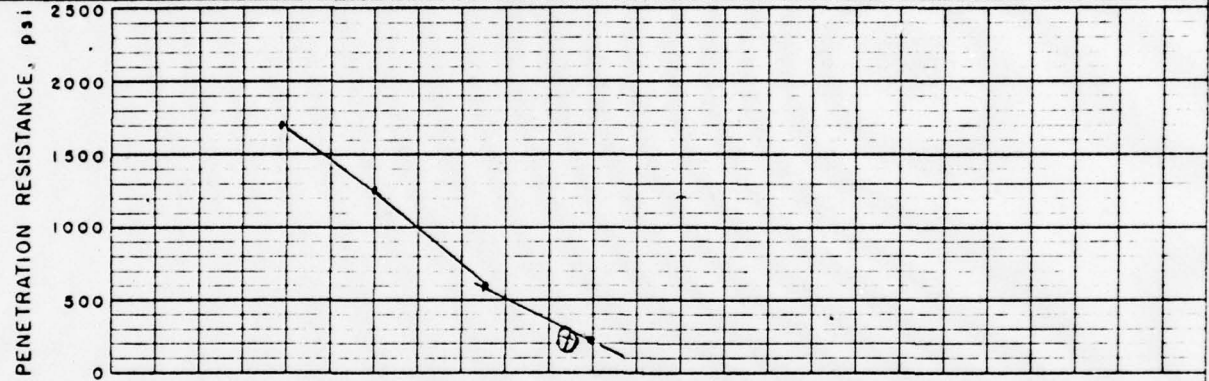

OPT. MOIST. 19.5 %
NATURAL MOIST. _____ %



REMARKS: ① - ② 75w as received.

CURVE IS FOR THE MINUS NO. 4 FRACTION
GRADATION OF TOTAL SAMPLE
< NO. 200 60% ; < NO. 4 85% ; < 3 IN. 100%

MATERIALS TESTING REPORT U. S. DEPARTMENT of AGRICULTURE **SOIL CONSERVATION SERVICE** **COMPACTION AND PENETRATION RESISTANCE**

PROJECT and STATE Higinbotham Brook, New York.
 FIELD SAMPLE NO. B-126.1 LOCATION Borrow. DEPTH 1-11'
 GEOLOGIC ORIGIN _____ TESTED AT SML-LINCOLN APPROVED BY eds DATE 5/16/75

CLASSIFICATION GC LL 29 PI 9 CURVE NO. 2 OF 3
 MAX. PARTICLE SIZE INCLUDED IN TEST #4 " STD. (ASTM D-698) ; METHOD A
 SPECIFIC GRAVITY (G_s) { MINUS NO. 4 2.72 MOD. (ASTM D-1557) ; METHOD _____
 PLUS NO. 4 _____ OTHER TEST (SEE REMARKS)

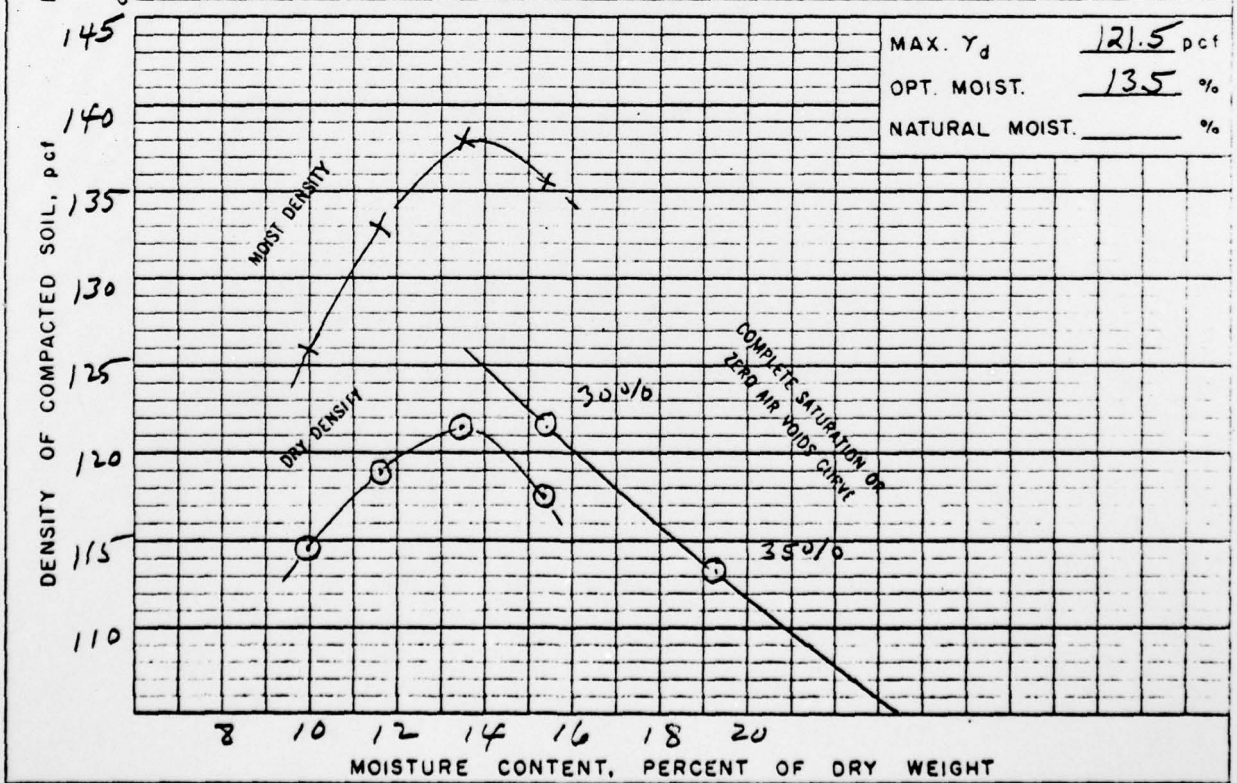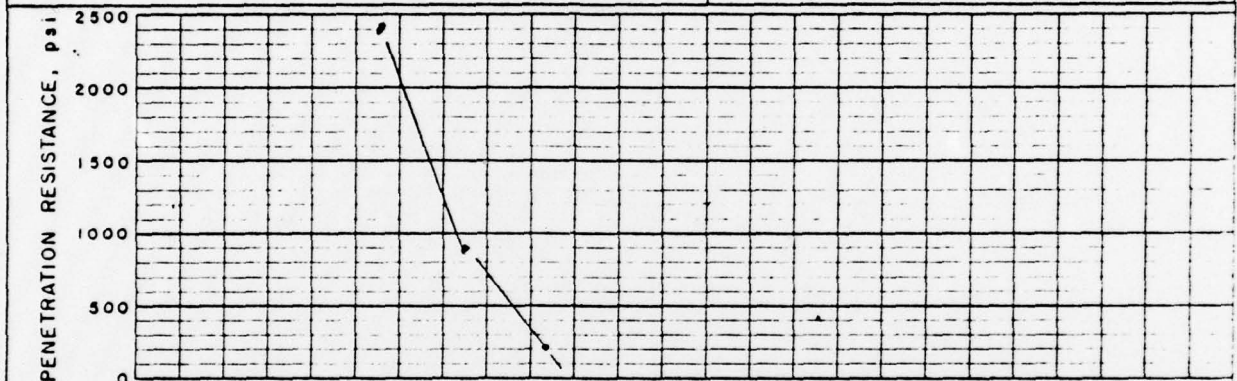

MAX. γ_d 121.5 pcf
 OPT. MOIST. 13.5 %
 NATURAL MOIST. _____ %

REMARKS CURVE IS FOR THE MINUS NO. 4 FRACTION GRADATION OF TOTAL SAMPLE
< NO. 200 27% ; < NO. 4 59% ; < 3 IN. 100%



MATERIALS TESTING REPORT U.S. DEPARTMENT of AGRICULTURE **SOIL CONSERVATION SERVICE** **COMPACTION AND PENETRATION RESISTANCE**

PROJECT and STATE: Higinbotham Brook, New York

FIELD SAMPLE NO: G-608.1 LOCATION: Diversion DEPTH: 1-8'

GEOLOGIC ORIGIN: _____ TESTED AT: SML-LINCOLN APPROVED BY: [Signature] DATE: 5/2/75

CLASSIFICATION: CL LL 25 PI 9 CURVE NO. 3 OF 3
 MAX. PARTICLE SIZE INCLUDED IN TEST: <#4 " STD (ASTM D-698) ; METHOD A
 SPECIFIC GRAVITY (G_s) { MINUS NO. 4: 2.74 MOD (ASTM D-1557) ; METHOD _____
 PLUS NO. 4: _____ OTHER TEST (SEE REMARKS)

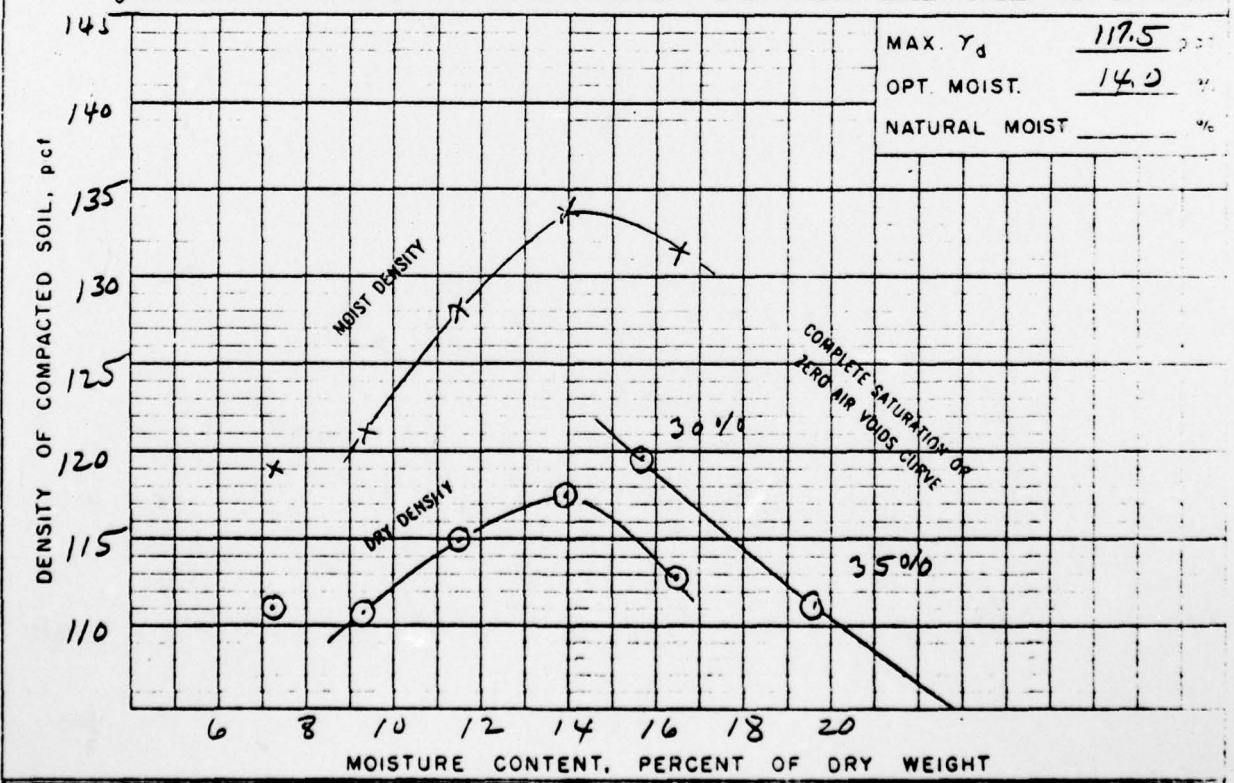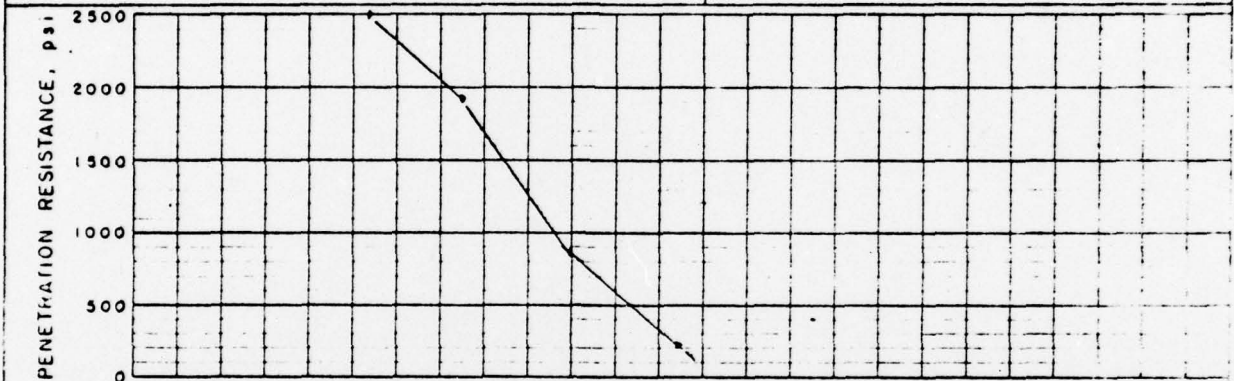

REMARKS

R-379

SLICE	h'	w	T	N
1	2.6	5.8	0	3.2
2	7.4	15.2	1.3	7.7
3	11.0	22.7	2.8	11.0
4	13.6	26.0	5.0	13.5
5	15.3	31.5	7.2	14.0
6	16.7	34.3	8.7	15.7
7	17.8	36.4	9.0	16.0
8	18.9	37.5	8.6	16.8
9	19.0	37.4	7.0	13.7
10	3.1	7.1	5.0	6.3
	Σ	53.4	103.5	

SOIL PROPERTIES
 $\phi = 14^\circ$ $\tan \phi = 0.249$
 $c = 350$
 $\gamma = 105$ $\gamma_{sat} = 105 + (0.377 \times 62.4) = 128.5$
 $\gamma_m = 120$ $\gamma_{sat} = 120 + (0.377 \times 62.4) = 143.5$
 $G_s = 2.70$
 $\gamma_{sat} = 128.5 = 246 \text{ W.G.}$


$$\frac{1}{S.F.} = \frac{\Sigma T}{\Sigma h' \tan \phi + cL}$$

$$L = \frac{c}{\gamma \times 379} = \frac{350}{573 \times 379} = 31 \times 379 = 205'$$

$$\frac{1}{S.F.} = \frac{53.4 (19.6) 62.4}{25.8 (19.6) 62.4 + 71,750} = 0.632$$

$$\frac{1}{S.F.} = \frac{51,554}{103,304} = 0.50$$

SAFETY FACTOR

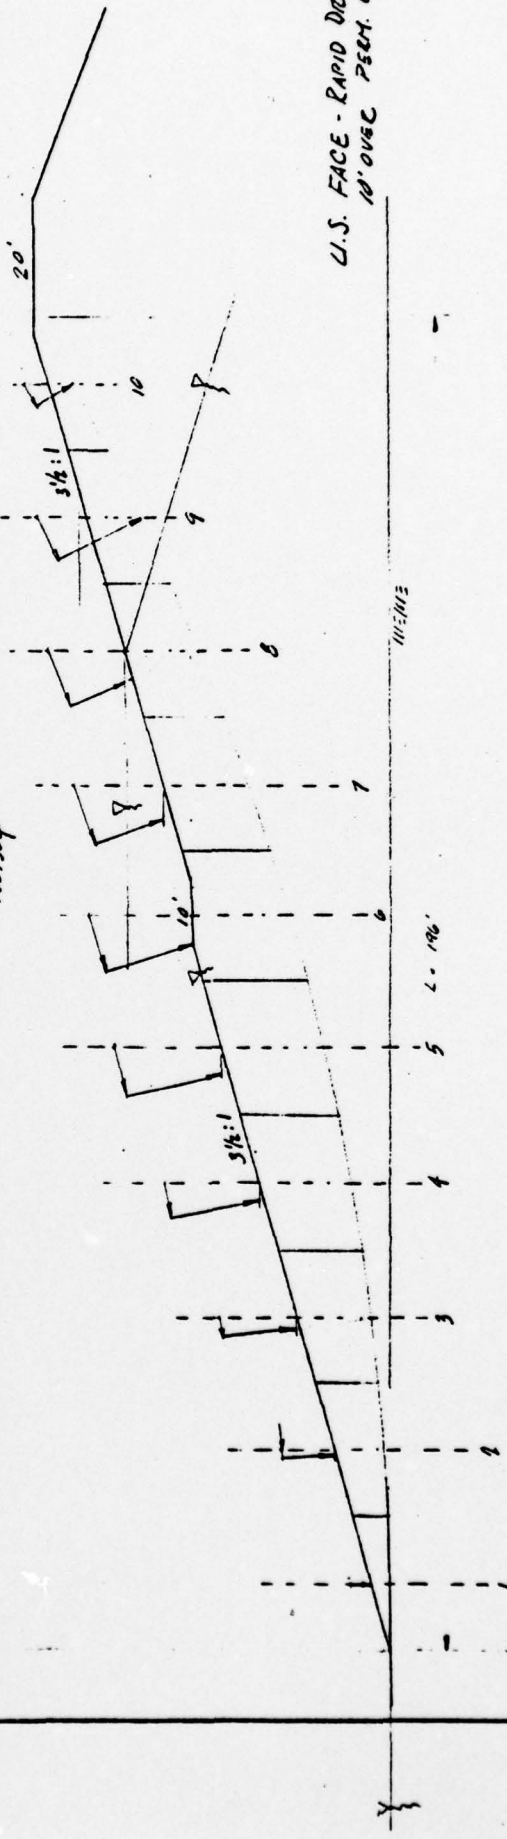

U. S. DEPARTMENT OF AGRICULTURE
 SOIL CONSERVATION SERVICE
 ASSISTING
 SOIL CONSERVATION DISTRICT

DRAWING NUMBER
 SHEET ___ OF ___ SHEETS
 DATE



$\phi = 33^\circ$

$$L = \frac{\sum W}{57.3} = 331$$


$$= 190.6$$

$$S.F. = \frac{\sum \text{Total } N + CL}{\sum T}$$

$$= \frac{17838.0 + 249.162 + 16 + 350 (190.6)}{69.9 \times 62.4 \times 18}$$

$$= \frac{49,566.6 + 66,780}{78,511.7} = 1.465$$

SLICE	h'	W	T	N
1	6.2	4.90	6.2	10.2
2	14.2	27.5	12.2	24.4
3	15.5	30.0	12.0	27.7
4	12.7	24.4	11.8	25.2
5	8.2	17.7	11.1	23.0
6	8.6	14.5	10.6	24.1
7	5.0	8.6	9.8	19.8
8	1.8	2.7	3.8	13.3
9	7.9	16.3	1.4	8.5
10	3.0	6.8	0	2.3
Σ				178.3

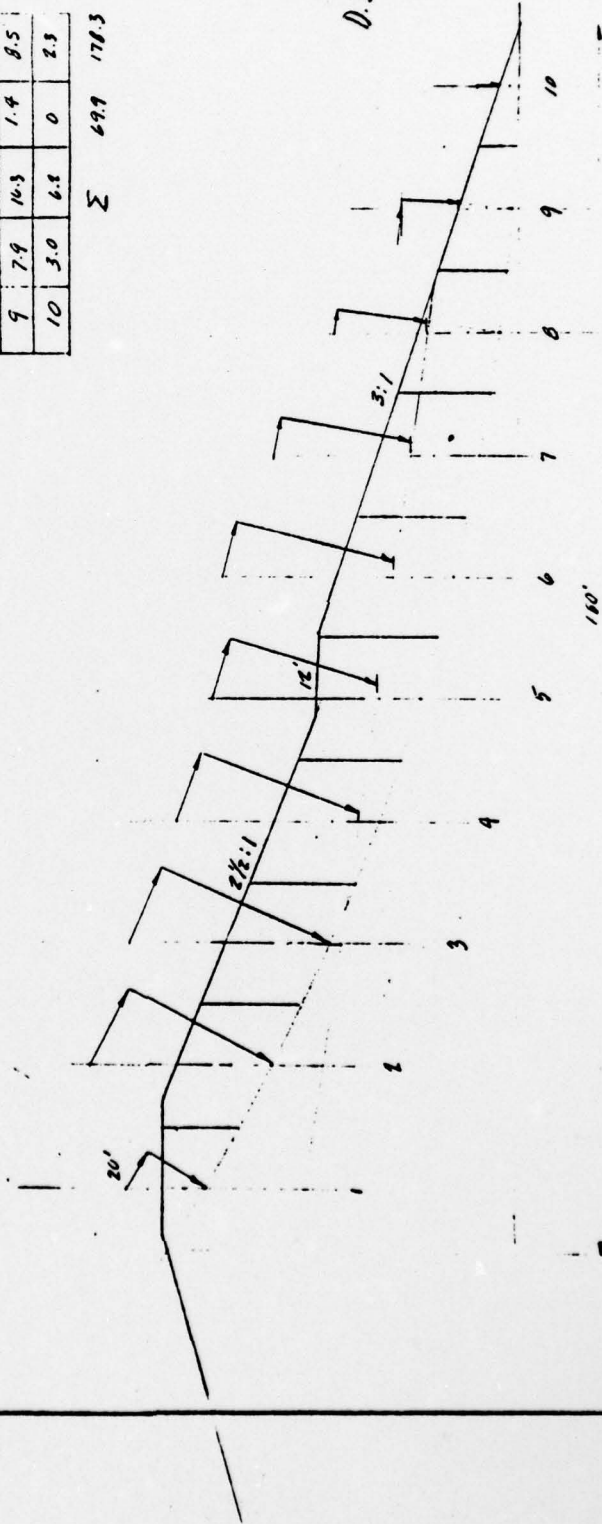

D.S. FACE - STEADY SEEPAGE

REFERENCE

U. S. DEPARTMENT OF AGRICULTURE
SOIL CONSERVATION SERVICE
ASSISTING

SOIL CONSERVATION DISTRICT

DRAWING NUMBER

SHEET --- OF --- SHEETS
DATE

*****ECHO PRINT OF INPUT LISTING*****

NO PLOT
TEMPLATE INFORMATION
MIGINBOINAM BROOK WATERSHED NEW YORK BY JDT 6-16-75 CK MAR 6 18 75 1

1	-9.0	0.0	9.0	0.0	120.0	0.0	0.0	14.0	350.0
2	9.0	0.0	66.0	-22.8	120.0	0.0	0.0	14.0	350.0
3	66.0	-22.8	78.0	-23.3	120.0	0.0	0.0	14.0	350.0
4	78.0	-23.3	168.3	-53.4	120.0	0.0	0.0	14.0	350.0
5	168.3	-53.4	1000.0	-53.4	0.0	0.0	0.0	0.0	0.0
6	168.3	-53.4	115.0	-53.4	0.0	14.0	350.0	0.0	0.0
7	115.0	-53.4	-55.9	-13.4	-128.5	14.0	350.0	14.0	350.0
8	-9.0	0.0	-55.9	-13.4	120.0	0.0	0.0	14.0	350.0
9	-55.9	-13.4	-88.8	-22.8	-128.5	0.0	0.0	14.0	350.0
10	-88.8	-22.8	-98.6	-23.3	-128.5	0.0	0.0	14.0	350.0
11	-98.6	-23.3	-204.2	-53.4	-128.5	0.0	0.0	14.0	350.0
12	-204.2	-53.4	-1000.0	-53.4	0.0	0.0	0.0	0.0	0.0
13	-204.2	-53.4	115.0	-53.4	0.0	14.0	350.0	0.0	0.0

END DATA

GRID INFORMATION

UPSTREAM SLOPE DRANDOWN 10' ABOVE PERMANENT POOL

16

17

ADP-3636 06-20-75

13.

5.

8.

8.

155.

11.

16

Invent
Spf

HIGINBOTHAM BROOK WATERSHED NEW YORK BY JDT 6-16-75 CK WAR 6 18 75

EMBANKMENT AND FOUNDATION INPUT DATA

LINE	FIRST POINT		SECOND POINT		DENSITY IN LBS/CU.FT.	SHEAR PARAMETERS ABOVE LINE		SHEAR PARAMETERS BELOW LINE	
	X	Y	X	Y		PHI	C	PHI	C
LINE 1	-9.0	0.0	9.0	0.0	120.0	0.0	0.	14.0	350.
LINE 2	9.0	0.0	66.0	-22.8	120.0	0.0	0.	14.0	350.
LINE 3	66.0	-22.8	78.0	-23.3	120.0	0.0	0.	14.0	350.
LINE 4	78.0	-23.3	168.3	-53.4	120.0	0.0	0.	14.0	350.
LINE 5	168.3	-53.4	1000.0	-53.4	0.0	0.0	0.	0.0	0.
LINE 6	168.3	-53.4	115.0	-53.4	0.0	14.0	350.	0.0	0.
LINE 7	115.0	-53.4	-55.9	-13.4	-128.5	14.0	350.	14.0	350.
LINE 8	-9.0	0.0	-55.9	-13.4	120.0	0.0	0.	14.0	350.
LINE 9	-55.9	-13.4	-88.8	-22.8	-128.5	0.0	0.	14.0	350.
LINE 10	-88.8	-22.8	-98.0	-23.3	-128.5	0.0	0.	14.0	350.
LINE 11	-98.8	-23.3	-204.2	-53.4	-128.5	0.0	0.	14.0	350.
LINE 12	-204.2	-53.4	-1000.0	-53.4	0.0	0.0	0.	0.0	0.
LINE 13	-204.2	-53.4	115.0	-53.4	0.0	14.0	350.	0.0	0.

0

HIGINBOTHAM BROOK WATERSHED NEW YORK BY JDT 6-16-75 CK WAR 6 18 75

UPSTREAM SLOPE DRAWDOWN 10' ABOVE PERMANENT POOL

ARC INPUT DATA

HORIZONTAL DISTANCE FROM CENTERLINE OF DAM TO LEFT MOST ARC CENTER = -180.0 FT.
 HORIZONTAL DISTANCE BETWEEN ARC CENTERS = 10.0 FT.
 NUMBER OF HORIZONTAL DISTANCES = 8
 VERTICAL DISTANCE FROM TOP OF DAM TO UPPER MOST ARC CENTER = 155.0 FT.
 VERTICAL DISTANCE BETWEEN ARC CENTERS = -10.0 FT.
 NUMBER OF VERTICAL DISTANCES = 8
 DISTANCE BETWEEN ARC RADIUS = 5 FT.
 LINE NUMBER TANGENT TO MINIMUM ARC = 11
 LINE NUMBER TANGENT TO MAXIMUM ARC = 13

MINIMUM SAFETY FACTOR AND ASSOCIATED RADIUS FOR SELECTED ARC CENTERS

VERTICAL DISTANCE	-180.0		-170.0		-160.0		-150.0		-140.0		-130.0		-120.0		-110.0	
	RAD	FS	RAD	FS	RAD	FS	RAD	FS	RAD	FS	RAD	FS	RAD	FS	RAD	FS
155.0	208	1.691	208	1.537	208	1.436	208	1.364	208	1.306	208	1.286	208	1.298	208	1.34E
145.0	198	1.710	198	1.555	198	1.450	198	1.371	198	1.314	198	1.283	198	1.286	198	1.326
135.0	188	1.729	188	1.573	188	1.463	188	1.382	188	1.329	188	1.282	188	1.281	188	1.30E
125.0	178	1.748	178	1.594	178	1.475	178	1.393	178	1.336	178	1.289	178	1.277	178	1.292
115.0	168	1.761	168	1.614	168	1.491	168	1.405	168	1.344	168	1.300	168	1.274	168	1.282
105.0	158	1.769	158	1.631	158	1.509	158	1.421	158	1.357	158	1.311	158	1.277	158	1.275
95.0	148	1.785	148	1.646	148	1.533	148	1.437	148	1.368	148	1.322	148	1.287	148	1.277

AD-A077 425

NEW YORK STATE DEPT OF ENVIRONMENTAL CONSERVATION ALBANY F/G 13/13
NATIONAL DAM SAFETY PROGRAM. HIGINBOTHAM BROOK WATERSHED PROJEC--ETC(U)
SEP 79 @ KOCH DACW51-79-C-0001
NL


UNCLASSIFIED

2 OF 2

AD
A077425



END
DATE
FILMED
12-79
DDC

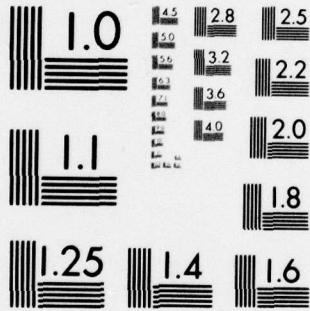

MICROCOPY RESOLUTION TEST CHART
NATIONAL BUREAU OF STANDARDS-1963-A

.....ECHO PRINT OF INPUT LISTING.....

GRID INFORMATION
DUNSTREAM SLOPE STEADY SEEPAGE WITH DRAIN
80. 10. 0. 135. -10. 0. 5. 4. 6. 18
19

.....

Input

MIGINBOTHAM BROOK WATERSHED NEW YORK BY JDT 6-16-75 CK WAR 6 18 75

EMBANKMENT AND FOUNDATION INPUT DATA

LINE	FIRST POINT		SECOND POINT		DENSITY IN LBS/CU.FT.	SHEAR PARAMETERS		SHEAR PARAMETERS	
	X	Y	X	Y		ABOVE LINE PHI	C	BELOW LINE PHI	C
LINE 1	-9.0	0.0	9.0	0.0	120.0	0.0	0.0	14.0	350.
LINE 2	9.0	0.0	66.0	-22.8	120.0	0.0	0.0	14.0	350.
LINE 3	66.0	-22.8	78.0	-23.3	120.0	0.0	0.0	14.0	350.
LINE 4	78.0	-23.3	168.3	-53.4	120.0	0.0	0.0	14.0	350.
LINE 5	168.3	-53.4	1000.0	-53.4	0.0	0.0	0.0	0.0	0.
LINE 6	168.3	-53.4	115.0	-53.4	0.0	14.0	350.	14.0	350.
LINE 7	115.0	-53.4	-55.9	-13.4	-128.5	14.0	350.	14.0	350.
LINE 8	-9.0	0.0	-55.9	-13.4	120.0	0.0	0.0	14.0	350.
LINE 9	-55.9	-13.4	-88.8	-22.8	-128.5	0.0	0.0	14.0	350.
LINE 10	-88.8	-22.8	-98.8	-23.3	-128.5	0.0	0.0	14.0	350.
LINE 11	-98.8	-23.3	-204.2	-53.4	-128.5	0.0	0.0	14.0	350.
LINE 12	-204.2	-53.4	-1000.0	-53.4	0.0	0.0	0.0	0.0	0.
LINE 13	-204.2	-53.4	115.0	-53.4	0.0	14.0	350.	14.0	350.

HIGINBOTHAM BROOK WATERSHED NEW YORK BY JUL 6-16-75 CK WAR 6 18 75

DOWNSTREAM SLOPE STEADY SEEPAGE WITH DRAIN

ARC INPUT DATA

HORIZONTAL DISTANCE FROM CENTERLINE OF DAM TO LEFT MOST ARC CENTER = 80.0 FT.

HORIZONTAL DISTANCE BETWEEN ARC CENTERS = 10.0 FT.

NUMBER OF HORIZONTAL DISTANCES = 8

VERTICAL DISTANCE FROM TOP OF DAM TO UPPER MOST ARC CENTER = 135.0 FT.

VERTICAL DISTANCE BETWEEN ARC CENTERS = -10.0 FT.

NUMBER OF VERTICAL DISTANCES = 8

DISTANCE BETWEEN ARC RADIUS = 5 FT.

LINE NUMBER TANGENT TO MINIMUM ARC = 4

LINE NUMBER TANGENT TO MAXIMUM ARC = 6

MINIMUM SAFETY FACTOR AND ASSOCIATED RADIUS FOR SELECTED ARC CENTERS

VERTICAL DISTANCE	90.0		100.0		110.0		120.0		130.0		140.0		150.0			
	RAD	FS	RAD	FS	RAD	FS	RAD	FS	RAD	FS	RAD	FS	RAD	FS		
135.0	188	1.603	188	1.517	188	1.464	188	1.443	188	1.477	188	1.558	188	1.717	188	1.925
125.0	178	1.573	178	1.489	178	1.444	178	1.435	178	1.486	178	1.586	178	1.760	178	1.970
115.0	168	1.539	168	1.467	168	1.429	168	1.439	168	1.500	168	1.630	168	1.806	168	2.013
105.0	158	1.510	158	1.443	158	1.418	158	1.448	158	1.527	158	1.678	158	1.849	158	2.043
95.0	148	1.481	148	1.425	148	1.417	148	1.460	148	1.564	148	1.722	148	1.892	148	2.054
85.0	138	1.455	138	1.410	138	1.423	138	1.482	138	1.618	138	1.772	138	1.923	138	2.070
75.0	128	1.433	128	1.408	128	1.435	128	1.519	128	1.664	128	1.813	128	1.958	128	2.047

22


65.0 110 1.417 110 1.414 110 1.459 110 1.578 110 1.716 110 1.856 110 1.967 110 2.080

20


20

APPENDIX C

DRAWINGS

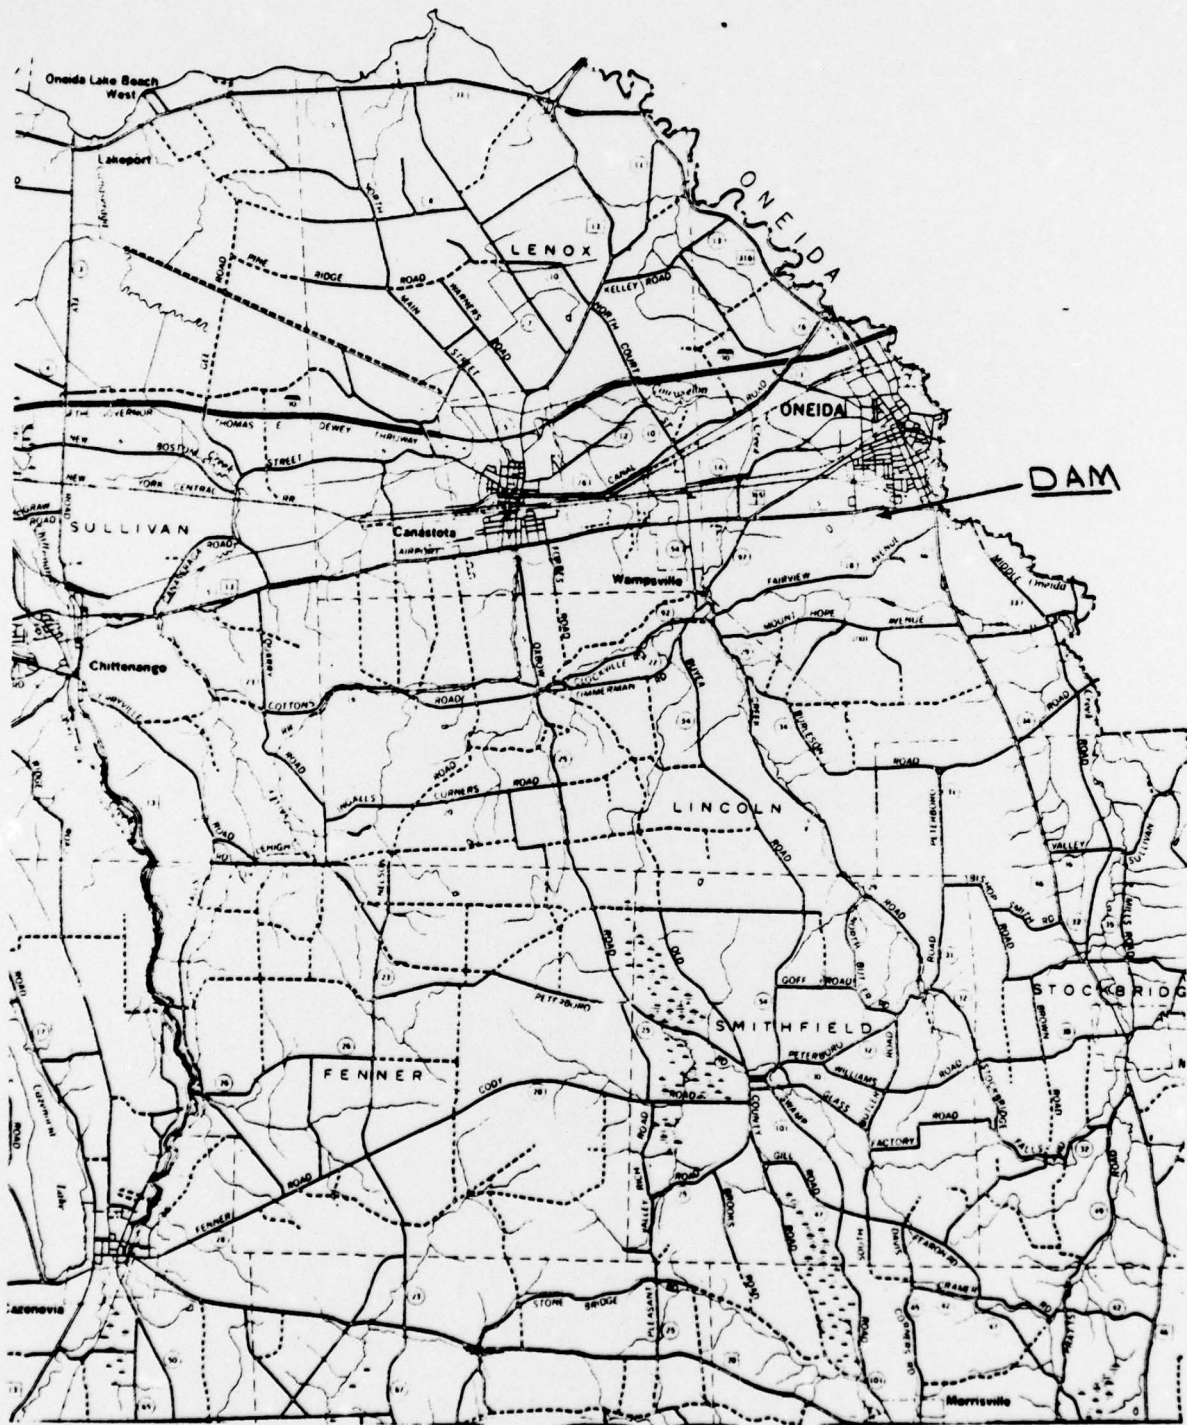


VICINITY MAP

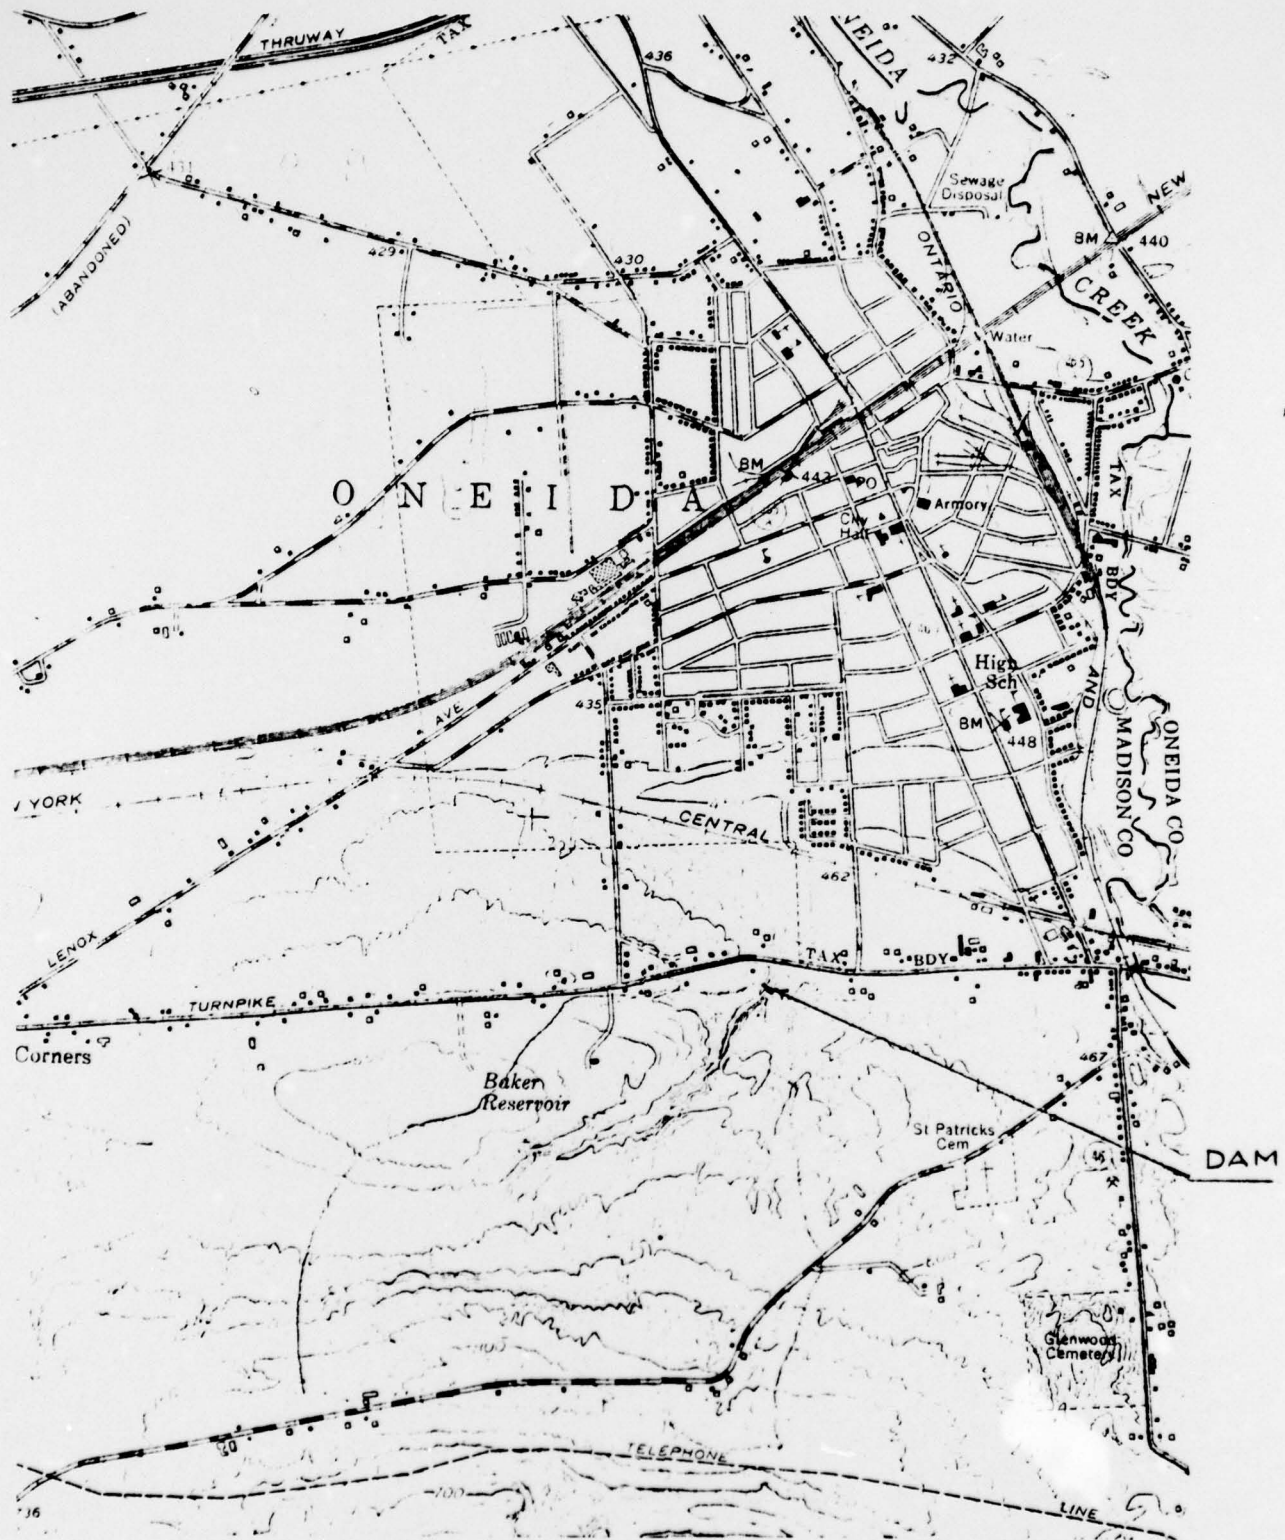


TOPOGRAPHIC MAP

LIST OF DRAWINGS
HIGINBOTHAM BROOK WATERSHED PROJECT

	<u>Drawing # of 30</u>
Plan of Storage Area	2
Plan of Structural Works	3&4
Sediment Basin	5
Diversion	7
Cutoff Trench Excavation	8&9
Emergency Spillway	10
Fill Placement & Principal Spillway - Dam 1	11
Drainage System - Dam 1	12&13
Plan Profile of Principal Spillway	14
Riser Structural Details	15
Principal Spillway Conduit Details	20
Reservoir Drain Conduit Details	21
Log of Test Holes	24&25

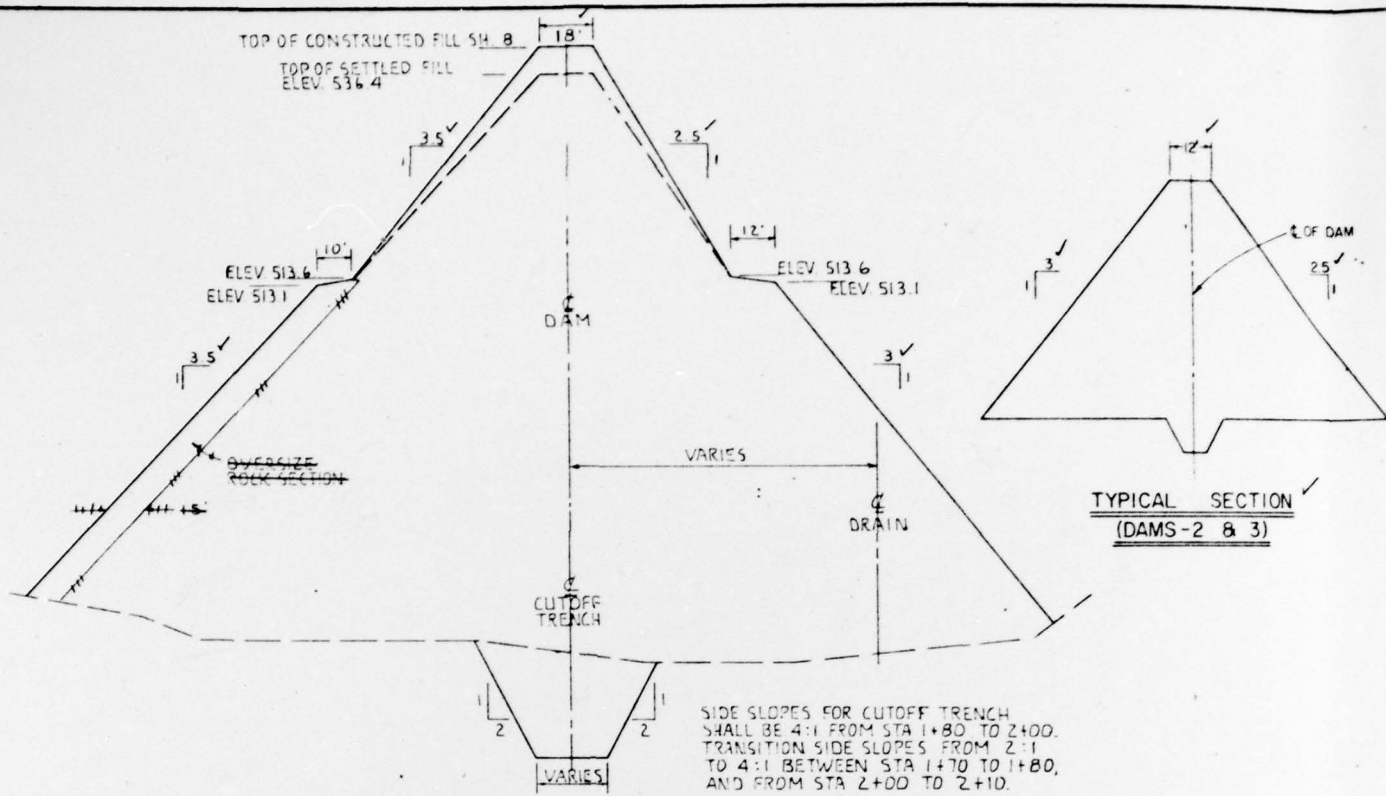

TYPICAL SECTION OF DAM-1

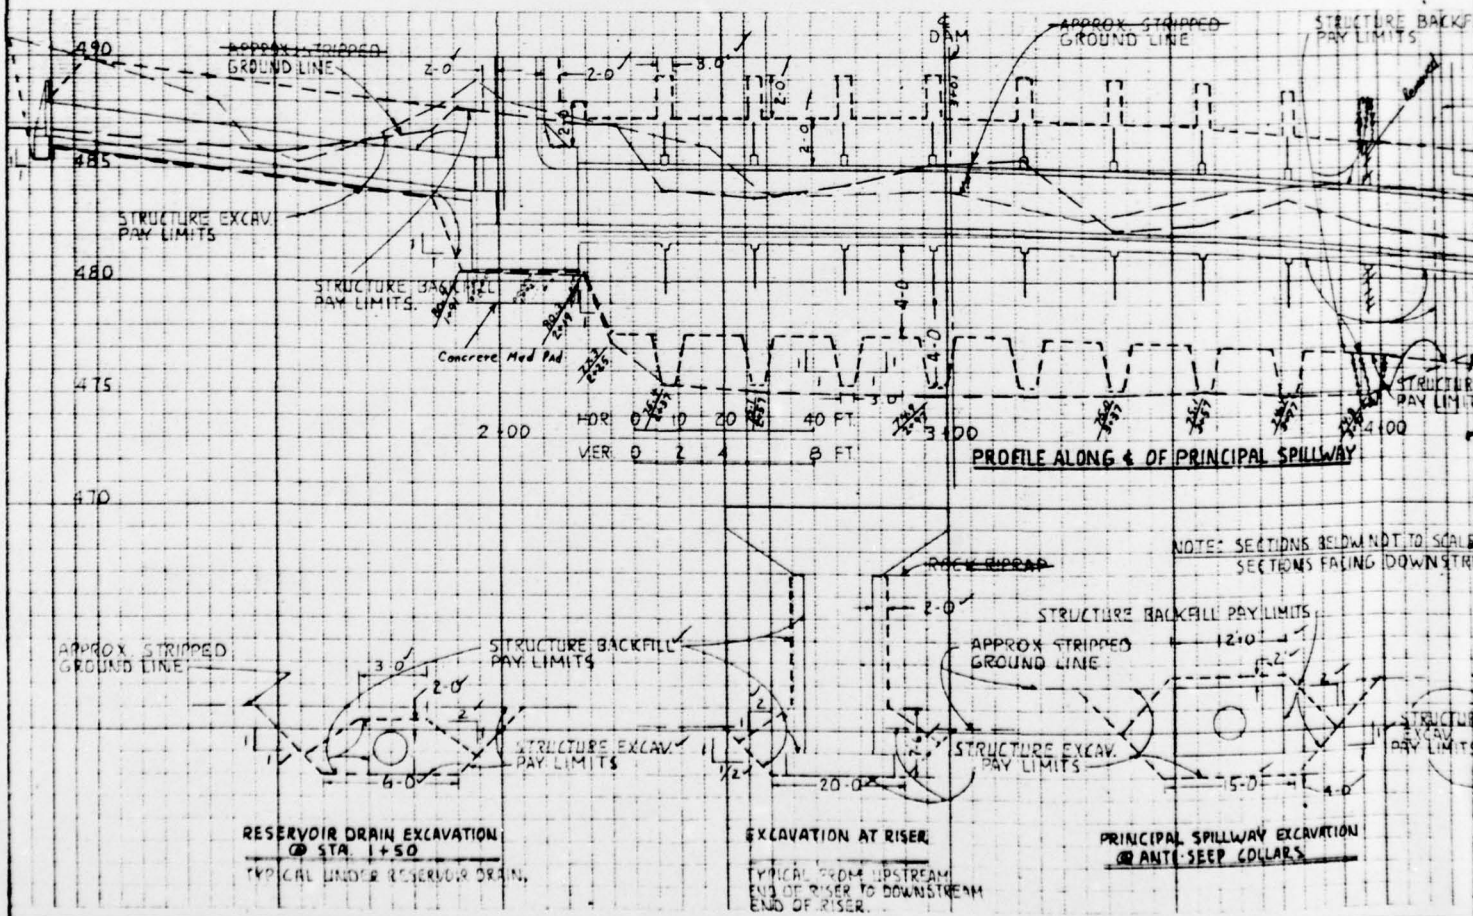



EARTH FILL REQUIREMENTS FOR DAM-1, 2, & 3

MATERIAL 1/	MAX. ROCK SIZE 2/	MAXIMUM LIFT THICKNESS 3/	MINIMUM REQUIRED WATER CONTENT 4/	COMPACTION 5/	
				CLASS	DEFINITION
CL-ML, SC-SM, GC-GW AND GC-GM MATERIALS AS REPRESENTED BY: TP 608 FROM 1' TO 8' TP 204 FROM 1' TO 2' TP 302 FROM 0' TO 3' TP 126 FROM 1' TO 11'	6"	9"	2% BELOW OPTIMUM	A	100% OF MAXIMUM DENSITY BY ASTM-D-698

- ✓ 1/ THE PLACEMENT TABLE INDICATES ESTIMATED USE OF MATERIALS.
- ✓ 2/ A) MAXIMUM ROCK SIZE IN STRUCTURE BACKFILL COMPACTED BY MEANS OF MANUALLY DIRECTED POWER TAMPERS OR PLATE TAMPERS SHALL BE 3".
B) OVERSIZE MATERIAL (OVER 6"), AND SHALE FRAGMENTS PLACED IN THE EARTH FILL SHALL BE RAKED TO THE PORTION OF THE DAM LABELED **OVERSIZE ROCK SECTION** AS SHOWN ON THE DRAWING.
- ✓ 3/ MAXIMUM LIFT THICKNESS PRIOR TO COMPACTION THE MAXIMUM LIFT THICKNESS OF THE **OVERSIZE ROCK SECTION** SHALL BE NO GREATER THAN 18" PRIOR TO COMPACTION. **NO OVERSIZED SECTION.**
- ✓ 4/ WATER CONTENT AT TIME OF COMPACTION.
- ✓ 5/ USE CLASS "C" COMPACTION IN AREA OF THE DAM CONTAINING OVERSIZE MATERIAL. CLASS "C" COMPACTION SHALL CONSIST OF A MINIMUM OF THREE PASSES PER LIFT OF FILL BY A TAMPING ROLLER EXERTING A MINIMUM CONTACT PRESSURE OF 450 PSI OR EQUIVALENT, AS APPROVED BY THE ENGINEER. THE FINAL NUMBER OF PASSES REQUIRED WILL BE DETERMINED BY THE ENGINEER IN THE FIELD.

CONSTRUCTION DETAILS

- ✓ 1. OVERSIZE ROCK SECTION BOUNDARY IS APPROXIMATE, ADJUSTMENTS WILL BE MADE BY THE ENGINEER TO UTILIZE AVAILABLE MATERIAL.
- ✓ 2. MATERIAL PLACED IN THE OVERSIZE ROCK SECTION SHALL CONSIST OF OVERSIZE MATERIAL RAKED FROM THE EARTH FILL, AND SHALE FRAGMENTS FROM THE REQUIRED EXCAVATIONS.
- ✓ 3. TOPSOIL THAT IS SUITABLE FOR USE AND NOT USED ON THE SPECIFIED AREAS OF THE EMERGENCY SPILLWAY SHALL BE INCORPORATED WITHIN THE SLOPES OF THE EARTH FILL AS DIRECTED BY THE ENGINEER. THE SOURCE OF THE TOPSOIL SHALL BE WITHIN THE REQUIRED EXCAVATION.
- ✓ 4. THE LIMITS OF STRUCTURE BACKFILL WILL BE MEASURED TO OUTSIDE FACE OF RISER, AT MAXIMUM WALL THICKNESS, AS SHOWN ON THIS SHEET.

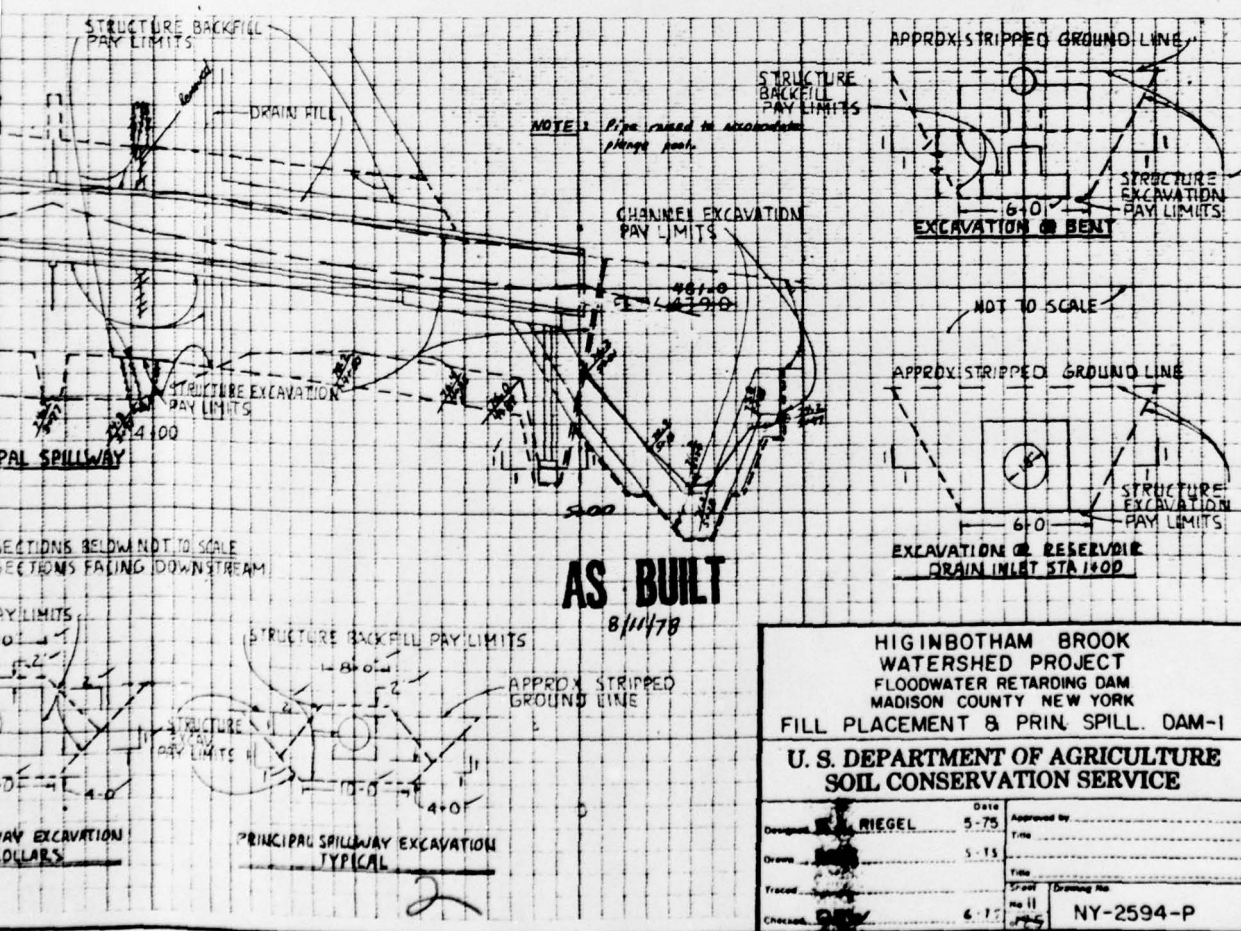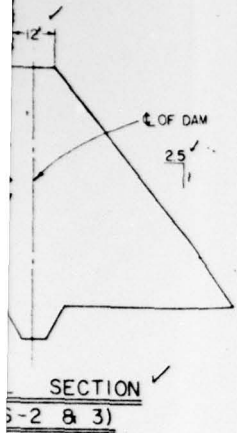

HIGINBOTHAM BROOK WATERSHED PROJECT
FLOODWATER RETARDING DAM
MADISON COUNTY NEW YORK

FILL PLACEMENT & PRIN. SPILL. DAM-1

U. S. DEPARTMENT OF AGRICULTURE
SOIL CONSERVATION SERVICE

Designed by	RIEDEL	Date	5-75	Approved by	
Drawn		Date	5-75	Title	
Checked		Date	6-75	Sheet	No 11
				Drawing No.	NY-2594-P

63-490-117, Rev. 1-60

DRAINAGE SYSTEM DETAILS


- ✓ 1. ASBESTOS-CEMENT DRAIN PIPE SHALL CONFORM TO SPECIFICATION 545 AND SHALL BE 8 INCH DIA. PRESSURE PIPE CLASS 200.
- ✓ 2. PROFILES AT THE BOTTOM OF ALL EXCAVATIONS ARE APPROXIMATE. THE REQUIRED FINISHED GRADES WILL BE ESTABLISHED IN THE FIELD BY THE ENGINEER AT THE TIME OF CONSTRUCTION.

QUANTITY SUMMARY


- 335 ~~225~~ CU. YDS. DRAIN FILL I (FINE)
- 202 ~~234~~ CU. YDS. DRAIN FILL II (COARSE)
- 158 ✓ L.F. STRAIGHT SECTION OF 8 INCH DIA. PERFORATED ASBESTOS-CEMENT PIPE.
- 47 ✓ L.F. STRAIGHT SECTION OF 8 INCH DIA. NON-PERFORATED ASBESTOS-CEMENT PIPE.
- 2 ✓ END CAPS.
- 1 ✓ 45° BEND-8 INCH DIA. CAST IRON
- 1 ✓ 90° BEND-8 INCH DIA. CAST IRON

GRAIN SIZE DISTRIBUTION FOR DRAIN FILL

- ✓ 1. DRAIN FILL I (FINE) SHALL MEET THE GRADATION OF ASTM C33-67 FOR FINE AGGREGATE. IN ADDITION, THE PERCENTAGE OF MATERIAL IN DRAIN FILL I FINER THAN A #200 SIEVE SHALL NOT BE MORE THAN 3%.
- ✓ 2. DRAIN FILL II (COARSE) SHALL MEET THE GRADATION OF SIZE DESIGNATION 1 AS SHOWN IN TABLE 703-4 OF THE JAN. 2, 1973 STANDARD SPECIFICATIONS OF THE NEW YORK STATE DEPARTMENT OF TRANSPORTATION. IN ADDITION, THE PERCENTAGE OF MATERIAL IN DRAIN FILL II FINER THAN A #200 SIEVE SHALL NOT BE MORE THAN 3%.

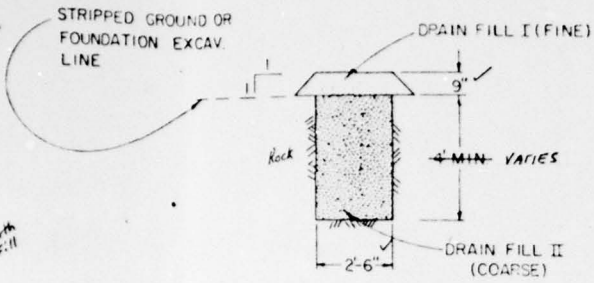



SECTION B-B & E-E

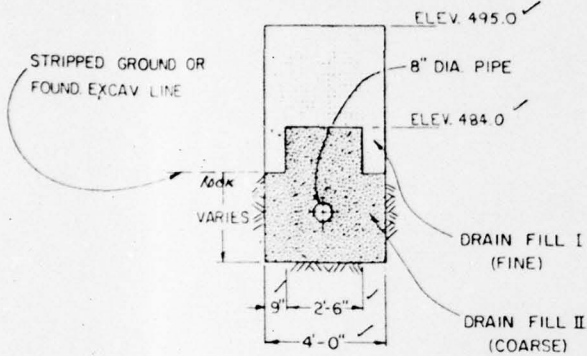

SECTION C-C & D-D

APPROX STA 0+55' LEFT, TO STA 0+50' RIGHT

NOT TO SCALE

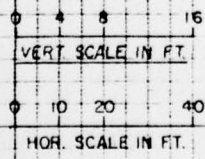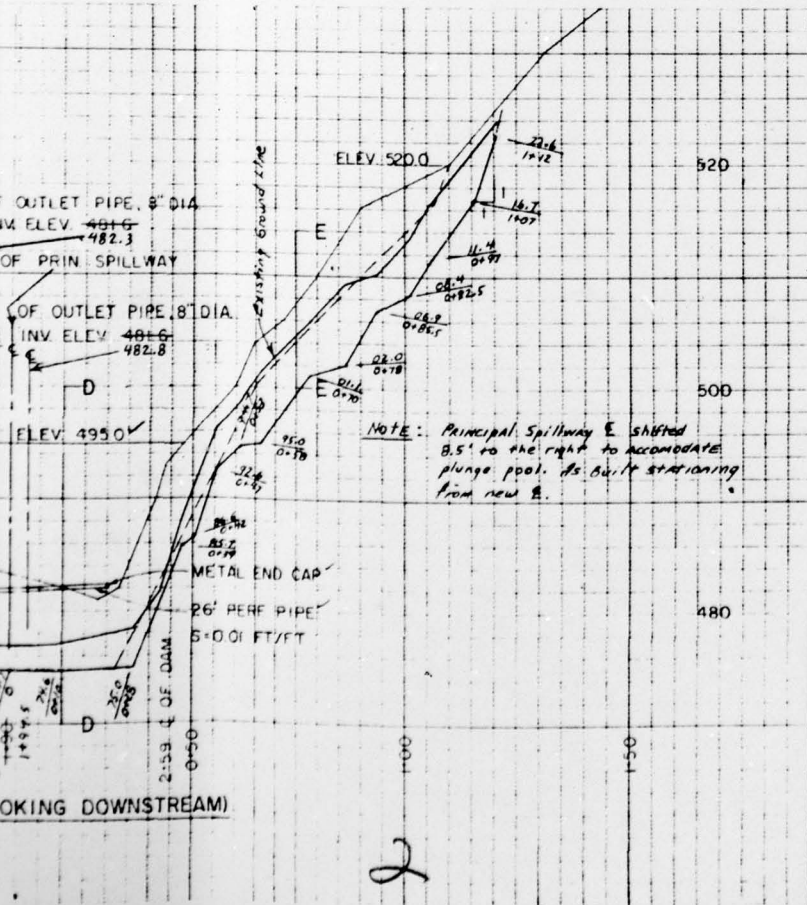


AS BUILT
8/11/78


HIGINBOTHAM BROOK WATERSHED PROJECT
FLOODWATER RETARDING DAM
MADISON COUNTY NEW YORK
DRAINAGE SYSTEM-DAM-1

U. S. DEPARTMENT OF AGRICULTURE
SOIL CONSERVATION SERVICE


Designed	W. A. RIEGEL	Date	5-75	Approved by	
Drawn		Title			
Traced	R. J. KELLEY	Date	5-75	Street	
Checked	D. E. W.	Date	5-75	Sheet No. 12	Drawing No. NY-2594-P

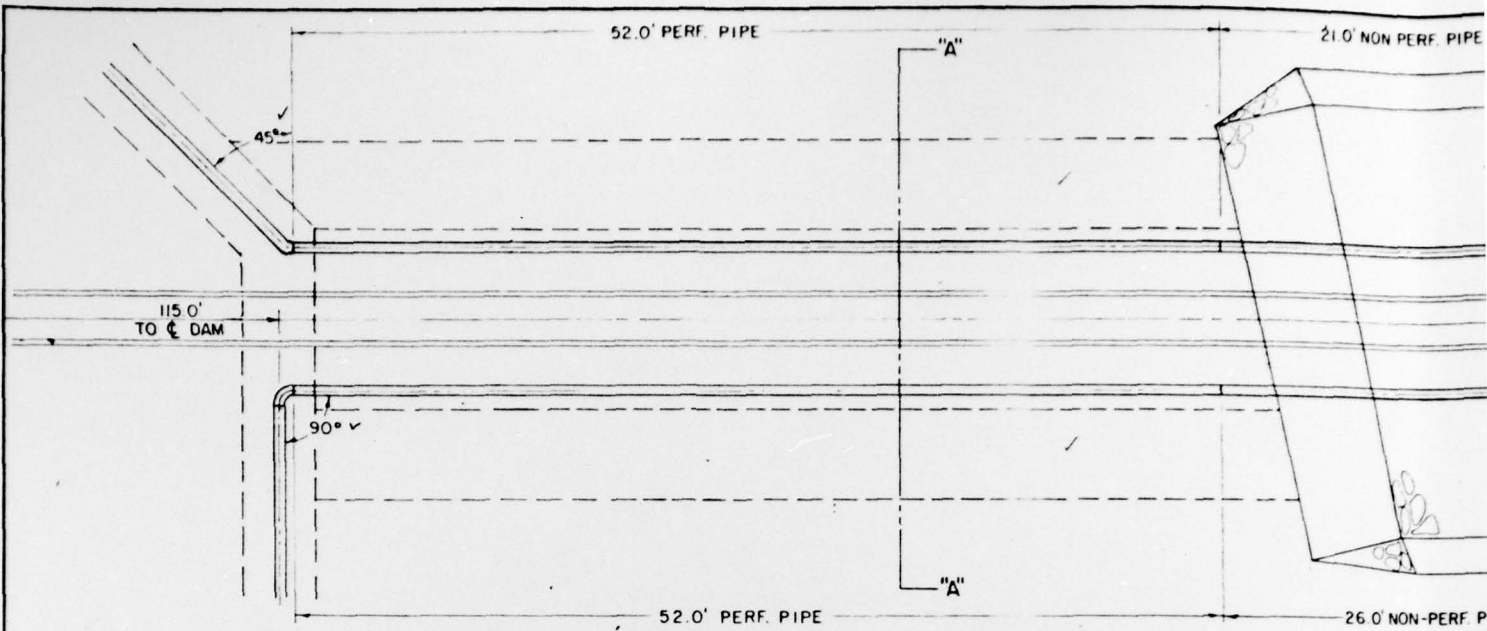

PLAN OF DRAIN OUTLET



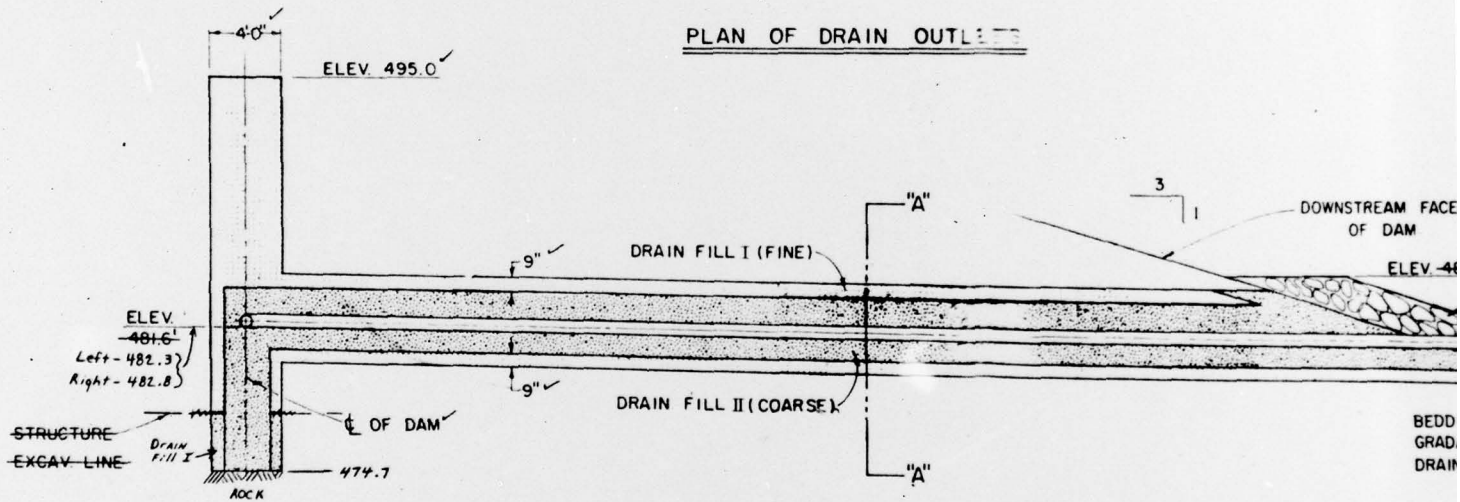


PROFILE ALONG DRAIN OUTLET

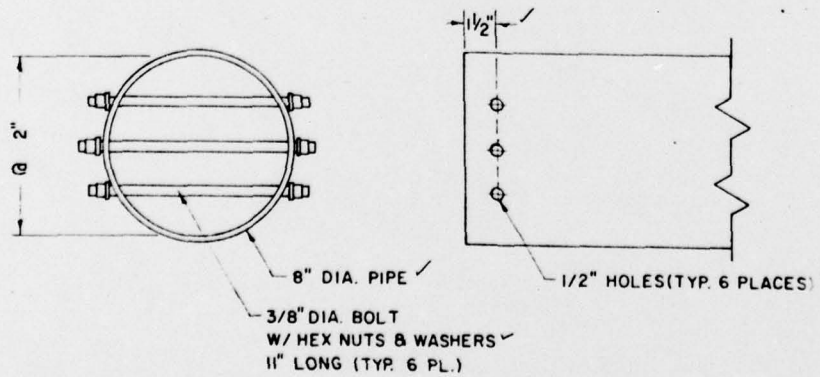


SMALL ANIMAL GUARD DETAILS

0 2
SCALE

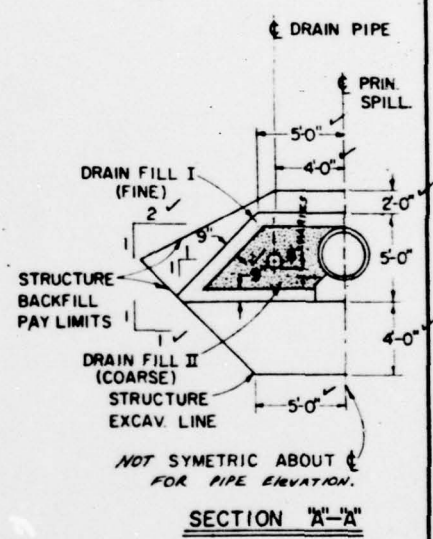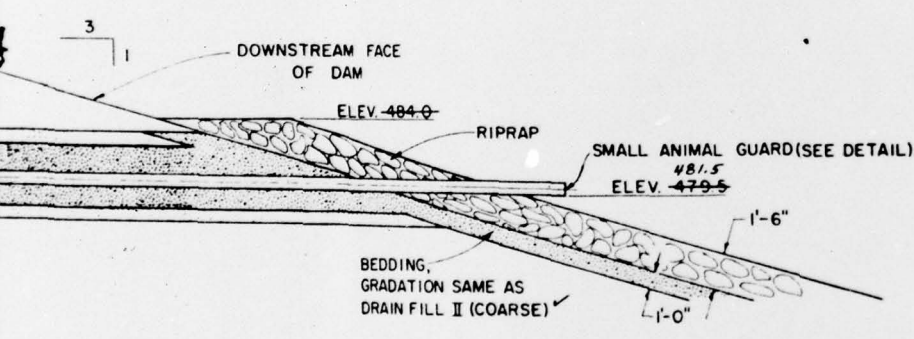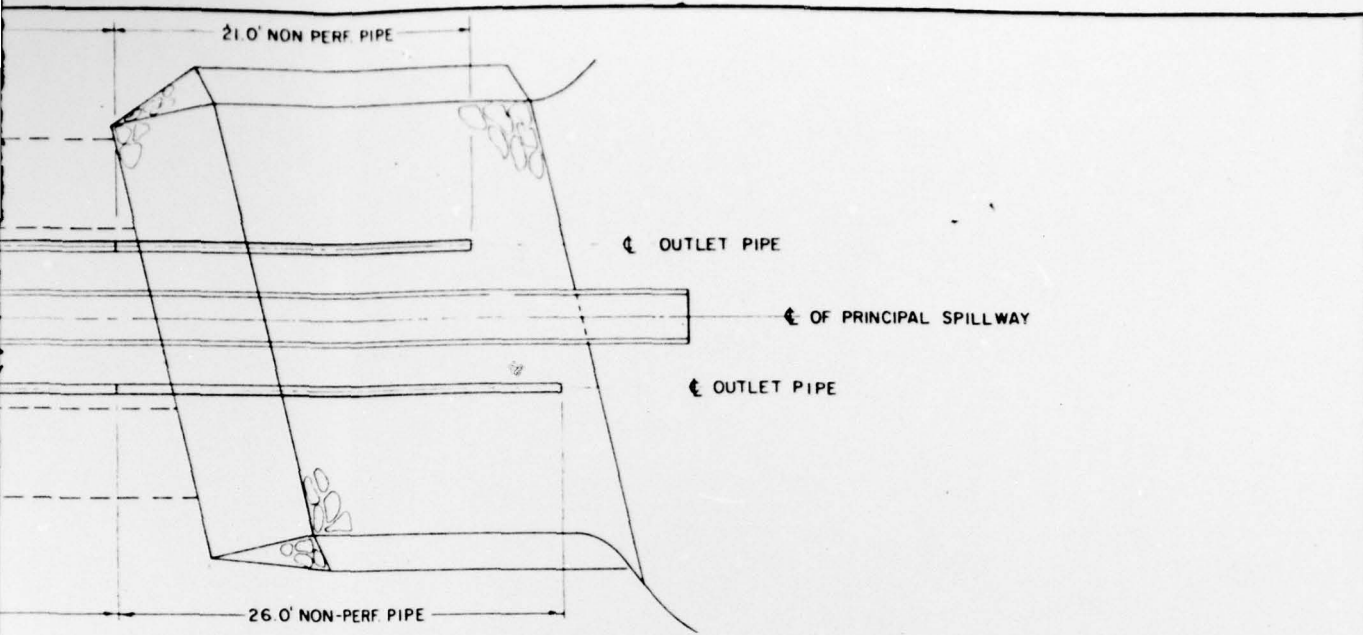


AS BUILT
8/11/78

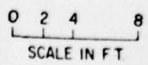


Note: Pipe inverts and slopes changed with the principal spillway to accommodate change in plunge pool.

HIGINBOTHAM BROOK WATERSHED PROJECT FLOODWATER RETARDING DAM MADISON COUNTY NEW YORK DRAINAGE SYSTEM			
U. S. DEPARTMENT OF AGRICULTURE SOIL CONSERVATION SERVICE			
Designed	W. A. RIEGEL	75	Approved by
Drawn	R. J. KELLE	75	Title
Traced			Fig No
Checked	D. E. W.		NY-2594-P


2

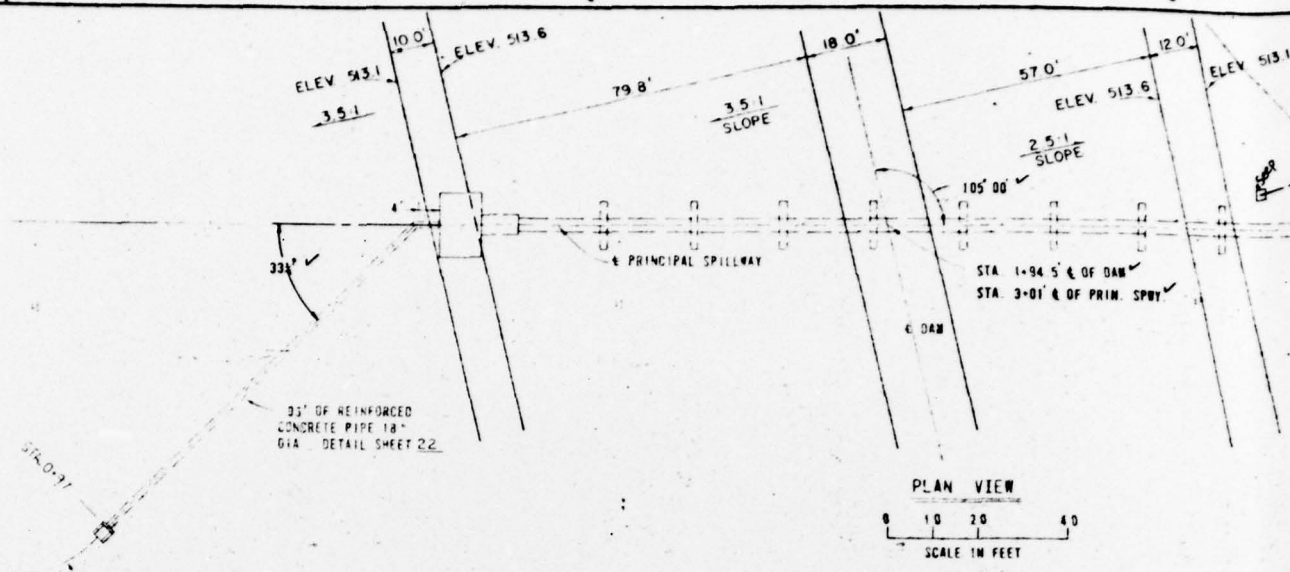

ORIGINAL GROUND SURFACE AND CHANNEL CONTOURATIONS GIVEN SHALL BE THE BASIS FOR DETERMINING THE PAY QUANTITIES FOR CHANNEL EXCAVATION.

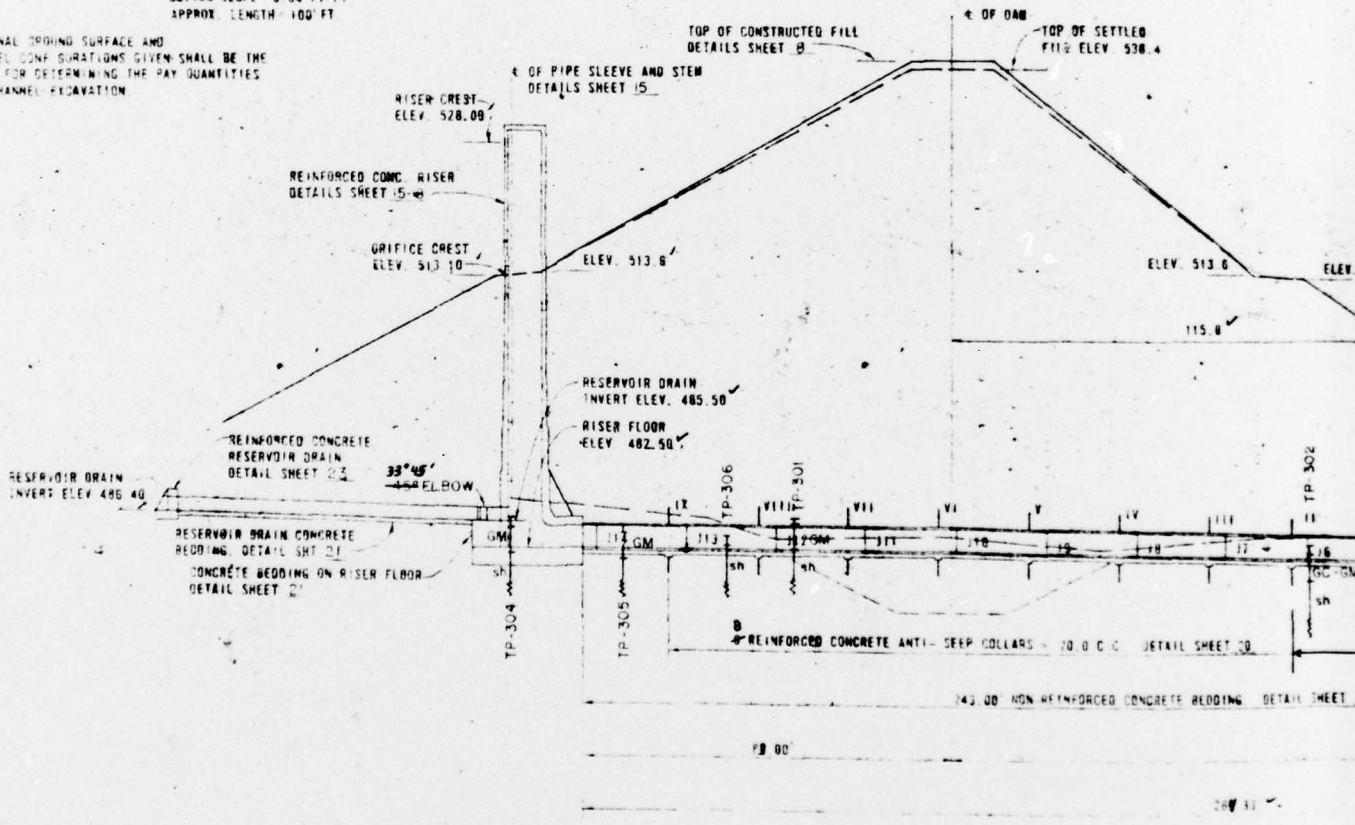

1

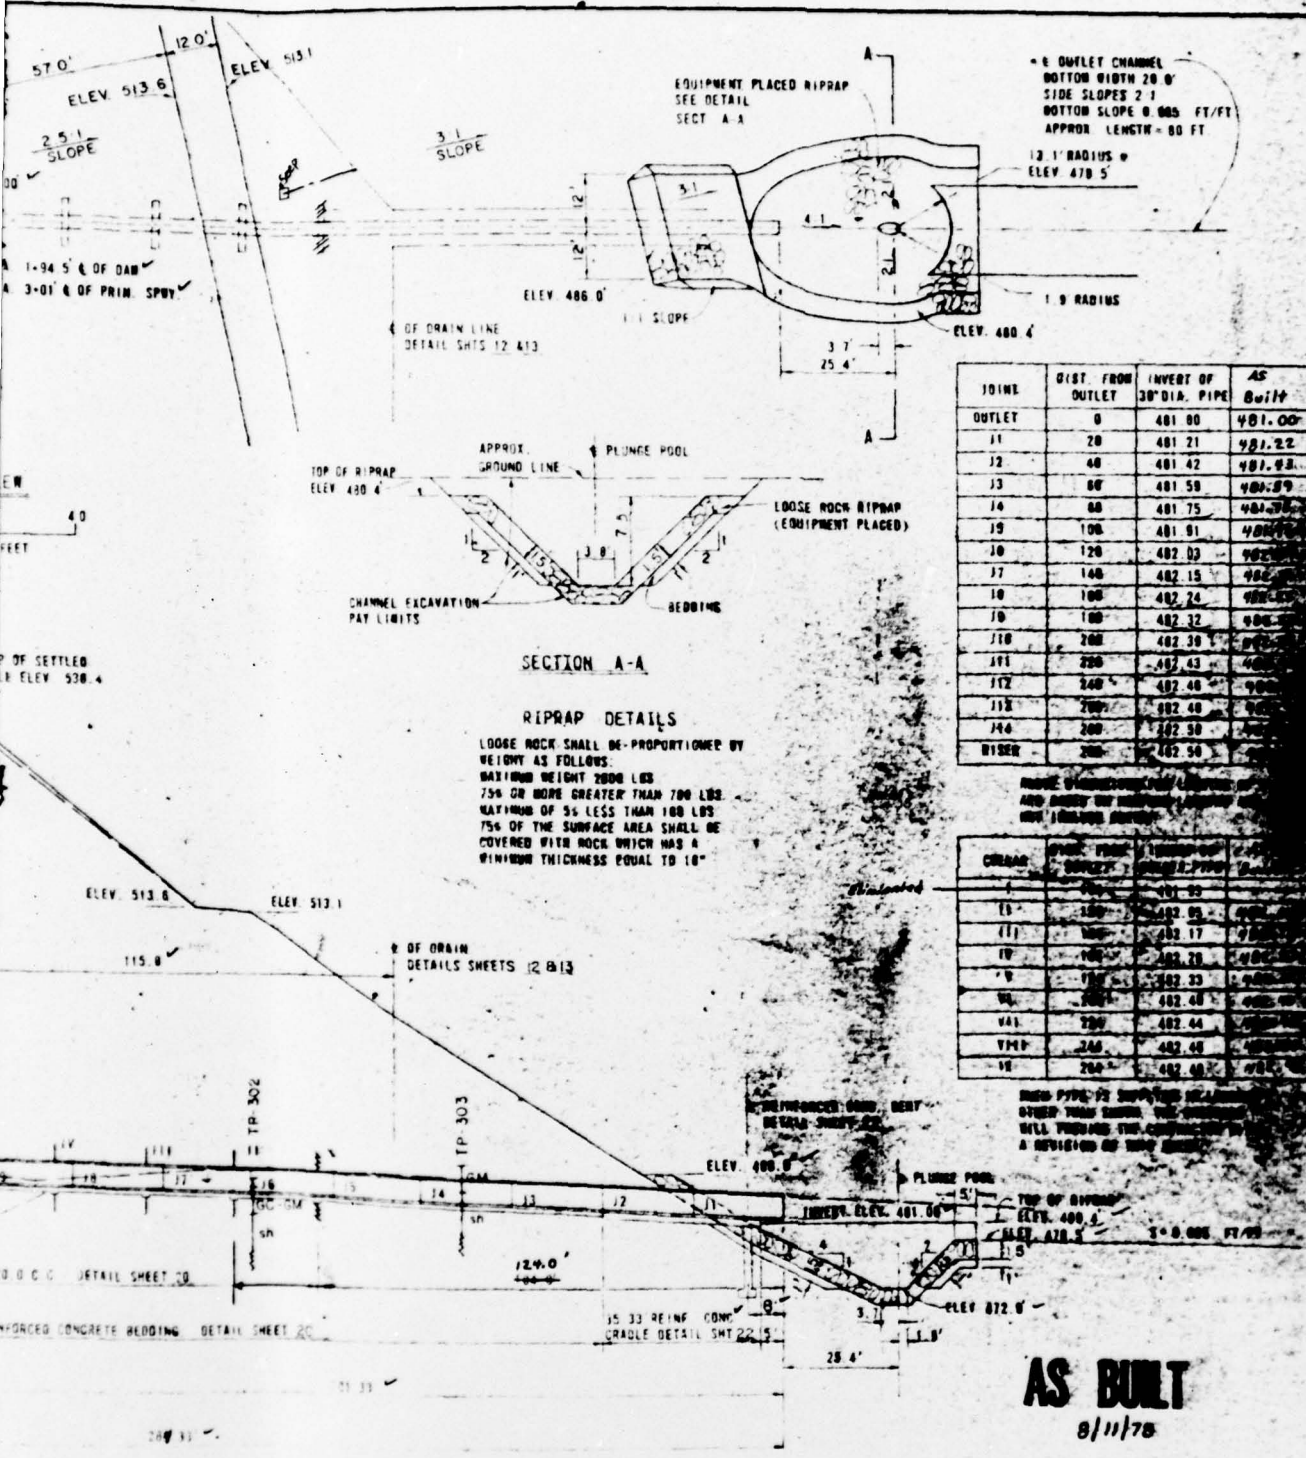



AS BUILT
8/11/78

HIGINBOTHAM BROOK
WATERSHED PROJECT
FLOODWATER RETARDING DAM
MADISON COUNTY NEW YORK
PLAN PROFILE OF PRINCIPAL SPILLWAY


U. S. DEPARTMENT OF AGRICULTURE
SOIL CONSERVATION SERVICE

W. A. RIEGEL
D. ANGELO

NY-2594-P

2

MANHOLE ASSEMBLY DETAIL

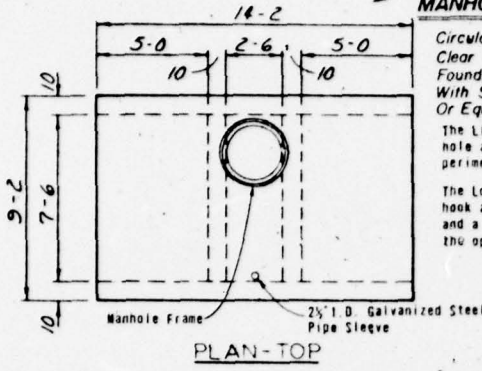


Circular Manhole Assembly Min Clear Opening 30" Neenah Foundry Co Model R-6461-HH With Stainless Steel Cap Screws, Or Equivalent

The Lifting Device shall consist of a hole approx. 3" from the outside perimeter of the lid

The Locking Device shall consist of a hook at one edge of the lid underside and a rotating bar with a hex bolt at the opposite edge.


PLAN-TOP

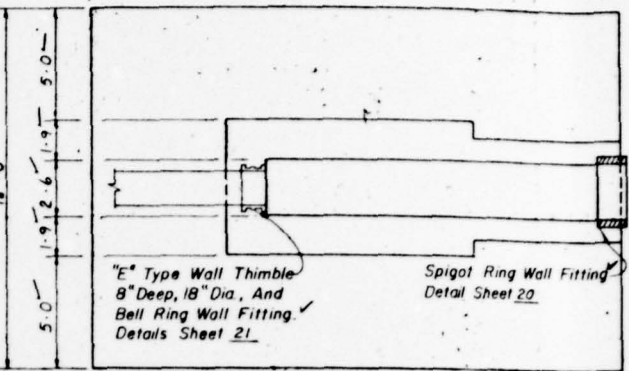

"E" Type Wall Thimble 8" Deep, 18" Dia., And Bell Ring Wall Fitting Details Sheet 21

Spigot Ring Wall Fitting Detail Sheet 20


SECTION B-B

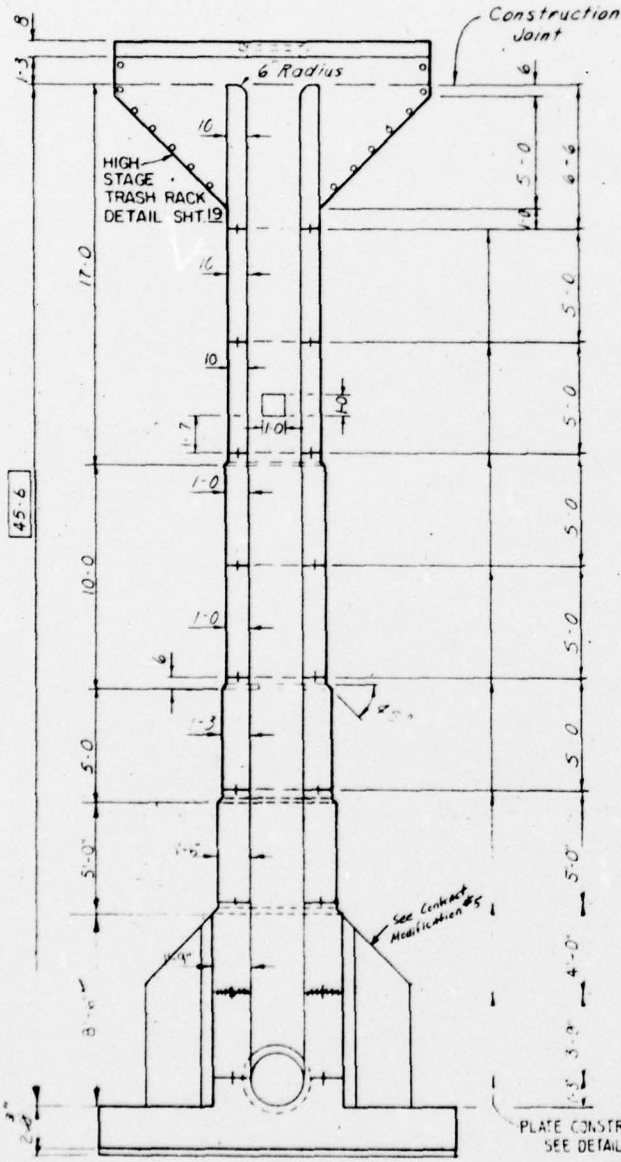

SECTION A-A

PLATE CONSTRUCTION JOINT SEE DETAIL SHEET 17






CONCRETE BEDDING SEE SHEET 21

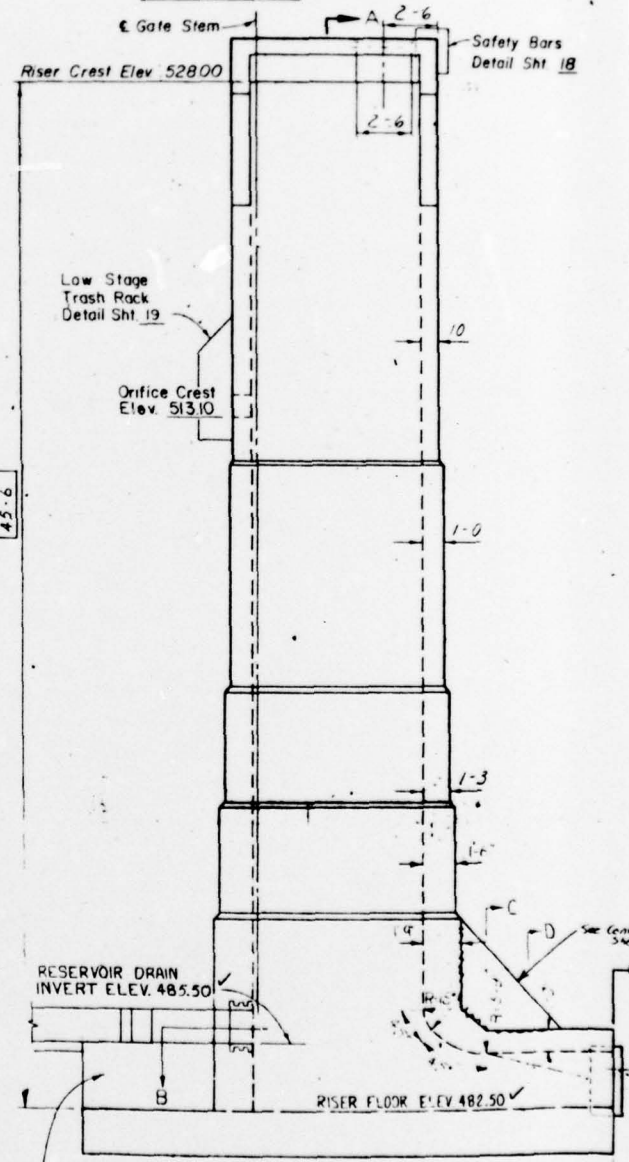


SIDEWALL ELEVATION

STEEL SCHEDULE

Mark	Size	Quantity	Length	Type	B	C	Total Length	Mark	Size	Quantity	Length	Type	B	C	Total Length
R1	#7	22	11-8	1			256-8	R27	#5	9	3-3	1			29-3
R2	#5	20	8-6	1			170-0	R28	#5	32	3-0	21	2-9	5-3	256-0
R3	#6	10	3-6	1			35-0	R29	#5	4	5-3	1			21-0
R4	#7	28	9-6	1			266-0	R30	#5	4	3-9	1			15-0
R5	#7	40	9-10	21	3-8	6-2	393-4								
R6	#5	20	8-6	1			170-0								
R7	#6	10	3-6	1			35-0								
R8	#7	26	4-4	1			112-8								
R9	#6	36	9-3	21	3-4	5-11	333-0								
R10	#6	4	8-9	21	3-1	5-8	35-0								
R11	#5	22	11-9	1			258-6	T1	#5	18	6-0	1			108-0
R12	#5	20	8-6	1			170-0	T2	#5	6	8-0	1			48-0
R13	#5	10	3-6	1			35-0	T3	#5	4	4-9	1			19-0
R14	#5	26	9-6	1			247-0	T4	#5	4	3-6	1			14-0
R15	#7	40	9-0	21	3-3	5-9	360-0	T5	#5	4	2-3	1			9-0
R16	#6	14	8-3	1			115-6	T6	#5	4	9-0	19	2-0	7-0	36-0
R17	#5	10	3-6	1			35-0	T7	#5	12	8-3	1			99-0
R18	#5	20	3-8	1			73-4	T8	#5	2	3-3	1			6-6
R19	#5	36	5-3	21	2-10	5-4	297-0	T9	#5	2	5-9	1			11-6
R20	#5	4	8-0	21	2-9	5-3	32-0	T10	#5	2	10-9	1			21-6
R21	#5	19	11-9	1			223-3	T11	#5	2	13-3	1			26-6
R22	#6	12	8-3	1			99-0	T12	#5	14	6-3	1			87-6
R23	#5	8	3-3	1			26-0	T13	#5	6	8-0	1			48-0
R24	#5	19	11-9	1			223-3	T14	#5	4	6-0	1			24-0
R25	#5	36	8-0	21	2-9	5-3	288-0	T15	#5	4	4-9	1			19-0
R26	#5	12	8-3	1			99-0	T16	#5	4	3-6	1			14-0
								T17	#5	4	2-3	1			9-0
								T18	#5	4	9-0	19	2-0	7-0	36-0
								T19	#5	24	8-0	21	2-9	5-3	192-0
								T20	#5	2	3-3	1			6-6
								T21	#5	2	5-9	1			11-6
								T22	#5	2	8-3	1			16-6
								T23	#5	2	10-9	1			21-6
								T24	#5	2	13-3	1			26-6
								T25	#5	4	13-9	1			55-0
								T26	#5	4	13-9	1			55-0
								T27	#4	14	8-3	1			115-6
								T28	#6	2	4-9	1			9-6
								T29	#4	7	13-9	1			96-3
								T30	#4	4	5-3	1			21-0
								T31	#5	24	6-9	21	1-6	5-3	162-0
								T32	#5	2	6-6	21	1-6	5-0	13-0
								T33	#5	2	2-6	21	1-6	1-0	5-0
								T34	#4	7	13-9	1			96-3
								T35	#4	4	5-3	1			21-0

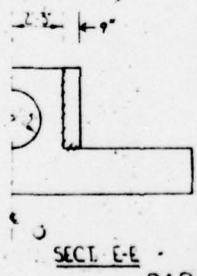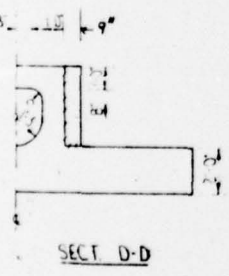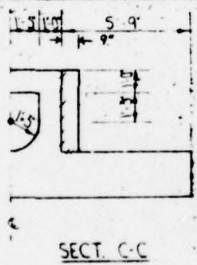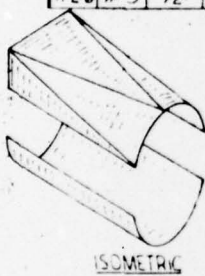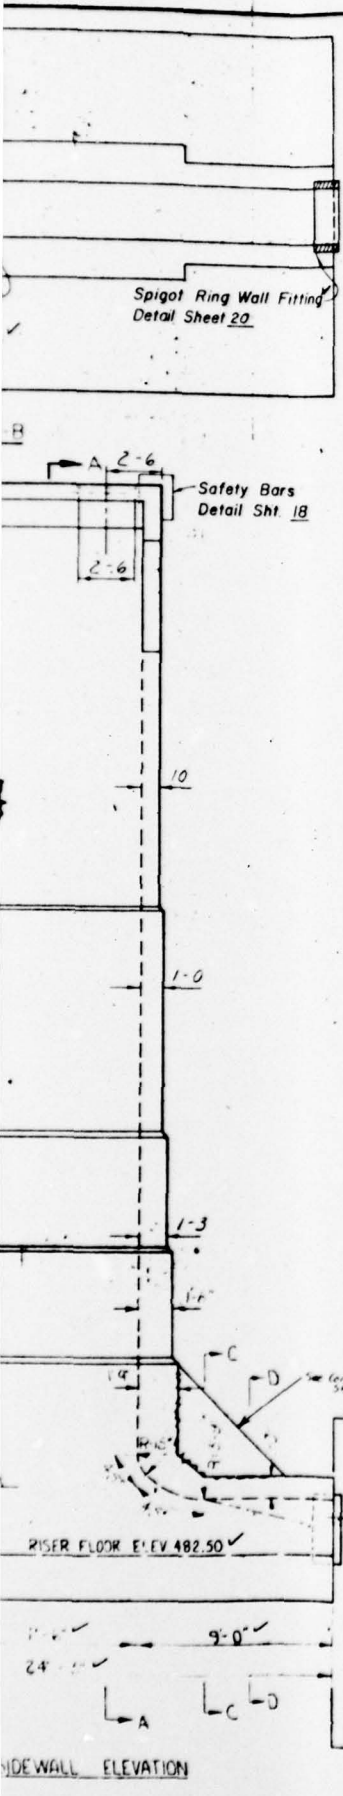

BAR TYPES

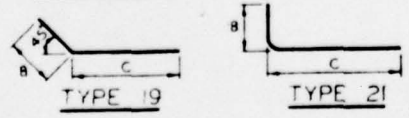

AS BUILT
8/11/78


0 2 4 6
Scale in Feet

HIGINBOTHAM BROOK WATERSHED PROJECT
FLOODWATER RETARDING DAM
MADISON COUNTY NEW YORK
RISER STRUCTURAL DETAILS
U. S. DEPARTMENT OF AGRICULTURE
SOIL CONSERVATION SERVICE


Adopted W A RIEGEL Date 5-75
Approved by Title
Drawn Title
Checked Title
Checked by Title
Drawing No. 15
NY-2594-P

2


TYPE T-1

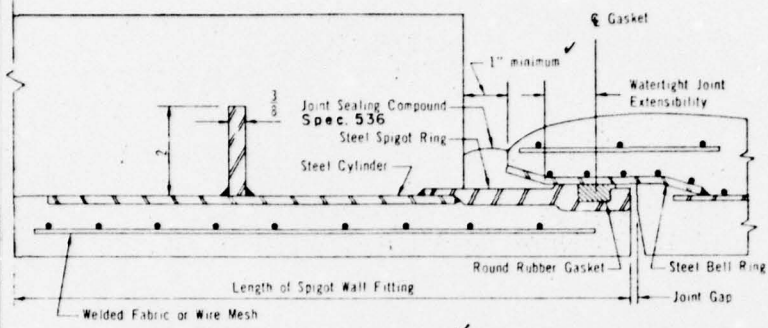


DETAIL A

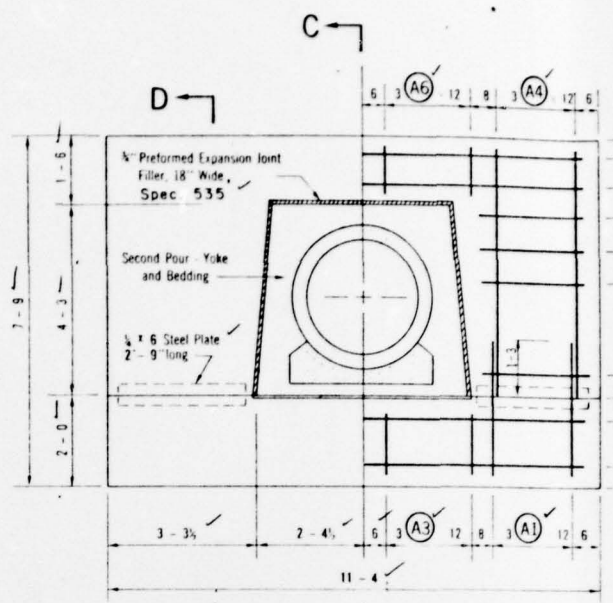


DETAIL OF ANTI-SEEP COLLAR

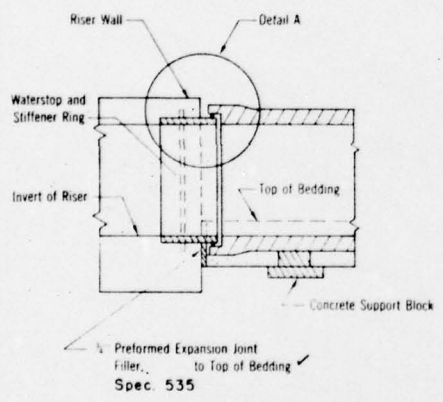


DETAIL OF SPIGOT WALL FITTING

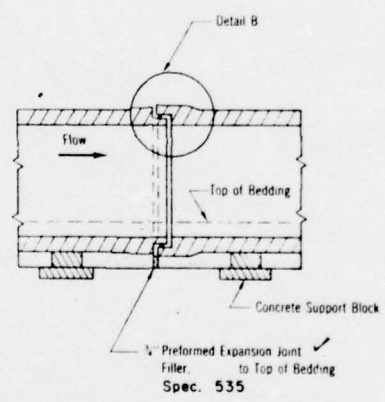

DETAIL OF PIPE JOINT

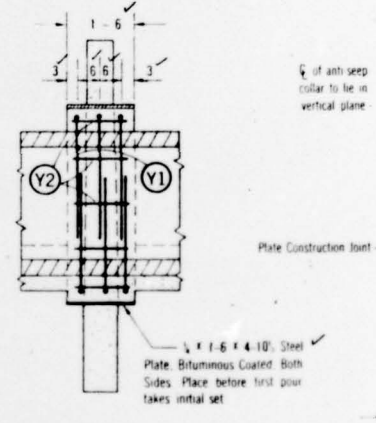

SECTION C-C

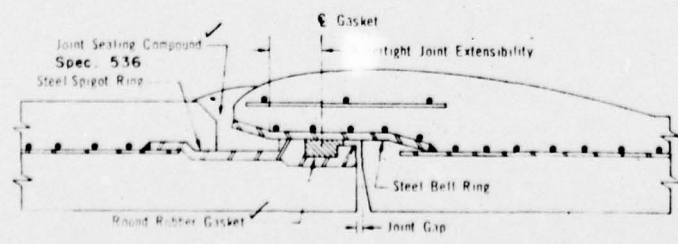

DETAIL B

JOINT REQUIREMENTS			
No. of pipe section	Length of Pipe Section	Minimum Joint Length	Minimum Joint Limiting Angle
14	20.0	2 3/4	008 0° 28'
1	3.0 (4.0)	2 3/4	008 0° 28'

Cast outside of spigot ring with concrete on one 20' section

Supply one spigot ring wall fitting for 12" wall

For pipe length other than shown, joint requirements will be determined by the Engineer.


Where pipes of different length are connected, adjoining pipes shall meet the requirements of the longer pipe.

Prior to delivery of pipe, the pipe joint detail proposed for use shall be submitted to the Engineer for approval.

STANDARD CONDUIT DETAILS	
FOR REINFORCED CONCRETE PRESSURE PIPE PRINCIPAL SPILLWAY	
STANDARD DRG. NO.	ES-5030-BE
DATE	2/70
SHEET	1 OF 1


Joint length equals watertight joint extensibility plus joint gap.
 The pipe shall be drawn together so that the maximum joint gap does not exceed 3/8 inch for pipe laid on a straight line. For cambered pipe or pipe laid on a curved line, the joint gap at the closest point shall not exceed 3/8 inch.

STR
 Inside Diameter of Pipe
 30

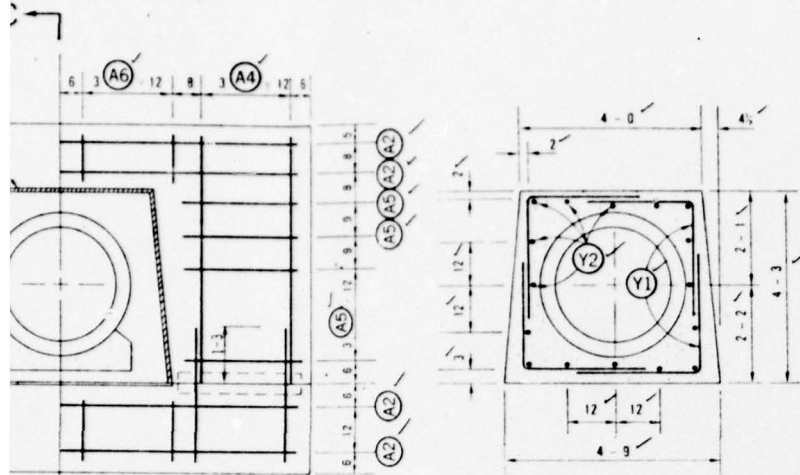

DETAIL OF ANTI-SEEP COLLAR YOKE

ANTI-SEEP COLLAR 8 REQUIRED (SEE SH. 14)

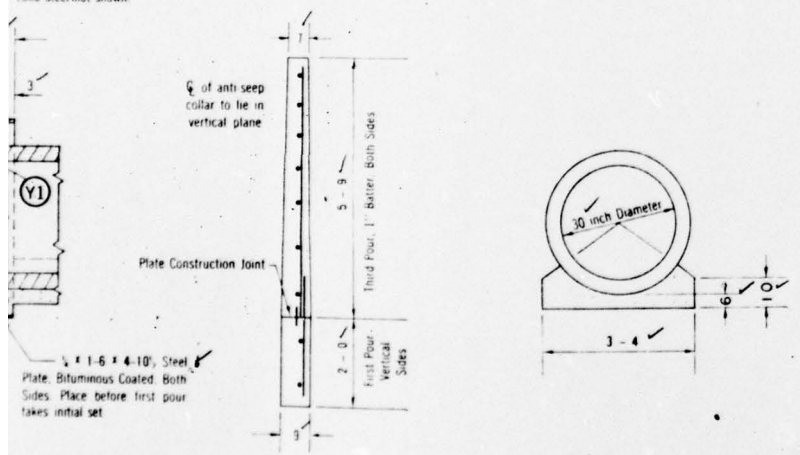


SECTION D-D DETAIL OF BEDDING

STEEL SCHEDULE						
Anti-seep Collar and Yoke, 8 Required						
Mark	Size	Quantity per Collar	Length	Type	Total Quantity	Total Length
A1	4	6	3-0	1	54 ⁷⁸	162-0
A2	4	4	10-10	1	36 ³²	396-8
A3	4	6	1-6	1	54 ⁴⁸	72-0
A4	4	6	5-6	1	54 ⁴⁸	264-0
A5	4	10	2-9	1	90 ⁸⁰	220-0
A6	4	6	1-0	1	54 ⁴⁸	48-0
Y1	4	12	5-2	21	108 ⁹⁶	498-0
Y2	4	16	1-2	1	144 ⁷⁸	149-4


CONSTRUCTION DETAILS SHEET 17

QUANTITIES	
Concrete	Cu. Yds.
Anti-seep Collar including Yoke	
• Each	2.38 2.37
Total REINFORCED CONCRETE	29.9 18.95
Bedding	
• Per Lineal Foot of Bedding	0.004 .1036
Total NONREINFORCED CONCRETE	21.6 23.27
Steel	Pounds
Anti-seep Collar including Yoke	1,950 LE 1,740
	1,162.3

Concrete quantities are based on an outside diameter of pipe of ~~30.75~~ 37.50".
 Steel quantities do not change with outside diameter of pipe. ~~37.50~~
 This quantity is given by:
 $2.339 - 0.00030(D_f - 30) - (0.30)$ cu. yds.
 This quantity is given by:
 $0.0734 - 0.0005(D_f - 30) - [0.167(3.333)]$ c.f.
 $D_f =$ outside diameter of pipe furnished, inches.

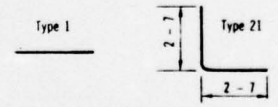

BAR TYPES

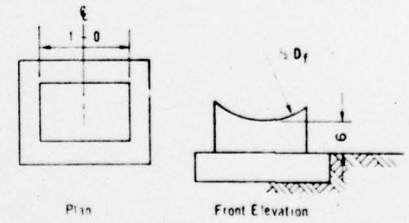

SUGGESTED SUPPORT BLOCKS

REQUIREMENTS	
Minimum Joint Length	Minimum Joint Limiting Angle
5	radians degrees
7/4	008 0° 28'
7/4	008 0° 28'

STRENGTH REQUIREMENTS		
Inside Diameter of Pipe	Internal Load	External Load
	Hydrostatic Pressure	Minimum 3 Edge Bearing Strength in Pounds per Lineal Foot of Pipe Applicable Standard Specification ASMA C-301
Head of Water	Load to produce 0.001 inch crack one foot long	
30	52	15,235
		15,700 Test


AS BUILT
8/11/78

The outside diameter of pipe assumed in design is 38.75 inches. At A-14 = 37.50".
 Where the pipe furnished has an outside diameter greater than assumed in design, the three-edge bearing strength of the pipe furnished must not be less than the specified three-edge bearing strength multiplied by the ratio of the outside diameter of the pipe furnished to the outside diameter assumed in design.


HIGINBOTHAM BROOK WATERSHED PROJECT
 FLOODWATER RETARDING DAM
 MADISON COUNTY NEW YORK
 PRINCIPAL SPILLWAY CONDUIT DETAILS

U. S. DEPARTMENT OF AGRICULTURE
 SOIL CONSERVATION SERVICE


Adopted: W. A. RIEGEL Date: 5-75 Approved By: [Signature]
 Drawn: [Signature] Title: [Signature]
 Traced: [Signature] Title: [Signature]
 Checked: D. E. W. 5-75 Sheet No. 20 of 22 Drawing No. NY-2594-P

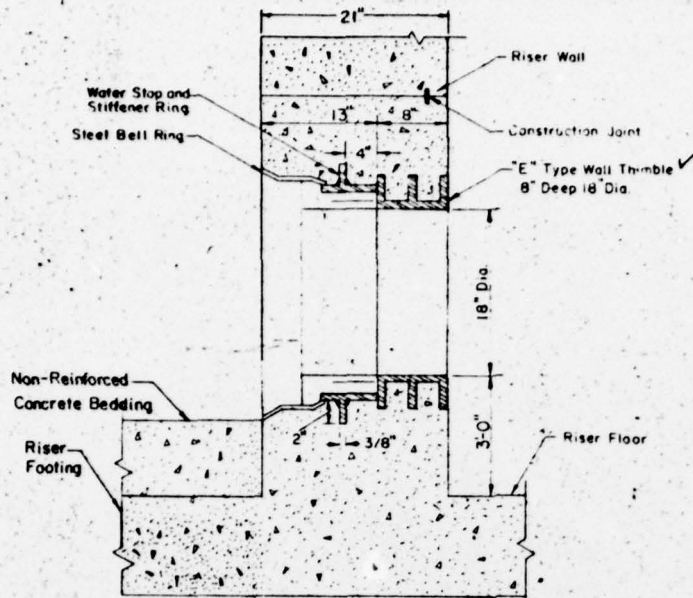


BELL WALL FITTING
(*E* Type Wall Thimble)

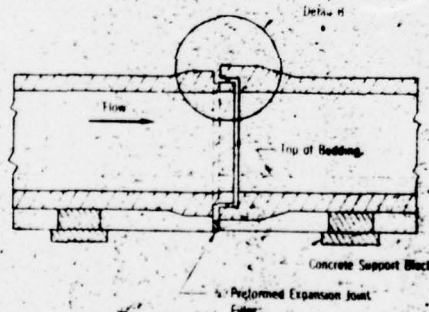

DETAIL OF PIPE JOINT

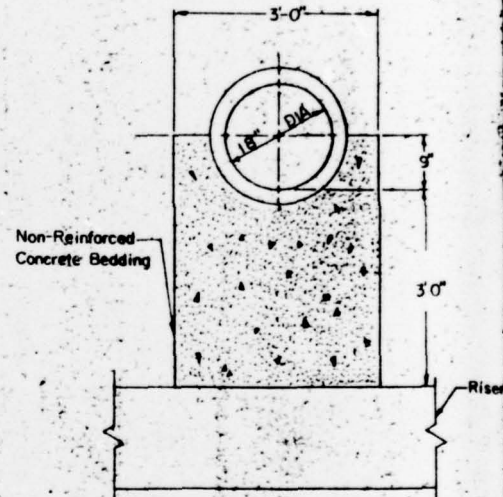

RISER FOOTING CONCRETE BE

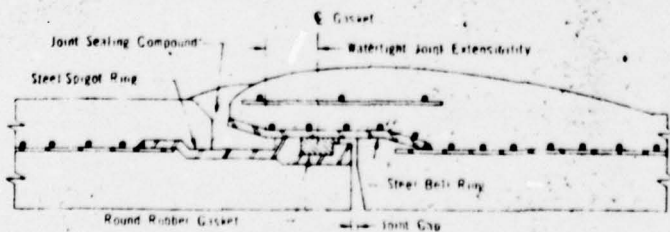

DETAIL B

JOINT REQUIREMENTS			
No. of Pipe Sections Each	Length of Pipe Section feet	Minimum Joint Length in feet	Minimum Joint Limiting Angle radians / degrees
One (1) Bell Wall Fitting For 13" Wall			
One (1) Spigot Wall Fitting For 8" Wall			
4	20.0	2 3/4"	0.124 or 43°
2	16.0	3	
1	4.0		
1	11.0		

For pipe length other than shown, joint requirements will be determined by the Engineer.

When pipes of different length are connected, adjoining pipes shall meet the requirements of the longer pipe.

Prior to delivery of pipe, the pipe joint detail proposed for use shall be submitted to the Engineer for approval.

STANDARD CONDUIT DETAILS	
FOR REINFORCED CONCRETE PRESSURE PIPE PRINCIPAL SPILLWAY	
STANDARD DWG. NO.	ES-5018-BE
DATE	2.70
SHEET	1 OF 1

Joint length equals water-tight joint extensibility plus joint gap.

The pipe shall be drawn together so that the maximum joint gap does not exceed 3/8 inch in any direction on a straight line. For chambered pipe or pipe laid on a curved line, the joint gap at the lowest point shall not exceed 3/8 inch.

STP

18

HIGHBOTHAM BROOK WATERBED

TEST PIT LOGS

TP #8, C/L Dam, 4/22/75, AHC, 524.3, Dam 2

- 0.0 - 0.5 Topsoil, red
- 0.5 - 3.0 Sand, silty, clayey w/some gravel
Max. size 3"
Approx. 7% gravel, 50% sand, 43% slightly plastic fines
Red; moist; rapidly permeable; loose; homogeneous;
glacial outwash; (SM)
- 3.0 - 6.0 Vernon shale, red, ripplable with backhoe
- 6.0 + Vernon shale, firm (sh)

TP #9, C/L Dam, 4/22/75, AHC, 533.1, Dam 2

- 0.0 - 0.5 Topsoil, red
- 0.5 - 1.5 Sand, silty, clayey w/some gravel
Max. size 3"
Approx. 7% gravel, 50% sand, 43% slightly plastic fines
Red; moist; rapidly permeable; loose; homogeneous;
glacial outwash; (SM)
- 1.5 - 3.0 Vernon shale, red, easily ripplable with backhoe
- 3.0 + Vernon shale, firm (sh)

TP #10, C/L Dam, 4/24/75, AHC, 524.7, Dam 3

- 0.0 - 0.5 Topsoil, red
- 0.5 - 3.0 Sand, silty, clayey w/some gravel
Max. size 3"
Approx. 10% gravel, 47% sand, 43% slightly plastic fines
Red; moist; moderately permeable; loose; homogeneous;
glacial outwash; (SM)
- 3.0 - 4.0 Vernon shale, red, easily ripplable with backhoe
- 4.0 + Vernon shale, red, firm (sh)

TP #11, C/L Dam, 4/18/75, AHC, 520.5, Dam 3

- 0.0 - 2.0 Sand, clayey, w/silt and gravel
Max. size 3"
Approx. 5% gravel, 55% sand, 40% nonplastic fines
Red; moist; moderately permeable; loose; homogeneous;
glacial outwash; (SM)
- 2.0 - 12.0 Clay, silty, w/some gravel and occasional subrounded sandstone boulders to 10"
Approx. 10% +6", 3% 3"-6", 84% matrix (which is approx. 4% gravel, 16% sand, 80% moderately plastic fines) (LL = 22, PI = 7)
Red; moist; very slowly permeable; very dense; homogeneous; lacustrine; (CL-ML) D.S. 11.1, CL-ML

TP #12, C/L Dam, 4/23/75, AHC, 533.3, Dam 3

- 0.0 - 0.5 Topsoil and forest duff
- 0.5 - 3.0 Sand, silty, w/some gravel
Max. size 3"
Approx. 5% gravel, 55% sand, 40% nonplastic fines
Brown; moist; rapidly permeable; loose; homogeneous;
(SM) D.S. 12.1, SM
- 3.0 - 12.0 Gravel, silty, clayey
Approx. 5% +6", 5% 3"-6", 90% < 3" (which is approx. 60% gravel, 20% sand, 12% slightly plastic fines) (LL = 22, PI = 5)
Brown; moist to saturated; rapidly permeable; loose; alluvial; (GC-GM); D.S. 12.2 - 12.3 GC-GM, GP

NOTE: water level @ 10'; caved badly below 6'.

TP #12a, Borrow Area, 4/22/75, AHC, 542.7

- 0.0 - 0.5 Topsoil, brown
- 0.5 - 3.0 Silt, sandy, w/some gravel
95% < 3" (which is approx. 5% gravel, 10% sand, 85% slightly plastic fines)
Brown; moist; moderately permeable; loose; homogeneous; lacustrine; (ML)
- 3.0 - 6.0 Gravel, silty, w/occasional boulders subangular to angular sandstone and shale to 10"
Approx. 5% +6", 5% 3"-6", 90% < 3" (which is approx. 54% gravel, 36% sand, 10% moderately plastic fines)
Brown; moist; rapidly permeable; loose; alluvial; (GC-GM)
- 6.0 - 8.0 Sand, silty, w/some gravel
100% < 3" (which is approx. 4% gravel, 61% sand, 35% nonplastic fines)
Brown; moist; moderately permeable; loose; lacustrine; (SM)
- 8.0 - 11.0 Silt and clay w/sand and gravel
Approx. 5% +6", 5% 3"-6", 90% < 3" (which is approx. 12% gravel, 25% sand, 63% nonplastic fines)
Brown; moist; slow permeable; moderately dense; homogeneous; lacustrine; (ML)

TP #12b, Borrow Area, 4/22/75, AHC, 542.7

- 0.0 - 0.5 Topsoil, brown
- 0.5 - 2.0 Silt, sandy, w/some gravel
95% < 3" (which is approx. 5% gravel, 10% sand, 85% slightly plastic fines)
Brown; moist; moderately permeable; loose; homogeneous; lacustrine; (ML)
- 2.0 - 3.5 Gravel, silty, w/occasional boulders subangular to angular sandstone and shale to 10"
Approx. 5% +6", 5% 3"-6", 90% < 3" (which is approx. 54% gravel, 36% sand, 10% moderately plastic fines)
Brown; moist; rapidly permeable; loose; alluvial; (GC-GM)
- 3.5 - 10.0 Sand, silty, w/some gravel
100% < 3" (which is approx. 4% gravel, 61% sand, 35% nonplastic fines)
Brown; moist; moderately permeable; loose; lacustrine; (SM) D.S. 12.1 SM

TP #12c, Borrow Area, 4/22/75, AHC, 552.6

- 0.0 - 0.5 Topsoil, brown
- 0.5 - 11.0 Gravel, silty, clayey
Some subangular to angular sandstone and shale to 10"
Approx. 5% +6", 5% 3"-6", 90% < 3" (which is approx. 45% gravel, 42% sand, 13% moderately plastic fines) (LL = 28, PI = 6)
Mottled gray-brown; moist; rapidly permeable; loose; generally homogeneous with less fine fraction found in lower portion; caves quite badly; (GM) D.S. 12.6.1 GC-GM

TP #12d, Borrow Area, 4/22/75, AHC, 552.3

- 0.0 - 0.5 Topsoil, brown
- 0.5 - 3.0 Silt, sandy, w/some gravel
95% < 3" (which is approx. 5% gravel, 10% sand, 85% slightly plastic fines)
Brown; moist; moderately permeable; loose; homogeneous; lacustrine; (ML)
- 3.0 - 11.0 Silt w/sand; 100% < 3"
Approx. 25% sand, 75% nonplastic fines
Brown; moist; moderately permeable; loose; homogeneous; lacustrine; (ML) D.S. 12.7.1 ML

TP #203, Emergency Spillway, 4/22/75, AHC, 540.2

- 0.0 - 0.5 Topsoil, red
- 0.5 - 2.0 Sand, silty, clayey, w/some gravel; 100% < 3"
Approx. 16% gravel, 40% sand, 44% moderately plastic fines
Red; moist; moderately permeable; loose; homogeneous; outwash (SM)
- 2.0 - 11.0 Gravel, silty, clayey, some subangular to angular sandstone and shale to 10"
Approx. 5% +6", 5% 3"-6", 90% < 3" (which is approx. 45% gravel, 42% sand, 13% moderately plastic fines)
Brown; moist; rapidly permeable; loose; generally homogeneous with siltier layer at 8'-outwash; (GC-GM)

TP #204, Emergency Spillway, 4/22/75, AHC, 526.3

- 0.0 - 0.5 Topsoil, red
- 0.5 - 2.0 Sand, silty, clayey, w/some gravel
100% < 3" (which is approx. 16% gravel, 40% sand, 44% moderately plastic fines) (LL = 25, PI = 5)
Red; moist; moderately permeable; loose; homogeneous; outwash; (SM) D.S. 204.1 SM
- 2.0 - 10.0 Gravel, silty, clayey, some subangular to angular sandstone and shale to 10"
Approx. 5% +6", 5% 3"-6", 90% < 3" (which is approx. 45% gravel, 42% sand, 13% moderately plastic fines)
Brown; moist; rapidly permeable; loose; generally homogeneous with siltier layer at 8'-outwash; (GC-GM)

TP #205, Emergency Spillway, 4/22/75, AHC, 531.8

- 0.0 - 0.5 Topsoil, red
- 0.5 - 2.0 Sand, silty, clayey, w/some gravel; 100% < 3"
Approx. 16% gravel, 40% sand, 44% moderately plastic fines
Red; moist; moderately permeable; loose; homogeneous; outwash (SM)
- 2.0 - 10.0 Gravel, silty, clayey
Some subangular to angular sandstone and shale boulders to 10"
Approx. 5% +6", 5% 3"-6", 90% < 3" (which is approx. 45% gravel, 42% sand, 13% moderately plastic fines)
Brown; moist; rapidly permeable; loose; homogeneous; outwash; (GM)

TP #201, Principal Spillway

- 0.0 - 0.5 Topsoil, fo
- 0.5 - 3.7 Gravel, sil sandstone & Approx. 5% 50% gravel, Red-brown; loose; allu
- 3.7 + Bedrock, Ve where situ

NOTE: Test about bed 7.0'

TP #202, Principal Spillway

- 0.0 - 1.0 Topsoil, fo trash
- 1.0 - 4.0 Gravel, sil sandstone & Approx. 5% 55% gravel, (LL = 30, PI = 6) Red-brown; loose; allu
- 4.0 + Bedrock, Ve where situ

NOTE: Test about vari at 4'

TP #206, Principal Spillway

- 0.0 - 3.0 Gravel, sil sandstone & Approx. 5% 50% gravel, Red-brown; loose; allu
- 3.0 + Bedrock, Ve easily reas

TP #207, Principal Spillway

- 0.0 - 1.0 Topsoil, fo
- 1.0 - 4.0 Gravel, sil sandstone & Approx. 5% 50% gravel, Red-brown; loose; allu
- 4.0 + Bedrock, Ve

TP #208, Principal Spillway

- 0.0 - 1.0 Topsoil, fo
- 1.0 - 4.0 Gravel, sil sandstone & Approx. 5% 50% gravel, Red-brown; loose; allu
- 4.0 + Bedrock, Ve easily reas

TP #209, Principal Spillway

- 0.0 - 1.0 Streambed d
- 1.0 + Bedrock, Ve depth altho

TP #210, Drain Line, A/C

- 0.0 - 2.0 Gravel, sil Approx. 5% 50% gravel, Red-brown; (GC-GM)
- 2.0 + Bedrock, Ve reworked with

NOTE: TP #

TP #211, Drain Line, A/C

- 0.0 + Bedrock, Ve soil, reas

NOTE: TP #

TP #501, Principal Sillway, 4/23/75, AHC, 485.0 ±

- 0.0 - 0.5 Topsoil, forest duff and floodplain trash
 - 0.5 - 3.7 Gravel, silty, clayey, w/some subangular to angular sandstone and shale boulders to 10".
Approx. 5% $4/8$, 5% 3"-6", 90% <math>< 3</math>" (which is approx. 50% gravel, 38% sand, 12% moderately plastic fines)
Red-brown; moist to saturated; rapidly permeable; loose; alluvial; (GM)
 - 3.7 + Bedrock, Vernon shale, badly weathered near stream where saturated (sh)
- NOTE: Test pit was a trench from the base of the abutment to the stream edge. Depth to firm bedrock varies from 3.7' near abutment to 7.0' at the stream edge.

TP #502, Principal Sillway, 4/23/75, AHC, 485.0 ±

- 0.0 - 1.0 Topsoil, forest duff, weathered shale and floodplain trash
 - 1.0 - 4.0 Gravel, silty, clayey, w/some subangular to angular sandstone and shale boulders to 10".
Approx. 5% $4/8$, 5% 3"-6", 90% <math>< 3</math>" (which is approx. 55% gravel, 31% sand, 12% moderately plastic fines) (LL = 30, PI = 9)
Red-brown; moist to saturated, rapidly permeable; loose; alluvial; (GM) D.S. 302.1 GC-GM
 - 4.0 + Bedrock, Vernon shale, badly weathered and easily removed with backhoe to depth of 8', near stream where saturated (sh)
- NOTE: Test pit was a trench from base of the abutment to stream edge. Depth to firm bedrock varied from 4' at base of abutment to 8.0' at the stream edge.

TP #503, Principal Sillway, 4/23/75, AHC, 483.0 ±

- 0.0 - 3.0 Gravel, silty, clayey, w/some subangular to angular sandstone and shale boulders to 10".
Approx. 5% $4/8$, 5% 3"-6", 90% <math>< 3</math>" (which is approx. 50% gravel, 38% sand, 12% moderately plastic fines)
Red-brown; moist to saturated; rapidly permeable; loose; alluvial; (GM)
- 3.0 + Bedrock, Vernon shale, top 5.0' badly weathered and easily removed with backhoe (sh)

TP #504, Principal Sillway, 4/23/75, AHC, 486.0 ±

- 0.0 - 1.0 Topsoil, forest duff and floodplain trash
- 1.0 - 4.0 Gravel, silty, clayey, w/some subangular to angular sandstone and shale to 10".
Approx. 5% $4/8$, 5% 3"-6", 90% <math>< 3</math>" (which is approx. 50% gravel, 38% sand, 12% moderately plastic fines)
Red-brown; moist to saturated; rapidly permeable; loose; alluvial; (GM)
- 4.0 + Bedrock, Vernon shale, weathered on top 18" (sh)

TP #505, Principal Sillway, 4/23/75, AHC, 485.0 ±

- 0.0 - 1.0 Topsoil, forest duff and floodplain trash
- 1.0 - 4.0 Gravel, silty, clayey, w/some subangular to angular sandstone and shale to 10".
Approx. 5% $4/8$, 5% 3"-6", 90% <math>< 3</math>" (which is approx. 50% gravel, 38% sand, 12% moderately plastic fines)
Red-brown; moist to saturated; rapidly permeable; loose; alluvial; (GM)
- 4.0 + Bedrock, Vernon shale, top 9' badly weathered and easily removed with backhoe

TP #506, Principal Sillway, 4/23/75, AHC, 484.0 ±

- 0.0 - 1.0 Streamed deposit, gravel and shale
- 1.0 + Bedrock, Vernon shale, badly weathered (dup to 8' depth without hitting firm bedrock) (sh)

TP #507, Drain Line, 4/23/75, AHC, 500.0 ±

- 0.0 - 2.0 Gravel, silty, clayey, mixed with forest duff
Approx. 5% $4/8$, 5% 3"-6", 90% <math>< 3</math>" (which is approx. 50% gravel, 38% sand, 12% moderately plastic fines)
Red-brown; moist; rapidly permeable; loose; alluvial; (GC-GM)
 - 2.0 + Bedrock, Vernon shale, top 1.0' weathered and easily removed with backhoe (sh)
- NOTE: TP extended up right abutment approx. 10.0'.

TP #508, Drain Line, 4/23/75, AHC, 475.0 ±

- 0.0 + Bedrock, Vernon shale, top 1.0' badly weathered and easily removed with backhoe (sh)
- NOTE: TP extended up right abutment approx. 15.0'.

TP #509, Diversion, 4/23/75, AHC, 519.0

- 0.0 - 1.0 Topsoil, brown
 - 1.0 - 3.0 Sand, silty, w/some gravel, 100% <math>< 3</math>"
Approx. 10% gravel, 50% sand, 40% moderately plastic fines
Brown; wet; moderately permeable; loose; homogeneous; alluvial; (GM)
 - 3.0 - 7.0 Silt w/sand and gravel
Max. size 3/8"
Approx. 5% gravel, 10% sand, 85% nonplastic fines
Red; wet; slowly permeable; loose; homogeneous; lacustrine; (ML)
 - 7.0 - 9.0 Sand gravelly with some silt and clay; 100% <math>< 3</math>"
Approx. 30% gravel, 40% sand, 15% moderately plastic fines
Red; wet; rapidly permeable; loose; (dense at 9.0'); homogeneous; alluvial; (SM)
- NOTE: Water table @ 3.0'. Logs and floodplain trash at 2.0'.

TP #502, Diversion, 4/23/75, AHC, 518.6

- 0.0 - 3.0 Sand, silty, w/some gravel, 100% <math>< 3</math>"
Approx. 10% gravel, 50% sand, 40% moderately plastic fines
Brown; wet; moderately permeable; loose; homogeneous; alluvial; (SM)
 - 3.0 - 10.0 Silt w/sand; 100% <math>< 3</math>"
Approx. 30% sand, 70% nonplastic fines
Brown; saturated; moderately permeable; loose; lacustrine; (ML) D.S. 602.1, 602.2 ML
 - 10.0 - 11.0 Clay w/silt; 100% <math>< 3</math>"
Approx. 8% gravel, 11% sand, 81% moderately plastic fines
Red; saturated; very slowly permeable; very dense; varved; lacustrine; (CL-ML) D.S. 602.3 CL-ML
 - 11.0 + Bedrock, Vernon shale, firm
- NOTE: Water level at 3.0'. Caves badly from 3.0' to 8.0'.

TP #503, Diversion, 4/23/75, AHC, 510.3

- 0.0 - 2.0 Silt clayey with some sand and gravel; 100% <math>< 3</math>" (which is approx. 4% gravel, 36% sand, 60% plastic fines) (LL = 40, PI = 13)
Red; moist; slowly permeable; soft; homogeneous; lacustrine; (ML) D.S. 603.1 CL-ML
 - 2.0 - 4.0 Sand, gravelly w/some silt and clay; 100% <math>< 3</math>"
Approx. 30% gravel, 46% sand, 15% moderately plastic fines (LL = 28, PI = 9)
Red; wet; rapidly permeable; loose; homogeneous; alluvial; (SM) D.S. 603.2, SM
 - 4.0 - 5.0 Silt w/sand; 100% <math>< 3</math>"
Approx. 30% sand, 70% nonplastic fines
Brown; saturated; moderately permeable; loose; lacustrine; (ML)
 - 5.0 - 6.0 Silt w/sand and gravel
Max. size 3/8"
Approx. 5% gravel, 10% sand, 85% nonplastic fines
Red; wet; slowly permeable; loose; homogeneous; lacustrine; (ML)
- NOTE: Water level @ 4', floodplain trash throughout pit, caved badly.

TP #504, Diversion, 4/23/75, AHC, 523.5

- 0.0 - 0.5 Topsoil, red
- 0.5 - 3.0 Silt w/ sand and gravel
Max. size 3/8"
Approx. 5% gravel, 10% sand, 85% nonplastic fines
Red; wet; slowly permeable; loose; homogeneous; lacustrine; (ML)
- 3.0 - 11.0 Silt and clay w/some sand and gravel
Approx. 5% $4/8$, 10% 3"-6", 85% <math>< 3</math>" (which is approx. 3% gravel, 22% sand, 75% very slightly plastic fines) (LL = 18, PI = 1)
Red-brown; with gray layer at 8.0'; saturated; slowly permeable; loose to dense with depth; homogeneous; lacustrine; (ML) D.S. 604.1 ML

HIGINBOTHAM BROOK
WATERSHED PROJECT
FLOODWATER RETARDING DAM
MADISON COUNTY, NEW YORK
LOGS OF TEST HOLES

U. S. DEPARTMENT OF AGRICULTURE
SOIL CONSERVATION SERVICE

Date	4/23/75	Project	HIGINBOTHAM BROOK WATERSHED PROJECT
Location	NY-2594-G	Sheet	5-75
Drawn by	DE N	Checked by	5-75
Scale	AS BUILT	Project No.	NY-2594-G

AS BUILT
8/11/78

2

DH 651 (continued)

12 18.0

DH 652, Diversion, 4/27/75, AHC, 535-A

N 0.0

0.5 Topsoil, brown

6 Clay, silt w/some sand and gravel layers
 12 Approx. 1/2 4", 10% 3"-6", 85% < 3" (which is
 6 approx 11% gravel, 22% sand, 67% moderately
 19 plastic fines); brown; moist; slow; permeable;
 19 medium dense; homogeneous except for occasional
 sand-gravelly layers; (CL-ML)

25 12.0

Sand, silt w/some gravel, 100% < 3"
 37 Approx. 3% gravel, 50% sand, 47% non-plastic
 14 fines; brown; moist; moderate; permeable;
 moderately dense with some varved layers of
 silt; lacustrine; (SM)

17.0

Clayey silt w/some sand and gravel layers
 16 Approx. 1/2 4", 10% 3"-6", 85% < 3" (which is
 13 approx 11% gravel, 22% sand, 67% moderately
 plastic fines); brown; moist; slow; permeable;
 medium dense; homogeneous except for occasional
 sand-gravelly layers; (CL-ML)

18 21.0

LEGEND

TEST HOLE NUMBERING SYSTEM

Test Pit (TP)	Drill Hole (DH)
Centerline of Dam	1-49
Borrow Area	101-149
Emergency Spillway	201-249
Principal Spillway	301-349
Outlet Channel	401-449
Drain Line	501-549
Other	601-649
	51-99
	151-199
	251-299
	351-399
	451-499
	551-599
	651-699

UNIFIED SOIL CLASSIFICATION SYSTEM (USCS) SYMBOLS

- GW Well graded gravels; gravel-sand mixtures
- GP Poorly graded gravels
- GM Silty gravels; gravel-sand-silt mixtures
- GC Clayey gravels; gravel-sand-clay mixtures
- SW Well graded sands
- SP Poorly graded sands
- SM Silty sands; sand-silt mixtures
- SC Clayey sands; sand-clay mixtures
- ML Silts; silty, very fine sands; sandy, or clayey silts
- CL Clays of low to medium plasticity; silty, sandy, or gravelly clays
- OL Organic silts and organic silty clays of low plasticity
- MH Elastic silts; micaceous or distomaceous silts
- CH Clays of high plasticity; fat clays
- OH Organic silts or clays of medium to high plasticity
- Pt Peat; muck
- (xx) Unified Classification by Visual-Manual Procedure (ASTM D2488) in the field
- xx Unified Classification based on laboratory analysis of representative samples (ASTM D2487)

BACKHOE PIT AND DRILL HOLE LOG TERMS AND ABBREVIATIONS

- Sample types - DS - Disturbed sample (loose, bagged, mixed)
- US - Undisturbed sample (sealed block or tube type)
- Matrix - All material less than 3"
- Atterberg limits - (ASTM D424)
 - LL - Liquid Limit
 - PL - Plastic Limit
 - PI - Plasticity Index
- Bldr - Boulder
- Cbl - Cobble
- A - Angular
- SA - Subangular
- SR - Subrounded
- R - Rounded
- ss - Sandstone
- sh - Shale
- slst - Siltstone
- ls - Limestone
- Sed - Sedimentary
- WL - water level
- - Seep in test hole
- RM - Blind hole - no sample
- WH - Weight of hammer
- Ref - Refusal
- RI - Rock core 2 1/8" diameter
- RB - Roller bit - no sample
- ANG - Anger - no sample
- DHS - Dry barrel sample
- STS - Split tube sample
- Rec - Recovery - % of rock or STS recovered
- k - Permeability rate (ft/day)
- RM - End of hole

N - Blows per foot - Standard Penetration Test (ASTM D1586)
 RQP - Rock Quality Designation in % - length of core pieces > 4" / length of core run

KEY TO BACKHOE PIT LOGS

TP Number, Location, Date, Logged by, Elevation

Depth Typical name
 Maximum size - lithology
 Approx % 4", % 3"-6", % matrix (which is approx % gravel, % sand, % plasticity fines)
 Odor; color; moisture; permeability; density or consistency; structure; origin; (field USCS)
 Sample number and type; lab USCS

NOTE: Water level, etc.

KEY TO DRILL HOLE LOGS

DH Number, Location, Date, Logged by, Elevation

N Description of Geologic Horizon
 0.0 Depth
 Typical name; gradation; % gravel, % sand, % fines; plasticity; odor; color; moisture; permeability; density or consistency; structure; origin; (field USCS).
 Sample number and type; lab USCS

NOTE: Water level, etc.

AS BUILT

8/11/78

HIGINBOTHAM BROOK WATERSHED PROJECT
 FLOODWATER RETARDING DAM
 MADISON COUNTY, NEW YORK
 LOGS OF TEST HOLES

U. S. DEPARTMENT OF AGRICULTURE
 SOIL CONSERVATION SERVICE

Approved by: STATE CONS ENGINEER
 Date: 5-75
 NY-2594-G


2

CONSTRUCTION DETAILS

- ✓ 1. AREAS UNDER THE DAMS AND LEVEE (INCLUDING 15 FEET OUTSIDE THE UPSTREAM AND DOWNSTREAM TOES), DIVERSION AND EMERGENCY SPILLWAY (INCLUDING ROCK OUTLET & 15 FEET OUTSIDE THE CUT SLOPES) AND BORROW AREA SHALL BE CLEARED AND GRUBBED. LIMITS OF AREA TO BE CLEARED AND GRUBBED WILL BE STAKED IN THE FIELD BY THE ENGINEER.
- ✓ 2. DEPTHS AND LIMITS OF BORROW EXCAVATION WILL BE DETERMINED IN THE FIELD BY THE ENGINEER AS REQUIRED. AT THE COMPLETION OF EARTH FILL OPERATIONS, THE BORROW SHALL BE LEFT GENTLY SLOPING, GENERALLY SMOOTH AND FREE DRAINING.
- ✓ 3. AREAS UPSTREAM FROM DAM 1 AND BELOW ELEVATION 515.0 SHALL BE CLEARED. THE AREA 80 FEET WIDE ON THE RIGHT ABUTMENT LEADING TO THE EMERGENCY SPILLWAY ENTRANCE CHANNEL SHALL BE CLEARED. LIMITS OF AREA TO BE CLEARED AND GRUBBED SHALL BE LEFT UNDISTURBED. MATERIAL DEPOSITED OUTSIDE THESE LIMITS BY CONSTRUCTION OPERATIONS SHALL BE REMOVED BY THE CONTRACTOR.
- ✓ 4. WASTE AREAS, AS STAKED IN THE FIELD BY THE ENGINEER, SHALL BE CLEARED THESE AREAS SHALL BE GRADED TO BE FREE-DRAINING AND GENERALLY SMOOTH.
- ✓ 5. BOTTOM SECTION OF THE EMERGENCY SPILLWAY IS TO BE COVERED WITH 6" OF TOPSOIL FROM STATION 1+00 TO APPROXIMATE STATION 4+10.

FENCING MATERIALS



- ✓ 1. FENCING MATERIAL SHALL CONFORM TO SPEC. 591.
- ✓ 2. TREATMENT SHALL BE OIL TAR OREGONITE.
- ✓ 3. STEEL POSTS, STYLE 1 OR 2 MAY BE USED AS AN ALTERNATIVE FOR LINE POSTS. MIN. WEIGHT FOR STEEL POSTS SHALL BE 1.33 LBS. PER FOOT, EXCLUSIVE OF ANCHOR PLATE.
- ✓ 4. THE TOP OF ALL POSTS SHALL HAVE THE MIN. DIA. IN INCHES SHOWN.
- ✓ 5. BARBED WIRE SHALL BE TYPE 1 (ZINC COATED) 12½ GAUGE, WITH 4 POINT ROUND BARBS SPACED APPROX. 5 INCHES APART.
- ✓ 6. SUBJECT TO THE APPROVAL OF THE ENGINEER, GALVANIZED STEEL BRACE POSTS AND LINE POSTS MAY BE USED AT THE CONTRACTOR'S OPTION. THE STEEL POSTS SHALL HAVE A MINIMUM OUTSIDE DIAMETER OF 2.375 INCHES, A LENGTH AS SHOWN ON THE DRAWINGS AND BE SET IN CONCRETE.

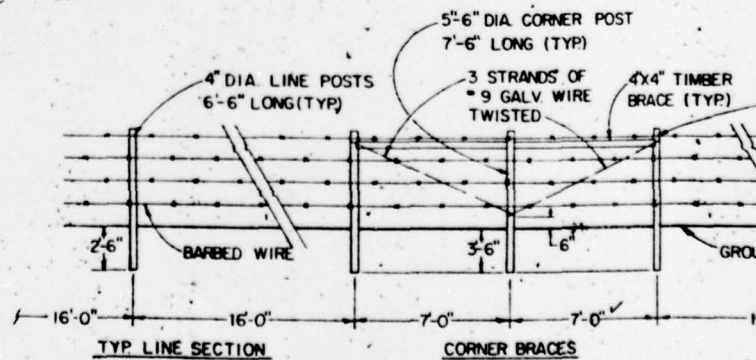


DETAIL OF 4-STRAND BARBED WIRE FENCE

LEGEND

- 510 — CONTOUR
- — — — — STREAM
- — — — — SEDIMENT POOL
- — — — — DESIGN HIGH WATER
- HUB
- — — — — ROAD
- x — x — x — FENCE LINE (EXISTING)
- — — — — " " (TO BE INSTALLED)

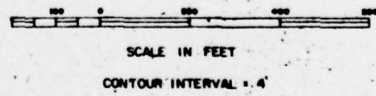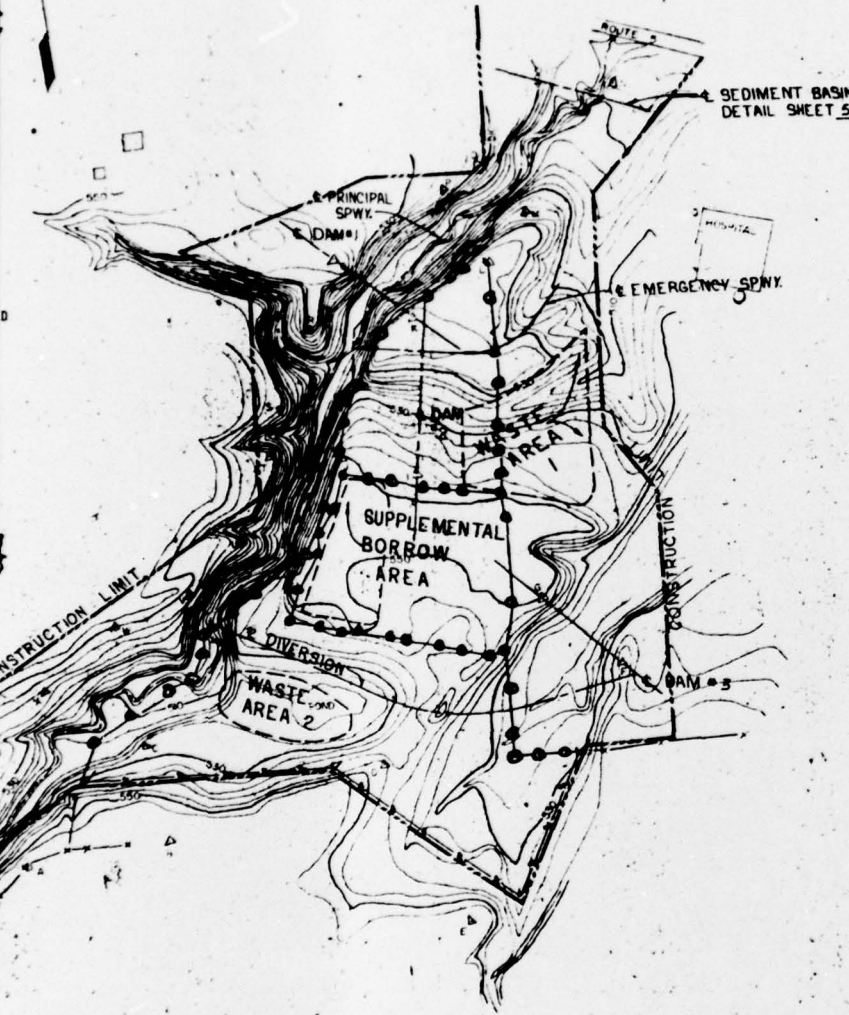

AS BUILT
 8/11/78

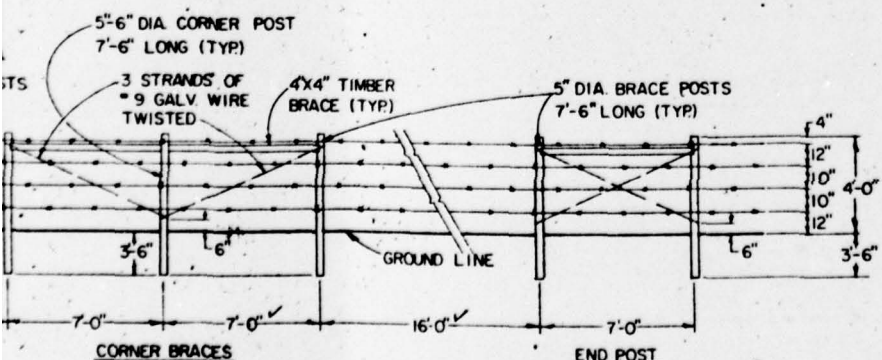

DETAIL OF 4-STRAND BARBED WIRE FENCE

HIGINBOTHAM BROOK WATERSHED PROJECT FLOODWATER RETARDING DAM MADISON COUNTY, NEW YORK PLAN OF STORAGE AREA	
U. S. DEPARTMENT OF AGRICULTURE SOIL CONSERVATION SERVICE	
W A RIEGEL	2-75
Wm Kenny	1-72
D.E.W.	5-72
	2 NY-2594-P

2



DAM #1 ELEV. 536.4
TOP WIDTH 18'

DAM #2 ELEV. 536.4
TOP WIDTH 12.0'

DESIGN HIGH WATER ELEV. 532.7
SEDIMENT POOL ELEV. 531.7

OUTLET
CHANNEL
DETAIL
SHY. 14

DESIGN HIGH WATER ELEV. 532.5

CONSTRUCTION LIMIT

MATCH LINE SHEET 4

TP 124

TP 125

TP 9

TP 52

TP 251

TP 205

TP 300

TP 302

TP 305

TP 502

TP 505

TP 508

TP 510

LEGEND

- FENCE LINE
- & OF STREAM
- CONTOUR LINES
- BENCH MARK
- HUB
- SEDIMENT POOL
- CONSTRUCTION LIMIT
- WOODS LINE
- OBUMENT
- FOUNDATION EXCAVATION
AVERAGE DEPTH-5
- DESIGN HIGH WATER
- DRILL HOLE (LOGGED & SAMPLED)
- TEST PIT (LOGGED & SAMPLED)
- TEST PIT (LOGGED ONLY)
- FENCE LINE (EXISTING)
- FENCE LINE (TO BE INSTALLED)

NOTES

1. FOUNDATION EXCAVATION IN THE VICINITY OF THE PRINCIPAL SPILLWAY AND RESERVOIR DRAIN WILL BE PAID FOR AS STRUCTURE EXCAVATION
2. LOOSE ROCK RIPRAP SHALL EXTEND FROM APPROX. STA. 1-30 TO STA. 2-50 (EMERG. SPWY) GRADATION REQUIREMENTS SHALL BE AS SHOWN ON SHEET 14.

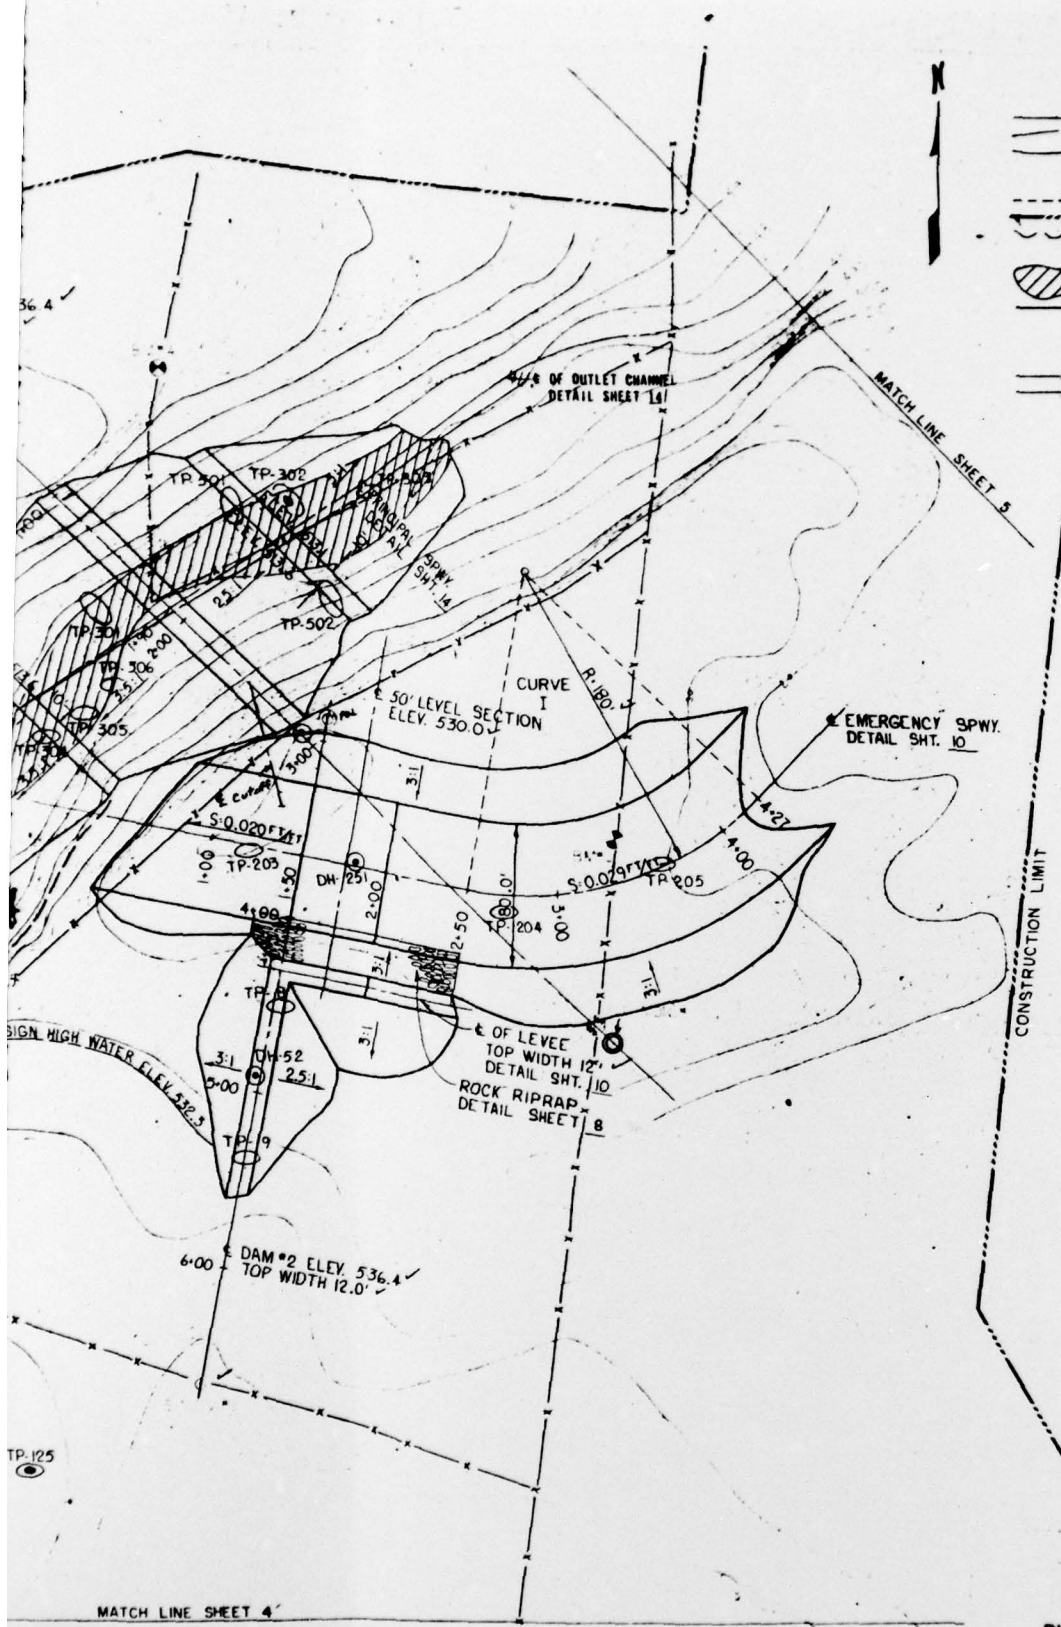


AS BUILT

2' CONTOUR INTERVAL
 0 25 50 100 8/11/78
 SCALE IN FEET


**HIGINBOTHAM BROOK
 WATERSHED PROJECT
 FLOODWATER RETARDING DAM
 MADISON COUNTY NEW YORK
 PLAN OF STRUCTURAL WORKS**


W. A. RIEGEL 2-75
 D. ANGELO 2-75
 D. E. W. 5-75 3 NY-2594-P
 30

2

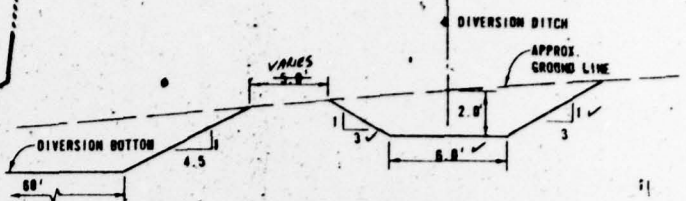


SECTION OF DIVERSION DITCH
 ALIGNMENT AND GRADE TO BE STAKED IN THE FIELD BY THE ENGINEER. ✓

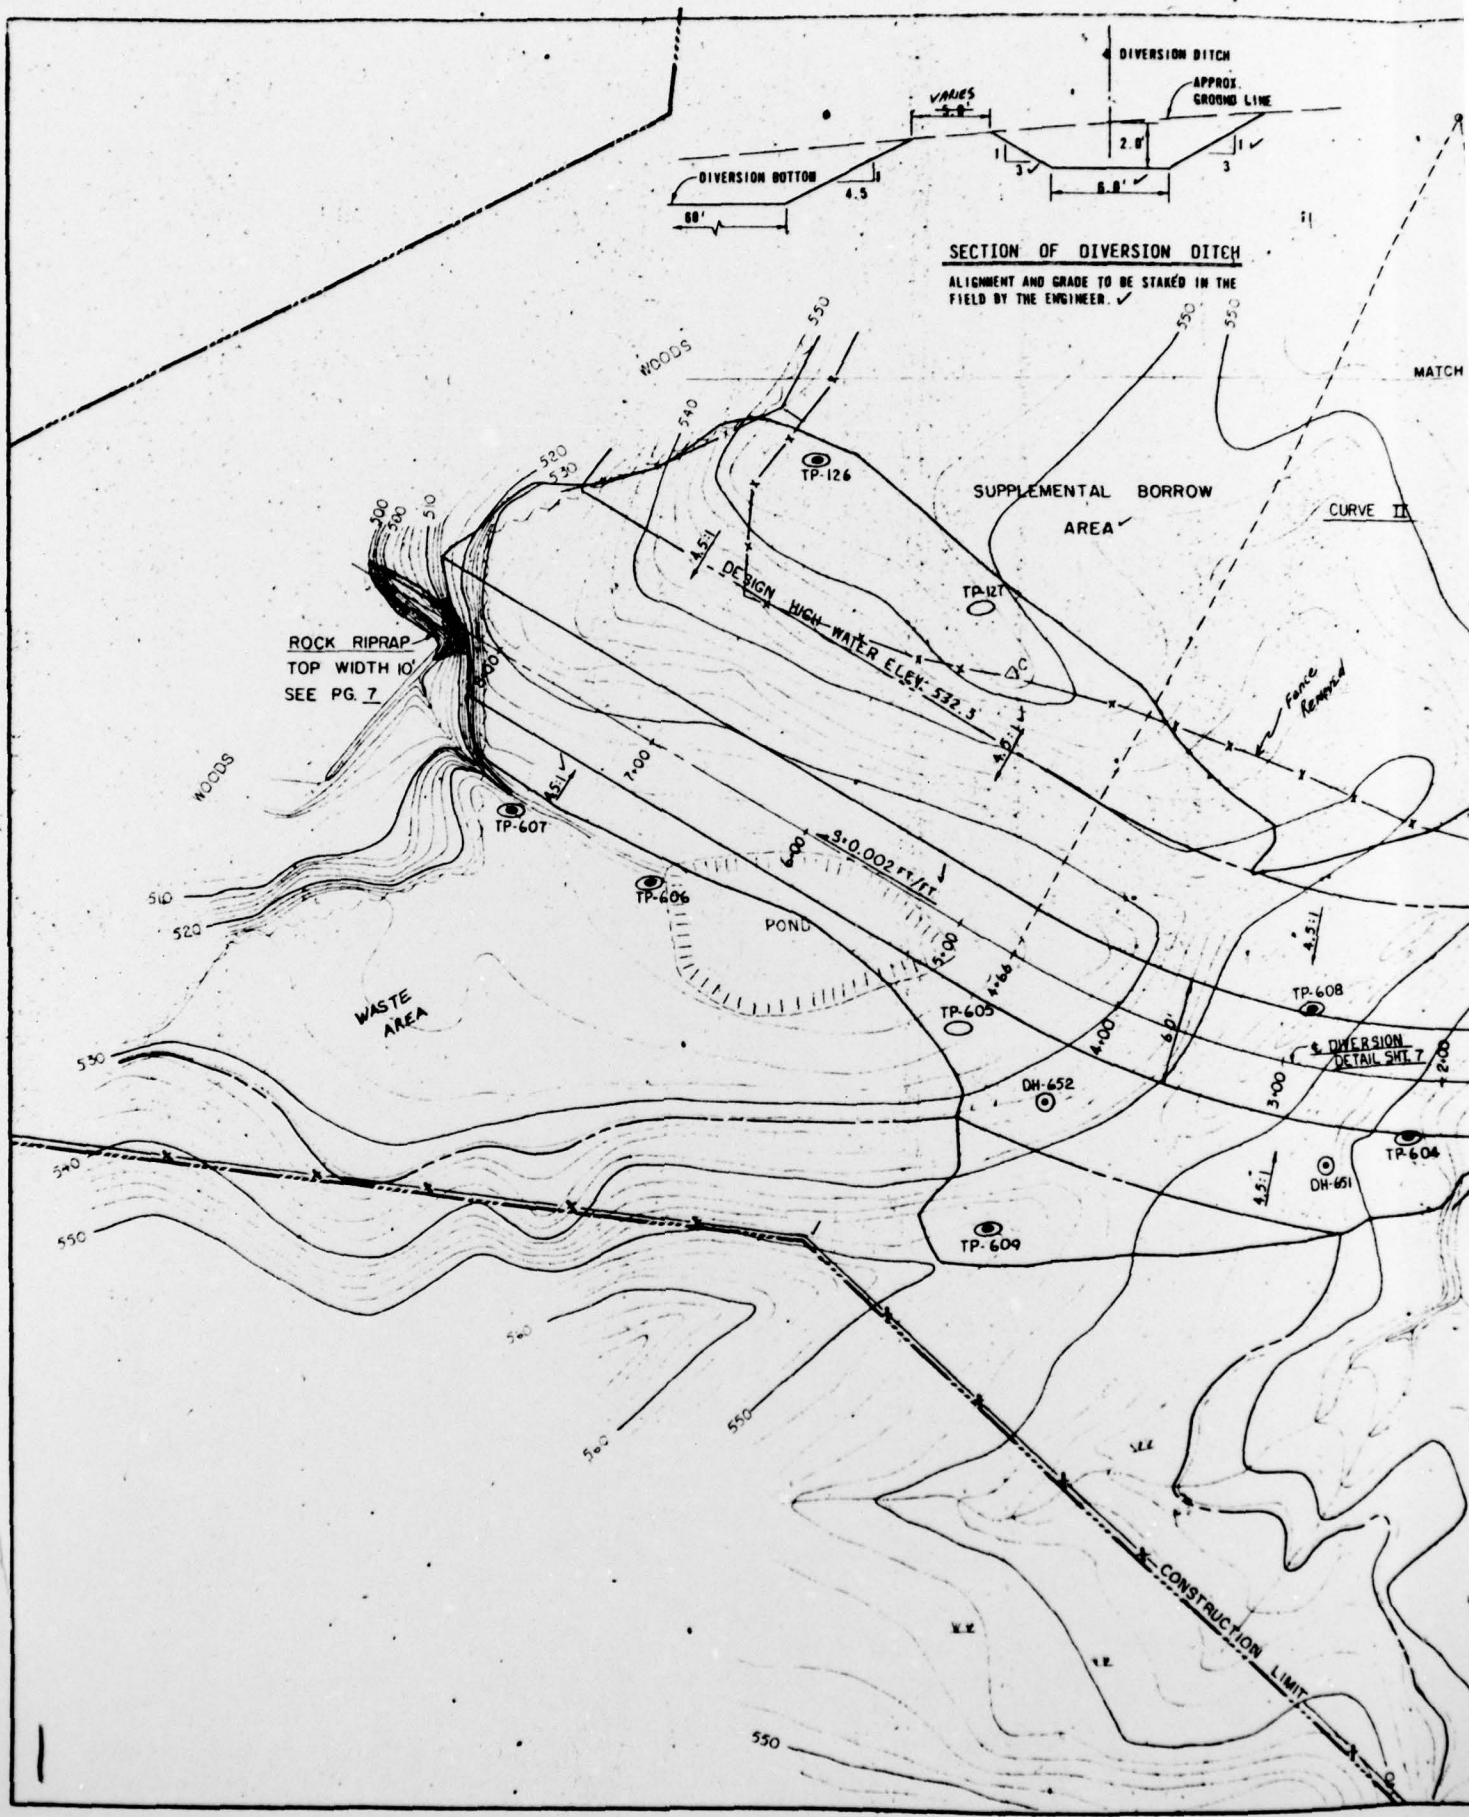

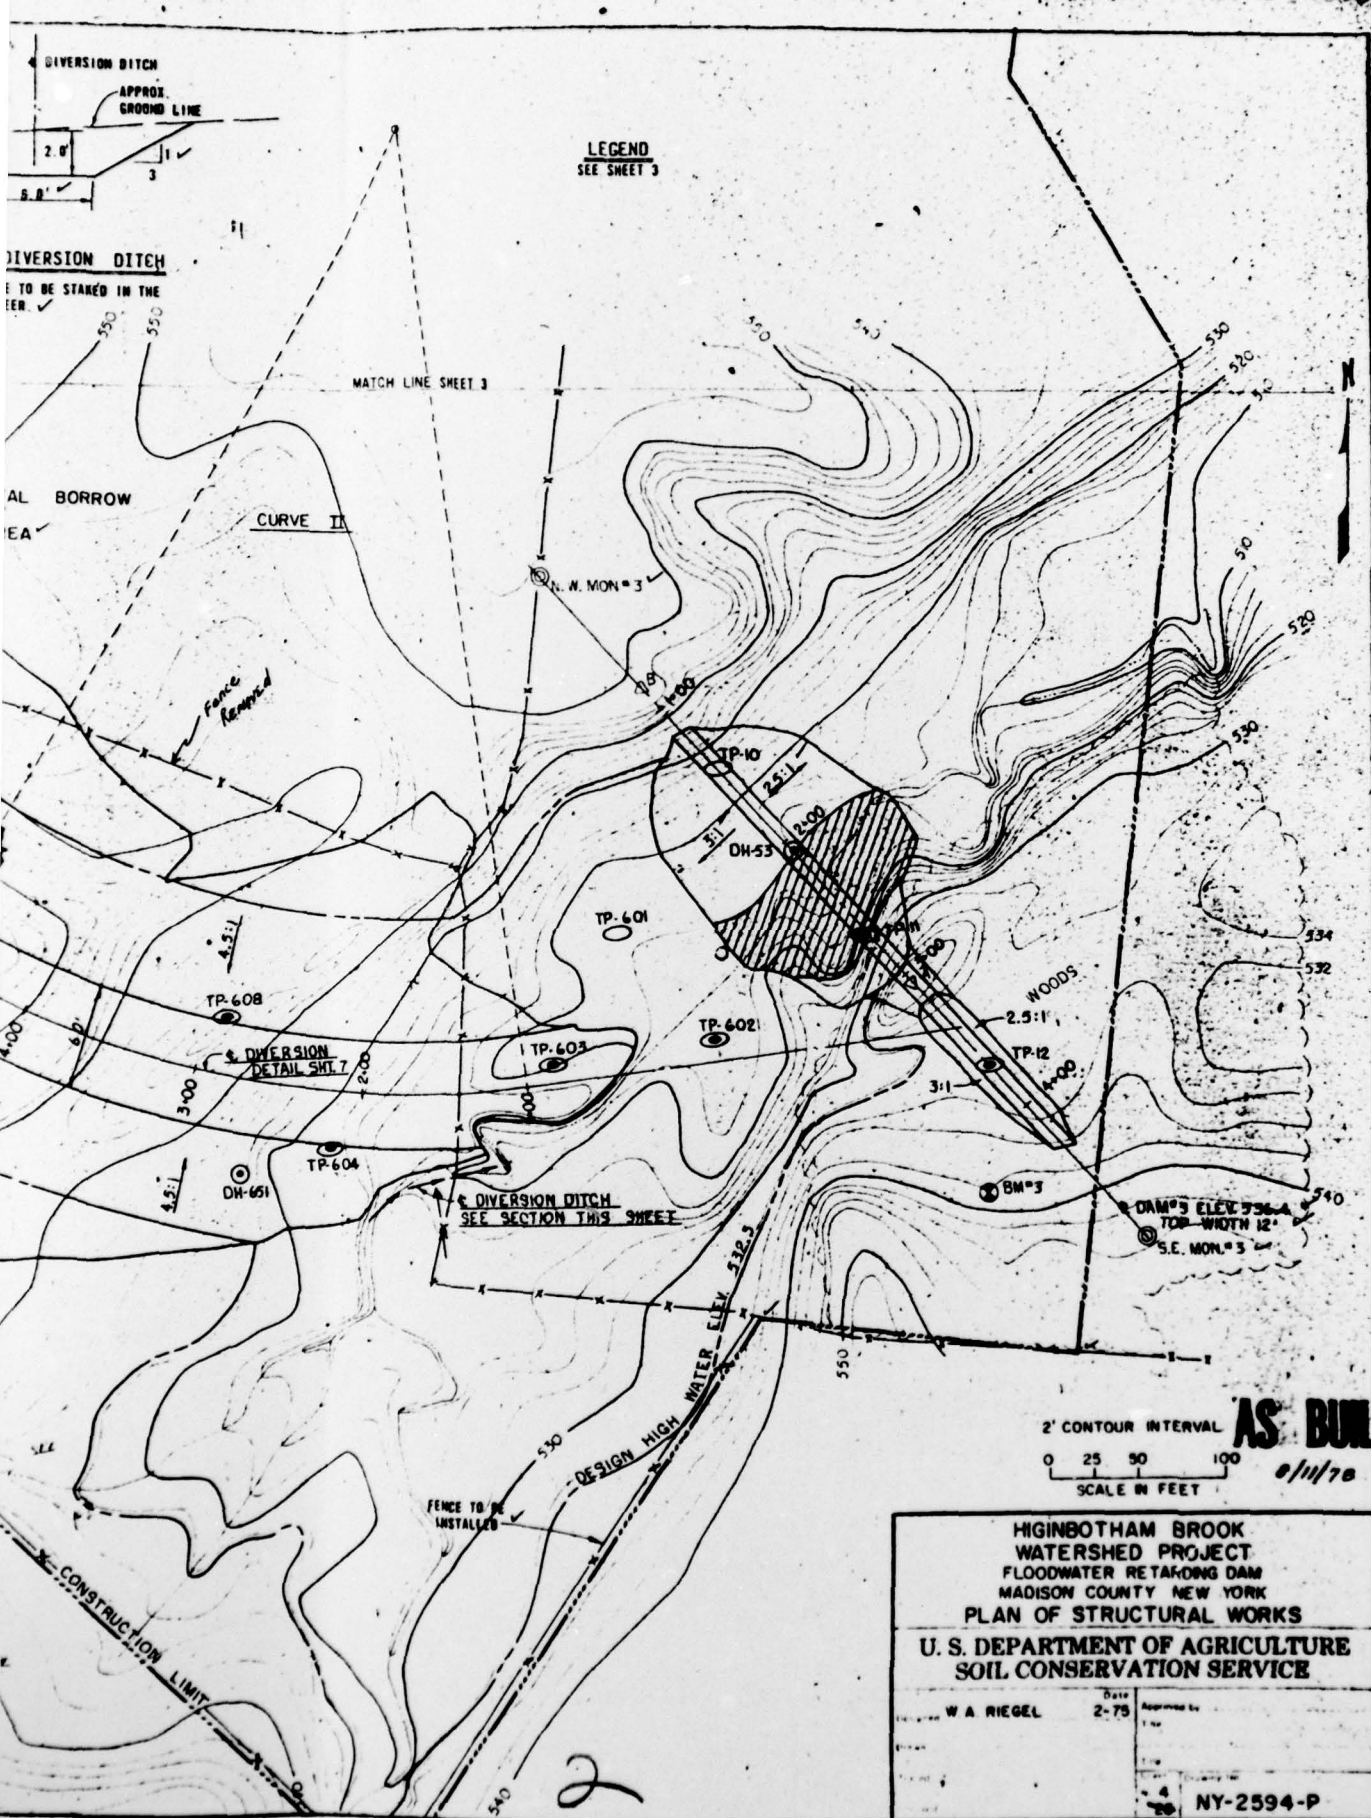

LEGEND
SEE SHEET 3

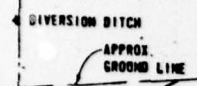

DIVERSION DITCH
TO BE STAKED IN THE
FIELD

MATCH LINE SHEET 3

CURVE II

AL BORROW
EA

*Fence
Removed*

DIVERSION
DETAIL SHT. 7

DIVERSION DITCH
SEE SECTION THIS SHEET









2' CONTOUR INTERVAL **AS BUILT**
0 25 50 100
SCALE IN FEET 8/11/78


HIGINBOTHAM BROOK
WATERSHED PROJECT
FLOODWATER RETARDING DAM
MADISON COUNTY NEW YORK
PLAN OF STRUCTURAL WORKS
U. S. DEPARTMENT OF AGRICULTURE
SOIL CONSERVATION SERVICE

Drawn by: W A RIEGEL
Date: 2-75
Approved by: [Signature]

NY-2594-P

2

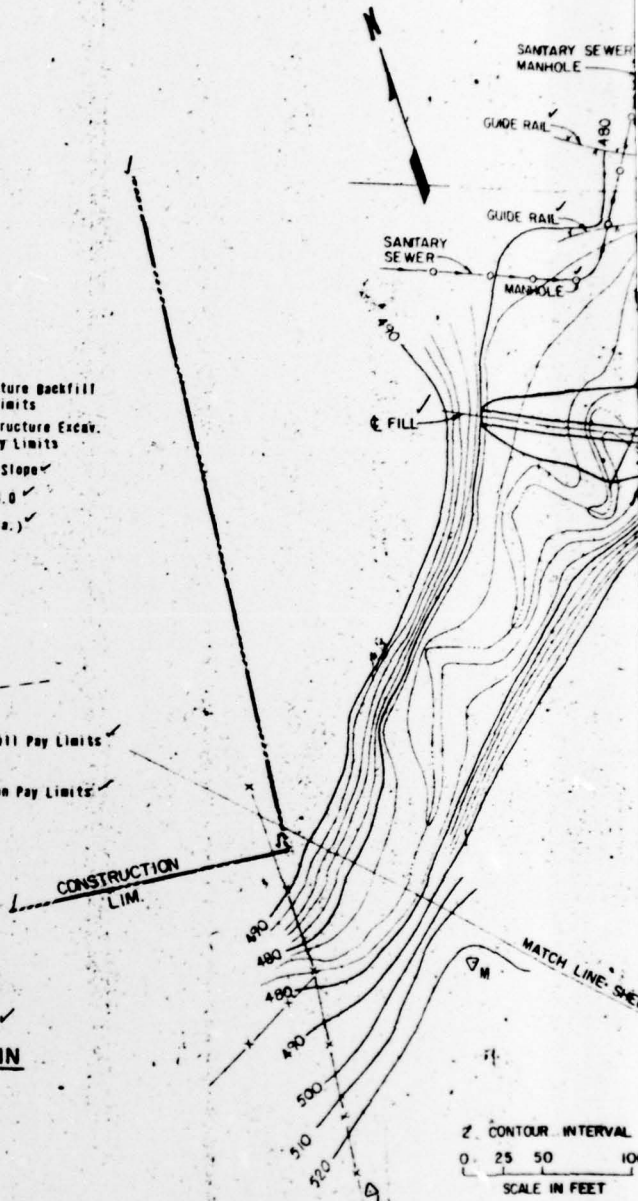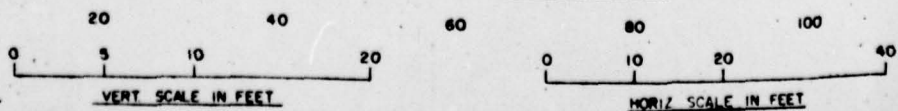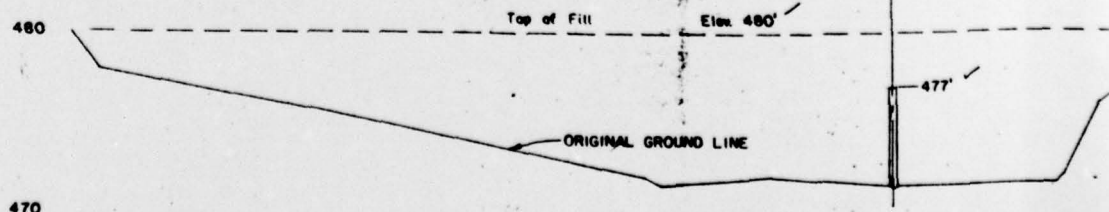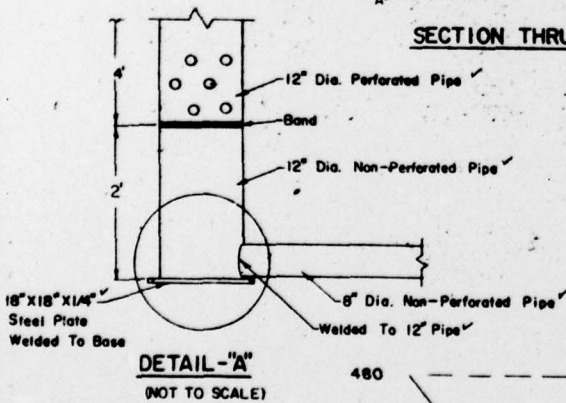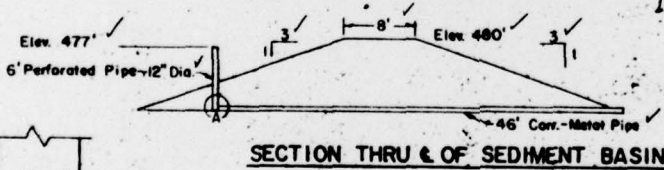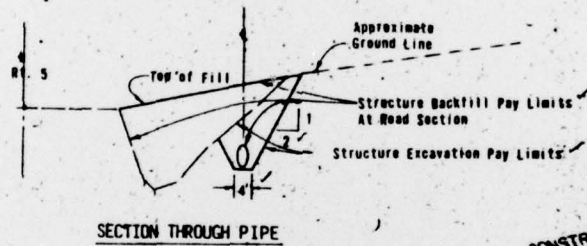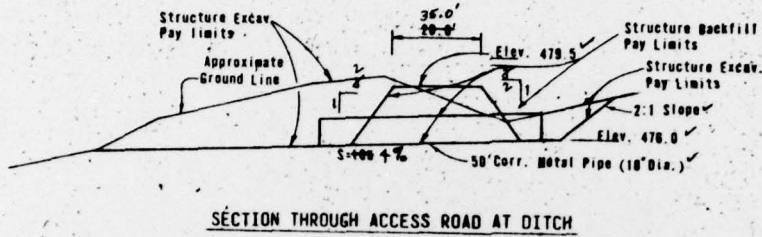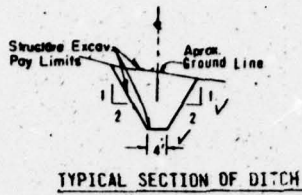


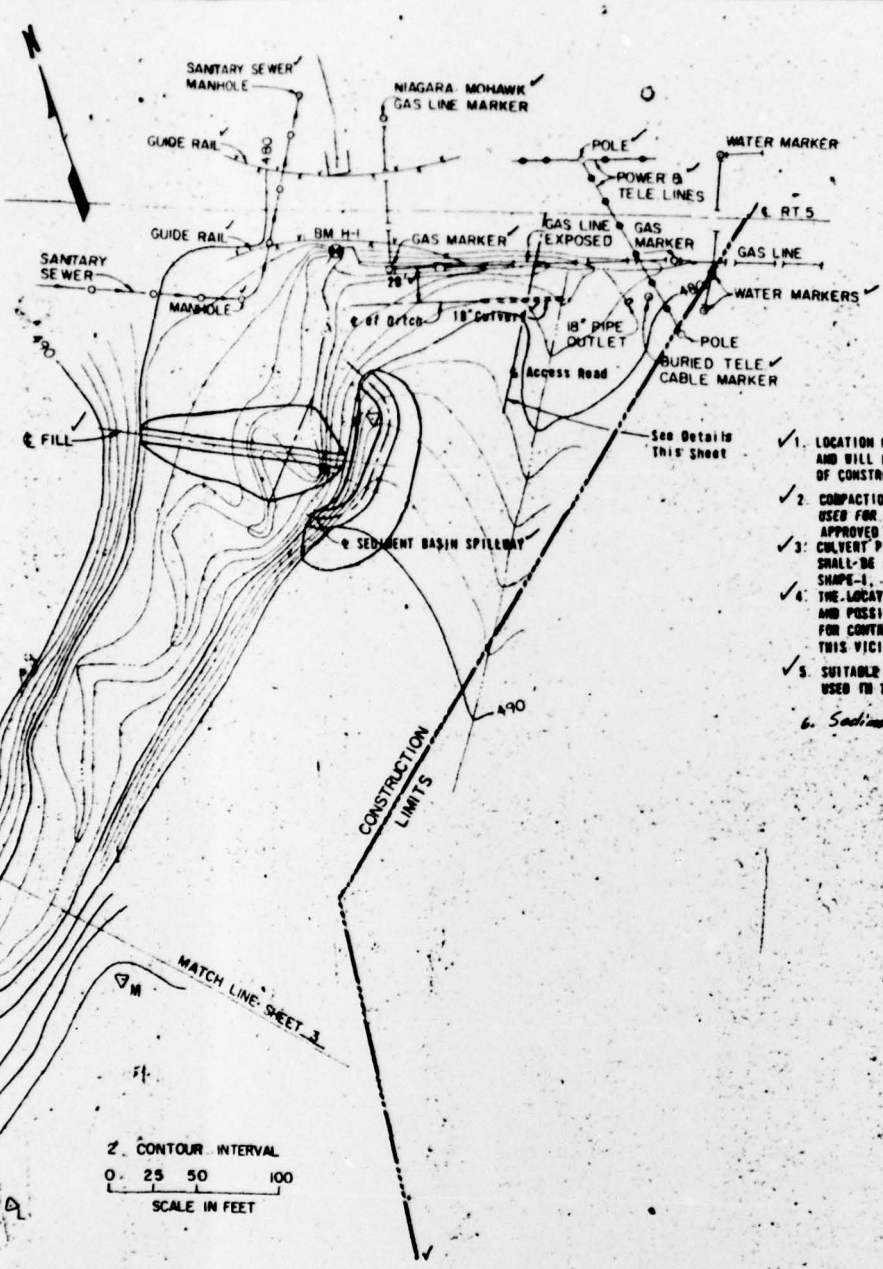

CONSTRUCTION DETAILS

- ✓ 1. LOCATION OF SEDIMENT BASIN AND ACCESS ROAD ARE APPROXIMATE AND WILL BE STAKED IN THE FIELD BY THE ENGINEER AT THE TIME OF CONSTRUCTION.
- ✓ 2. COMPACTION SHALL BE MADE BY A B.M. OF ONE PASS BY THE VEHICLE USED FOR PLACING THE MATERIAL, OR BY AN ALTERNATIVE METHOD APPROVED BY THE ENGINEER.
- ✓ 3. CULVERT PIPE USED BENEATH ACCESS ROAD FROM RT. 5 TO THE SITE SHALL BE 18 INCH DIA., ZINC COATER STEEL, CLASS-I OR II, SERIES-A SHAPE-1, 16 GAUGE MINIMUM.
- ✓ 4. THE LOCATION OF UTILITIES SHOWN ON THE DRAWINGS IS APPROXIMATE AND POSSIBLY NOT COMPLETE. THE CONTRACTOR SHALL BE RESPONSIBLE FOR CONTRACTING THE APPROPRIATE UTILITIES PRIOR TO EXCAVATION IN THIS VICINITY.
- ✓ 5. SUITABLE EXCESS MATERIALS FROM THE SEDIMENT BASIN MAY BE USED TO THE SAME OR LOWER.
- 6. *Sediment Basin to be removed after 1975.*

2' CONTOUR INTERVAL
 0 25 50 100
 SCALE IN FEET

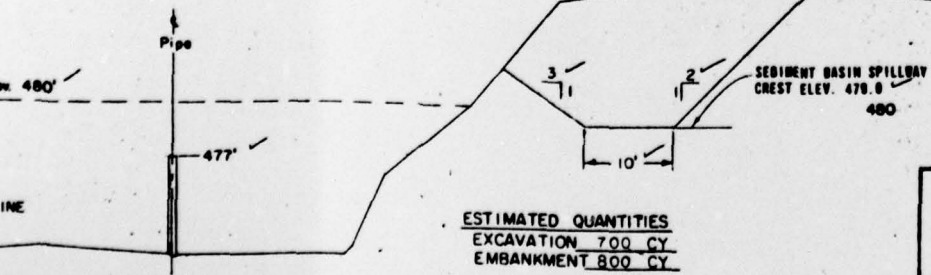

ESTIMATED QUANTITIES
 EXCAVATION 700 CY
 EMBANKMENT 800 CY


AS BUILT
 8/11/78


CROSS SECTION ALONG C OF SEDIMENT BASIN

80 100 120 140 160
 10 20 40
 HORIZ SCALE IN FEET

HIGINBOTHAM, BROOK WATERSHED PROJECT FLOODWATER RETARDING DAM MADISON COUNTY NEW YORK SEDIMENT BASIN	
U. S. DEPARTMENT OF AGRICULTURE SOIL CONSERVATION SERVICE	
W. A. REBEL O.E.W.	4-75 5-75 NY-2594-P


2

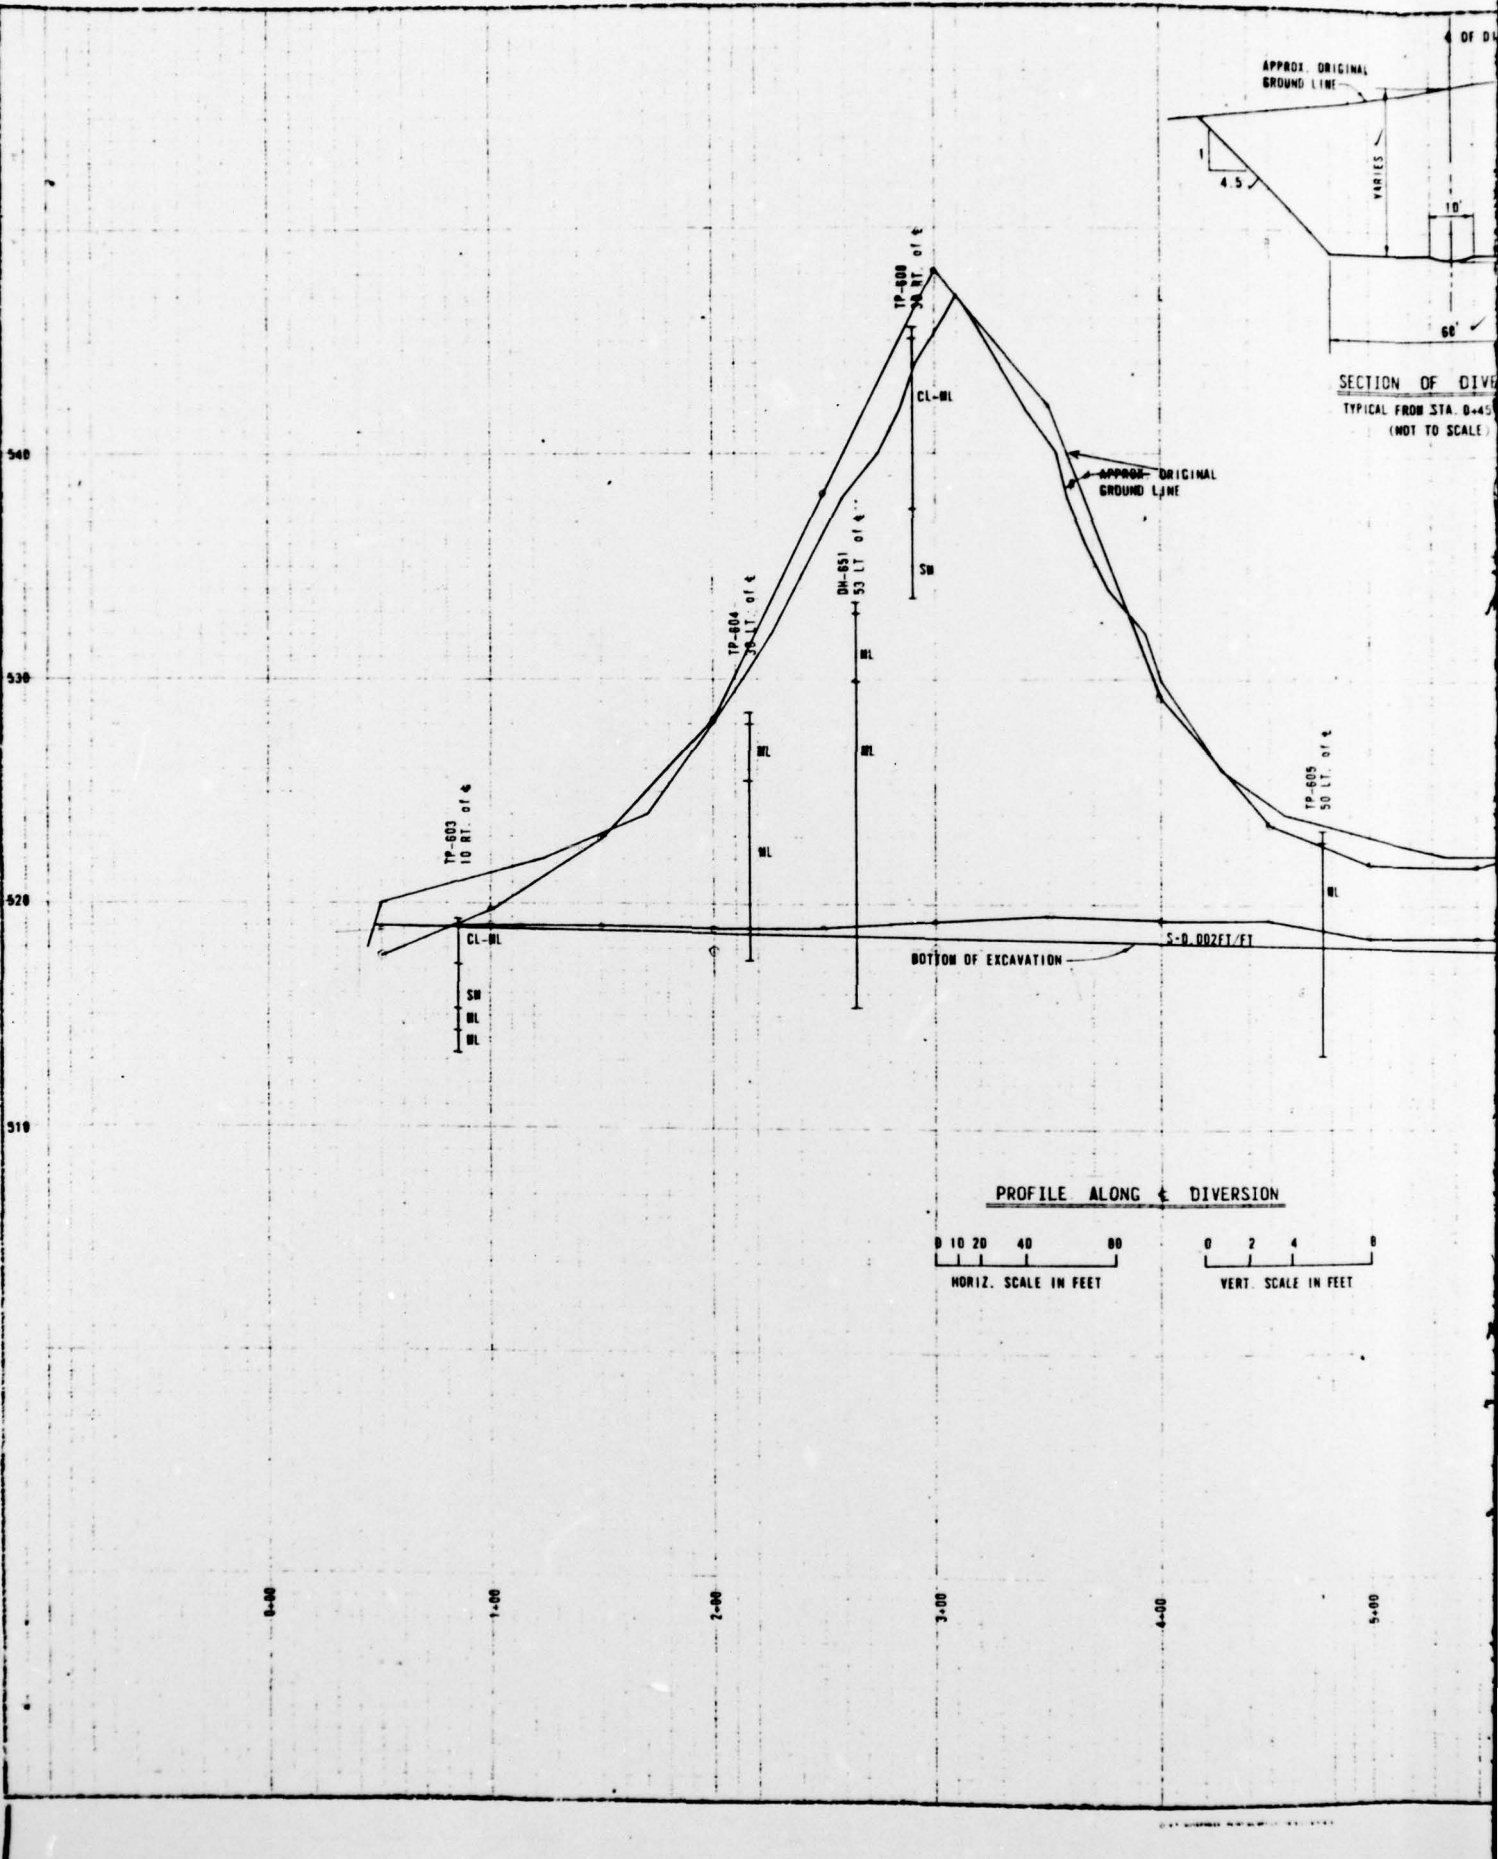

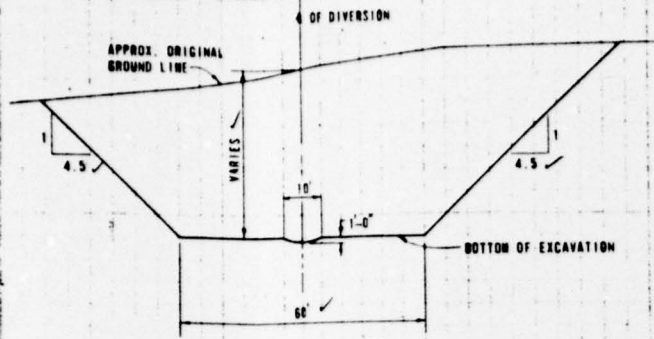


SECTION OF DIVERSION
TYPICAL FROM STA. 8-45 TO 8-20
(NOT TO SCALE)

CONSTRUCTION DETAILS
ROCK RIPRAP SHALL BE EQUIPMENT PLACED AT OUTLET FOR DIVERSION AT APPROX. STA. 8-20. ROCK PROTECTION SHALL BE APPROX. 10' WIDE. SLOPE SHALL BE APPROX. 3.5' HORIZ. TO 1' VERTICAL. NO BEDDING WILL BE REQUIRED. SEE SHEET 14 FOR GRADATION REQUIREMENTS.

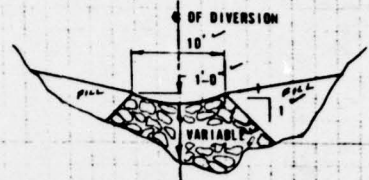


TYPICAL SECTION OF DIVERSION OUTLET AND RIPRAP
(NOT TO SCALE)

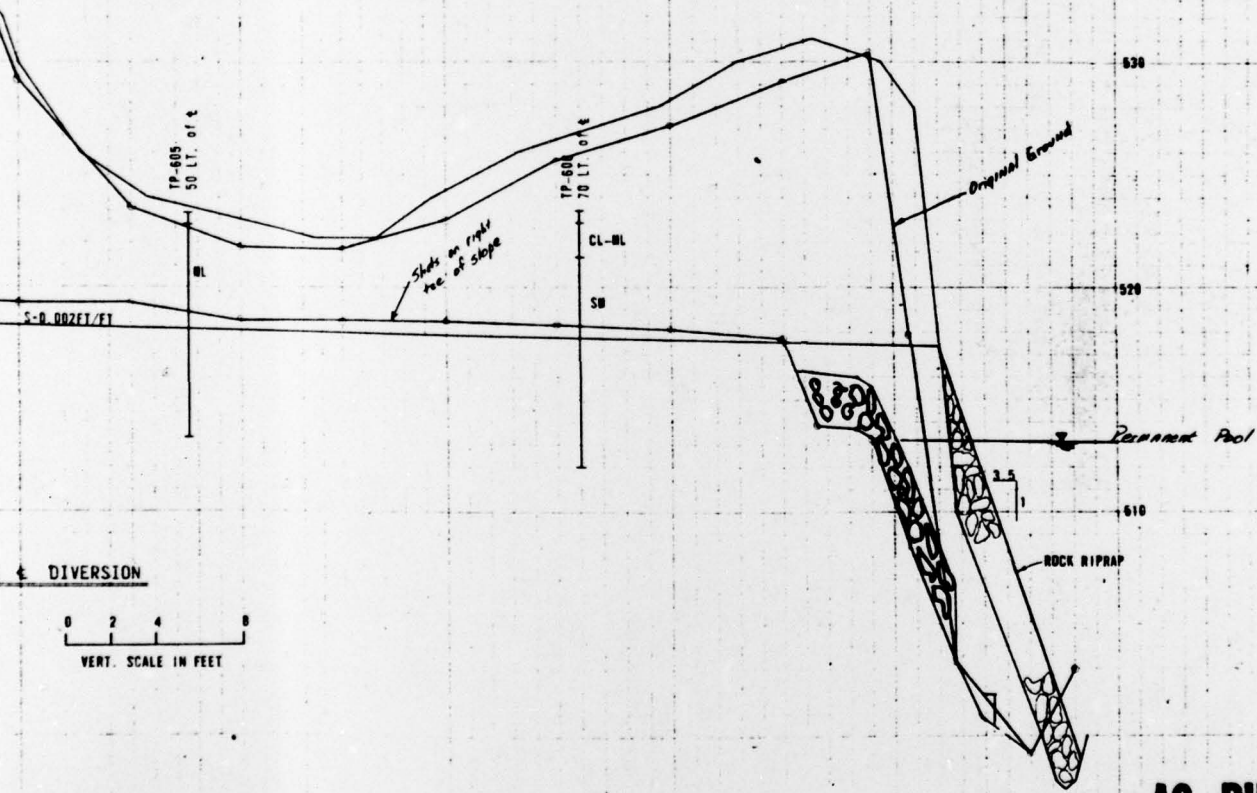


AS BUILT
8/11/78

HIGINBOTHAM BROOK WATERSHED PROJECT FLOODWATER RETARDING DAM MADISON COUNTY NEW YORK DIVERSION			
U. S. DEPARTMENT OF AGRICULTURE SOIL CONSERVATION SERVICE			
Designed by	W. RIEGEL	2-75	As shown
Checked by	D. ANGELO	3-75	
Drawn by			
City	D. E. W.	5-75	NY-2594-P

2

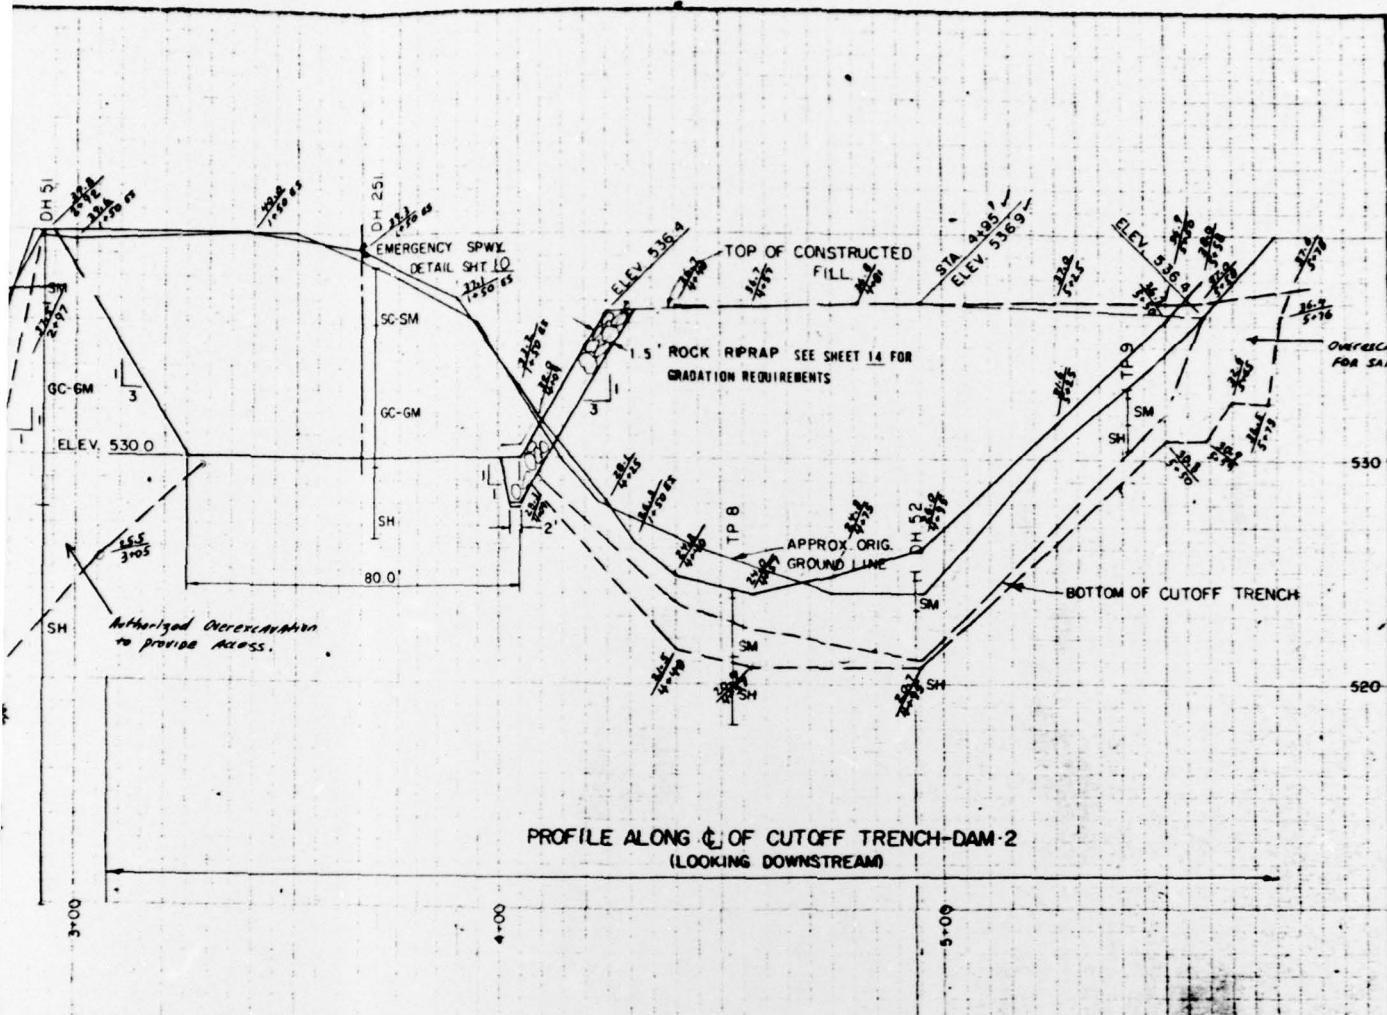

PROFILE ALONG C. OF CUTOFF TRENCH-DAM-2
(LOOKING DOWNSTREAM)

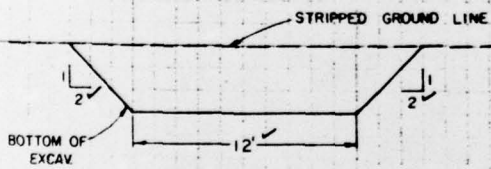


TYPICAL SECTION OF CUTOFF TRENCH-DAM-2

CUTOFF TRENCH DETAILS

1. THE BOTTOM OF CUTOFF TRENCH SHOWN IS APPROXIMATE. ITS FINAL DEPTH WILL BE DETERMINED BY THE ENGINEER AT THE TIME OF CONSTRUCTION.
2. ALL ROCK SURFACES AT THE BOTTOM OF CUTOFF TRENCH SHALL BE FREE OF LOOSE MATERIAL AND CLEANED AS DESCRIBED IN THE SPECIFICATIONS PRIOR TO BACKFILLING. JOINTS OR CRACKS ENCOUNTERED IN THE BOTTOM OR SIDES OF THE CUTOFF TRENCH WILL BE EXAMINED BY THE ENGINEER TO DETERMINE THE NEED FOR ROCK TREATMENT PRIOR TO BACKFILLING.


AS BUILT
8/11/78

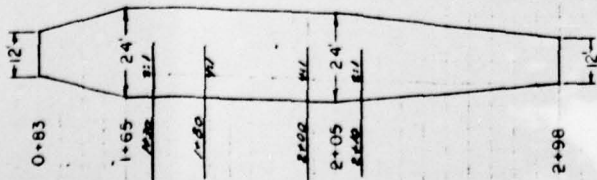


BOTTOM WIDTH OF CUTOFF-DAM-1
(NOT TO SCALE)
SIDE SLOPES SHALL BE
4:1 FROM APPROX STA 1+80-2+00

HIGHBOTHAM BROOK
WATERSHED PROJECT
FLOODWATER RETARDING DAM
MADISON COUNTY, NEW YORK
CUTOFF TRENCH EXCAVATION-DAM 1&2
U. S. DEPARTMENT OF AGRICULTURE
SOIL CONSERVATION SERVICE

W. A. RIEGEL	2-75	NY-2594-P
D. ANGELO	2-75	
R. J. KELLEY		
D. E. W.	5-75	

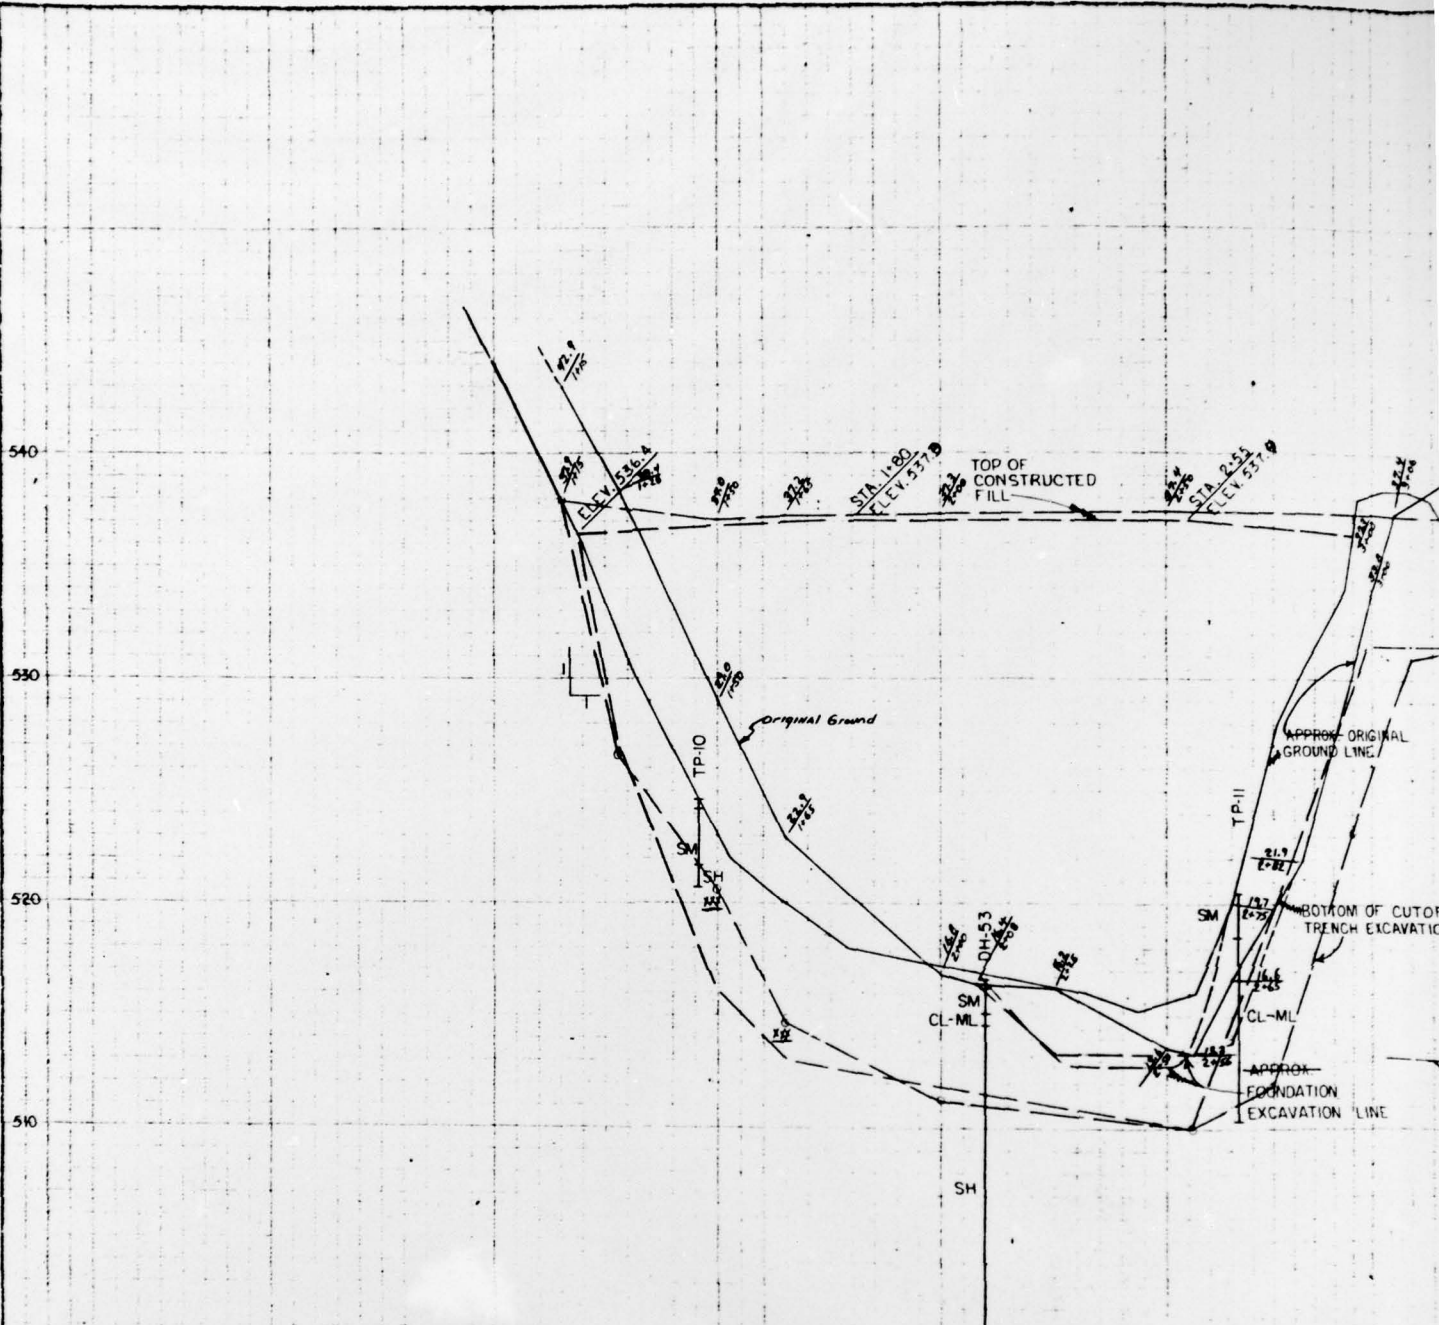


PROFILE ALONG & CUTOFF TRENCH-DAM 3 (LOOKING DOWNSTREAM)

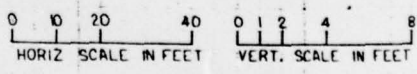

1+00

2+00

5+00

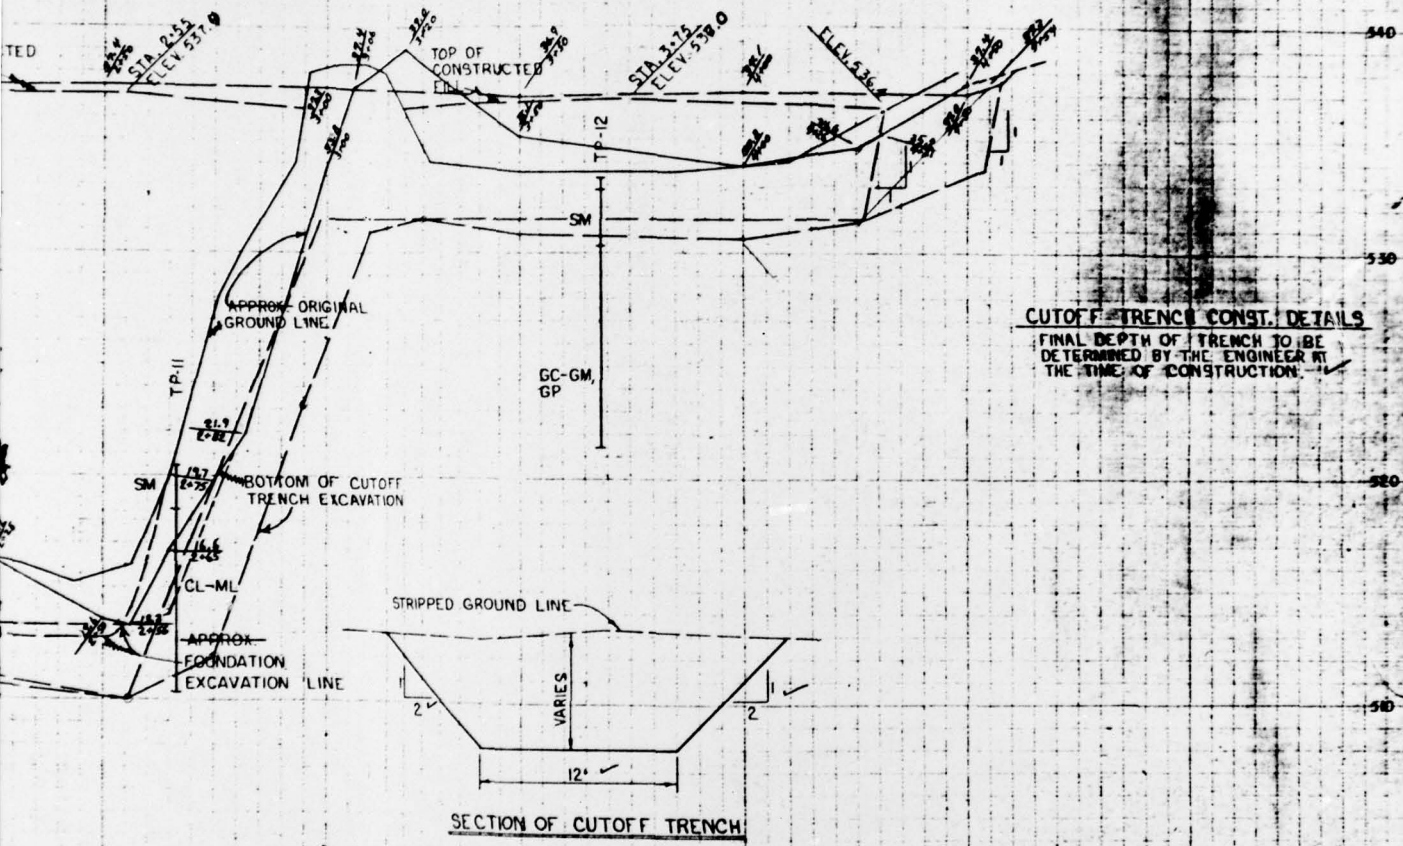

TRENCH - DAM 3 (LOOKING DOWNSTREAM)

0 1 2 4 8
VERT. SCALE IN FEET

5+00


4+00

REV. ROCK, DR. REF. 1/1



AS BUILT
8/11/78

HIGINBOTHAM BROOK WATERSHED PROJECT FLOODWATER RETARDING DAM MADISON COUNTY NEW YORK CUTOFF TRENCH EXCAVATION - DAM 3 U. S. DEPARTMENT OF AGRICULTURE SOIL CONSERVATION SERVICE			
Drawn by W. A. RIEGEL 2-75	Date 2-75	Checked by D. ANGELO 2-75	Date 2-75
Drawn by D. E. W.	Date 2-75	Project No. 9	NY-2594-P


2

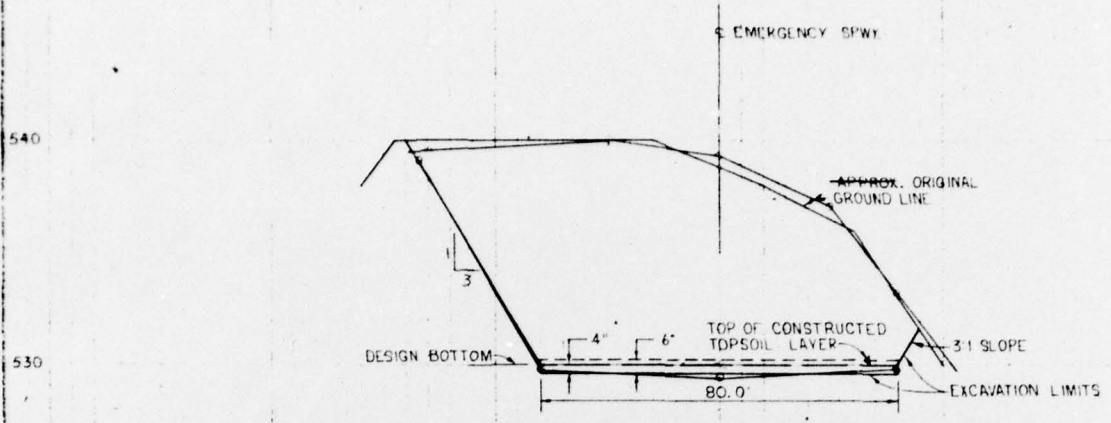


SECTION OF EMERGENCY SPILLWAY AT STA. 1+50
 TYPICAL FROM STA. 1+00 TO APPROX. STA. 4+15, EXCAVATION
 LIMITS TO DESIGN BOTTOM FROM APPROX. STA. 0+40 TO STA. 1+00

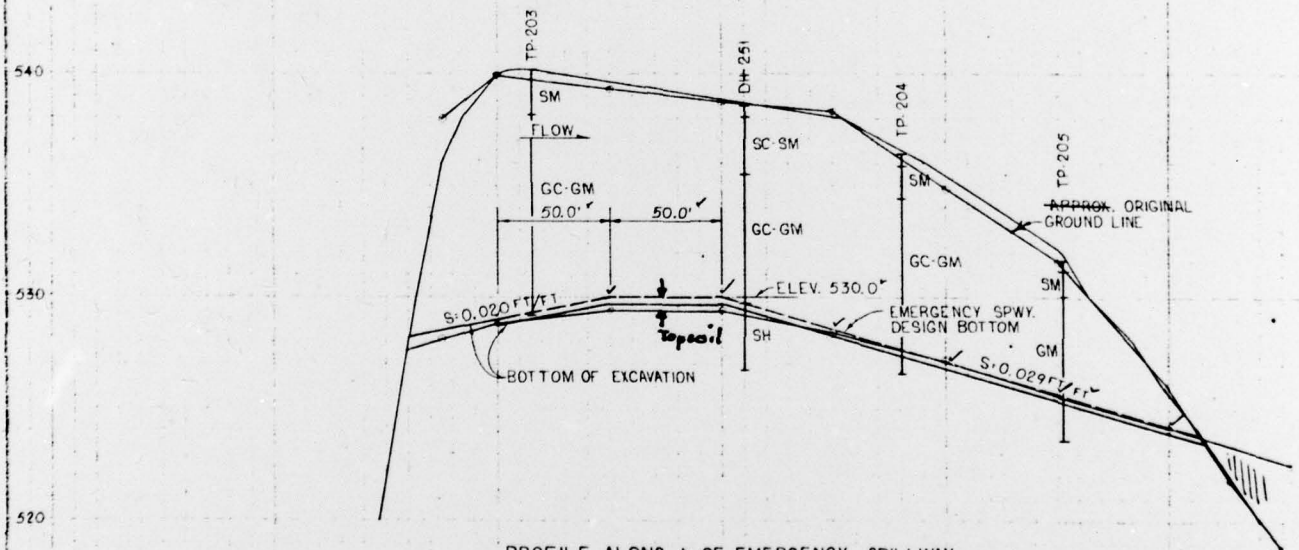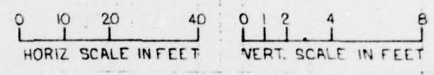


PROFILE ALONG ϵ OF EMERGENCY SPILLWAY

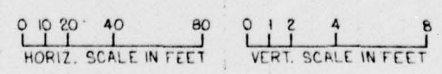


0+00 1+00 2+00 3+00 4+00 5+00

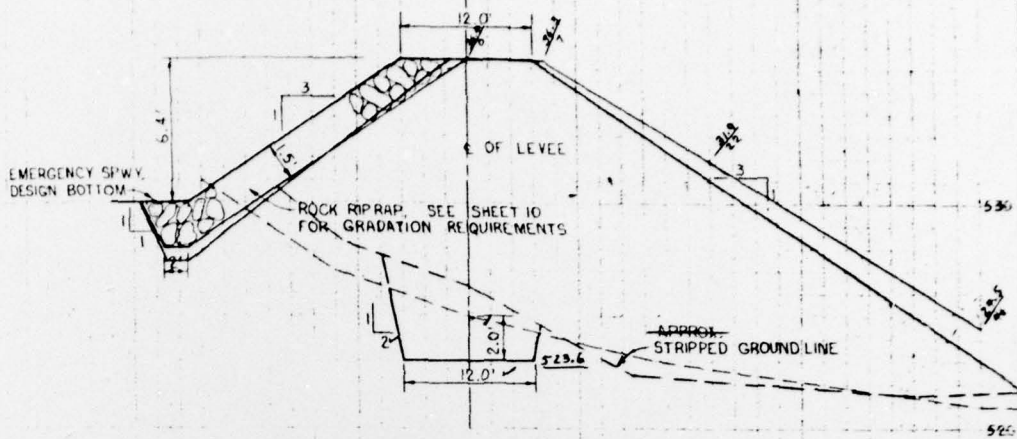


SECTION OF LEVEE AT STA. 2+00
TYPICAL FROM EMERGENCY SPILLWAY

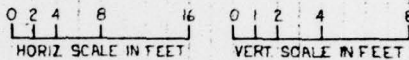

EMERGENCY SPILLWAY
LEVEL SECTION

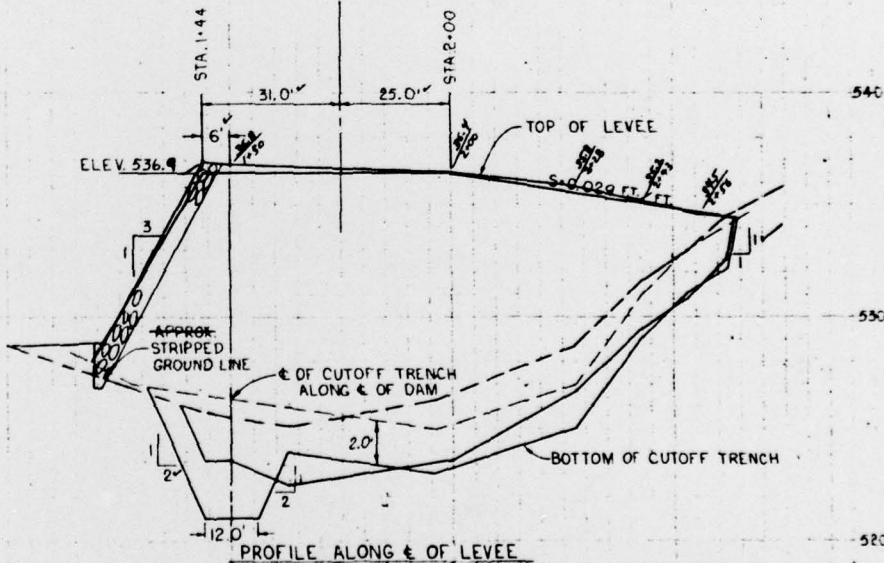

PROFILE ALONG E OF LEVEE

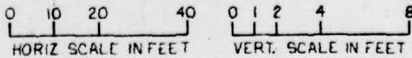

AS BUILT
8/11/70

HIGINBOTHAM BROOK
WATERSHED PROJECT
FLOODWATER RETARDING DAM
MADISON COUNTY NEW YORK
EMERGENCY SPILLWAY

U. S. DEPARTMENT OF AGRICULTURE
SOIL CONSERVATION SERVICE

W A RIEGEL 2-75

D ANGELO 2-75

D E W 5-75

NY-2594-P

2